

1420 Greenbare

L15 B4 Owens Plaza #1 Zone R-1

LOG NO. & AREA

CITY OF LAS VEGAS, NEVADA

CONST. VAL. \$

DEPARTMENT OF BUILDING & SAFETY

APPLICATION & BUILDING PERMIT -- for:

Fence, Wall, Retaining Wall.

ADDRESS OF
CONSTRUCTION:

OWNER:

LOT(s)

BLOCK

SUBDIVISION

ZONE:

Materials of

Construction:

Block ☐Concrete ☐Wire ☐Wood ☒Other ☐

Yes No

PLANS: ☐CALCS: ☐

ARCHITECT:

ENGINEER:

CONTRACTOR:

STATE

LICENSE #

CITY

LICENSE #


TOTAL SQUARE FEET:

TOTAL LINEAL FEET: 149

Remarks:

CONDITIONS OF THE PERMIT:

- Any type of retaining wall must be engineered by a Civil or Structural Engineer.
- If a home owner takes out the Building Permit and if the owner sublets the work to a Contractor then the Contractor must take out the permit and pay for it.
- No fence or wall can be built on City property or rights-of-way, but this is not intended to preclude construction within utility easements if utilities will not be damaged or made inaccessible.
- The fence or wall shall not enclose any water meter, light standard, or fire alarm box and shall not come closer than 24" from the nearest fire hydrant outlet.
- Department Inspectors must approve footings before concrete is poured and block wall reinforcing before grouting is done.
- Maximum height of any wall or fence is 6', side and rear yards; 4' maximum in front yard with the vertical surface above the height of 4' 50% open and farther than 25' of the intersection of curb faces on corner and through lots is limited to a maximum height of 30".
- I must not obstruct required on-street parking space (1 space for each dwelling unit) by the erection of this fence or wall.
- By the signing of this application I herewith agree to the requirements outlined above.

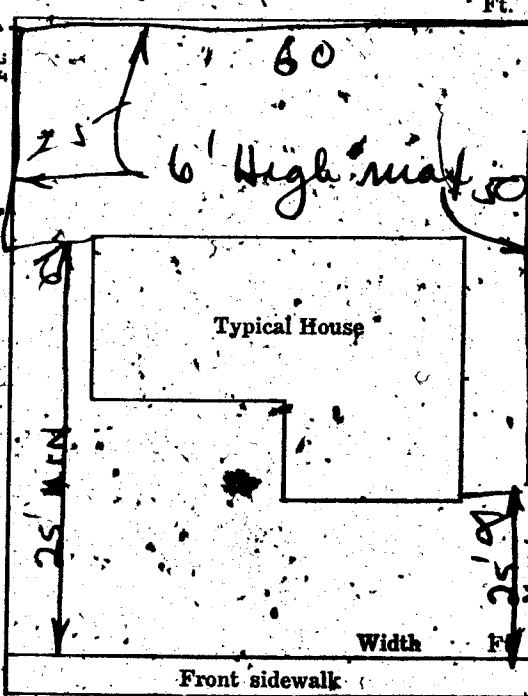

SIGNED:

CONTRACTOR ☐ AGENT ☐ OWNER ☐

DATE:

5-21-68

PLANNING DEPT:

Date:

5-23-68

ENGINEERING DEPT:

Date:

5-23-68

BUILDING DEPT:

Date:

5-23-68

#1285

PERMIT NO:

41970

PERMIT FEE \$

400

RECEIPT

050 \$004.00 - 8

CITY OF LAS VEGAS

DEPT. OF
BUILDING & SAFETY

MUST BE MACHINE VALIDATED

24 MAY 68

DEPARTMENT OF BUILDING & SAFETY
CITY OF LAS VEGAS, NEVADA

KARDEX CARD
FENCE & RETAINING
WALLS

OWNER 1st Western

DATE 5/23/68

CONTRACTOR American

PERMIT NO. 41970

LOT 15

BLOCK 4

SUBDIVISION Green Plaza #1

Wood

Fence (wire, wood, etc.)

Walls (masonry, rock, etc.)

Location

Final Inspection Q A 5-31-68

Location

Footings

Wall Steel 1st 2d 3d

Final Inspection

Retaining Wall (masonry)

Retaining Wall (concrete)

Location

Footings

Wall Steel 1st 2d 3d

Bond Beam 1st 2d 3d

Final Inspection

Location

Footings

Wall Steel 1st 2d 3d

Final Inspection

23.14 B

ADDRESS 1420 Greenbary

AREA

DEPARTMENT OF BUILDING & SAFETY
CITY OF LAS VEGAS, NEVADA

KARDEX CARD
FENCE & RETAINING
WALLS

OWNER Kenneth Cummins

ADDRESS 1420 Greenbary

DATE 5-3-65

CONTRACTOR Same

PERMIT NO. 30112

LOT 15

BLOCK 4

SUBDIVISION Green Plaza

wood fence

Fence (wire, wood, etc.)

Walls (masonry, rock, etc.)

Location

Final Inspection Q A 5-9-65

Location

Footings

Wall Steel 1st 2d 3d

Final Inspection

Retaining Wall (masonry)

Retaining Wall (concrete)

Location

Footings

Wall Steel 1st 2d 3d

Bond Beam 1st 2d 3d

Final Inspection

Location

Footings

Wall Steel 1st 2d 3d

Final Inspection

23.14 B

ADDRESS 1420 Greenbary

AREA

OWNER K. C. Cummings DEPT. of BLDG. & SAFETY—CITY of LAS VEGAS, NEVADA
GEN. CONT. Same ADDRESS 1420 Greenb are DATE 1-21-65
PERMIT NO. 316 TYPE OF STRUCTURE SFD
LEGAL DESCRIPTION Lot 15 Blk 4 Owens Plaza #1

BUILDING		MECHANICAL	ELECTRICAL
LOCATION <u>1420 Greenb are</u>	PLUMBING CONT. <u>Same</u>	TEMP. POLE CONT.	
FIREPLACE FTS <u>2</u>	PERMIT NO. <u>17489</u> DATE <u>2-22-65</u>	PERMIT NO. _____ DATE _____	
FOOTINGS <u>1-10-65</u>	HEAT & VENT. AC CONT. <u>Same</u>	INSPECTION _____ DATE _____	
FOUNDATION WALL <u>1-10-65</u>	PERMIT NO. <u>12521</u> DATE <u>2-25-65</u>	ELECTRICAL CONT. <u>Same</u>	
FLOOR FRAMING <u>1-17-65</u>	SEWER CONT. <u>Same</u>	PERMIT NO. <u>19118</u> DATE <u>2-25-65</u>	
SLAB <u>1-17-65</u>	PERMIT NO. <u>17489</u> DATE <u>2-22-65</u>	FIXTURES CONT. <u>Same</u>	
CHIMNEY STEEL (FIREPLACE)	ROUGH SOIL <u>2-12-65</u>	PERMIT NO. <u>19118</u> DATE <u>2-25-65</u>	
WALL STEEL	ROUGH WATER <u>2-12-65</u>	SLAB <u>2-12-65</u>	
COLUMN STEEL	TOP-OUT <u>3-18-65</u>	ROUGH <u>2-12-65</u>	
BEAM STEEL	ROUGH GAS <u>3-18-65</u>	FINAL ROUGH	
FRAMING <u>1-17-65</u>	AC ROUGH DUCT <u>3-23-65</u>	FINAL FIXTURE	
ROOF SHEATHING <u>3-17-65</u>	REF. ROUGH PIPING	FINAL ELECTRICAL <u>3-21-65</u>	
INTERIOR	FINAL PLUMBING <u>3-16-65</u>	TEMPORARY SERVICE	
DRYWALL <u>2-18-65</u>	FINAL GAS <u>3-16-65</u>		
LATHING	FINAL AIR COND. <u>3-16-65</u>		
BACKING (SIDING)	FINAL REFRIG. <u>3-16-65</u>		
SCRATCH	FINAL SEWER <u>3-16-65</u>		
PLASTER BROWN	FINAL SEPTIC TANK		
UNBAN REDEVELOPMENT APPROVAL			
FINAL BLDG. <u>2-4-65</u>			

APPROVED FOR OCCUPANCY & METER

INSPECTOR

DATE

PLEASE NOTE REMARKS ON REVERSE SIDE

LOG #

AREA #

234

1420 Greenb are

-T 1

2