

3904 EL PORTAL

L52 B3 Las Verdes No 5 Zone R-1

H. Batewood 3-23-79

PERMIT FEE: \$ 400

CITY OF LAS VEGAS, NEVADA
DEPARTMENT OF BUILDING & SAFETY
APPLICATION & BUILDING PERMIT
for FENCE, WALL, RETAINING WALL

CONSTRUCTION
VALUATION: \$ 639.00
INSPECTION
VALUATION: \$ 172.00

ADDRESS OF CONSTRUCTION: 3904 EL PORTAL OWNER'S NAME: Kenneth A. Allen OWNER'S ADDRESS: 3904 EL PORTAL


Lot (s) 62 Block 3 Subdivision LOS VERDES NO 5 Zone R-1

Materials of Construction: Concrete Block (x) Concrete () Wire () Wood () Other ()

Total Square Feet: Total Linear Feet 55 FT

CONTRACTOR'S NAME: OWNER STATE LICENSE # CITY LICENSE #

Architect's Name: PLANS SUBMITTED: Yes No
Engineer's Name: CALCULATIONS: Yes No

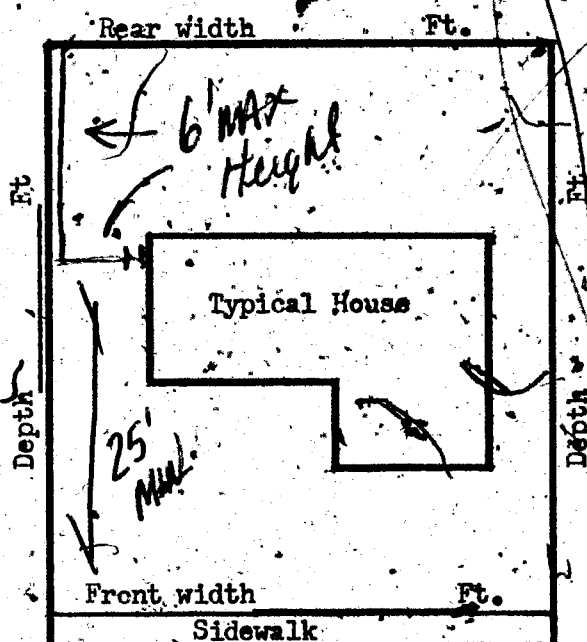

I understand that any portion of this (fence) (wall) constructed or erected on City property or right-of-way will be removed from said location at my expense upon request received from the City of Las Vegas, Nevada. I understand that the (fence) (wall) shall not enclose water meter, light standard, fire alarm box & shall not come closer than two (2') feet in any direction from any fire hydrant. I further state that I am familiar with effective Ordinances of the City of Las Vegas, Nevada & effective Statutes of the State of Nevada covering construction and use of the above type; I agree to perform said construction in conformity therewith. I further agree that issuance of a permit on above application will not excuse me from conforming with said Ordinances and Statutes, despite any errors on the part of the Building Inspector or Engineer in checking plans and applications herewith submitted. I have read and understand the contents of above application & permit; I hereby state that same are true and correct.

SIGN HERE: Kenneth A. Allen Date: 8/19

APPROVED BY:

PLANNING DEPT. & CODE ASSISTANCE DATE

FIRE DEPARTMENT DATE

ENGINEERING DEPARTMENT DATE

BUILDING & SAFETY DEPARTMENT DATE 8-19-66

#1285 PERMIT NO. 34807 PERMIT FEE \$ 400
23.14

RECEIPT
1136 \$004.00 - 8
CITY OF LAS VEGAS
DEPT. OF
BUILDING & SAFETY

Must be machine validated
22 AUG 66

H. Batewood 3-23-79

PERMIT FEE: \$ 400

CITY OF LAS VEGAS, NEVADA
DEPARTMENT OF BUILDING & SAFETY
APPLICATION & BUILDING PERMIT
for FENCE, WALL, RETAINING WALL

CONSTRUCTION
VALUATION: \$ 13900
INSPECTION
VALUATION: \$ 17200

ADDRESS OF CONSTRUCTION: 3904 EL PORTAL OWNER'S NAME: Kenneth A. Allen OWNER'S ADDRESS: 3904 EL PORTAL


Lot (s) 162 Block 3 Subdivision 165 VERDES NO 5 Zone R-1

Materials of Construction: Concrete (x) Concrete () Wire () Wood () Other ()

Total Square Feet: 8 Total Lineal Feet 55 FT

CONTRACTOR'S NAME: OWNER STATE: CITY: LICENSE #: LICENSE #:

Architect's Name: PLANS SUBMITTED: Yes No
Engineer's Name: CALCULATIONS: Yes No

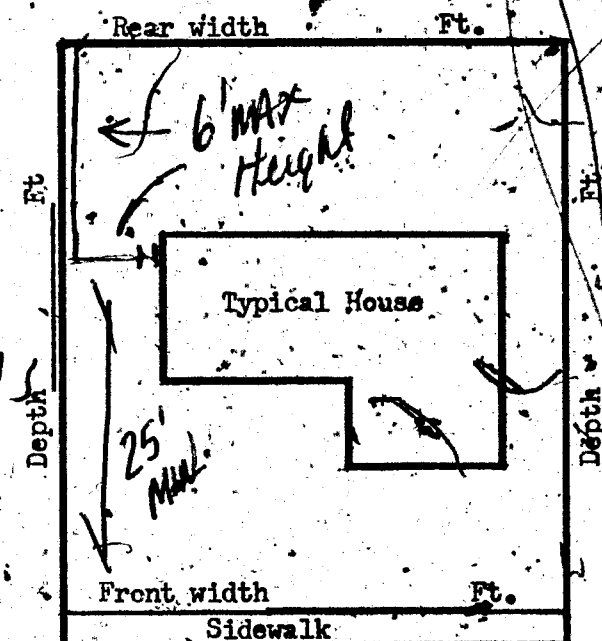

I understand that any portion of this (fence) (wall) constructed or erected on City property or right-of-way will be removed from said location at my expense upon request received from the City of Las Vegas, Nevada. I understand that the (fence) (wall) shall not enclose water meter, light standard, fire alarm box & shall not come closer than two (2') feet in any direction from any fire hydrant. I further state that I am familiar with effective Ordinances of the City of Las Vegas, Nevada & effective Statutes of the State of Nevada covering construction and use of the above type. I agree to perform said construction in conformity therewith. I further agree that issuance of a permit on above application will not excuse me from conforming with said Ordinances and Statutes, despite any errors on the part of the Building Inspector or Engineer in checking plans and applications herewith submitted. I have read and understand the contents of above application & permit; I hereby state that same are true and correct.

SIGN HERE: Kenneth A. Allen Date: 8/19/66

APPROVED BY: 8/19/66
PLANNING DEPT. & CODE ASSISTANCE DATE
FIRE DEPARTMENT DATE
ENGINEERING DEPARTMENT DATE
BUILDING & SAFETY DEPARTMENT DATE 8-19-66

#1285 PERMIT NO. 34807 PERMIT FEE \$ 400
23.14

RECEIPT
1136 \$004.00 - 8
CITY OF LAS VEGAS
DEPT. OF BUILDING & SAFETY
Must be machine validated
22 AUG 66

G. Gatewood 3-23-79

CITY OF LAS VEGAS, NEVADA

DEPARTMENT OF BUILDING & SAFETY - APPLICATION AND PERMIT FOR PLUMBING

ADDRESS OF CONSTRUCTION: 3904 El Portal

OWNER'S NAME: Freeman Robert J.

CIRCLE: New Bldg. Add'n. Remodel; TYPE OF BLDG.: SFD. APT. PUBLIC COMM.

CONTRACTOR'S NAME: Tango Pools

STATE LICENSE # 11105

CITY LICENSE # 08515

UNITS	DESCRIPTION	FEE	TOTAL
	Bathtub	1.00	
	Shower	1.00	
	Lavatory	1.00	
	Toilet	1.00	
	Urinal	1.00	
	Floor Drain	1.00	
	Floor Sink	1.00	
	Wash Tray	1.00	
	Sink	1.00	
	Garbage Disposal	1.00	
	Garbage Disposal (comm.)	3.00	
	Clothes Dryer (gas)	1.00	
	Clothes Washer	1.00	
	Clothes Washer (comm.)	5.00	
	Dishwasher	1.00	
	Dishwasher (commercial)	5.00	
	Dental Unit	10.00	
	Drinking Fountain	1.00	
	Any Water using Equipment	1.00	
	Water Heater (gas) (elect.)	1.00	
	Sewer System - New, Replacement, or any Drainage System	4.00	
	Grease or Sand Trap	2.00	
	Trailer Trap	2.00	
	Septic Disposal System	4.00	
WATER SOFTENERS			
	Nonpermanent Type	4.00	
	Permanent Type (connected to Drainage)	5.00	
SWIMMING POOLS			
	Private or Wading Pool	10.00	10.00
	Public or Semi public	20.00	

UNITS	DESCRIPTION	FEE	TOTAL
WATER DISTRIBUTION SYSTEM			
	Single Family Dwelling	4.00	
	Multiple Family Dwelling plus each unit	4.00 2.00	
	Bldg. Group "A" thru "G" per each floor	6.00	
	Hotel or Motel plus each bath	4.00 1.50	
	Trailer Park plus each space	20.00 1.00	
	Irrigation	4.00	
GAS PIPING SYSTEM			
	Single Family Dwelling	3.00	
	Multiple Family Dwelling plus each unit	6.00 1.00	
	Commercial Bldg. per floor plus each unit	3.00 3.00	
	Gas Appliance (any type)	1.00	
AUTOMATIC FIRE EXTINGUISHING SYSTEM			
	Underground Piping	10.00	
	Distribution Piping ea. ft.	.01	
	Sprinkler Head each	1.00	
	In Range Hood and Vent	5.00	
DRY STANDPIPE SYSTEM			
	Piping	50.00	
	Each Outlet	1.00	
WET STANDPIPE SYSTEM			
	Piping	5.00	
	Fire Hose Cabinet	1.00	
MINIMUM PERMIT FEE			
PIPELINE CONTRACTOR, SECT. 14 B.P.F.		4.00	
TOTAL PERMIT FEE \$		10.00	

I hereby certify that I have carefully examined and read the above application, that the same is true and correct, and that the work herein described is to be done in accordance with all the provisions of the applicable Ordinances of the City of Las Vegas, Nevada and the State Laws, whether herein specified or not.

Approval for the work under this permit will be given only after refuse and debris have been removed from job site and public right of way.

Signed Tango Pools Registered Master Plumber, Spec. Cont'r. or Owner

Date: 5/29/73

Building Department

Date: 5/29/73

Permit No. 10539 Permit Fee \$ 10.00

#12870

RECEIPT

T310 \$010.00 - 7

CITY OF LAS VEGAS
DEPT. OF
BUILDING & SAFETY

MUST BE MACHINE VALIDATED

29 MAY 73

G. Gatewood 3-23-79

CITY OF LAS VEGAS, NEVADA
DEPARTMENT OF BUILDING & SAFETY

RECEIPT
FOR
SEWER CONNECTION FEE

JOB ADDRESS: 3904 El Portal

OWNER'S NAME: Freeman, Robert Jr.

LOT 62

BLOCK 4

SUBDIVISION

Las Vegas Hgts 5

QUANTITY	OCCUPANCY	UNIT FEE	AMOUNT
1	private swimming pool	37.50	

PAID BY:

Jungo Pools

TOTAL

37.50

Less Credit*

TOTAL FEE \$

37.50

*Credit for existing sewer is applied to the new sewer connection fee based on previous type of occupancy and only when the new occupancy requires an additional fee.

This receipt does not authorize the owner or his representative to start any work without obtaining a plumbing permit.

DEPARTMENT OF BUILDING & SAFETY

DATE

5/29/73

RECEIPT NO.

10540

SEWER FEE \$

37.50

73102

RECEIPT

7311

\$037.50 - 3

CITY OF LAS VEGAS
DEPT. OF
BUILDING & SAFETY

MUST BE MACHINE VALIDATED

29 MAY 73

H. Gatewood 3-23-79

CITY OF LAS VEGAS, NEVADA
DEPARTMENT OF BUILDING & SAFETY

**RECEIPT
FOR
SEWER CONNECTION FEE**

JOB ADDRESS: 3904 El Portal

OWNER'S NAME: Freeman, Robert, Jr.

LOT 62 BLOCK 4

SUBDIVISION Las Vegas Hgts 5

QUANTITY	OCCUPANCY	UNIT FEE	AMOUNT
1	private swimming pool	37.50	

PAID BY: Jungo Goals

TOTAL 37.50

Less Credit

TOTAL FEE \$ 37.50

*Credit for existing sewer is applied to the new sewer connection fee based on previous type of occupancy and only when the new occupancy requires an additional fee.

This receipt does not authorize the owner or his representative to start any work without obtaining a plumbing permit.

DEPARTMENT OF BUILDING & SAFETY

DATE

RECEIPT NO. 10540

SEWER FEE \$ 37.50

73102

RECEIPT

7311 \$037.50 - 3

CITY OF LAS VEGAS
DEPT. OF
BUILDING & SAFETY

MUST BE MACHINE VALIDATED

29 MAY 73

B. Gatewood 3-23-79

CITY OF LAS VEGAS, NEVADA

BUILDING AND SAFETY DEPARTMENT - APPLICATION AND PERMIT FOR SWIMMING POOL

LOG No. M-226

Const. valuation \$ 2136

ADDRESS OF CONSTRUCTION:

3904 El Portal

OWNER'S NAME:

Freeman, Robert J.

LOT

602

BLOCK

4

SUBDIVISION

LAS VERDES Hg 1500

CIRCLE TYPE OF POOL THAT APPLIES: Private ☒

Semi-public ☐

Public ☐

MATERIALS OF CONSTRUCTION: Reinforced gunite ☐

Reinforced concrete ☐

Other ☒

SQUARE FEET OF SURFACE AREA:

334

VOLUME IN GALLONS

14,868

ARCHITECTS NAME:

ENGINEER NAME:

PLANS SUBMITTED: Yes ☐ No ☒

CALCULATIONS SUBMITTED: Yes ☐ No ☒

CONTRACTOR'S NAME:

Tony Pools

State

License # 11105

City

License # 08515

ADDITIONAL PERMITS REQUIRED: Electrical ☐

Plumbing ☐

Other ☐

Sewer fee req'd: Yes ☐ No ☒

I state that I am familiar with effective Ordinances of the City of Las Vegas, Nevada, and effective Statutes of the State of Nevada covering construction and use of the above type; I agree to perform said construction in conformity therewith. I further agree that issuance of a permit on above application will not excuse me from conforming with said Ordinances and Statutes despite any errors on the part of the building Inspector or Engineer in checking plans and application herewith submitted.

All swimming pools must be fenced before the pool is filled with water. No electric lines shall go over a pool.

I have read and understand the contents of above application; I hereby state that same are true and correct.

I also agree to repair any utility line if damaged during excavation work.

Signed: Tony Pools
(Contractor)

By: Tony Pools
(Agent of Owner)

CITY SWIMMING POOL ORDINANCE

Applicant must have separate plot plan showing location of power pole, proposed or existing pool fencing and location of swimming pool.

The Contractor's signature above denotes authority from the owner to sign on his behalf and that the owner is aware of all requirements of this application. Separate permits must be obtained for electrical and plumbing work.

APPROVED BY:

PLANNING DEPT. [Signature]

DATE 5/24/73

PUBLIC WORKS DEPT. WR3

DATE 5/29/73

BUILDING DEPT. 11549

DATE 5/29/73

PERMIT No.

11549

PERMIT FEE: \$

18.00

RECEIPT

7308 \$018.00 - 8

CITY OF LAS VEGAS

DEPT. OF BUILDING & SAFETY

MUST BE MACHINE VALIDATED

29 MAY 73

12850

B. Gatewood 3-23-79

CITY OF LAS VEGAS, NEVADA

DEPARTMENT OF BUILDING & SAFETY — ELECTRICAL APPLICATION & PERMIT

ADDRESS OF CONSTRUCTION: 3904 E1 Portal Avenue

OWNER'S NAME: Freeman

CIRCLE: New Bldg.; Add'n; Remodel; TYPE OF BLDG.: SFD. APT. PUBLIC COMM. Swimming Pool

CONTRACTOR'S NAME: Poser Electric Inc.

STATE LICENSE #: 11117

CITY LICENSE #: CH-7421

NUMBER	FIXTURE OR INSTALLATION	UNIT PRICE	
1	Fixture or sockets	.15	.15
2	Light, receptacle or switch outlet	.20	.40
	Wall or ceiling space heater	.35	
	Blast coil heater per kilowatt	.35	
	Garbage grinder outlet	.35	
	Dishwasher outlet	.35	
	Clothes dryer outlet	.35	
	Automatic clothes washer	.35	
	Electric range outlet	.35	
	Electric water heater outlet	.35	
	Mercury arc lamp and equipment	.35	
	Special purpose outlet	.35	
	X-ray unit and its appurtenances	5.00	
	Watts of festoon lighting (Watts) First 3,000 watts for each additional thousand watts	4.00 1.50	
I	Horsepower — all motors first horsepower or less for each additional horsepower	1.75 .35	1.75
	Temporary power and lights (temporary pole)	4.00	
	Electric service (including any single meter socket) for each additional socket	3.00 .35	
	Air conditioning service amps	1.50	
	Each KW (KVA) Generator (Transformer) (Welder) KW (KVA) First 100 KVA — For each additional KW (KVA)	2.00 .01	
	Special inspection per hour	4.00	
	Speaker outlets	.15	
	Signal or Alarm outlets	.15	
	Amplifiers	.50	
	Control panels	.25	
	T. V. outlets — master system only	.15	
	Radio outlets	.15	
	Main control racks	1.00	
	T. V. and Radio antennas — master system only	.75	
	Minimum fee for any permit	4.00	
	Total fee		4.00

I hereby certify that I have carefully examined and read the above application; that the same is true and correct; and that the work herein described is to be done in accordance with all the provisions of the applicable Ordinances of the City of Las Vegas, Nevada and State laws whether herein specified or not.

SIGNED Richard Poser MASTER (ELECTRICIAN) (TECHNICIAN) (OWNER)

DATE 5-30-73

BUILDING DEPARTMENT N. M. Miller

DATE

#12860 PERMIT NO. 6635

PERMIT FEE: \$ 4.00

RECEIPT

7638 \$004.00 - 6

CITY OF LAS VEGAS
MUST BE MACHINE VALIDATED
DEPT. OF
BUILDING & SAFETY

G. Gatewood 3-23-79

1-12

CITY OF LAS VEGAS, NEVADA

LOG NO. & AREA

DEPARTMENT OF BUILDING & SAFETY

APPLICATION & BUILDING PERMIT for:
Fence, Wall, Retaining Wall.

CONST. VAL. \$ 1242

ADDRESS OF CONSTRUCTION:

3904 ELPONTEL

OWNER:

BOB FREEMAN

LOT(s):

62

BLOCK

4

SUBDIVISION

LAS VEGAS HTS UNIT 5

ZONE:

R-1

Materials of Construction:

Block

☒

Concrete

☐

Wire

☐

Wood

☐

Other

☐

Yes No

PLANS:

☐

☐

ARCHITECT:

ENGINEER:

CALCS:

☐

☐

CONTRACTOR:

acura

STATE LICENSE #

CITY LICENSE #

TOTAL SQUARE FEET:

828


TOTAL LINEAL FEET:

138'

Remarks:

CONDITIONS OF THE PERMIT:

1. Any type of retaining wall must be engineered by a Civil or Structural Engineer.
2. If a home owner takes out the Building Permit and if the owner sublets the work to a Contractor, then the Contractor must take out the permit and pay for it.
3. No fence or wall can be built on City property or rights-of-way, but this is not intended to preclude construction within utility easements if utilities will not be damaged or made inaccessible.
4. The fence or wall shall not enclose any water meter, light standard, or fire alarm box and shall not come closer than 24" from the nearest fire hydrant outlet.
5. Department Inspectors must approve footings before concrete is poured and block wall reinforcing before grouting is done.
6. Maximum height of any wall or fence is 6' side and rear yards; 4' maximum in front yard with the vertical surface above the height of 2' - 50% open.
7. I must not obstruct required onsite parking space (2 spaces for each dwelling unit) by the erection of this fence or wall.
8. By the signing of this application I herewith agree to the requirements outlined above.

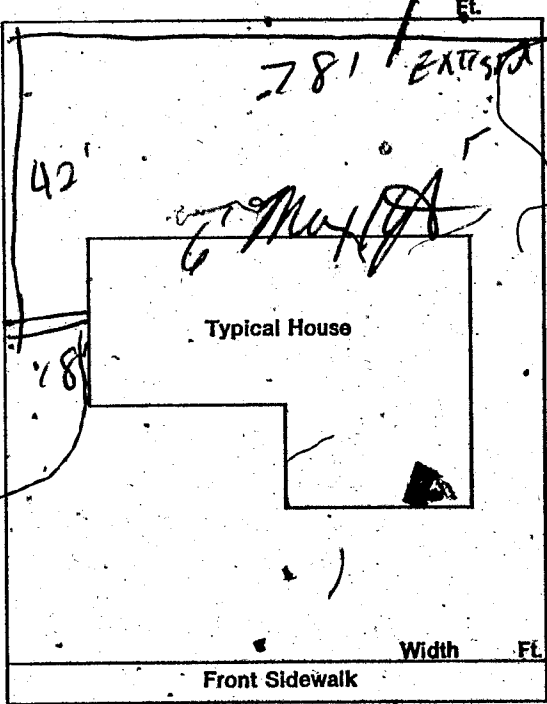

Bob Freeman by

SIGNED:

Rich Russo

DATE:

CONTRACTOR ☐

AGENT ☐

OWNER ☐

PLANNING DEPT:

Date:

5-2-77

PUBLIC WORKS DEPT:

Date:

5/2/77

BUILDING DEPT:

Date:

5/2/77

#12850

PERMIT NO:

2402

PERMIT FEE \$

1500

RECEIPT

9933 \$015.00 - 8

CITY OF LAS VEGAS

DEPT. OF BUILDING & SAFETY

MUST BE MACHINE VALIDATED

- 2 MAY 77

These, Kipakes 9-15-81

DEPARTMENT OF BUILDING & SAFETY
CITY OF LAS VEGAS, NEVADA

KARDEX CARD
FENCE & RETAINING
WALLS

DATE 8/19/66

OWNER Kennet Allen

PERMIT NO. 31807

CONTRACTOR Owner

LOT 52

BLOCK 1

SUBDIVISION Las Vegas No. 5

Block Fence

Fence (wire, wood, etc.)

Walls (masonry, rock, etc.)

Location
Final Inspection

Location
Footings
Wall Steel 1st 2d 3d
Final Inspection

Retaining Wall (masonry)

Retaining Wall (concrete)

Location
Footings
Wall Steel 1st 2d 3d
Bond Beam 1st 2d 3d
Final Inspection

Location
Footings
Wall Steel 1st 2d 3d
Final Inspection

23.14 B

ADDRESS 3904 El Portal

LOG NO.

AREA

Department of Building & Safety
City of Las Vegas, Nevada

Special Kardex 7

Elect. only - Plbg. only - A.C. only

Owner Lido Homes

Address 3904 El Portal

Date 12-3-64

Contractor Paradise Lawn Sprinklers

Permit No.

Lot Block Subdivision

Electric Only	Plumbing Only	Heat & Vent - A.C. Only
Contractor	Contractor Paradise Lawn	Contractor
Permit No.	Permit No. 17146	Permit No.
Slab	Rough Soil	A.C. Rough Duct
Rough Elect.	Rough Water	Ref. Ro. Piping
Final Rough	Top Out	Rough Gas
Final Fixture	Rough Gas	Final Refrig.
Final Elect.	Final Plbg. 12/4/64	Final Air Cond.
Temp. Service	Final Gas	Final Gas
	Final Sewer	
	Final Septic Tank	

23.06 D

Address 3904 El Portal

Log. No.

Area irrigation system

These Equates 9-15-81

DEPARTMENT OF BUILDING & SAFETY
CITY OF LAS VEGAS, NEVADA

KARDEX CARD
SWIMMING POOL

OWNER Robert S Freeman

DATE 5/30/73

CONTRACTOR TANGO POOLS

PERMIT NO. 11549

LOT 62 BLOCK SUBDIVISION Las Verdes Hgts

LOCATION

FINAL PLUMBING 4/4/77-73

ROUGH SOIL

FINAL ELECTRIC 7/8-28-73

ROUGH WATER 4/7-30-73

FINAL GAS

ROUGH GAS

FINAL SEWER

ROUGH ELECTRIC 1st 2d 3d

FINAL SEPTIC TANK

STEEL INSPECTION

Tango Pools sewer #10540

" " Plbg 10533 FINAL POOL INSPECTION 5-1-73

DATE

Pover-Elle-6635

(Inspector)

23.24 B ADDRESS 3904 El Portal LOT NO. M226

AREA

DEPARTMENT OF BUILDING & SAFETY
CITY OF LAS VEGAS, NEVADA

KARDEX CARD
FENCE & RETAINING
WALLS

OWNER Bob Freeman

DATE 5-2-77

CONTRACTOR Owner

PERMIT NO. 2402

LOT BLOCK SUBDIVISION block fence

Fence (wire, wood, etc.)

Walls (masonry, rock, etc.)

Location

Location HB 5-10-77

Final Inspection

Footings HB 5-10-77

Wall Steel 1st 2d 3d

Final Inspection HB 5-19-77

Retaining Wall (masonry)

Retaining Wall (concrete)

Location

Location

Footings

Footings

Wall Steel 1st 2d 3d

Wall Steel 1st 2d 3d

Bond Beam 1st 2d 3d

Final Inspection

Final Inspection

House & duplex 9-15-81

DEPT. OF BLDG & SAFETY - CITY OF LAS VEGAS, NEVADA			
OWNER <u>C. J. TIFFANY</u>		ADDRESS <u>3904 El Portal</u>	
GEN. CONT. <u>J. B. J. INVESTMENT CO</u>		DATE <u>11-14-62</u>	
PERMIT NO. <u>3990</u>		TYPE OF STRUCTURE <u>SED</u>	
LEGAL DESCRIPTION <u>Lot 62, Blk 4, Las Verdes</u>			
BUILDING		MECHANICAL	
ELECTRICAL		MISCELLANEOUS	
LOCATION <u>12-5-62</u>	PLUMBING CONT. <u>Hammond</u>	TEMP POLE CONT. <u>✓</u>	
FIREPLACE <u>12-5-62</u>	PERMIT NO. <u>5477</u> DATE <u>11-14-62</u>	PERMIT NO. _____ DATE _____	
FOOTINGS <u>12-5-62</u>	HEAT & VENT. AC CONT. <u>Hammond</u>	INSPECTION _____ DATE _____	
FOUNDATION WALL _____	PERMIT NO. <u>5658</u> DATE <u>12-27-62</u>	ELECTRICAL CONT. <u>Deane Valley</u>	
STEM WALL _____	SEWER CONT. _____	PERMIT NO. <u>4426</u> DATE <u>12-8-62</u>	
FLOOR FRAMING _____	PERMIT NO. _____ DATE _____	FIXTURES CONT. _____	
SLAB _____	ROUGH SOIL <u>5-12-46</u>	PERMIT NO. _____ DATE _____	
CHIMNEY/STOVE/FIREPLACE _____	ROUGH WATER <u>5-12-46</u>	SLAB _____	
WALL STEEL _____	TOP-OUT <u>5-12-46</u>	ROUGH _____	
CEILING STEEL _____	ROUGH GAS _____	FINAL ROUGH _____	
BEAM STEEL _____	AC ROUGH DUCT <u>5-12-46</u>	FINAL FIXTURE _____	
STEEL FABRICATION _____	REF. ROUGH PIPING _____	TEMPORARY SERVICE _____	
FRAMING <u>12-5-62</u>	FINAL PLUMBING <u>5-12-46</u>		
ROOF SHEATHING <u>12-5-62</u>	FINAL GAS _____		
INTERIOR _____	FINAL AIR COND. <u>5-12-46</u>		
EXTERIOR _____	FINAL REFRIG. _____		
BRICK/STUCCO _____	FINAL SEWER <u>5-12-46</u>		
LATHING _____	FINAL SEPTIC TANK _____		
BACKING (SIDING) _____			
PLASTER <u>SCRATCH</u>			
PLASTER <u>BROWN</u>			
FINAL BLDG _____			
DATE <u>5-12-63</u>			
APPROVED FOR OCCUPANCY <u>5-12-63</u> INSPECTOR _____		DATE _____	
APPROVED FOR METER <u>5-12-63</u>			
PLEASE NOTE REMARKS ON REVERSE SIDE			

3904 El Portal T71 4