

· 3705 El Conlon Ave ·

· L2 B3 Las Verdes #6 Unit #3 Zone R-1 ·

M. Gatewood 4-9-79

CITY OF LAS VEGAS, NEVADA  
DEPARTMENT OF BUILDING AND SAFETY  
APPLICATION FOR FENCE, WALL OR  
RETAINING WALL

LOG NO. \_\_\_\_\_  
AREA: 41  
KARDEX CARD: \_\_\_\_\_  
TELEPHONE: \_\_\_\_\_

CONSTRUCTION VALUATION: \$341.00  
INSPECTION VALUATION: \$271.00  
PERMIT FEE: \$4.00  
PERMIT NUMBER: 31026  
DATE: 7-29 1965

ADDRESS OF CONSTRUCTION: 3705 EL CONDON OWNER'S NAME: Miss. Parsey

Lot (s) 2 Block B Subdivision Las Vegas #6 Unit 3 Zone: R-1  
Materials of Construction: Block ( ) Concrete ( ) Wire ( ) Wood  Other ( )

Total Square Feet: \_\_\_\_\_ Total Linear Feet: 271

CONTRACTOR'S NAME: OWNER STATE LICENSE # \_\_\_\_\_ CITY LICENSE # \_\_\_\_\_

Architect's Name: \_\_\_\_\_ PLANS SUBMITTED: Yes \_\_\_\_\_ No \_\_\_\_\_  
Engineer's Name: \_\_\_\_\_ CALCULATIONS: Yes \_\_\_\_\_ No \_\_\_\_\_

Street Name: EL CONDON  
Front Yard: 63' Feet

I understand that any portion of this (fence) (wall) constructed or erected on City property or right-of-way will be removed from said location at my expense upon request received from the City of Las Vegas, Nevada. I understand that the (fence), (wall) shall not enclose water meter, light standard, fire alarm box and shall not come closer than two (2') feet in any direction from any fire hydrant. I further state that I am familiar with effective Ordinances of the City of Las Vegas, Nev. and effective Statutes of the State of Nevada covering construction and use of above type; I agree to perform said construction in conformity therewith. I further agree that issuance of a permit on above application will not excuse me from conforming with said Ordinances and Statutes, despite any errors on the part of the Building Inspector or Engineer in checking plans and applications herewith submitted.

I have read and understand the contents of above application; I hereby state that same are true and correct.


S. GN HERE: Miss. Parsey  
By: \_\_\_\_\_

APPROVED BY: 7/29/65  
PLANNING DEPT. & CODE ASSISTANCE DATE:

FIRE DEPARTMENT DATE:

ENGINEERING DEPT. DATE:

BUILDING & SAFETY DEPT. 7/29/65 DATE:

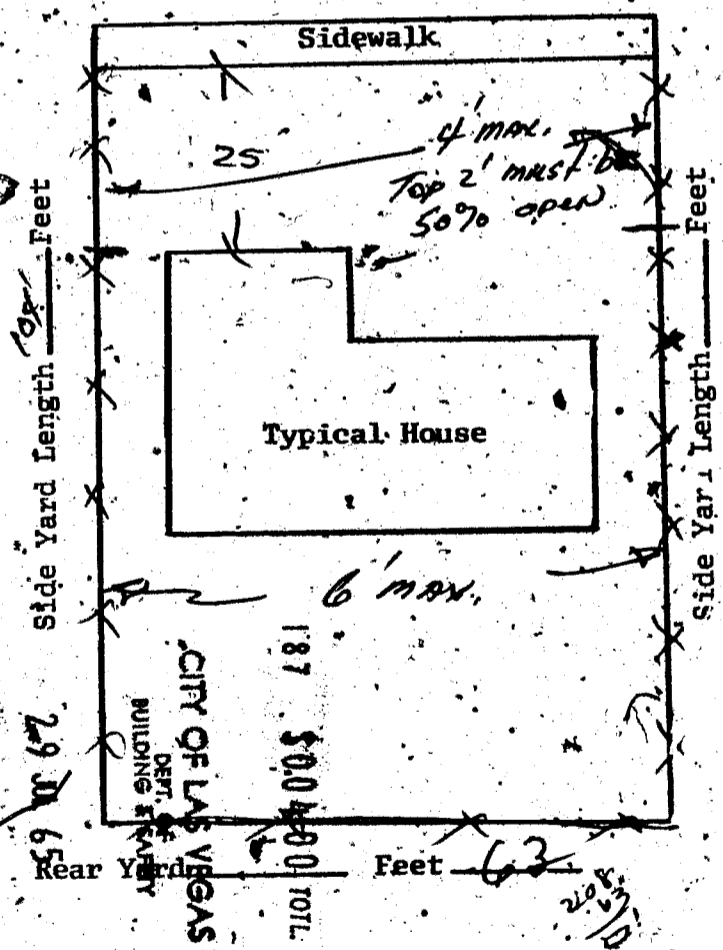

Note: Owner or Contractor must call for all inspections required.

DEPARTMENT OF BUILDINGS  
CITY OF LAS VEGAS, NEVADA

**BARRIER CARD**  
**FENCE & RETAINING**  
**WALLS**

OWNER: Chas Dorsey

DATE 7-29-65

CONTRACTOR Same

PERMIT NO. 31026

LOT 2

BLOCK 6

SUBDIVISION Las Verdes 6-3

wood fence

Fence (wire, wood, etc.)		Walls (masonry, rock, etc.)	
Location _____		Location _____	
Final Inspection <u>8/10/65</u>		Footings _____	
		Wall Steel 1st _____ 2d _____ 3d _____	
		Final Inspection _____	
Retaining Wall (masonry)		Retaining Wall (concrete)	
Location _____		Location _____	
Footings _____		Footings _____	
Wall Steel 1st _____ 2d _____ 3d _____		Wall Steel 1st _____ 2d _____ 3d _____	
Bond Beam 1st _____ 2d _____ 3d _____		Final Inspection _____	
Final Inspection _____			

23.14 B

ADDRESS 3705 El Conlon

LOG NO. \_\_\_\_\_

AREA \_\_\_\_\_

DEPT. of BLDG & SAFETY - CITY of LAS VEGAS, NEVADA

OWNER Charlest M. Dorsey ADDRESS 3705 El Conlon DATE 12-2-64

GEN. CONT. Owner

PERMIT NO. 28464 LEGAL DESCRIPTION Lot 2 block 6 Las Verdes # 6 TYPE OF STRUCTURE garage remodel  
patio cover

BUILDING		MECHANICAL		ELECTRICAL	
LOCATION		PLUMBING CONT.		TEMP. POLE CONT.	
FIREPLACE FTG.		PERMIT NO. _____ DATE _____		PERMIT NO. _____ DATE _____	
FOOTINGS		HEAT & VENT. & C. CONT.		INSPECTION _____ DATE _____	
FOUNDATION WALL		PERMIT NO. _____ DATE _____		ELECTRICAL CONT.	
FLOOR FRAMING		SEWER CONT.		PERMIT NO. _____ DATE _____	
SLAB		ROUGH SOIL		FIXTURES CONT.	
CHIMNEY STEEL (FIREPLACE)		ROUGH WATER		PERMIT NO. _____ DATE _____	
WALL STEEL		TQP-OUT		SLAB	
COLUMN STEEL		ROUGH GAS		ROUGH <u>12/2/64</u>	
BEAM STEEL		A/C ROUGH DUCT		FINAL ROUGH	
FRAMING		REF. ROUGH PIPING		FINAL FIXTURE	
ROOF SHEATHING		FINAL PLUMBING		FINAL ELECTRICAL	
DRYWALL	INTERIOR _____ EXTERIOR _____	FINAL GAS		TEMPORARY SERVICE	
LATHING		FINAL AIR COND.			
BACKING (SDWS)		FINAL REFRIG.		MISCELLANEOUS	
PLASTER	SCRATCH _____ BROWN _____	FINAL SEWER			
URBAN REDEVELOPMENT APPROVAL		FINAL SEPTIC TANK			
FINAL BLDG _____ DATE <u>3/2/65</u>					

APPROVED FOR OCCUPANCY (METER W O D 3-24-65) INSPECTOR \_\_\_\_\_ DATE \_\_\_\_\_

PLEASE NOTE REMARKS ON REVERSE SIDE

705 El Conlon

LOG #

AREA #

23 0

DEPT. of BLDG. & SAFETY - CITY of LAS VEGAS, NEVADA

OWNER DURCO CORP ADDRESS 3705 El Conlon DATE 12-5-62  
 GEN. CONT. D. L. Bradley TYPE OF STRUCTURE FD  
 PERMIT NO. 14318 LEGAL DESCRIPTION Lot 2, Blk 3, Las Vegas 6-3

BUILDING		MECHANICAL		ELECTRICAL		
LOCATION <u>3705 El Conlon</u>	PLUMBING CONT.	PERMIT NO.	DATE	TEMP POLE CONT.	PERMIT NO.	DATE
FIREPLACE FTG.	HEAT & VENT. AC. CONT.	INSPECTION	DATE	ELECTRICAL CONT.	PERMIT NO.	DATE
FOUNDATIONS	SEWER CONT.	FIXTURES CONT.	DATE	SLAB	PERMIT NO.	DATE
FOUNDATION WALL	ROUGH SOIL	ROUGH	DATE	FINAL ROUGH	PERMIT NO.	DATE
STEM WALL	ROUGH WATER	FINAL FIXTURE	DATE	TEMPORARY SERVICE		
FLOOR FRAMING	TOP-OUT	MISCELLANEOUS				
SLAB	ROUGH GAS	URBAN REDEVELOPMENT APPROVAL				
CHIMNEY STEEL (FIREPLACE)	AC-ROUGH DUCT	GRAVING & DRAINAGE				
WALL STEEL	REF. ROUGH PIPING	ON-SITE PARKING SPACES				
COLUMN STEEL	FINAL PLUMBING	ENG. APPROVAL OF				
BEAM STEEL	FINAL GAS	OFF-SITE IMPROVEMENTS				
STEEL FABRICATION	FINAL AIR COND.					
FRAMING	FINAL REFRIG.					
ROOF SHEATHING	FINAL SEWER					
INTERIOR	FINAL SEPTIC TANK					
EXTERIOR						
DRYWALL						
LATHING						
BACKING (SHEATHING)						
PLASTER						
SCRAATCH						
BROWN						
FINAL BLDG						

APPROVED FOR OCCUPANCY K.L. 6-6-62 INSPECTOR \_\_\_\_\_ DATE \_\_\_\_\_  
 APPROVED FOR METER M. Miller 6-6-63 \_\_\_\_\_ DATE \_\_\_\_\_  
 PLEASE NOTE REMARKS ON REVERSE SIDE

3705 El Conlon

776

4

23.04