

201 Falcon Lane

L17 B2 Sub. Char. Hgts. Tr. #31-B Zone R-1

Gloria Natuval May 16, 1979

1967

LOG NO. & AREA R-71/4 CITY OF LAS VEGAS, NEVADA CONST. VAL. \$ 14,275.00

DEPARTMENT OF BUILDING & SAFETY APPLICATION & BUILDING PERMIT — for:
Dwellings, Duplexes, Misc. Residential Const.

ADDRESS OF CONSTRUCTION: 201 Falcon Lane OWNER: Northwest Const. Co.

LOT(s) 17 BLOCK 2 SUBDIVISION Charleston Heights Tract 31-B ZONE: R-1

Existing structure on lot: Dwelling ☐ Accessory bldgs. ☐ Vacant lot ☒ Other ☐

PROPOSED CONSTRUCTION: S.F. Res. USE: S.F. Res.

MATERIALS OF CONSTRUCTION: Wood Frame ☒ Concrete Block ☐ Reinforced Concrete ☐ Steel Frame ☐

SQUARE FEET OF FLOOR AREAS: 1st: 1300 2nd: 1274+ 3rd: 505 Other: 505 TOTAL SQ. FT. 3079


FIRE ZONE: 1 2 3 3 Occupancy Group A B C D E F G H I J 1-2-3-4-5, CONST. TYPE: I II III IV V

ARCHITECT: _____ ENGINEER: _____ NO. of UNITS 1 NO. of STORIES 1

Plans Submitted: Yes ☒ No ☐ Calculations Submitted: Yes ☐ No ☐ Sewer Fee Req'd. Yes ☒ No ☐

CONTRACTOR: Northwest Const. Co. STATE LICENSE # 9599 CITY LICENSE # C11-3332

ADD'L. PERMITS REQ'D.: Air Cond. ☐ Elec. ☒ Plumbing ☒ Signs ☐ Paving ☐ Fence ☐ Public Walks ☐ Curb-gutters ☐
Incinerators ☐ Fire Sprinkling System ☐

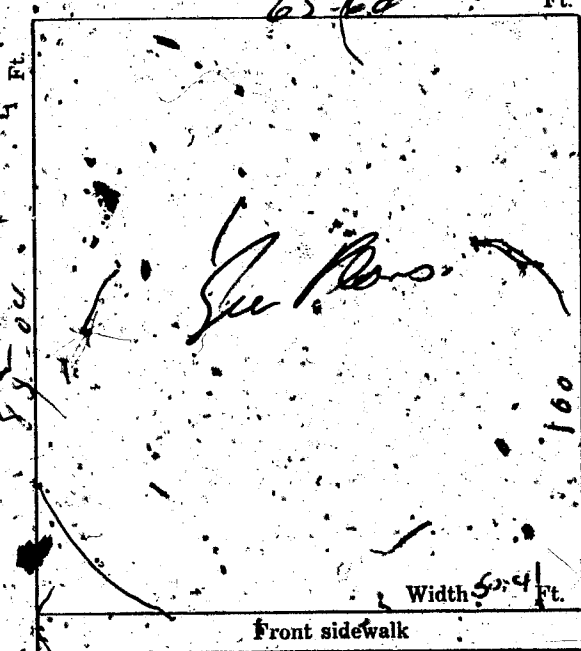

CONDITIONS OF THE PERMIT:

1. I agree to call the City Building Department for inspections before concrete is poured, before rough wiring, electrical, plumbing, framing is covered. Also for Air conditioning, sheet-rock and sheathing inspection.
2. I agree that when the job is completed that I will call for final inspection before occupancy.
3. I agree to perform all construction in accordance with City Ordinances and Building Codes.
4. The Contractor's signature below denotes authority from the owner to sign in his behalf and that the owner is aware of all requirements of this application and permit. Separate permits must be taken out for work noted above this agreement.
5. I have read and understand the content of this application and permit; I hereby certify that the information I have supplied on this application is true and correct.

SIGNED: Northwest Const. Company Contractor

BY: John Skaggs Agent or Owner

CLARK COUNTY HEALTH DEPT. Date: 11/2/67

LAS VEGAS FIRE DEPARTMENT Date: _____

PLANNING DEPT.: [Signature] Date: 11/2/67

ENGINEERING DEPT.: [Signature] Date: 11-9

BUILDING DEPT.: [Signature] Date: 11-14-67

#1285 PERMIT NO: 39363 PERMIT FEE \$ 76.50

RECEIPT

1061 \$076.50 - 8

CITY OF LAS VEGAS
DEPT. OF
BUILDING & SAFETY

MUST BE MACHINE VALIDATED

17 NOV 67

Florida National May 10/1979

CITY OF LAS VEGAS, NEVADA
DEPARTMENT OF BUILDING & SAFETY

SEWER CONNECTION FEE: \$ 150⁰⁰

RECEIPT
for
SEWER CONNECTION FEE

JOB ADDRESS: 201 Falcon OWNER'S NAME: Northwind Court Co
LOT 17 BLOCK 2 SUBDIVISION Charleston Heights Tract 31-B

QUANTITY	OCCUPANCY	UNIT FEE	AMOUNT
1	I, J, - S.F. Dwelling	150 ⁰⁰	150 ⁰⁰
TOTAL			150 ⁰⁰
Less Credit*			0
TOTAL FEE \$			150 ⁰⁰

*Credit for existing sewer is applied to the new sewer connection fee based on previous type of occupancy and only when the new occupancy requires an additional fee.

This receipt does not authorize the owner or his representative to start any work without obtaining a plumbing permit.

DEPARTMENT OF BUILDING & SAFETY DATE 11-16-67

#1287 RECEIPT NO. 22305 SEWER FEE \$ 150⁰⁰

23.30

Receipt

1062 \$150.00 3

CITY OF LAS VEGAS
DEPT. OF
BUILDING & SAFETY

Must be machine validated
17 NOV 67

Gloria Watson May 16, 1979

CITY OF LAS VEGAS, NEVADA
DEPARTMENT OF BUILDING & SAFETY

PERMIT FEE \$
APPLICATION & PERMIT FOR
PLUMBING

JOB ADDRESS: 201 Falcon NAME: Crestmont East

LOT BLOCK SUBDIVISION Bldg. type: SED APT COMM

Circle: New bldg; Old bldg; Add'n; Remodel; Pool; Wtr. Sftner; Lawn Sprkr; Other

CONTRACTOR: Bigelow, D/B/ State Lic #33417CNY Lic. # 2201

QUANTITY	FIXTURE OR INSTALLATION	Unit Price	AMOUNT
1	Bathtub	1.00	1.00
	Clothes dryer (gas)	1.00	
1	Clothes washer	1.00	1.00
	Dental unit	1.00	
	Dishwasher	1.00	
	Drinking fountain	1.00	
	Fire sprinkling - underground piping	5.00	
	Fire sprinkling - distribution piping per each foot	.01	
	Fire sprinkling heads - per each head	.10	
	Floor drain \$1.00 Floor sink	1.00	
	Gas appliance (any type)	1.00	
	Gas piping system - single family dwelling	3.00	
	Gas piping system - multiple family \$3 per each unit plus	1.00	
	Gas piping system - commercial bldg. per each floor	3.00	
	Grease trap	1.00	
	Irrigation system	4.00	
1	Lavatory	1.00	1.00
	Minimum fee for any permit	4.00	
1	Piping; Drainage	4.00	4.00
	Sewer replacement	4.00	
	Septic disposal system - Health Dept. approval required	4.00	
1	Shower	1.00	1.00
1	Sink - kitchen type	1.00	1.00
	Swimming pool - private - wading pool	8.00	
	Swimming pool - public - semi-public	12.00	
1	Toilet	1.00	1.00
	Urinal	1.00	
1	Water distribution system, single family dwelling	4.00	4.00
	Water distribution system multiple dwg. \$4 + each unit	1.00	
	Water distribution system, Group "A" thru "G" per each floor	4.00	
	Water distribution system, Group "H" (hotel) \$4 + per bath	.50	
1	Water heater (gas) (electric)	1.00	1.00
	Water using equipment	1.00	
	Water softener nonpermanent type	4.00	
	Water softener permanent (connected to drainage)	5.00	
	Wash tray	1.00	

I hereby certify that I have carefully examined & read the above application; that the same is true & correct; and the work herein described is to be done in accordance with the provisions of City of Las Vegas Ordinances & State Laws, whether herein specified or not. *As defined in City Code and Ordinances.

SIGNED: [Signature] Date: 12/8/67
Registered Plumber Spec. Cont'r, Owner

Engineering Dept. Date: Building Department Date: 12-8-67
Sewer Conn. Fees
Paid in Engr. Dept. PERMIT NO. 22426 PERMIT FEE \$17.00
23.10 #1287

TOTAL FEE \$ 17.00

RECEIPT

1276 \$017.00 - 7

CITY OF LAS VEGAS
DEPT. OF
BUILDING & SAFETY

Must be machine validated

14 DEC 67

Gloria Saterick May 14/1989

CITY OF LAS VEGAS, NEVADA

DEPARTMENT OF BUILDING & SAFETY - AIR CONDITIONING APPLICATION & PERMIT

ADDRESS OF CONSTRUCTION: 201 Falcon Lane OWNER'S NAME: Ernest A. Becker
CIRCLE: ☒ New bldg.; ☐ Old bldg.; ☒ Add'n; ☐ Remodel; TYPE OF BLDG. ☐ SFD ☐ APT. ☐ COMM.
CONTRACTOR'S NAME: Oasis Air Conditioning STATE LICENSE # 8454 CITY LICENSE # 10371

UNITS	HEATERS	PRICE	FEE	UNITS	GAS	PRICE	FEE
	Unit Heaters (floor, suspended & wall)	\$2.00			Gas piping system 1 to 5 outlets	\$3.00	
	Floor Furnace	\$3.00			Gas piping system over 5 outlets (per outlet)	.20	
	Forced Air or Gravity Type under 100,000 BTU's	\$7.00			Swimming pool heater	\$4.00	
	Steam or hot water heating system under 15 outlets (Boiler Excluded)	\$8.00			VENTS		
	Steam or hot water heating system 15 to 30 outlets (Boiler Excluded)	\$10.00			Combustion products vent other than a chimney	\$1.00	
	Each outlet over 30	.50			Residential kitchen or bathroom vent each	.25	
	Radiant type heating system under 1000 sq. ft. to be heated	\$8.00			Commercial Hood	\$4.00	
	Radiant type heating system 1000 to 2000 sq.-ft. to be heated	\$10.00			Ventilation system not a portion of any heating or air conditioning system up to \$1,000 valuation	\$5.00	
	Each additional 500 sq. ft. over 2000 sq. ft.	.50			BOILER		
AIR CONDITIONING					Boiler installation 15 H.P. and under	\$5.00	
	Heat pump or refrigerant 3 tons or less.	\$4.00	4.00		Boiler installation over 15 H.P.	\$10.00	
	Heat pump or refrigerant 3 tons to 10 tons	\$6.00			REPAIR		
	Each addn. ton over 10 ton	.50			Inspection of alteration or replacement of any mechanical cooling equipment which is a portion of any air conditioning system	\$3.00	
	Refrigeration system 3 ton or less	\$5.00			DUST WORK ONLY (each opening)	.25	
	Refrigeration system 3 to 10 ton	\$7.00			WATER TOWER	\$4.00	
	Each addn. ton over 10 ton	.50			MINIMUM PERMIT FEE	\$4.00	
	Evaporative cooler 5 outlets and under	\$3.00			TOTAL PERMIT FEE		
	Evaporative cooler 5 to 10 outlets	\$5.00					\$4.00
	Each addn. outlet over 10	.25					

I hereby certify that I have carefully examined and read the above application; that the same is true and correct; and that the work herein described is to be done in accordance with all the provisions of the applicable Ordinances of the City of Las Vegas, Nevada and the State laws, whether herein specified or not.

SIGNED Richard Patton Date 8/28/67
AIR CONDITIONING CONTRACTOR - OWNER
BUILDING DEPARTMENT Janet Meyer Date 8/30/67
#1289 PERMIT NO. 15138 PERMIT FEE \$ 4.00

RECEIPT

2052 \$004.00 - 4

CITY OF LAS VEGAS
DEPT. OF
BUILDING & SAFETY
MUST BE MACHINE VALIDATED

31 AUG 67

Gloria Johnson May 16, 1979

CITY OF LAS VEGAS, NEVADA

DEPARTMENT OF BUILDING & SAFETY ELECTRICAL APPLICATION & PERMIT

ADDRESS OF CONSTRUCTION: ²⁰¹ ~~BARTO~~ + FALCON

OWNER'S NAME: SNEAD Bldg. Co.

LOT(S) BLOCK SUBDIVISION Type of bldg. SED ☒ Apt. ☐ Comm. ☐

Check Proper Construction: New Bldg. ☐ Addn. ☐ Remodel ☐ Temporary Pole ☐ Old Bldg. ☐

CONTRACTOR'S NAME: FRONTIER ELECTRIC STATE LICENSE # 7132 CITY LICENSE # 4819

NUMBER	FIXTURE OR INSTALLATION	UNIT PRICE	
10	Fixture or sockets	.15	1.50
49	Light, receptacle or switch outlet	.20	9.80
	Wall or ceiling space heater	.35	
	Blast coil heater per kilowatt	.35	
/	Garbage grinder outlet	.35	.35
/	Dishwasher outlet	.35	.35
/	Clothes dryer outlet	.35	.35
/	Automatic clothes washer	.35	.35
/	Electric range outlet	.35	.35
/	Electric water heater outlet	.35	.35
	Mercury arc lamp and equipment	.35	
	Special purpose outlet	.35	
	X-ray unit and its appurtenances	5.00	
	Watts of festoon lighting (Watts) First 3,000 watts	4.00	
	for each additional thousand watts	1.50	
	Horsepower - all motors first horsepower or less	1.75	
	for each additional horsepower	.35	
/	Temporary power and lights (temporary pole)	4.00	4.00
/	Electric service (including any single meter socket)	0.00	3.00
	for each additional socket	.35	
/	Air conditioning service	1.50	1.50
	amps		
	Each KW (KVA) Generator (Transformer) (Welder) KW (KVA)	2.00	
	First 100 KVA - For each additional KW (KVA)	.01	
	Special inspection per hour	4.00	
	Speaker outlets	.15	
	Signal or Alarm outlets	.15	
	Amplifiers	.50	
	Control panels	.25	
	T. V. outlets - master system only	.15	
	Radio outlets	.15	
	Main control racks	1.00	
	T. V. and Radio antennas - master system only	.75	
	Minimum fee for any permit	4.00	
	Total fee		21.90

I hereby certify that I have carefully examined and read the above application; that the same is true and correct; and that the work herein described is to be done in accordance with all the provisions of the applicable Ordinances of the City of Las Vegas, Nevada and State laws whether herein specified or not.

SIGNED Ray J. Lisk MASTER (ELECTRICIAN) (TECHNICIAN) (OWNER)

Date 1-16-68

BUILDING DEPARTMENT Janet Meyer

Date 1/17/68

#12860

PERMIT NO. 24593

PERMIT FEE: \$ 21.90

RECEIPT

3341 3021.90 - 6

CITY OF LAS VEGAS

DEPT. OF BUILDING & SAFETY

MUST BE MACHINE VALIDATED

18 JUN 68

Glenn Watson May 16, 1972

CITY OF LAS VEGAS, NEVADA

LOG NO. & AREA

DEPARTMENT OF BUILDING & SAFETY

CONST. VAL. \$

25.00

APPLICATION & BUILDING PERMIT — for:
Fence, Wall, Retaining Wall.

ADDRESS OF
CONSTRUCTION:

801 Falcon Lane, L.V.

OWNER:

R.D. Ripley

LOT(s)

17

BLOCK

2

SUBDIVISION

CHARLTON LOTS 31B

ZONE:

D

Materials of Construction:

Block ☐

Concrete ☐

Wire ☐

Wood ☒

Other ☐

Yes

No

PLANS:

☐

☐

ARCHITECT:

ENGINEER:

CALCS:

☐

☐

CONTRACTOR:

STATE
LICENSE #

CITY
LICENSE #

TOTAL SQUARE FEET:


TOTAL LINEAL FEET:

125

Remarks:

CONDITIONS OF THE PERMIT:

- Any type of retaining wall must be engineered by a Civil or Structural Engineer.
- If a home owner takes out the Building Permit and if the owner sublets the work to a Contractor, then the Contractor must take out the permit and pay for it.
- No fence or wall can be built on City property or rights-of-way, but this is not intended to preclude construction within utility easements if utilities will not be damaged or made inaccessible.
- The fence or wall shall not enclose any water meter, light standard, or fire alarm box and shall not come closer than 24" from the nearest fire hydrant outlet.
- Department Inspectors must approve footings before concrete is poured and block wall reinforcing before grouting is done.
- Maximum height of any wall or fence is 6', side and rear yards; 4' maximum in front yard with the vertical surface above the height of 2' — 50% open.
- I must not obstruct required onsite parking space (1 space for each dwelling unit) by the erection of this fence or wall.
- By the signing of this application I herewith agree to the requirements outlined above.

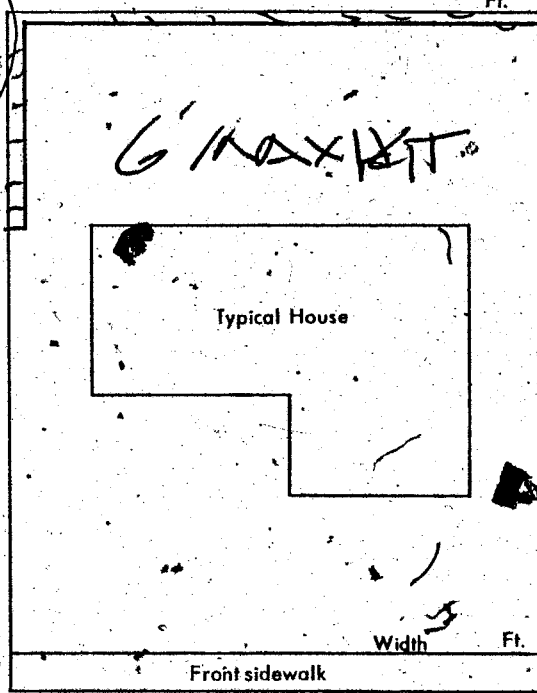

SIGNED:

R.D. Ripley

DATE:

3/3/72

CONTRACTOR ☒

AGENT ☐

OWNER ☐

PLANNING DEPT.:

Date:

3/3/72

PUBLIC WORKS DEPT.:

Date:

3/3/72

BUILDING DEPT.:

Date:

3/3/72

#12850

PERMIT NO.:

3316

PERMIT FEE \$

5.00

RECEIPT

2936

\$005.00

8

CITY OF LAS VEGAS

DEPT. OF
BUILDING & SAFETY

MUST BE MACHINE VALIDATED

- 6 MAR 72

Gloria Gatewood May 16, 1979

CITY OF LAS VEGAS, NEVADA

LOG NO. & AREA

DEPARTMENT OF BUILDING & SAFETY

CONST. VAL. \$

APPLICATION & BUILDING PERMIT — for:
Dwellings, Duplexes, Misc. Residential Const.

ADDRESS OF CONSTRUCTION:

201 Falcon Lane, L.V.

OWNER:

Robert A. Ripley

LOT(s)

17

BLOCK

2

SUBDIVISION


ZONE:

R-1

Existing structure on lot: Dwelling



Accessory bldg.



Vacant lot



Other



PROPOSED CONSTRUCTION:

Room Addition Second story add

USE:

Res. Perm

MATERIALS OF CONSTRUCTION:

Wood Frame



Concrete Block



Reinforced Concrete



Steel Frame



SQ. FEET OF FLOOR AREAS:

1st

391

2nd

3rd

Other

TOTAL SQ. FT.

391

FIRE ZONE: 1 2 3

Occupancy Group 1 J 1 2

CONST. TYPE

I II III IV V

ARCHITECT:

ENGINEER:

NO. of UNITS

NO. of STORIES

Plans Submitted:

Yes



No

Calculations Submitted



No



Sewer Fee Req'd.

Yes



No



CONTRACTOR:

OWNER

STATE LICENSE #

CITY LICENSE #

ADD'L. PERMITS REQ'D:

Air Cond.



Incinerators



Elec.



Plumbing



Signs



Paving




Fence



Public Walks



Curb-gutters

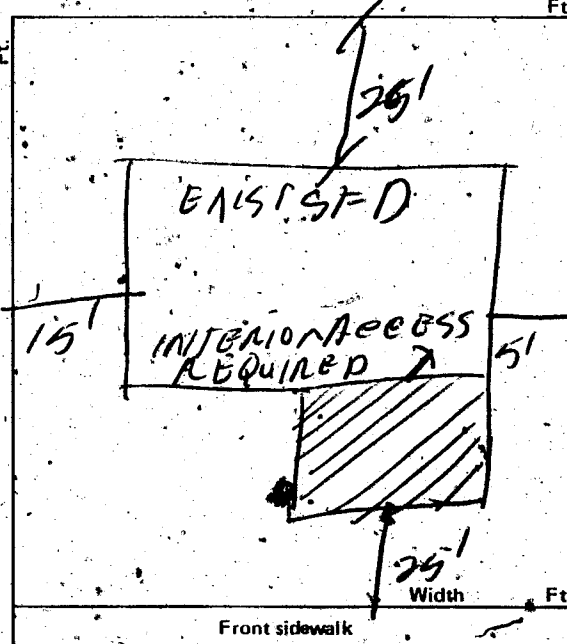

CONDITIONS OF THE PERMIT:

1. I agree to call the City Building Department for inspections before concrete is poured, before rough wiring, electrical, plumbing, framing is covered. Also for air conditioning, sheet-rock and sheathing inspection.
2. I agree that when the job is completed that I will call for final inspection before occupancy.
3. I agree to perform all construction in accordance with City Ordinances and Building Codes.
4. The Contractor's signature below denotes authority from the owner to sign in his behalf and that the owner is aware of all requirements of this application and permit. Separate permits must be taken out for work outlined above this agreement.
5. I have read and understand the contents of this application and permit, I hereby state that the information I have supplied on this application is true and correct.

Approval for the work under this permit will be given only after refuse and debris have been removed from job site and public right of way.

SIGNED:

Robert A. Ripley

Contractor

BY:

Agent or Owner

CLARK COUNTY HEALTH DEPT.

Date

LAS VEGAS FIRE DEPARTMENT

Date

PLANNING DEPT.:

Date:

7-19-79

PUBLIC WORKS DEPT.:

Date:

BUILDING DEPT.:

Date:

12850

PERMIT NO.:

17752

PERMIT FEE \$

24.00

RECEIPT

4839

\$024.00

CITY OF LAS VEGAS
DEPT. OF
BUILDING & SAFETY

MUST BE MACHINE VALIDATED

22 JUL 79

CITY OF LAS VEGAS, NEVADA

DEPARTMENT OF BUILDING & SAFETY - ELECTRICAL APPLICATION & PERMIT

ADDRESS OF
CONSTRUCTION:

201 FAUCON LANE

OWNER'S
NAME

ROBERT RILEY

CIRCLE: New Bldg.; Add'n.; Remodel; TYPE OF BLDG.: SFD. APT. PUBLIC COMM.

CONTRACTOR'S NAME:

OWNER

STATE
LICENSE #

CITY
LICENSE #

NUMBER	FIXTURE OR INSTALLATION	UNIT PRICE	TOTAL
	Rm addition, carport or garage enclosure	4.00	9.00
	Temporary power	4.00	
	Light, receptacle or switch outlet	.20	
	Wall or ceiling space heater	.35	
	Garbage grinder outlet	.35	
	Dishwasher outlet	.35	
	Clothes dryer outlet	.35	
	Automatic clothes washer	.35	
	Electric range outlet	.35	
	Electric water heater outlet	.35	
	Special purpose outlet	.35	
	X-ray unit and its appurtenances	5.00	
	Watts of festoon lighting (Watts) First 3,000 watts for each additional thousand watts	4.00 1.50	
	Horsepower each motor first horsepower or less for each additional horsepower	1.75 .35	
	Electric service (including any single meter socket) for each additional socket	3.00 .35	
	Air conditioning service	1.50	
	Each KW(KVA) Generator (Transformer, Welder) First 100 KVA for each additional KW(KVA)	2.00 .01	
	Speaker, signal or alarm outlet	.15	
	Amplifiers	.50	
	Control panels	.25	
	Main control racks	1.00	
	T.V. and radio antennas-master system only	.75	
	Minimum fee for any permit	4.00	
	TOTAL FEE		9.00

Approval for the work under this permit will be given only after refuse, and debris have been removed from job site and public right of way.

I hereby certify that I have carefully examined and read the above application; that the same is true and correct; and that the work herein described is to be done in accordance with all the provisions of the applicable Ordinances of the City of Las Vegas, Nevada and State laws whether herein specified or not.

SIGNED

MASTER (ELECTRICIAN) (TECHNICIAN) (OWNER)

DATE

BUILDING DEPARTMENT

DATE

#12860

PERMIT NO.

9822

PERMIT FEE: \$

9.00

RECEIPT

4838 \$004.00 - 6

CITY OF LAS VEGAS
DEPT. OF
BUILDING & SAFETY

MUST BE MACHINE VALIDATED

22 JUL 74

DEPT. of BLDG. & SAFETY - CITY of LAS VEGAS, NEVADA

OWNER Northwest Const. ADDRESS 201 Falcon Lane DATE 11/16/67
 GEN. CONT. Same TYPE OF STRUCTURE SED
 PERMIT NO. 39363 LEGAL DESCRIPTION L 17 B 2 Charleston Heights 31-B

BUILDING	MECHANICAL	ELECTRICAL
LOCATION <u>CH 12-5-67</u>	PLUMBING CONT. <u>Ray T. Davis</u>	TEMP. POLE CONT. <u>Ray T. Davis</u>
FIREPLACE FTS. <u>CH 12-5-67</u>	PERMIT NO. <u>22426</u> DATE <u>12-5-67</u>	PERMIT NO. <u>24593</u> DATE <u>11-16-67</u>
FOOTINGS <u>CH 12-5-67</u>	HEAT & VENT. AC CONT. <u>Opis</u>	INSPECTION <u>Miller</u> DATE <u>12-22-67</u>
FOUNDATION WALL <u>CH 12-13-67</u>	PERMIT NO. <u>15128</u> DATE <u>8-31-67</u>	ELECTRICAL CONT. <u>Miller</u>
FLOOR FRAMING	SEWER CONT. <u>Northwest</u>	PERMIT NO. <u>24593</u> DATE
SLAB <u>CH 12-2-67</u>	PERMIT NO. <u>22305</u> DATE <u>11-16-67</u>	FIXTURES CONT.
CHIMNEY STEEL (FIREPLACE)	ROUGH SOIL <u>UP 12-12-67</u>	PERMIT NO.
WALL STEEL	ROUGH WATER <u>UP 12-12-67</u>	SLAB
COLUMN STEEL	TOP-OUT	ROUGH <u>Miller 1-29-68</u>
BEAM STEEL	ROUGH GAS	FINAL ROUGH
FRAMING	AC ROUGH DUCT	FINAL FIXTURE
ROOF SHEATHING	REF. ROUGH PIPING	FINAL ELECTRICAL <u>Miller 4-5-68</u>
INTERIOR <u>CH 12-2-67</u>	FINAL PLUMBING <u>Wep 3-25-68</u>	TEMPORARY SERVICE
EXTERIOR <u>CH 2-12-67</u>	FINAL GAS	MISCELLANEOUS
DRYWALL <u>CH 2-12-67</u>	FINAL AIR COND. <u>Wep 4-3-68</u>	GRADING & DRAINAGE
LATHING	FINAL REFRIG.	ON-SITE PARKING SPACES
BACKING (SIDING)	FINAL SEWER	ENG. APPROVAL OF
SCRATCH	FINAL SEPTIC TANK	OFF-SITE IMPROVEMENTS
PLASTER BROWN		
URBAN REDEVELOPMENT APPROVAL		
FINAL BLDG <u>CH</u> DATE <u>1-8-68</u>		

APPROVED FOR OCCUPANCY & METER CH 4-25-68 INSPECTOR

DATE

PLEASE NOTE REMARKS ON REVERSE SIDE

201 Falcon Lane

LOG # R-71

AREA # 4

23.04

DEPT. of BLDG. & SAFETY - CITY of LAS VEGAS, NEVADA

OWNER Robert A. Ripley ADDRESS 201 Falcon Lane DATE 7-19-74
 GEN. CONT. Owner TYPE OF STRUCTURE 2nd story addn
 PERMIT NO. 17752 LEGAL DESCRIPTION L 17 B 2 Charleston Hgts # 31 B

BUILDING	MECHANICAL	ELECTRICAL
Investigation	Plumbing Cont.	Temp. pole cont.
Location & Footing	Permit No. _____ Date _____	Permit No. _____ Date _____
Stem Wall	Heat & Vent. A/C Cont.	Inspection _____ Date _____
Concrete Slab Floor	Permit No. _____ Date _____	Electrical Cont. <u>Owner</u>
Floor Framing	Sewer Cont.	Permit No. <u>9822</u> Date _____
Fireplace Footing	Permit No. _____ Date _____	Fixtures Cont.
Chimney Steel	ROUGH SOIL	Permit No. _____ Date _____
Vert. Steel Reinf.	ROUGH WATER	SLAB
Horiz. Steel Reinf.	TOP-OUT	ROUGH
Roof Sheathing	ROUGH GAS	FINAL ROUGH
Framing	A/C ROUGH DUCT	FINAL FIXTURE
Backing for siding	REF. ROUGH PIPING	FINAL ELECTRICAL
Ext. Lath	FINAL PLUMBING	TEMPORARY SERVICE
Ext. Scratch	FINAL GAS	MISCELLANEOUS
Ext. Brown	FINAL AIR COND.	GRADING & DRAINAGE
Int. Lath	FINAL REFRIG.	ON-SITE PARKING SPACES
Int. Brown	FINAL SEWER	ENG. APPROVAL OF
Drywall	FINAL SEPTIC TANK	OFF-SITE IMPROVEMENTS
Permit No.		
Final Building		
Appr. for Occu.		

INSPECTOR:

DATE

APPROVED FOR OCCUPANCY & METER

PLEASE NOTE REMARKS ON REVERSE SIDE

201 Falcon Lane

LOG #

AREA #

DEPARTMENT OF BUILDING & SAFETY
CITY OF LAS VEGAS, NEVADA

KARDEX CARD
FENCE & RETAINING
WALLS

OWNER R. Riley ADDRESS 201 Falcon Lane DATE 3-3-72

CONTRACTOR Owner PERMIT NO. 3316

LOT 17 BLOCK 2 SUBDIVISION Charleston Gate 31 B wood fence

Fence (wire, wood, etc.)	Walls (masonry, rock, etc.)
Location _____	Location _____
Final Inspection <u>2-9-72</u>	Footings _____
	Wall Steel 1st _____ 2d _____ 3d _____
	Final Inspection _____
Retaining Wall (masonry)	Retaining Wall (concrete)
Location _____	Location _____
Footings _____	Footings _____
Wall Steel 1st _____ 2d _____ 3d _____	Wall Steel 1st _____ 2d _____ 3d _____
Bond Beam 1st _____ 2d _____ 3d _____	Final Inspection _____
Final Inspection _____	

23.14 B

ADDRESS 201 Falcon

LOG NO. _____

AREA _____