

5116 Del Monte

DEPT. of BLDG & SAFETY—CITY of LAS VEGAS, NEVADA
OWNER REED CONST. ADDRESS 5116 Del Monte DATE 3-5-62
GEN. CONT. E.A. Becker TYPE OF STRUCTURE S.F. Dw.
PERMIT NO. 8227 LEGAL DESCRIPTION Lot 16 Block 1 Chas. Hts. #32-A-1

BUILDING		MECHANICAL		ELECTRICAL	
LOCATION <u>DB 3-13-62</u>		PLUMBING CONT. <u>Miller</u>		TEMP. POLE CONT.	
FIREPLACE FTS.		PERMIT NO. <u>5053</u>	DATE <u>3-19-62</u>	PERMIT NO.	DATE
FOOTINGS <u>DB 3-13-62</u>		HEAT & VENT. AC CONT. <u>Miller</u>		INSPECTION	DATE
FOUNDATION WALL		PERMIT NO. <u>4645</u>	DATE <u>3-22-62</u>	ELECTRICAL CONT.	DATE
STEM WALL <u>DB 3-14-62</u>		SEWER CONT. <u>Miller</u>		PERMIT NO. <u>6153</u>	DATE <u>5-8-62</u>
FLOOR FRAMING		PERMIT NO. <u>5053</u>	DATE <u>3-14-62</u>	FIXTURES CONT.	DATE
SLAB <u>DB 3-14-16-62</u>		ROUGH SOIL <u>Miller</u>	DATE <u>4-4-62</u>	PERMIT NO. <u>6153</u>	DATE <u>5-8-62</u>
CHIMNEY STEEL (FIREPLACE)		ROUGH WATER <u>Miller</u>	DATE <u>4-4-62</u>	SLAB	
WALL STEEL		TOP-OUT <u>Miller</u>	DATE <u>5-22-62</u>	ROUGH <u>Miller</u>	DATE <u>5-21-62</u>
COLUMN STEEL		ROUGH GAS <u>Miller</u>	DATE <u>5-22-62</u>	FINAL ROUGH	
BEAM STEEL		AC ROUGH DUCT <u>Miller</u>	DATE <u>5-22-62</u>	FINAL FIXTURE <u>Miller</u>	DATE <u>7-6-62</u>
STEEL FABRICATION		REF. ROUGH PIPING		TEMPORARY SERVICE	
FRAMING <u>DB 5-8-62</u>		FINAL PLUMBING <u>Miller</u>	DATE <u>5-22-62</u>		
ROOF SHEATHING <u>DB 5-24-62</u>		FINAL GAS <u>Miller</u>	DATE <u>5-22-62</u>	MISCELLANEOUS	
INTERIOR	EXTERIOR	FINAL AIR COND. <u>Miller</u>	DATE <u>6-21-62</u>	URBAN REDEVELOPMENT APPROVAL	
DRYWALL <u>DB 6-10-62</u>		FINAL REFRIG.		☐	
LATHING		FINAL SEWER		GRADING & DRAINAGE	
BACKING (SIDING)		FINAL SEPTIC TANK		ON-SITE PARKING SPACES	
PLASTER <u>SCRATCH</u>	<u>DB 6-14-62</u>			ENG. APPROVAL OF	
BRWN				OFF-SITE IMPROVEMENTS	
FINAL BLDG	DATE <u>7-6-62</u>				

APPROVED FOR OCCUPANCY Cashway 7-6-62 INSPECTOR Miller 7/6/62 DATE
APPROVED FOR METER Miller 7/6/62
PLEASE NOTE REMARKS ON REVERSE SIDE LOG # AREA # 23 04

5116 Del Monte

T-61

4


Not issued as of 7-4-82

MAYOR BILL BRIARE

COMMISSIONERS
PAUL J. CHRISTENSEN
RON LURIE
MYRON E. LEAVITT
ROY WOOFER

CITY ATTORNEY
CARL E. LOVELL, JR.

CITY MANAGER
WILLIAM E. ADAMS, P.E.

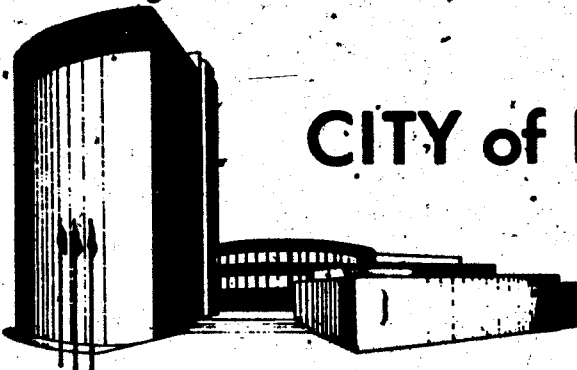

CITY of LAS VEGAS



DEPARTMENT BUILDING & SAFETY
BUILDING INSPECTION REPORT OF REQUIREMENTS, FOR COMPLIANCE WITH CITY OF LAS VEGAS
BUILDING CODES AND ZONING ORDINANCE

ADDRESS 5116 Adelmont

OWNER Don Heller

DATE 7-18-90

PERMITS REQUIRED

BLDG. ☒ Rm. addn. + 16X23 Carport

ELEC. ☒ _____

PLBG. ☐ _____

A.C. ☐ _____

CORRECTIONS TO BE MADE


BLDG. Roof Slope toward House

ELEC. _____

PLBG. _____

A.C. _____

MISC. _____

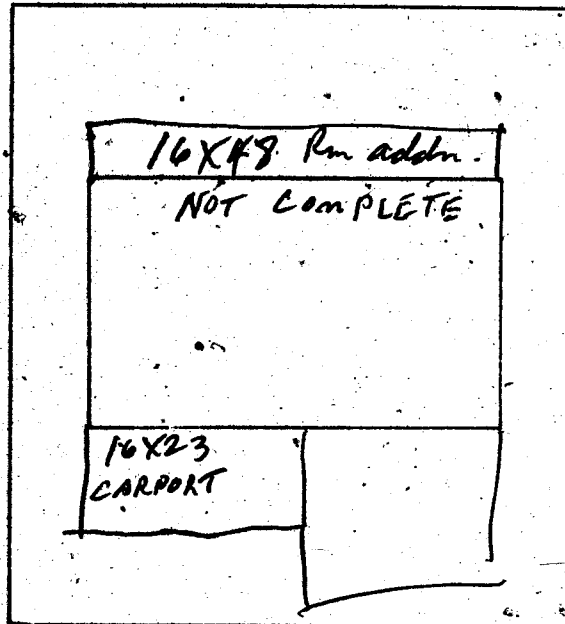

CERTIFICATE OF INSPECTION

APPROVED _____ DATE _____

☒ NOT APPROVED - CALL FOR
REINSPECTION.
386 6251

REMARKS 16X48 Rm addn. NOT COMPLETE
Roof. Cannot appear so complete. will need
insp. & Find when complete

BLDG. INSPECTOR Jim Bailey