

1709 FONTENELLE ST.

LOT 5 BK 4 FAIRACRES #1 ZONE R-1

Gloria Waterwood 5-9-79

CITY OF LAS VEGAS, NEVADA

LOG NO. & AREA

DEPARTMENT OF BUILDING & SAFETY

CONST. VAL. \$

2166⁰⁰

APPLICATION & BUILDING PERMIT - for: Dwellings, Duplexes, Misc. Residential Const.

ADDRESS OF CONSTRUCTION:

1709 FONTENELLE ST

OWNER: B. FELLOWES

LOT(S)

BLOCK

SUBDIVISION

ZONE: R-1

Existing structure on lot: Dwelling Accessory bldgs. Vacant lot Other

PROPOSED CONSTRUCTION: ROOM ADDN

USE: Fam. Rm.

MATERIALS OF CONSTRUCTION: Wood Frame Concrete Block Reinforced Concrete Steel Frame

SQUARE FEET OF FLOOR AREAS: 1st 494 2nd 3rd Other TOTAL SQ. FT. 361

FIRE ZONE: 1 2 3 Occupancy Group A B C D E F G H I J-1-2-3-4-5


CONST. TYPE: I II III IV V

ARCHITECT: ENGINEER: NO. of UNITS NO. of STORIES

Plans Submitted: Yes No Calculations Submitted: Yes No Sewer Fee Req'd: Yes No

CONTRACTOR: STATE LICENSE # CITY LICENSE #

ADD'L. PERMITS REQ'D: Air Cond. Elec. Plumbing Signs Paving Fence Public Walks Curb-gutters Incinerators Fire Sprinkling System

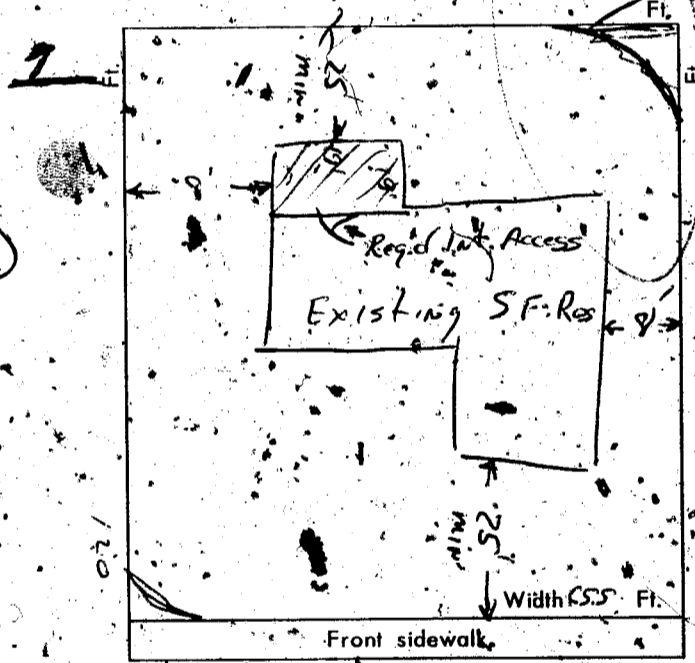

CONDITIONS OF THE PERMIT:

- 1. I agree to call the City Building Department for inspections before concrete is poured, before rough wiring, electrical, plumbing, framing is covered. Also for Air conditioning, sheet-rock and sheathing inspection.
2. I agree that when the job is completed that I will call for final inspection before occupancy.
3. I agree to perform all construction in accordance with City Ordinances and Building Codes.
4. The Contractor's signature below denotes authority from the owner to sign in his behalf and that the owner is aware of all requirements of this application and permit. Separate permits must be taken out for work outlined above this agreement.
5. I have read and understand the contents of this application and permit, hereby state that the information I have supplied on this application is true and correct.

SIGNED: B. Fellowes Contractor

BY: Agent or Owner

CLARK COUNTY HEALTH DEPT. Date

LAS VEGAS FIRE DEPARTMENT Date

PLANNING DEPT. Date: 4/11/69

PUBLIC WORKS DEPT. Date:

BUILDING DEPT. Date: 4-1-69

#12850 PERMIT NO. 46844 PERMIT FEE \$ 1500

RECEIPT 334 \$015.00 8 CITY OF LAS VEGAS DEPT. OF BUILDING & SAFETY MUST BE MACHINE VALIDATED APR 69

DEPARTMENT OF BUILDING & SAFETY
CITY OF LAS VEGAS, NEVADA

KABDEX CARD
FENCE & RETAINING
WALLS

OWNER Bart Fellowes ADDRESS 1709 Fontenelle DATE 6-21-65

CONTRACTOR Tile Masonry PERMIT NO. 30679

LOT 5 BLOCK 4 SUBDIVISION Fairways Tract #1 blk wall

Fence (wire, wood, etc.)		Walls (masonry, rock, etc.)	
Location _____		Location <u>2078 7-1-65</u>	
Final Inspection _____		Footing <u>2078 7-1-65</u>	
		Wall Steel 1st <u>2d</u> <u>3d</u>	
		Final Inspection <u>NRB 7-22-65</u>	
Retaining Wall (masonry)		Retaining Wall (concrete)	
Location _____		Location _____	
Footing _____		Footing _____	
Wall Steel 1st <u>2d</u> <u>3d</u>		Wall Steel 1st <u>2d</u> <u>3d</u>	
Bond Beam 1st <u>2d</u> <u>3d</u>		Final Inspection _____	
Final Inspection _____			

23.14 B ADDRESS 1709 Fontenelle LOG NO. _____ AREA _____

DEPT. of BLDG. & SAFETY—CITY of LAS VEGAS, NEVADA
OWNER B. Fellowes Owner ADDRESS 1709 Fontenelle DATE 4/11/69
GEN. CONT. _____ TYPE OF STRUCTURE Room add
PERMIT NO. 46844 LEGAL DESCRIPTION _____

BUILDING	MECHANICAL	ELECTRICAL
LOCATION <u>1709 7-24-69</u>	PLUMBING CONT. _____	TEMP. POLE CONT. _____
FIREPLACE FTS. _____	PERMIT NO. _____ DATE _____	PERMIT NO. _____ DATE _____
FOOTINGS _____	HEAT & VENT. AC CONT. _____	INSPECTION _____ DATE _____
FOUNDATION WALL _____	PERMIT NO. _____ DATE _____	ELECTRICAL CONT. _____
FLOOR FRAMING _____	SEWER CONT. _____	PERMIT NO. _____ DATE _____
SLAB <u>27-24-69</u>	PERMIT NO. _____ DATE _____	FIXTURES CONT. _____
WIREY STEEL (FIREPLACE) _____	ROUGH SOIL _____	PERMIT NO. _____ DATE _____
WALL STEEL _____	ROUGH WATER _____	SLAB _____
COLUMN STEEL _____	TOP-OUT _____	ROUGH <u>2118 26-69</u>
BEAM STEEL _____	ROUGH GAS _____	FINAL ROUGH _____
FRAMING _____	AC ROUGH DUCT _____	FINAL FIXTURE _____
ROOF SHEATHING <u>226-9-69</u>	REF. ROUGH PIPING _____	FINAL ELECTRICAL _____
INTERIOR _____	FINAL PLUMBING _____	TEMPORARY SERVICE _____
EXTERIOR _____	FINAL GAS _____	MISCELLANEOUS _____
DRYWALL _____	FINAL AIR COND. _____	GRADING & DRAINAGE _____
LATHING _____ <u>8/11/25/69</u>	FINAL REFRIG. _____	ON-SITE PARKING SPACES _____ APP. _____
BACKING (SIDING) _____	FINAL SEWER _____	ENG. APPROVAL OF _____
PLASTER SCRATCH _____ <u>2/12/69</u>	FINAL SEPTIC TANK _____	OFF-SITE IMPROVEMENTS _____
PLASTER BROWN _____		
URBAN REDEVELOPMENT APPROVAL _____		
FINAL BLDG. _____ DATE _____		

APPROVED FOR OCCUPANCY & METER J. J. 3-22-71 INSPECTOR DATE

PLEASE NOTE REMARKS ON REVERSE SIDE 1709 Fontenelle LOG: # AREA: # 23.04

DEPT. of BLDG & SAFETY - CITY of LAS VEGAS, NEVADA

OWNER: WESTGATE BUILDERS ADDRESS: 1709 Fontanelle St. DATE: 8-17-62

GEN. CONT.: same TYPE OF STRUCTURE: S.F. Dwl.

PERMIT NO.: 12042 LEGAL DESCRIPTION: Lot 5 Block 4, Fairacres Tr. #1

BUILDING		MECHANICAL		ELECTRICAL	
LOCATION	<i>Allen 10-5-62</i>	PLUMBING CONT.	<i>Allen 10-5-62</i>	TEMP. POLE CONT.	
FIREPLACE FTG.	<i>Allen 10-5-62</i>	PERMIT NO.	<i>7472</i> DATE <i>8-12-62</i>	PERMIT NO.	
FOOTINGS	<i>Allen 10-5-62</i>	HEAT & VENT. AC CONT.	<i>Wilson 11-30-62</i>	INSPECTION	
FOUNDATION WALL		PERMIT NO.	<i>5748</i> DATE <i>10-30-62</i>	ELECTRICAL CONT.	<i>Lark</i>
STEM WALL		SEWER CONT.	<i>Allen 10-5-62</i>	PERMIT NO.	<i>7062</i> DATE <i>11-9-62</i>
FLOOR FRAMING		PERMIT NO.	<i>7472</i> DATE <i>8-12-62</i>	FIXTURES CONT.	
SLAB		ROUGH SOIL	<i>JW 11-19-62</i>	PERMIT NO.	
CHIMNEY STEEL (FIREPLACE)		ROUGH WATER	<i>JW 10-19-62</i>	SLAB	
WALL STEEL		TOP-OUT	<i>JW 12-7-62</i>	ROUGH	<i>Meller 11-29-62</i>
COLUMN STEEL		ROUGH GAS		FINAL ROUGH	
BEAM STEEL		AC ROUGH DUCT	<i>JW 12-7-62</i>	FINAL FIXTURE	
STEEL FABRICATION		REF. ROUGH PIPING		TEMPORARY SERVICE	
FRAMING	<i>Allen 10-5-62</i>	FINAL PLUMBING	<i>JW 3-5-63</i>	MISCELLANEOUS	
ROOF SHEATHING	<i>Allen 10-5-62</i>	FINAL GAS		URBAN REDEVELOPMENT APPROVAL	
DRYWALL	<i>Allen 3-8-63</i>	FINAL AIR COND.	<i>JW 3-5-63</i>	<input type="checkbox"/>	
LATHING	<i>Allen 3-8-63</i>	FINAL REFRIG.		GRADING & DRAINAGE	
BACKING (SIDING)	<i>Allen 3-8-63</i>	FINAL SEWER	<i>JW 1-4-63</i>	ON-SITE PARKING SPACES	APP: <i>0</i>
PLASTER	<i>Allen 3-8-63</i>	FINAL SEPTIC TANK		ENG. APPROVAL OF	
FINAL BLDG	<i>Allen 3-12-63</i>			OFF-SITE IMPROVEMENTS	

APPROVED FOR OCCUPANCY: *Webb 3-12-63* INSPECTOR: _____

APPROVED FOR METER: *Meller 3-8-63* Log: # _____

PLEASE NOTE REMARKS ON REVERSE SIDE AREA: # _____ 23.04

1709 Fontanelle St. T-43 4