

2400 Fremont

G. Gatewood 4-30-79

CITY OF LAS VEGAS, NEVADA
DEPARTMENT OF BUILDING & SAFETY
APPLICATION FOR SIGN PERMIT

LOG NO.

PERMIT NO. 2338
TELEPHONE NO. 735-8061
DATE: April 11, 1966

ADDRESS OF
CONSTRUCTION: 2400 E. Fremont

PLANNING
ZONE C-2

SIGN
OWNER'S
NAME: Milton Taylor
STATE
LICENSE # 8183

CITY
LICENSE # 615

CONTRACTOR'S NAME Wm. Comerford

PROPERTY OWNER'S NAME:

BILLBOARD TYPE (NONELECTRIFIED)

FEE

Single face (if on roof, marquee or projecting 2 times fee below)

square feet

25 sq. ft. to 50 sq. ft.

\$4.00

51 sq. ft. to 200 sq. ft.

5.00

Over 200 sq. ft.

7.50

Double faced or V-type (if on roof, marquee or projecting 2 times fee below)

200 square feet

25 sq. ft. to 50 sq. ft.

\$ 6.00

51 sq. ft. to 300 sq. ft.

7.50

Over 300 sq. ft.

11.25

Plan check fee (if required) \$20.00

Electric Permit Required

Yes No ☒

SUBSECTION "D" TYPE (ELECTRIFIED)

VALUATION 200.00

Front Street

Wall or Marquee or Single face

sq. ft. of display surface @ \$12.00

Projecting or roof or double face

sq. ft. of display surface @ \$15.00


(Sign 25 sq. ft. and under minimum permit only)

Moving of Sign Fee @ \$5 each sign

Minimum permit Fee @ \$4 each sign

TOTAL PERMIT FEE

REMARKS:

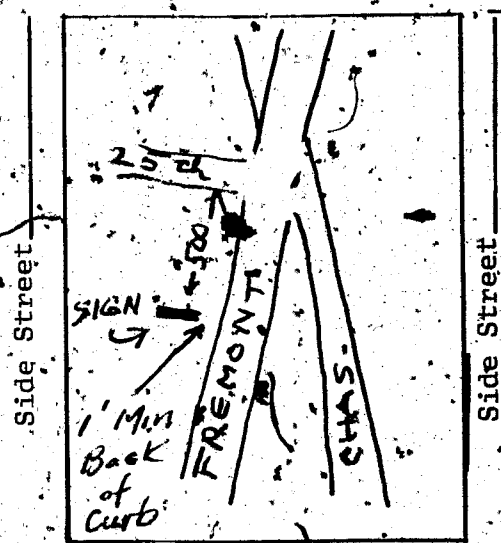

Rear Street

MATERIAL OF SIGNS: Metal ☒ Wood ☒ Plastic ☒ Other ☒

TYPE OF JOB: New Sign ☒ Replacement ☒ Relocate ☒

I hereby certify that I have carefully examined and read the above application; that the same is true and correct; and that the work herein described is to be done in accordance with all the provisions of the applicable Ordinances of the City of Las Vegas, Nevada, and State laws, whether herein specified or not.

APPLICATION APPROVED BY

PLANNING DEPT.

ENGINEERING DEPT.

BUILDING DEPT.

23.07

SIGN HERE:

Master Neon Electrician, Billboard Contractor

11 APR 66

DEPT. of BLDG & SAFETY—CITY of LAS VEGAS, NEVADA
 OWNER Showboat Hotel ADDRESS 2400 Boulder Highway DATE 4/12/63
 GEN CONT. R.E.Z. Const. Co. TYPE OF STRUCTURE Engineers
 PERMIT NO. 19677 LEGAL DESCRIPTION

BUILDING	MECHANICAL	ELECTRICAL
LOCATION	PLUMBING CONT.	TEMP. POLE CONT.
FIREPLACE FTS.	PERMIT NO. DATE	PERMIT NO. DATE
FOOTINGS	HEAT & VENT. AC CONT.	INSPECTION DATE
FOUNDATION WALL	PERMIT NO. DATE	ELECTRICAL CONT.
FLOOR FRAMING	SEWER CONT.	PERMIT NO. DATE
SLAB	PERMIT NO. DATE	FIXTURES CONT.
CHIMNEY STEEL (FIREPLACE)	ROUGH SOL.	PERMIT NO. DATE
WALL STEEL	ROUGH WATER	SLAB
COLUMN STEEL	TOP-OUT	ROUGH
BEAM STEEL	ROUGH GAS	FINAL ROUGH
FRAMING	AC ROUGH DUCT	FINAL FIXTURE
ROOF SHEATHING	REF. ROUGH PIPING	FINAL ELECTRICAL
INTERIOR	FINAL PLUMBING	TEMPORARY SERVICE
EXTERIOR	FINAL GAS	
DRY WALL	FINAL AIR COND.	
LATHING	FINAL REFRIG.	
BACKING (BROW)	FINAL SEWER	
PLASTER	FINAL SEPTIC TANK	
PLASTER BROWN		
URBAN REDEVELOPMENT APPROVAL		
FINAL B.D.G.		
DATE		

APPROVED FOR OCCUPANCY METER Inspector DATE 4/14/63
 PLEASE NOTE REMARKS ON REVERSE SIDE LOG # AREA # 23.04

2400 Boulder Highway C-181 1

DEPT. of BLDG & SAFETY—CITY of LAS VEGAS, NEVADA
 OWNER Showboat Hotel, Inc. ADDRESS 2400 Boulder Hwy. DATE 4/10/63
 GEN CONT. REZ Const. Co. TYPE OF STRUCTURE 3 transformers
 PERMIT NO. 19491 LEGAL DESCRIPTION

BUILDING	MECHANICAL	ELECTRICAL
LOCATION	PLUMBING CONT.	TEMP. POLE CONT.
FIREPLACE FTS.	PERMIT NO. DATE	PERMIT NO. DATE
FOOTINGS	HEAT & VENT. AC CONT.	INSPECTION DATE
FOUNDATION WALL	PERMIT NO. DATE	ELECTRICAL CONT.
FLOOR FRAMING	SEWER CONT.	PERMIT NO. DATE
SLAB	PERMIT NO. DATE	FIXTURES CONT.
CHIMNEY STEEL (FIREPLACE)	ROUGH SOL.	PERMIT NO. DATE
WALL STEEL	ROUGH WATER	SLAB
COLUMN STEEL	TOP-OUT	ROUGH
BEAM STEEL	ROUGH GAS	FINAL ROUGH
FRAMING	AC ROUGH DUCT	FINAL FIXTURE
ROOF SHEATHING	REF. ROUGH PIPING	FINAL ELECTRICAL
INTERIOR	FINAL PLUMBING	TEMPORARY SERVICE
EXTERIOR	FINAL GAS	
DRY WALL	FINAL AIR COND.	
LATHING	FINAL REFRIG.	
BACKING (BROW)	FINAL SEWER	
PLASTER	FINAL SEPTIC TANK	
PLASTER BROWN		
URBAN REDEVELOPMENT APPROVAL		
FINAL B.D.G.		
DATE		

APPROVED FOR OCCUPANCY METER Inspector DATE 4/16/63
 PLEASE NOTE REMARKS ON REVERSE SIDE LOG # AREA # 23.04

2400 Boulder Hwy C-173 1

KARDEX - CARD
SIGN

CONTRACTOR. William Comerford PERMIT NO. 2338

LOCATION _____ ELECT. ROUGH _____

SHOP (WIRING, CONST.) _____ ELECT. FINAL _____

SITE (BLDG., ETC.) _____

INST. (SERV: STRUCT.) _____

BILLBOARD

ELECTRIFIED

FINAL Chrock 4-13-66

23.06 E ADDRESS 2400 E. Fremont LOG-NO. _____ AREA _____