

2514 E. Fremont

LOT 8 & 9 BLOCK 6 FISHERS FREMONT ST. ZONED C-2

G. Gatewood 4-30-79

CITY OF LAS VEGAS, NEVADA

LOG NO. & AREA

CONST. VAL. \$

DEPARTMENT OF BUILDING & SAFETY

APPLICATION & BUILDING PERMIT — for:

Commercial or Public Structures.

ADDRESS OF CONSTRUCTION:

OWNER: FIVE POINTS AUTO

LOT(s)

BLOCK

SUBDIVISION

ZONE:

Existing structure on lot:

Dwelling

Accessory Bldgs.

Vacant lot

Commercial Bldg.

Other

PROPOSED CONSTRUCTION:

USE:

MATERIALS OF CONSTRUCTION: Wood Frame

Concrete Block

Reinforced Concrete

Steel Frame

SQUARE FEET OF FLOOR AREAS: 1st

2nd

3rd

Other

TOTAL SQ. FT.

FIRE ZONE: 1 2 3

Occupancy Group A B C D E F G H I J-1-2-3-4-5

CONST. TYPE: I II III IV V

ARCHITECT:

ENGINEER:

NO. of UNITS

NO. of STORIES

Plans Submitted: Yes

No

Calculations Submitted

Yes

No

Sewer Fee Req'd. Yes

No

CONTRACTOR: CHEYENNE CONST.

STATE LICENSE #

10168

CITY LICENSE #

11751

ADD'L. PERMITS REQ'D: Air Cnd.

Elec.

Plumbing

Signs

Paving

Fence

Public Walks

Curb-gutters

Incinerators

Fire Sprinkling System

CONDITIONS OF THE PERMIT:


1. I agree to call the City Building Department for inspections before concrete is poured, before rough wiring, electrical, plumbing, framing is covered. Also for Air conditioning, sheet-rock and sheathing inspection.
2. I agree that when the job is completed that I will call for final inspection before occupancy.
3. I agree to perform all construction in accordance with City Ordinances and Building Codes.
4. The Contractor's signature below denotes authority from the owner to sign in his behalf and that the owner is aware of all requirements of this application and permit. Separate permits must be taken out for work outlined above this agreement.
5. I have read and understand the contents of this application and permit; I hereby state that the information I have supplied on this application is true and correct.

SIGNED: CHEYENNE CONST. INC. Contractor

BY: David W. Bly Agent or Owner

CLARK COUNTY HEALTH DEPT.

LAS VEGAS FIRE DEPARTMENT

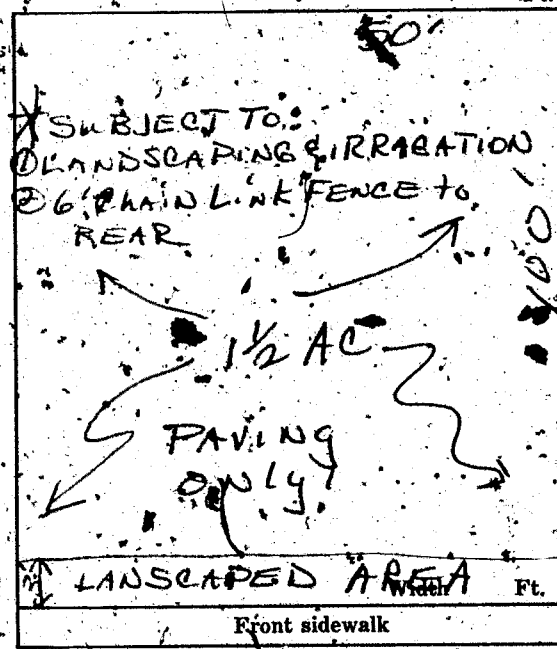

PLANNING DEPT:

Date:

ENGINEERING DEPT:

Date:

BUILDING DEPT:

Date:

#12850

PERMIT NO:

50869

PERMIT FEE \$

800

RECEIPT

8119 \$008.00 - 8

CITY OF LAS VEGAS
DEPT. OF
BUILDING & SAFETY

MUST BE MACHINE VALIDATED

26 JAN 70

J. Gatewood 4-30-79

CITY OF LAS VEGAS, NEVADA

LOG NO. & AREA: _____

DEPARTMENT OF BUILDING & SAFETY

APPLICATION & BUILDING PERMIT — For:

Commercial or Public Structures.

ADDRESS OF
CONSTRUCTION:

2514 E

OWNER: FIVE POINTS AUTO

LOT(s)

8-9 BLOCK 6

SUBDIVISION

FISHERS FREEMONT ST

ZONE: C-2

Existing structure on lot: Dwelling ☐ Accessory Bldgs. ☐ Vacant lot ☐ Commercial Bldg. ☐ Other ☐

PROPOSED CONSTRUCTION:

LOT PAVING

USE:

MATERIALS OF CONSTRUCTION: Wood Frame ☐ Concrete Block ☐ Reinforced Concrete ☐ Steel Frame ☐

SQUARE FEET OF FLOOR AREAS: 1st _____ 2nd _____ 3rd _____ Other _____ TOTAL SQ. FT. 5000

FIRE ZONE: 1 2 3 Occupancy Group A B C D E F G H I J-1-2-3-4-5 CONST. TYPE: I II III IV V

ARCHITECT:

ENGINEER:

NO. of UNITS

NO. of STORIES

Plans Submitted: Yes ☐ No ☐ Calculations Submitted: Yes ☐ No ☐ Sewer Fee Req'd. Yes ☐ No ☐

CONTRACTOR: CHEYENNE CONST.

STATE

LICENSE #

10168

CITY

LICENSE #

11751

ADD'L. PERMITS REQ'D: Air Cond. ☐ Elec. ☐ Plumbing ☐ Signs ☐ Paving ☐ Fence ☐ Public Walks ☐ Curb-gutters ☐ Incinerators ☐ Fire Sprinkling System ☐

CONDITIONS OF THE PERMIT:

1. I agree to call the City Building Department for inspections before concrete is poured, before rough wiring, electrical, plumbing, framing is covered. And for Air conditioning, sheet-rock and sheathing inspection.
2. I agree that when the job is completed that I will call for final inspection before occupancy.
3. I agree to perform all construction in accordance with City Ordinances and Building Codes.
4. The Contractor's signature below denotes authority from the owner to sign in his behalf and that the owner is aware of all requirements of this application and permit. Separate permits must be taken out for work outlined above this agreement.
5. I have read and understand the contents of this application and permit; I hereby state that the information I have supplied on this application is true and correct.

SIGNED: CHEYENNE CONST. INC. Contractor


BY: David W. Byle Agent or Owner

CLARK COUNTY HEALTH DEPT.

Date

LAS VEGAS FIRE DEPARTMENT

Date

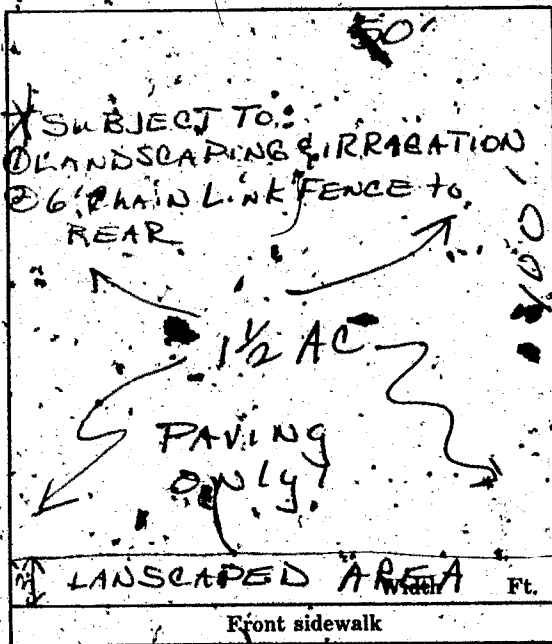

PLANNING DEPT: * MC

Date: 1-23-70

ENGINEERING DEPT: LM

Date: 1-23-70

BUILDING DEPT: H. T. Ellis

Date: 1-23-70

#12850

PERMIT NO:

50869

PERMIT FEE \$

800

RECEIPT

28119 \$008.00 - 8

CITY OF LAS VEGAS
DEPT. OF
BUILDING & SAFETY

MUST BE MACHINE VALIDATED

26 JAN 70

Lila Collins 2-1-82

DEPT. OF BLDG & SAFETY - CITY OF LAS VEGAS, NEVADA					
OWNER	Five Points Auto	ADDRESS	2514 East Fremont	DATE	1/26/70
GEN. CONT.	Cheyenne Const.		TYPE OF STRUCTURE	Paving	
PERMIT NO.	50869	LEGAL DESCRIPTION	Lots 8-9 Blk 6 Fisher's Fremont		
BUILDING		MECHANICAL		ELECTRICAL	
LOCATION		PLUMBING CONT.		TEMP. POLE CONT.	
FIREPLACE FTS.		PERMIT NO.		PERMIT NO.	
FOOTINGS		DATE		DATE	
FOUNDATION WALL		DAY & VENT. AC CONT.		INSPECTION	
FLOOR FRAMING		PERMIT NO.		DATE	
SLAB		SEWER CONT.		ELECTRICAL CONT.	
CHIMNEY STEEL (FIREPLACE)		PERMIT NO.		DATE	
WALL STEEL		ROUGH SOIL		FIXTURES CONT.	
COLUMN STEEL		ROUGH WATER		PERMIT NO.	
BEAM STEEL		TOP-OUT		DATE	
FRAMING		ROUGH GAS		SLAB	
ROOF SHEATHING		AC ROUGH DUCT		ROUGH	
INTERIOR		REF. ROUGH PIPING		FINAL ROUGH	
EXTERIOR		FINAL PLUMBING		FINAL FIXTURE	
DRYWALL		FINAL GAS		FINAL ELECTRICAL	
LATHING		FINAL AIR COND.		TEMPORARY SERVICE	
BACKING (SIDING)		FINAL REFRIG.		MISCELLANEOUS	
PLASTER		FINAL SEWER		GRADING & DRAINAGE	
BROWN		FINAL SEPTIC TANK		ON-SITE PARKING SPACES	
URBAN REDEVELOPMENT APPROVAL				ENG. APPROVAL OF	
FINAL BLDG				OFF-SITE IMPROVEMENTS	
DATE					

APPROVED FOR OCCUPANCY METER 1-2-15-70 INSPECTOR

DATE

PLEASE NOTE REMARKS ON REVERSE SIDE

LOG #

MEAS #

23.04

2514 E. Fremont