

. 1312 North Eastern .

3-19-79
CITY OF LAS VEGAS, NEVADA
DEPARTMENT OF BUILDING & SAFETY

PERMIT FEE \$
SIGNS - APPLICATION & PERMIT
INSPECTION VALUATION:

ADDRESS OF
CONSTRUCTION:

315 N. 25th St.
1312 N. 25th St.

SIGN OWNER:

ROBO WASH

STATE

CITY

SIGN CONTRACTOR:

SHAW ADVERTISING

LICENSE #

7484

LICENSE #

8220

PROPERTY OWNER'S NAME:

DARRELL PHILLIPS

LOG NO.
& AREA

PLANNING
ZONE:

C-2

BILLBOARD TYPE (NON-ELECTRIFIED)

Single face (If on roof, marquee or projecting - 2 times fee listed below)

25 sq. ft. to 50 sq. ft.	\$4.00
51 sq. ft. to 300 sq. ft.	5.00
Over 300 sq. ft.	7.50

Double faced or V-type (If on roof, marquee or projecting 2 times fee below)

25 sq. ft. to 50 sq. ft.	\$6.00
51 sq. ft. to 300 sq. ft.	7.50
Over 300 sq. ft.	11.25

Plan check fee (If required)

\$20.00

Electric permit required

Yes No

SUB-SECTION "D" TYPE (ELECTRIFIED)

Material of Signs:

Metal () Wood () Plastic () Other ()

Type of Job:

New Sign Replacement Relocate

Rear width Ft.

Wall or Marquee or single face

sq. ft. of display surface \$12.00

Projecting on roof or double face

sq. ft. of display surface \$15.00


Signs 25 sq. ft. & under min. fee \$4.00

Signs Moving per each sign \$5.00

Minimum permit fee \$4.00

TOTAL PERMIT FEE

4.00

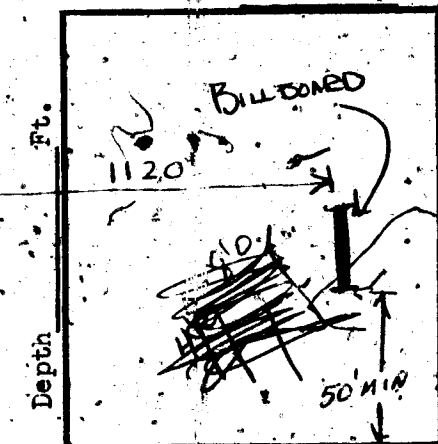

Front width Ft.

STREET 25th St 315

I hereby certify that I have carefully examined and read the above application; that the same is true & correct & that the work herein described is to be done in accordance with all the provisions of the applicable Ordinances of the City of Las Vegas and State laws whether specified or not.

Signed:

D. J. Shaw

Date: 10/25/67

Master Neon Elec. Billboard Contractor

APPROVED BY:

PLANNING DEPARTMENT

DATE 11-1-67

ENGINEERING DEPARTMENT

DATE 11-1-67

BUILDING DEPARTMENT

DATE 11-1-67

288

PERMIT NO.

32235

PERMIT FEE:

4.00

RECEIPT

73 \$5004.00

CITY OF LAS VEGAS
DEPT. OF
BUILDING & SAFETY

Must be machine validated

2 NOV 67

B. L. L. 3-19-68

PERMIT FEE \$

CITY OF LAS VEGAS, NEVADA
DEPARTMENT OF BUILDING & SAFETY

SIGNS - APPLICATION & PERMIT
INSPECTION VALUATION:

ADDRESS OF
CONSTRUCTION: 1312 25TH ST.

SIGN OWNER: SUN OUTDOOR ADVERT.

SIGN CONTRACTOR: SUN OUTDOOR

STATE
LICENSE # 9733

CITY
LICENSE # C-501

PROPERTY OWNER'S NAME: EDITH J. JENSEN

LOG NO.
& AREA

PLANNING
ZONE: C-2

BILLBOARD TYPE (NON-ELECTRIFIED)

Single face (If on roof, marquee or projecting - 2 times fee listed below)

25 sq. ft. to 50 sq. ft.	\$4.00
51 sq. ft. to 300 sq. ft.	5.00
Over 300 sq. ft.	7.50

Double faced or V-type (If on roof, marquee or projecting 2 times fee below)

25 sq. ft. to 50 sq. ft.	\$6.00
51 sq. ft. to 300 sq. ft.	7.50
Over 300 sq. ft.	11.25

Plan check fee (If required)

\$20.00

Electric permit required

Yes No


SUB-SECTION "D" TYPE (ELECTRIFIED)

Material of Signs:
Metal (X) Wood () Plastic () Other ()

Type of Job:
New Sign (X) Replacement Relocate

Rear width

Ft.

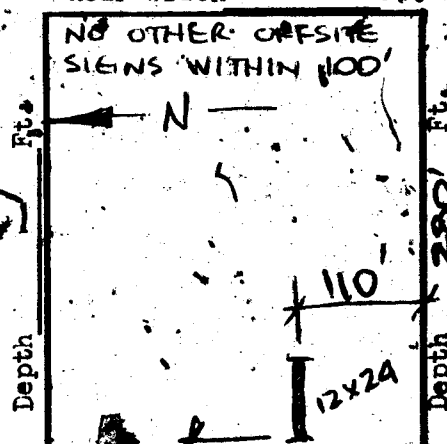

Front width 550' Ft.

STREET 25TH ST

Wall or Marquee or single face
sq. ft. of display surface \$12.00

Projecting or roof or double face
sq. ft. of display surface \$15.00

Signs 25 sq. ft. & under min. fee \$4.00

Signs Moving per each sign \$5.00

Minimum permit fee \$4.00

TOTAL PERMIT FEE

I hereby certify that I have carefully examined and read the above application; that the same is true & correct & that the work herein described is to be done in accordance with all the provisions of the applicable Ordinances of the City of Las Vegas and State laws whether specified or not.

Signed: James H. Cox Date: 3/20/68
Master Neon/Elec. Billboard Contractor

APPROVED BY:

PLANNING DEPARTMENT

DATE 3-20-68

ENGINEERING DEPARTMENT

DATE 3-20-68

BUILDING DEPARTMENT

DATE 3-20-68

#12880 PERMIT NO. 40897 PERMIT FEE: 23.07

RECEIPT

5441 1002.50 - 5

CITY OF LAS VEGAS
DEPT. OF
BUILDING & SAFETY

Must be machine validated.

24 MAR 68

DEPARTMENT OF BUILDING & SAFETY
CITY OF LAS VEGAS, NEVADA

KARDEX CARD
SIGN

OWNER ROBO WASH ADDRESS 1312 North 25th St. DATE Nov. 1, 1967

CONTRACTOR SHAW ADVERTISING CO. PERMIT NO. 32235

LOT BLOCK SUBDIVISION

LOCATION

SHOP (WIRING, CONST.)

SITE (BLDG. ETC.)

INST. (SERV: STRUCT.)

BILLBOARD

ELECTRIFIED

FINAL

ELECT. ROUGH

ELECT. FINAL

23.07 D.

ADDRESS 1312 No. 25th St.

LOG NO.

AREA

DEPARTMENT OF BUILDING & SAFETY
CITY OF LAS VEGAS, NEVADA

KARDEX CARD
SIGN

OWNER Sun Outdoor Adv ADDRESS 1312 25th Street DATE 3-20-68

CONTRACTOR Sun Outdoor Adv PERMIT NO. 40897

LOT _____ BLOCK _____ SUBDIVISION _____

LOCATION <u>803 26 68</u>	ELECT. ROUGH _____
SHOP (WIRING; CONST.) <u>J</u>	ELECT. FINAL _____
SITE (BLDG., ETC.) <u>J</u>	
INST. (SERV: STRUCT.) _____	
BILLBOARD _____	
ELECTRIFIED _____	
FINAL <u>J.D. 4-10-68</u>	

23.07 D ADDRESS 1312 25th Street LOG NO. _____ AREA _____