

6113 EMPIRE CR.

L57 B1 Char Hgts 28 A Zone R-1

G. Gatewood 4-9-79

CITY OF LAS VEGAS, NEVADA

LOT NO. & AREA

CONST. VAL. \$ 532

DEPARTMENT OF BUILDING & SAFETY

APPLICATION & BUILDING PERMIT for:
Dwellings, Duplexes, Misc. Residential Const.

ADDRESS OF
CONSTRUCTION:

OWNER:

LOT(s)

BLOCK

SUBDIVISION

No. 25-A

ZONE: R-1

Existing structure on lot: Dwelling ☒ Accessory bldg. ☐ Vacant lot ☐ Other ☐

PROPOSED CONSTRUCTION:

USE:

MATERIALS OF CONSTRUCTION: Wood Frame ☐ Concrete Block ☐ Reinforced Concrete ☐ Steel Frame ☐

SQUARE FEET OF FLOOR AREAS: 1st 2nd 3rd Other TOTAL SQ. FT. 221


FIRE ZONE: 1 2 3 Occupancy Group A B C D E F G H I J-1-2-3-4-5 CONST. TYPE: I II III IV V

ARCHITECT: ENGINEER: NO. of UNITS NO. of STORIES

Plans Submitted: Yes ☒ No ☐ Calculations Submitted: Yes ☐ No ☐ Sewer Fee Req'd. Yes ☐ No ☐

STATE LICENSE # CITY LICENSE #

PERMITS REQ'D: Air Cond. ☐ Elec. ☒ Plumbing ☐ Signs ☐ Paying ☐ Fence ☐ Public Walks ☐ Curb-gutters ☐
Incinerators ☐ Fire Sprinkling System ☐

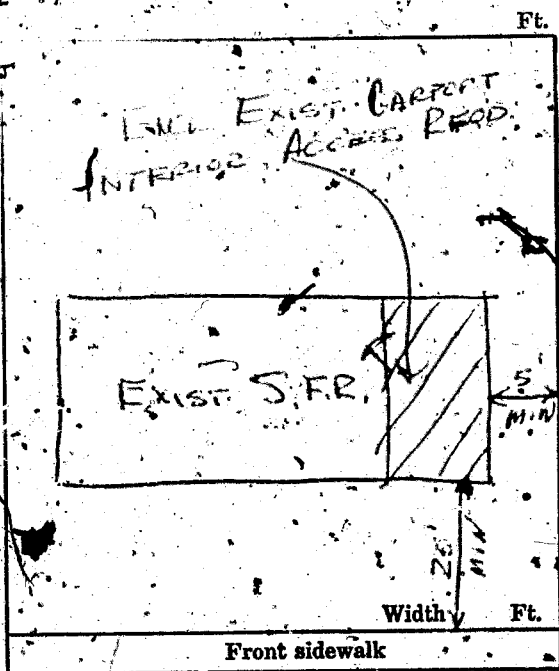

CONDITIONS OF THE PERMIT

1. I agree to call the City Building Department for inspections before concrete is poured, before rough wiring, electrical, plumbing, framing is covered. Also for Air conditioning, sheet-rock and sheathing inspection.
2. I agree that when the job is completed that I will call for final inspection before occupancy.
3. I agree to perform all construction in accordance with City Ordinances and Building Codes.
4. The Contractor's signature below denotes authority from the owner to sign in his behalf and, that the owner is aware of all requirements of this application and permit. Separate permits must be taken out for work outlined above this agreement.
5. I have read and understand the contents of this application and permit; I hereby state that the information I have supplied on this application is true and correct.

SIGNED: Contractor

BY: Agent or Owner

CLARK COUNTY HEALTH DEPT.

LAS VEGAS FIRE DEPARTMENT

PLANNING DEPT:

Date: 7-12-68

ENGINEERING DEPT:

Date:

BUILDING DEPT:

Date: 7-12-68

#1285

PERMIT NO:

43576

PERMIT FEE:

600

RECEIPT

2244 \$006.00 - 8

CITY OF LAS VEGAS

DEPT. OF
BUILDING & SAFETY

MUST BE MACHINE VALIDATED

12 JUL 68

Y. Gatewood 4-9-79

CITY OF LAS VEGAS, NEVADA

DEPARTMENT OF BUILDING & SAFETY - ELECTRICAL APPLICATION & PERMIT

ADDRESS OF
CONSTRUCTION:

6113 Empire Cir

OWNER'S
NAME:

Douglas Jenkins

LOT(S)

BLOCK

SUBDIVISION

Type of bldg.

SFD ☐

Apt. ☐

Comm. ☐

Check Proper Construction:

New Bldg. ☐

Addn. ☐

Remodel ☐

Temporary Pole ☐

Old Bldg. ☐

CONTRACTOR'S NAME:

STATE
LICENSE #

CITY
LICENSE #

NUMBER	FIXTURE OR INSTALLATION	UNIT PRICE
	Fixture or sockets	.15
	Light, receptacle or switch outlet	.20
	Wall or ceiling space heater	.35
	Blast coil heater per kilowatt	.35
	Garbage grinder outlet	.35
	Dishwasher outlet	.35
	Clothes dryer outlet	.35
	Automatic clothes washer	.35
	Electric range outlet	.35
	Electric water heater outlet	.35
	Mercury arc lamp and equipment	.35
	Special purpose outlet	.35
	X-ray unit and its appurtenances	5.00
	Watts of festoon lighting (Watts) First 3,000 watts	4.00
	for each additional thousand watts	1.50
	Horsepower - all motors first horsepower or less	1.75
	for each additional horsepower	.35
	Temporary power and lights (temporary pole)	4.00
	Electric service (including any single meter socket)	3.00
	for each additional socket	.35
	Air conditioning service	amps 1.50
	Each KW (KVA) Generator (Transformer) (Welder) KW (KVA)	2.00
	First 100 KVA - For each additional KW (KVA)	.01
	Special inspection per hour	4.00
	Speaker outlets	.15
	Signal or Alarm outlets	.15
	Amplifiers	.50
	Control panels	.25
	T. V. outlets - master system only	.15
	Radio outlets	.15
	Main control racks	1.00
	T. V. and Radio antennas - master system only	.75
	Minimum fee for any permit	4.00
	Total fee	

I hereby certify that I have carefully examined and read the above application; that the same is true and correct; and that the work herein described is to be done in accordance with all the provisions of the applicable Ordinances of the City of Las Vegas, Nevada and State laws whether herein specified or not.

SIGNED

Douglas Jenkins

Date

MASTER (ELECTRICIAN) (TECHNICIAN) (OWNER)

BUILDING DEPARTMENT

J. W. Wynn

Date

7-7-68

#1286

PERMIT NO.

25906

PERMIT FEE: \$

400

RECEIPT

2245 \$004.00 - 6

CITY OF LAS VEGAS

DEPT. OF

BUILDING & SAFETY

MUST BE MACHINE VALIDATED

12 JUL 68

J. Jones 10/12/67

DEPT. of BLDG. & SAFETY - CITY of LAS VEGAS, NEVADA

OWNER Douglas Jenkins ADDRESS 6113 Empire Cir. DATE 7/12/68

GEN. CONT. Owner TYPE OF STRUCTURE Enc Carport

PERMIT NO 43576 LEGAL DESCRIPTION L 57 B 1 Charleston Heights #28-A

BUILDING	MECHANICAL	ELECTRICAL
LOCATION	PLUMBING CONT.	TEMP. POLE CONT.
FIREPLACE FTS.	PERMIT NO. DATE	PERMIT NO. DATE
FOOTINGS	HEAT & VENT. AC CONT.	INSPECTION <u>Owner</u> DATE
FOUNDATION WALL	PERMIT NO. DATE	ELECTRICAL CONT.
FLOOR FRAMING	SEWER CONT.	PERMIT NO. <u>25906</u> DATE <u>7/12/68</u>
SLAB	PERMIT NO. DATE	FIXTURES CONT.
CHIMNEY, STEEL (REPLACE)	ROUGH SOIL	PERMIT NO. DATE
WALL STEEL	ROUGH WATER	SLAB
COLUMN STEEL	TOP-OUT	ROUGH <u>Miller 10-10-67</u>
BEAM STEEL	ROUGH GAS	FINAL ROUGH
FRAMING <u>2-4-10-14-67</u>	AC ROUGH DUCT	FINAL FIXTURE
ROOF SHEATHING	REF. ROUGH PIPING	FINAL ELECTRICAL
INTERIOR	FINAL PLUMBING	TEMPORARY SERVICE
EXTERIOR	FINAL GAS	
DRYWALL	FINAL AIR COND.	
LATHING	FINAL REFRIG.	
BACKING (SHIMS)	FINAL SEWER	
SCRATCH	FINAL SEPTIC TANK	
PLASTER		
BROWN		
URBAN REDEVELOPMENT APPROVAL		
FINAL BLDG. DATE		

APPROVED FOR OCCUPANCY & METER Office 2-17-67 INSPECTOR

PLEASE NOTE REMARKS ON REVERSE SIDE 6113 Empire Cir. LOG # 23.04

DEPT. of BLDG. & SAFETY - CITY of LAS VEGAS, NEVADA

OWNER SPRONI HOMES INC. ADDRESS 6113 Empire Circle DATE 8-24-67

GEN. CONT. owner TYPE OF STRUCTURE S.F. Dwl.

PERMIT NO 5733 LEGAL DESCRIPTION Lot 51 Block 1 Chas Hts #28-A

BUILDING	MECHANICAL	ELECTRICAL
LOCATION	PLUMBING CONT.	TEMP. POLE CONT.
FIREPLACE FTS.	PERMIT NO. DATE	PERMIT NO. DATE
FOOTINGS	HEAT & VENT. CONT.	INSPECTION DATE
FOUNDATION WALL	PERMIT NO. DATE	ELECTRICAL CONT.
FLOOR	SEWER CONT.	PERMIT NO. DATE
SLAB	PERMIT NO. DATE	OUTLETS
ANCHOR BOLTS	ROUGH SOIL	MOYORS
BASE PLATES	ROUGH WATER	SLAB
WALL STEEL	TOP-OUT	ROUGH
COLUMN STEEL	ROUGH GAS	FINAL ROUGH
BEAM STEEL	AC ROUGH DUCT	FIXTURES CONT.
FRAMING	REF. ROUGH PIPING	PERMIT NO. DATE
ROOF SHEATHING	SEWER	FIXTURES
STEEL FABRICATION	SEPTIC TANK	FINAL FIXTURE
STEEL CONNECTION		
INTERIOR		
EXTERIOR		
LATHING		
BACKING		
SCRATCH		
PLASTER		
BROWN		
FINAL BLDG. DATE		
GRADING & DRAINAGE		
ON-SITE PARKING SPACES		
ENG. APPROVAL OF		
OFF-SITE IMPROVEMENTS		

APPROVED FOR OCCUPANCY Office 11-17-67 INSPECTOR

APPROVED FOR METER Office 11-17-67

PLEASE NOTE REMARKS ON REVERSE SIDE 6113 Empire Circle LOG # T-47 AREA # 4 23.04