

1413 Eastern S

L9 B3 Eastwood Tr #1 Zone R-1

H. Delwood 3-22-79

1967

PERMIT FEE \$ 4.00

CITY OF LAS VEGAS, NEVADA

DEPARTMENT OF BUILDING & SAFETY

ADDRESS OF

CONSTRUCTION: 1413 EASTERN

CIRCLE: New bldg; Old bldg; Add'n; Remodel; TYPE OF BLDG. SFD

CONTRACTOR'S NAME: Deluca Sheet Metal

Unit furnished by Sears

APPLICATION & PERMIT FOR
AIR CONDITIONING

OWNER'S NAME: Z. FERNANDEZ DIAZ

STATE APT. COMM.

LICENSE # 6018 CITY LICENSE

UNITS	HEATERS	PRICE	FEE	UNITS	GAS	PRICE
	Unit Heaters (floor, suspended & wall)	\$2.00			Gas piping system 1 to 5 outlets	\$3.00
	Floor Furnace	\$3.00			Gas piping system over 5 outlets (per outlet)	.20
	Forced Air or Gravity Type, under 100,000 BTU's	\$7.00			Swimming pool heater	\$4.00
	Steam or hot water heating system under 15 outlets (Boiler Excluded)	\$8.00			VENTS	
	Steam or hot water heating system 15 to 30 outlets (Boiler excluded)	\$10.00			Combustion products vent other than a chimney	\$1.00
	Each outlet over 30	.50			Residential kitchen or bathroom vent, each	.25
	Radiant type heating system under 1000 sq. ft. to be heated	\$ 8.00			Commercial Hood	\$4.00
	Radiant type heating system 1000 to 2000 sq. ft. to be heated	\$10.00			Ventilation system not a portion of any heating or air conditioning system up to \$1,000 valuation	\$5.00
	Each additional 500 sq. ft. over 2000 sq. ft.	.50			BOILER	
	AIR CONDITIONING				Boiler installation 15 H.P. and under	\$5.00
	Heat pump or refrigerant 3 tons or less	\$4.00			Boiler installation over 15 H.P.	\$10.00
	Heat pump or refrigerant 3 tons to 10 tons	\$6.00			REPAIR	
	Each addn. ton over 10 ton	.50			Inspection of alteration or replacement of any mechanical cooling equipment which is a portion of any air conditioning system	\$3.00
	Refrigeration system 3 ton or less	\$5.00			DUCT WORK (each opening ONLY)	.25
	Refrigeration system 3 to 10 ton	\$7.00			WATER TOWER	\$4.00
	Each addn. ton over 10 ton	.50			MINIMUM PERMIT FEE	\$4.00
	Evaporative cooler 5 outlets and under	\$3.00			TOTAL PERMIT FEE	4.00
	Evaporative cooler 5 to 10 outlets	\$5.00				
	Each addn. outlet over 10	.25				

I hereby certify that I have carefully examined & read the above application; that the same is true & correct; & that the work herein described is to be done in accordance with all the provisions of the applicable Ordinances of the City of Las Vegas and the State laws, whether herein specified or not.

SIGNED: Alan Deluca DATE: 2/2/67

BUILDING DEPARTMENT Janet Meyer DATE: 2-8-67

#1289 PERMIT NO. 14380 PERMIT FEE \$ 4.00

CITY OF LAS VEGAS
DEPT. OF
BUILDING & SAFETY

Must be machine validated

Y. Gatewood 3-22-79

CITY OF LAS VEGAS, NEVADA

DEPARTMENT OF BUILDING & SAFETY - ELECTRICAL APPLICATION & PERMIT

ADDRESS OF
CONSTRUCTION: 1413 Eastern

OWNER'S
NAME: Louis Diaz

LOT(S) BLOCK SUBDIVISION

Type of bldg. SFD ☒ Apt. ☐ Comm. ☐

Check Proper Construction: New Bldg. ☐ Addn. ☐ Remodel ☒ Temporary Pole ☐ Old Bldg. ☐

CONTRACTOR'S NAME: All-Rite Electric

STATE CITY
LICENSE # 8439 LICENSE # 9863

NUMBER	FIXTURE OR INSTALLATION	UNIT PRICE	
	Fixture or sockets	.15	
	Light, receptacle or switch outlet	.20	
	Wall or ceiling space heater	.35	
	Blast coil heater per kilowatt	.35	
	Garbage grinder outlet	.35	
	Dishwasher outlet	.35	
	Clothes dryer outlet	.35	
	Automatic clothes washer	.35	
	Electric range outlet	.35	
	Electric water heater outlet	.35	
	Mercury arc lamp and equipment	.35	
	Special purpose outlet	.35	
	X-ray unit and its appurtenances	5.00	
	Watts of festoon lighting (Watts) First 3,000 watts	4.00	
	for each additional thousand watts	1.50	
1	Horsepower - all motors first horsepower or less	1.75	1.75
2	for each additional horsepower	.35	.70
	Temporary power and lights (temporary pole)	4.00	
1	Electric service (including any single meter socket)	3.00	3.00
	for each additional socket	.35	
	Air conditioning service amps	1.50	
	Each KW (KVA) Generator (Transformer) (Welder) KW (KVA)	2.00	
	First 100 KVA - For each additional KW (KVA)	.01	
1	Special inspection per hour	4.00	
	Speaker outlets	.15	
	Signal or Alarm outlets	.15	
	Amplifiers	.50	
	Control panels	.25	
	T. V. outlets - master system only	.15	
	Radio outlets	.15	
	Main control racks	1.00	
	T. V. and Radio antennas - master system only	.75	
	Minimum fee for any permit	4.00	
	Total fee		5.45

I hereby certify that I have carefully examined and read the above application; that the same is true and correct; and that the work herein described is to be done in accordance with all the provisions of the applicable Ordinances of the City of Las Vegas, Nevada and State laws whether herein specified or not.

SIGNED [Signature] MASTER (ELECTRICIAN) (TECHNICIAN) (OWNER)

Date 2/15/67

BUILDING DEPARTMENT [Signature]

Date 2-16-67

#1286

PERMIT NO. 22788 PERMIT FEE: \$ 5.45

RECEIPT

1822 \$005.45 - 6

CITY OF LAS VEGAS

DEPT. OF
BUILDING & SAFETY

MUST BE MACHINE VALIDATED

16 FEB 67

D. Gatewood 3-22-79

24-12

CITY OF LAS VEGAS, NEVADA

LOG NO. & AREA

DEPARTMENT OF BUILDING & SAFETY

CONST. VAL. \$

5,100.00

APPLICATION & BUILDING PERMIT — for:
Dwellings, Duplexes, Misc. Residential Const.

ADDRESS OF
CONSTRUCTION:

1433 Eastern

OWNER:

Louis Fernandez

LOT(s)

9

BLOCK

3

SUBDIVISION

EASTWOOD TRACT I

ZONE

R1

Existing structure on lot: Dwelling



Accessory bldgs.



Vacant lot



Other



PROPOSED CONSTRUCTION:

Room addition

ONE bath
ONE bedroom

MATERIALS OF CONSTRUCTION:

Wood Frame



Concrete Block



Reinforced Concrete



Steel Frame



SQ. FEET OF FLOOR AREAS:

1st

2nd

3rd

Other

TOTAL SQ. FT.

510

FIRE ZONE: 1 2 3

Occupancy Group 1 J 1 - 2

CONST. TYPE

SI II VI V

ARCHITECT:

ENGINEER:

NO. of UNITS

NO. of STORIES

Plans Submitted:

Yes



No



Calculations Submitted

Yes



No



Sewer Fee Req'd.

Yes



No



CONTRACTOR:

OWNER

STATE
LICENSE

CITY
LICENSE

ADD'L. PERMITS REQ'D:

Air Cond.



Elev.



Plumbing



Signs



Paving



Fence



Public Works




Curb gutters



Incinerators



Fire Sprinkling System

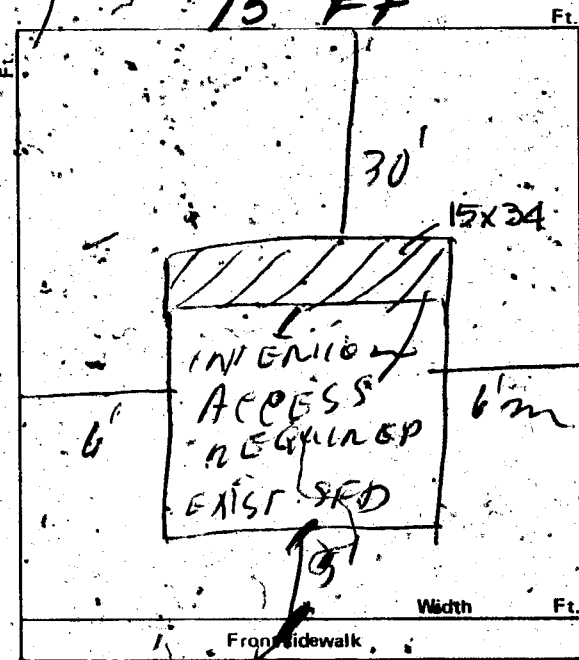

CONDITIONS OF THE PERMIT:

1. I agree to call the City Building Department for inspections before concrete is poured; before rough wiring, electrical, plumbing, framing is covered. Also for air conditioning, sheet-rock and sheathing inspection.
2. I agree that when the job is completed that I will call for final inspection before occupancy.
3. I agree to perform all construction in accordance with City Ordinances and Building Codes.
4. The Contractor's signature below denotes authority from the owner to sign in his behalf and that the owner is aware of all requirements of this application and permit. Separate permits must be taken out for work outlined above this agreement.
5. I have read and understand the contents of this application and permit; I hereby state that the information I have supplied on this application is true and correct.

Approval for the work under this permit will be given only after refuse and debris have been removed from job site and public right of way.

SIGNED:

Louis Fernandez

Contractor

BY:

Agent or Owner

CLARK COUNTY HEALTH DEPT.

Date

LAS VEGAS FIRE DEPARTMENT

Date

PLANNING DEPT.

Date:

2-25-76

PUBLIC WORKS DEPT.

Date:

2-25-76

BUILDING DEPT.

Date:

2-25-76

12850

PERMIT NO.:

809

PERMIT-FEE \$

3900

RECEIPT

7519 \$039.00 - 8

CITY OF LAS VEGAS
DEPT. OF
BUILDING & SAFETY

MUST BE MACHINE VALIDATED

26 FEB 76

J. Gatewood 3-22-79

24-12

CITY OF LAS VEGAS, NEVADA

LOG NO. & AREA

DEPARTMENT OF BUILDING & SAFETY

CONST. VAL. \$

5,100.00

APPLICATION & BUILDING PERMIT — for:
Dwellings, Duplexes, Misc. Residential Const.

ADDRESS OF
CONSTRUCTION:

1433 Eastern

OWNER:

Louis Fernandez

LOT(s)

9

BLOCK

3

SUBDIVISION

EASTWOOD TRACT I

ZONE

R1

Existing structure on lot: Dwelling

☐

Accessory bldgs.

☐

Vacant lot

☒

Other

☐

PROPOSED CONSTRUCTION:

Room addition

one bath
one bedroom

MATERIALS OF CONSTRUCTION:

Wood Frame

☐

Concrete Block

☒

Reinforced Concrete

☐

Steel Frame

☒

SQ. FEET OF FLOOR AREAS:

1st

2nd

3rd

Other

TOTAL SQ. FT.

972

FIRE ZONE: 1 2 3

Occupancy Group 1 J 1 - 2

CONST. TYPE

II

ARCHITECT:

ENGINEER:

NO. of UNITS

NO. of STORIES

Plans Submitted:

Yes

☒

No

☐

Calculations Submitted

Yes

☐

No

☐

Sewer Fee Req'd.

Yes

☐

No

☒

CONTRACTOR:

OWNER

STATE
LICENSE

CITY
LICENSE

ADD'L PERMITS REQ'D:

Air Cond.

☐

Elec.

☒

Plumbing

☒

Signs

☐

Paving

☒

Fence

☒

Public Walks

☐

Curb gutters


☐

Incinerators

☐

Fire Sprinkling System

☐

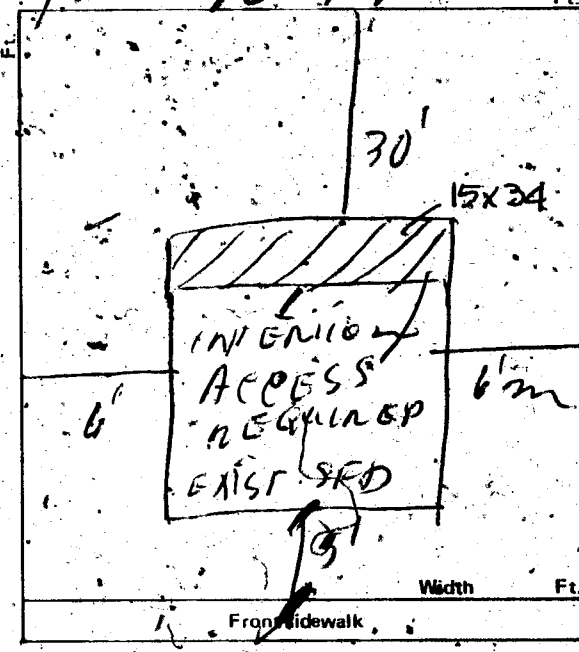

CONDITIONS OF THE PERMIT:

1. I agree to call the City Building Department for inspections before concrete is poured, before rough wiring, electrical, plumbing, framing is covered. Also for air conditioning, sheet-rock and sheathing inspection.
2. I agree that when the job is completed that I will call for final inspection before occupancy.
3. I agree to perform all construction in accordance with City Ordinances and Building Codes.
4. The Contractor's signature below denotes authority from the owner to sign in his behalf and that the owner is aware of all requirements of this application and permit. Separate permits must be taken out for work outlined above this agreement.
5. I have read and understand the contents of this application and permit; I hereby state that the information I have supplied on this application is true and correct.

Approval for the work under this permit will be given only after refuse and debris have been removed from job site and public right of way.

SIGNED:

Louis Fernandez

Contractor

BY:

Agent or Owner

CLARK COUNTY HEALTH DEPT.

Date

LAS VEGAS FIRE DEPARTMENT

Date

PLANNING DEPT.

Date:

2-25-76

PUBLIC WORKS DEPT.

Date:

2-25-76

BUILDING DEPT.

Date:

2-25-76

12850

PERMIT NO.:

809

PERMIT-FEE \$

3900

RECEIPT

7519 \$039.00 - 8

CITY OF LAS VEGAS
DEPT. OF
BUILDING & SAFETY

MUST BE MACHINE VALIDATED

26 FEB 76

Y. Dated 3-22-79

CITY OF LAS VEGAS, NEVADA

LOG NO. & AREA

DEPARTMENT OF BUILDING & SAFETY

CONST. VAL. \$

APPLICATION & BUILDING PERMIT for:

Dwellings, Duplexes, Misc. Residential Const.

ADDRESS OF CONSTRUCTION

1413 EASTERN

OWNER

LOUIS FERNANDEZ

LOT(s)

BLOCK

SUBDIVISION

EASTWOOD TR #1

ZONE

R-1

Existing structure on lot: Dwelling

☐

Accessory bldgs.

☐

Vacant lot

☐

Other

☐

PROPOSED CONSTRUCTION:

Roof overhang
MANAGED ROOF

USE:

MATERIALS OF CONSTRUCTION:

Wood Frame

☐

Concrete Block

☐

Reinforced Concrete

☐

Steel Frame

☐

SQ. FEET OF FLOOR AREAS:

1st

2nd

3rd

Other

TOTAL SQ. FT.

FIRE ZONE: 1 2 3

Occupancy Group 1 J 1 - 2

CONST. TYPE

I II III IV V

ARCHITECT:

ENGINEER:

NO. of UNITS

NO. of STORIES

Plans Submitted:

Yes

☐

No

☐

Calculations Submitted

Yes

☐

No

☐

Sewer Fee Req'd.

Yes

☐

No

☐

CONTRACTOR:

OWNER

STATE LICENSE #

CITY LICENSE #

ADD'L. PERMITS REQ'D:

Air Cond.

☐

Elec.

☐

Plumbing

☐

Signs

☐

Paving

☐

Fence

☐

Public Walks

☐

Curb gutters

☐

Incinerators

☐

Fire Sprinkling System

☐

CONDITIONS OF THE PERMIT:

1. I agree to call the City Building Department for inspections before concrete is poured, before rough wiring, electrical, plumbing, framing is covered. Also for air conditioning, sheet rock and sheathing inspection.
2. I agree that when the job is completed that I will call for final inspection before occupancy.
3. I agree to perform all construction in accordance with City Ordinances and Building Codes.
4. The Contractor's signature below denotes authority from the owner to sign in his behalf and that the owner is aware of all requirements of this application and permit. Separate permits must be taken out for work outlined above this agreement.
5. I have read and understand the contents of this application and permit; I hereby state that the information I have supplied on this application is true and correct.

Approval for the work under this permit will be given only after refuse and debris have been removed from job site and public right of way.

SIGNED:

Contractor

BY:

Agent or Owner

CLARK COUNTY HEALTH DEPT.

LAS VEGAS FIRE DEPARTMENT.

PLANNING DEPT.

Date:

4/5/76

PUBLIC WORKS DEPT.

Date:

BUILDING DEPT.

Date:

4-5-76

PERMIT NO.:

1693

PERMIT FEE \$

500

RECEIPT

9495 \$005.00 - 8

CITY OF LAS VEGAS
DEPT. OF
BUILDING & SAFETY

MUST BE MACHINE VALIDATED

- 6 APR 76

1. H. Gatenwood 3-22-79

CITY OF LAS VEGAS, NEVADA

DEPARTMENT OF BUILDING & SAFETY - APPLICATION AND PERMIT FOR PLUMBING

ADDRESS OF CONSTRUCTION: 1413 EASTERN OWNER'S NAME: Lewis, Fernandes
CIRCLE: New Bldg.; Add'n.; Remodel; TYPE OF BLDG.: SFD. APT. PUBLIC COMM.
CONTRACTOR'S NAME: OWNER STATE LICENSE # _____ CITY LICENSE # _____

UNITS	DESCRIPTION	FEE	TOTAL
	Bathtub	1.00	
/	Shower	1.00	
/	Lavatory	1.00	
/	Toilet	1.00	
	Urinal	1.00	
	Floor Drain	1.00	
	Floor Sink	1.00	
/	Wash Tray	1.00	
	Sink	1.00	
	Garbage Disposal	1.00	
	Garbage Disposal (comm.)	3.00	
	Clothes Dryer (gas)	1.00	
	Clothes Washer	1.00	
	Clothes Washer (comm.)	5.00	
	Dishwasher	1.00	
	Dishwasher (commercial)	5.00	
	Dental Unit	10.00	
	Drinking Fountain	1.00	
	Any Water using Equipment	1.00	
	Water Heater (gas) (elect.)	1.00	
/	Sewer System - New, Replacement, or any Drainage System	4.00	
	Grease or Sand Trap	2.00	
	Trailer Trap	2.00	
	Septic Disposal System	4.00	
WATER SOFTENERS			
	Nonpermanent Type	4.00	
	Permanent Type (connected to Drainage)	5.00	
SWIMMING POOLS			
	Private or Wading Pool	10.00	
	Public or Semi-public	20.00	

UNITS	DESCRIPTION	FEE	TOTAL
WATER DISTRIBUTION SYSTEM			
	Single Family Dwelling	4.00	
	Multiple Family Dwelling plus each unit	4.00 2.00	
	Bldg. Group "A" thru "G" per each floor	6.00	
	Hotel or Motel plus each bath	4.00 1.50	
	Trailer Park plus each space	20.00 1.00	
	Irrigation	4.00	
GAS PIPING SYSTEM			
	Single Family Dwelling	3.00	
	Multiple Family Dwelling plus each unit	6.00 1.00	
	Commercial Bldg. per floor plus each unit	3.00 3.00	
	Gas Appliance (any type)	1.00	
AUTOMATIC FIRE EXTINGUISHING SYSTEM			
	Underground Piping	10.00	
	Distribution Piping ea. ft.	.01	
	Sprinkler Head each	1.00	
	In Range Hood and Vent	5.00	
DRY STANDPIPE SYSTEM			
	Piping	50.00	
	Each Outlet	1.00	
WET STANDPIPE SYSTEM			
	Piping	5.00	
	Fire Hose Cabinet	1.00	
	MINIMUM PERMIT FEE	4.00	
PIPELINE CONTRACTOR, SECT 14 B P F			
TOTAL PERMIT FEE \$			

I hereby certify that I have carefully examined and read the above application, that the same is true and correct, and that the work herein described is to be done in accordance with all the provisions of the applicable Ordinances of the City of Las Vegas, Nevada and the State Laws, whether herein specified or not.

Approval for the work under this permit will be given only after refuse and debris have been removed from job site and public right of way.

Signed: [Signature] Date: _____
Registered Master Plumber, Spec. Contr. or Owner
Building Department: MM Date: 4-76
Permit No. 1418 Permit Fee \$ 8.00
#12870

RECEIPT
419 \$008.00 - 7
CITY OF LAS VEGAS
DEPT. OF
BUILDING & SAFETY
MUST BE MACHINE VALIDATED
20 APR 76

G. Gatewood 3-22-79

file 1413 ~~no~~ ~~action~~
STOP WORK ORDER

placed on job at: 1413 Perten

Contractor/Owner: Owner

DATE 10-22-76 TIME 11:15

REASON Set back Violation

Inspector: W. P. Quibant

Removal date: _____ Time: _____

Removal authorized by: _____

10.00 FEE Applicable (yes) (no) Paid (yes) (no)