

1900 FERRELL"

SEE APPLICATION FOR LEGAL

Howa Lateral 9-79

CITY OF LAS VEGAS, NEVADA
DEPARTMENT OF BUILDING AND SAFETY
APPLICATION FOR FENCE, WALL OR
RETAINING WALL

LOG NO. _____

AREA: _____

KARDEX CARD: _____

TELEPHONE: 878-7524

CONSTRUCTION VALUATION: 1250.00

INSPECTION VALUATION: 996.00

PERMIT FEE: 9.00

PERMIT NUMBER: 32330

DATE: Jan 24 1966

ADDRESS OF _____

OWNER'S NAME _____

OWNER'S ADDRESS _____

CONSTRUCTION: 4 Helly Drive

NAME _____

ADDRESS 3009 Helly Dr.

APOR OF THE NEIGH.

SW 1/4, SEC. 10, T. 15S, R. 61E

Zone: R-E

Lot (s) _____ Block _____

Subdivision _____

Materials of Concrete

Construction: Block () Concrete () Wire (X) Wood (X) Other ()

Total Square Feet: 51,792

Total Linear Feet 996

STATE

LICENSE # _____

CITY

LICENSE # _____

CONTRACTOR'S NAME: _____

Architect's Name: _____


Engineer's Name: _____

PLANS SUBMITTED: Yes _____ No _____

CALCULATIONS: Yes _____ No _____

Street Name: FERRELL

Front Yard: _____ Feet

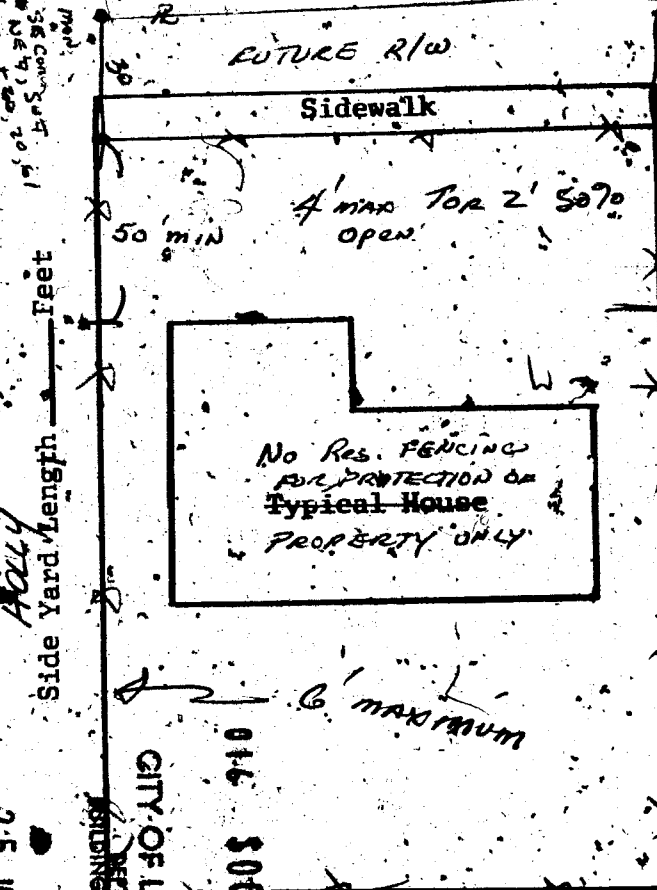

I understand that any portion of this (fence) (wall) constructed or erected on City property or right-of-way will be removed from said location at my expense upon request received from the City of Las Vegas, Nevada. I understand that the (fence) (wall) shall not enclose water meter, light standard, fire alarm box and shall not come closer than two (2') feet in any direction from any fire hydrant. I further state that I am familiar with effective Ordinances of the City of Las Vegas, Nev. and effective Statutes of the State of Nevada covering construction and use of above type; I agree to perform said construction in conformity therewith. I further agree that issuance of a permit on above application will not excuse me from conforming with said Ordinances and Statutes, despite any errors on the part of the Building Inspector or Engineer in checking plans and applications herewith submitted.

I have read and understand the contents of above application; I hereby state that same are true and correct.

SIGN HERE: _____

By: _____

APPROVED BY: _____
PLANNING DEPT. & CODE ASSISTANCE DATE: 1/24/66

FIRE DEPARTMENT DATE: _____

ENGINEERING DEPT. DATE: _____

BUILDING & SAFETY DEPT. DATE: 1-24-66

Note: Owner or Contractor must call for all inspections required.

DEPARTMENT OF BUILDING & SAFETY
CITY OF LAS VEGAS, NEVADA

KARDEX CARD
FENCE & RETAINING
WALLS

OWNER D. E. YOUNG

ADDRESS 1900 Ferrell

DATE 1/24/66

CONTRACTOR Owner - Same

PERMIT NO. 32330

For NE 1/4, SW 1/4, Sec. 20, T20S R61 E, S 156' of W 312'

LOT BLOCK SUBDIVISION

Fence (wire, wood, etc.)		Wire fence		Walls (masonry, rock, etc.)	
Location <u>21-26-16</u>		Location <u> </u>		Location <u> </u>	
Final Inspection <u>2-2-66 2-2-66</u>		Footing <u> </u>		Footing <u> </u>	
Wall Steel 1st <u> </u> 2d <u> </u> 3d <u> </u>		Wall Steel 1st <u>2-1-66</u> 2d <u> </u> 3d <u> </u>		Wall Steel 1st <u> </u> 2d <u> </u> 3d <u> </u>	
Bond Beam 1st <u> </u> 2d <u> </u> 3d <u> </u>		Final Inspection <u> </u>		Final Inspection <u> </u>	
Retaining Wall (masonry)		Retaining Wall (concrete)		Retaining Wall (concrete)	
Location <u> </u>		Location <u> </u>		Location <u> </u>	
Footing <u> </u>		Footing <u> </u>		Footing <u> </u>	
Wall Steel 1st <u> </u> 2d <u> </u> 3d <u> </u>		Wall Steel 1st <u> </u> 2d <u> </u> 3d <u> </u>		Wall Steel 1st <u> </u> 2d <u> </u> 3d <u> </u>	
Bond Beam 1st <u> </u> 2d <u> </u> 3d <u> </u>		Final Inspection <u> </u>		Final Inspection <u> </u>	
Final Inspection <u> </u>		Final Inspection <u> </u>		Final Inspection <u> </u>	

23.14 B

ADDRESS 1900 Ferrell

LOG NO.

AREA