


1212 ARROWHEAD

LOT 16 BLK 23 TWIN LAKES VILLAGE ZONE R-1

CITY OF LAS VEGAS, NEVADA
Department of Building and Safety

CERTIFICATE OF INSPECTION

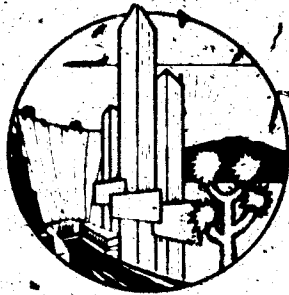

Address 1212 Arrowhead Owner Mr. Vakanes
Legal Lot 16 Blk 23 Twin Lakes Village 4-21-77

This certificate issued pursuant to the requirements of Section 306 of the
UNIFORM BUILDING CODE certifying that at the time of this issuance
the improvements on this property were in compliance with CITY OF LAS
VEGAS, HOUSING, BUILDING, ELECTRICAL, PLUMBING and MECH-
ANICAL CODES

DIRECTOR
Department of Building & Safety

N. Miller

This Certificate does not include conditions subject to normal maintenance.

No. GR:271900

Fee \$ 10.00

RECEIPT

Must be machine validated

PAID

4-18-77

N.M.

12850

MAYOR BILL BRIARE
 COMMISSIONERS
 PAUL J. CHRISTENSEN
 RON LURIE
 MYRON E. LEAVITT
 ROY WOOFER
 CITY ATTORNEY
 CARL E. LOVELL, JR.
 CITY MANAGER
 WILLIAM E. ADAMS, P.E.



CITY of LAS VEGAS



DEPARTMENT BUILDING & SAFETY
 BUILDING INSPECTION REPORT OF REQUIREMENTS FOR COMPLIANCE WITH CITY OF LAS VEGAS
 BUILDING CODES AND ZONING ORDINANCE

ADDRESS 1212 W. Sahara

OWNER _____

DATE 2-1-79

PERMITS REQUIRED

BLDG. ☒ and Car Garage

ELEC. ☒

PLBG. ☐

A.C. ☐

CORRECTIONS TO BE MADE


BLDG. _____

ELEC. _____

PLBG. _____

A.C. _____

MISC. _____

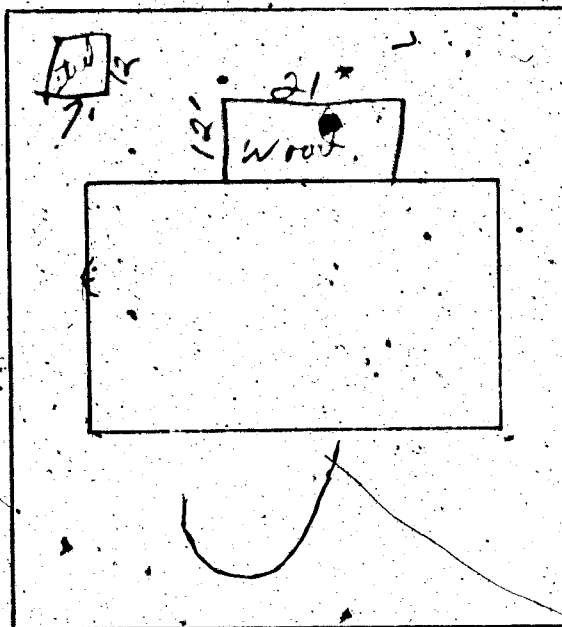

CERTIFICATE OF INSPECTION

APPROVED [Signature] DATE 2-1-79

☐ NOT APPROVED - CALL FOR
 REINSPECTION
 386 6251

REMARKS _____

BLDG. INSPECTOR _____

CITY OF LAS VEGAS, NEVADA
DEPT. OF PUBLIC SERVICES

LOG NO. & AREA

DIVISION OF BUILDING & SAFETY
PHONE: 386-6251

CONST. VAL. \$ 2000⁰⁰

APPLICATION & BUILDING PERMIT - for:
Dwellings, Duplexes, Misc. Residential Const.

ADDRESS OF
CONSTRUCTION:

1212 Arrowhead

OWNER: VAKANAS, George

LOT(s) 16 BLOCK 23 SUBDIVISION TWIN LAKES VILLAGE H.S. ZONE R-1

Existing structure on lot: Dwelling ☒ Accessory bldgs. ☐ Vacant lot ☐ Other ☐

PROPOSED CONSTRUCTION:

ENC. Garage, Wind patio, Steel

USE:

MATERIALS OF CONSTRUCTION: Wood Frame ☐ Concrete Block ☒ Reinforced Concrete ☐ Steel Frame ☐

SQ. FEET OF FLOOR AREAS: 1st 2nd 3rd Other TOTAL SQ. FT. 200

FIRE ZONE: Occupancy Group

CONST. TYPE:

ARCHITECT: ENGINEER: NO. of UNITS NO. of STORIES


Plans Submitted: Yes ☐ No ☐ Calculations Submitted: Yes ☐ No ☐ Sewer Fee Req'd: Yes ☐ No ☐

CONTRACTOR: OWNER

STATE
LICENSE #

CITY
LICENSE #

ADD'L. PERMITS REQ'D: Air Cond. ☐ Elec. ☐ Plumbing ☐ Signs ☐ Paving ☐ Fence ☐ Public Walks ☐ Curb-gutters ☐
Incinerators ☐ Fire Sprinkling System ☐

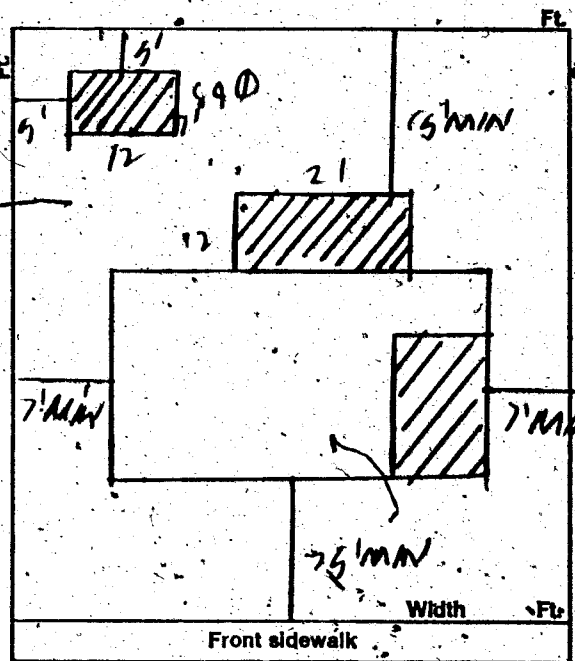

CONDITIONS OF THE PERMIT:

1. I agree to call the City Building Department for inspections before concrete is poured, before rough wiring, electrical, plumbing, framing is covered. Also for air conditioning, sheet-rock and sheathing inspection.
2. I agree that when the job is completed that I will call for final inspection before occupancy.
3. I agree to perform all construction in accordance with City Ordinances and Building Codes.
4. The Contractor's signature below denotes authority from the owner to sign in his behalf and that the owner is aware of all requirements of this application and permit. Separate permits must be taken out for work outlined above this agreement.
5. I have read and understand the contents of this application and permit; I hereby state that the information I have supplied on this application is true and correct.

SIGNED: Contractor

BY: Linda Scott Agent or Owner

CLARK COUNTY HEALTH DEPT. Date

LAS VEGAS FIRE DEPARTMENT Date

PLANNING DEPT. Date: 4-21-77

PUBLIC WORKS DEPT. Date:

BUILDING DEPT. Date: 4-21-77

PERMIT NO: 2177 PERMIT FEE \$ 15.00

9171 RECEIVED 8

CITY OF LAS VEGAS
DEPT. OF
BUILDING & SAFETY

21 APR 77
MUST BE MACHINE VALIDATED

CITY OF LAS VEGAS, NEVADA

DIVISION OF BUILDING & SAFETY - ELECTRICAL APPLICATION & PERMIT

ADDRESS OF CONSTRUCTION: 1212 Arkadhead OWNER'S NAME: UAKANAS George

CIRCLE: New Bldg.; Add'n.; Remodel; TYPE OF BLDG.: SFD. APT. PUBLIC COMM.

CONTRACTOR'S NAME: Owner STATE LICENSE # _____ CITY LICENSE # _____

NUMBER	FIXTURE OR INSTALLATION	UNIT PRICE	TOTAL
	Am addition, carport or garage enclosure	4.00	
	Temporary Power	4.00	
	Light, receptacle or switch outlet	.20	
	Wall or ceiling space heater	.35	
	Garbage grinder outlet	.35	
	Dishwasher outlet	.35	
	Clothes dryer outlet	.35	
	Automatic clothes washer	.35	
	Electric range outlet	.35	
	Electric water heater outlet	.35	
	Special purpose outlet	.35	
	X-ray unit and its appurtenances	5.00	
	Watts of festoon lighting (Watts) First 3,000 watts	4.00	
	for each additional thousand watts	1.50	
	Horsepower each motor first horsepower or less	1.75	
	for each additional horsepower	.35	
	Electric service (including any single meter socket)	3.00	
	for each additional socket	.35	
	Air conditioning service	1.50	
	Each KW(KVA) Generator (Transformer, Welder) First 100 KVA	2.00	
	for each additional KW(KVA)	.01	
	Speaker, signal or alarm outlet	.15	
	Amplifiers	.50	
	Control panels	.25	
	Main control racks	1.00	
	T.V. and radio antennas master system only	.75	
	Minimum fee for any permit	4.00	
	TOTAL FEE		

Approval for the work under this permit will be given only after refuse and debris have been removed from job site and public right of way.

I hereby certify that I have carefully examined and read the above application; that the same is true and correct; and that the work herein described is to be done in accordance with all the provisions of the applicable Ordinances of the City of Las Vegas, Nevada and State laws whether herein specified or not.

SIGNED Heidi Smith DATE _____
MASTER (ELECTRICIAN) (TECHNICIAN) (OWNER)
 BUILDING DEPARTMENT MM DATE 4-21-77
 PERMIT NO. 1045 PERMIT FEE: \$ 4.00

RECEIPT

9172 \$004.00 - 6

CITY OF LAS VEGAS
DEPT. OF BUILDING & SAFETY
 MUST BE MACHINE VALIDATED

7 APR 77

1 Gloria Ealy 11-24-80

DIVISION of BUILDING & SAFETY - CITY of LAS VEGAS, NEVADA
OWNER George Vakanas ADDRESS 1212 Arrowhead DATE 4-21-77
GEN. CONT. Owner TYPE OF STRUCTURE enc garage, wood patio
PERMIT NO. 2177 LEGAL DESCRIPTION L 16 B 23 Twin Lakes steel shed for

BUILDING	MECHANICAL	CERTIFICATION ELECTRICAL
Investigation	Plumbing Cont.	Temp. pole cont.
Location & Footing	Permit No. _____ Date _____	Permit No. _____ Date _____
Stem Wall	Heat & Vent. A/C Cont.	Inspection _____ Date _____
Concrete Slab Floor	Permit No. _____ Date _____	Electrical Cont.
Floor Framing	Sewer Cont.	Permit No. _____ Date _____
Fireplace Footing	Permit No. _____ Date _____	Fixtures Cont.
Chimney Steel	Rough Soil	Permit No. _____ Date _____
Veff. Steel Reinf.	Rough Water	Slab
Horiz. Steel Reinf.	Top-Out	Rough
Roof Sheathing	Rough Gas	Final Rough
Framing	A/C Rough Duct	Final Fixture
Backing for siding	Ref. Rough Piping	Final Electrical
Ext. Lath	Final Plumbing	
Ext. Scratch	Final Gas	Temporary Service
Ext. Brown	Final Air Cond.	
Int. Lath	Final Refrig.	MISCELLANEOUS
Int. Brown	Final Sewer	
Drywall	Final Septic Tank	Grading & Drainage
Insulation		On-Site Parking Spaces App. _____
Final Building		Eng. Approval of _____
Appr. for Occu. R.P. 4-19-77		Off-Site Improvements

INSPECTOR: _____

DATE _____

APPROVED FOR OCCUPANCY & METER _____

PLEASE NOTE REMARKS ON REVERSE SIDE

1212 Arrowhead

LOG # _____

AREA # _____

76-11-4

DEPT. of BLDG. & SAFETY - CITY of LAS VEGAS, NEVADA
OWNER P. A. GARDNER ADDRESS 1212 Arrowhead DATE 2-18-57
GEN. CONT. OWNER TYPE OF STRUCTURE REDWOOD FENCE
PERMIT NO. 28109 LEGAL DESCRIPTION Lot 16, Bl. 23, Twin Lakes #5.

LOCATION & FLOOR ELEVATION	PLUMBING CONT.	TEMP. POLE CONT.
FOOTINGS	PERMIT NO. _____ DATE _____	PERMIT NO. _____ DATE _____
FOUND. & PIERS	HEAT. & VENT. CONT.	INSPECTION _____ DATE _____
WALL STEEL	PERMIT NO. _____ DATE _____	ELECTRICAL CONT.
BOND BEAM STEEL	SEWER CONT.	PERMIT NO. _____ DATE _____
FRAMING & ROOF SHEATHING	PERMIT NO. _____ DATE _____	OUTLETS _____
STEEL FABRICATION	ROUGH SOIL _____	MOTORS _____ H.P. _____
CONNECTIONS & PAINTING	ROUGH WATER _____	SLAB _____
INTERIOR EXTERIOR	SEWER OR SEPTIC TANK _____	ROUGH _____
LATHING	TOP-OUT _____	FINAL ROUGH _____
PLASTER	ROUGH GAS _____	FIXTURE CONT.
SCRATCH	ROUGH DUCT _____	PERMIT NO. _____ DATE _____
BROWN	FINAL PLUMBING _____	FIXTURES _____
FINAL BLDG. 2-18-57	FINAL HEATING _____	FINAL FIXTURE _____
GRADING & DRAINAGE	FINAL GAS _____	
ON-SITE PARKING SPACES		APPROVED FOR METER: _____
ENG. APPROVAL OF		
OFF-SITE IMPROVEMENTS		

APPROVED for OCCUPANCY: _____

INSPECTOR

DATE

* PLEASE NOTE REMARKS ON REVERSE SIDE

1212 Arrowhead - REDWOOD FENCE

2/18/57

23 04