

2028 Alturas

Lot 19 Blk 2 Woodland Park

Reverse Remarks 11-3-80

DEPT. of BLDG. & SAFETY - CITY of LAS VEGAS, NEVADA

OWNER Roberts Workman ADDRESS 2028 Alturas DATE 6-13-73
GEN. CONT. Owner
PERMIT NO. 11748 TYPE OF STRUCTURE Storage shed
LEGAL DESCRIPTION L 19 B 2 Woodland Park

BUILDING	MECHANICAL	ELECTRICAL
Investigation	Plumbing Cont.	Temp. pole cont.
Location & Footing	Permit No. _____ Date _____	Permit No. _____ Date _____
Stem Wall	Heat & Vent. A/C Cont.	Inspection _____ Date _____
Concrete Slab Floor	Permit No. _____ Date _____	Electrical Cont.
Floor Framing	Sewer Cont.	Permit No. _____ Date _____
Fireplace Footing	Permit No. _____ Date _____	Fixtures Cont.
Chimney Steel	Rough Soil	Permit No. _____ Date _____
Vert. Steel Reinf.	Rough Water	Slab
Horiz. Steel Reinf.	Top Out	Rough
Roof Sheathing	Rough Gas	Final Rough
Framing	A/C Rough Duct	Final Fixture
Backing for siding	Ref. Rough Piping	Final Electrical
Ext. Lath	Final Plumbing	Temporary Service
Ext. Scratch	Final Gas	MISCELLANEOUS
Ext. Brown	Final Air Cond.	
Int. Lath	Final Refrig.	Grading & Drainage
Int. Brown	Final Sewer	On Site Parking Spaces App. _____
Drywall	Final Septic Tank	Eng. Approval of
Permit No. _____		Off Site Improvements
Final Building		
Appr. for Occu.		

INSPECTOR:

DATE

APPROVED FOR OCCUPANCY & METER

PLEASE NOTE REMARKS ON REVERSE SIDE

2028 Alturas

LOG #

AREA #

CITY OF LAS VEGAS, NEVADA

LOG NO. & AREA

DEPARTMENT OF BUILDING & SAFETY

CONST. VAL. \$

720.00

APPLICATION & BUILDING PERMIT - for:

Residential Const.

ADDRESS OF CONSTRUCTION

2228 Alturas

OWNER

Roberta Workman

LOT

19

BLOCK

7

SUBDIVISION


ZONE

RE

Existing structure on lot: Dwelling

☐

Accessory

☐

Warehouse

☐

Other

☐

PROPOSED CONSTRUCTION:

Storage shed

USE:

MATERIALS OF CONSTRUCTION:

Wood Frame

☐

Concrete

☐

Reinforced Concrete

☐

Steel Frame

☐

SQ. FEET OF FLOOR AREAS:

1st

2nd

3rd

4th

TOTAL SQ. FT.

240

FIRE ZONE:

1

2

3

Occupancy Group

1

2

3

CONST. TYPE:

I

II

III

IV

V

ARCHITECT:

ENGINEER:

NO. of UNITS

NO. of STORES

Plans Submitted: Yes ☐ No ☐

Calculations Submitted: Yes ☐ No ☐

Sewer Fee Req'd: Yes ☐ No ☐

CONTRACTOR:

Owner

STATE LICENSE #

CITY LICENSE #

ADD'L PERMITS REQ'D: Air Cond. ☐

Elec. ☐

Plumbing ☐


Signs ☐

Fencing ☐

Fence ☐

Public Works ☐

Curb-gutters ☐

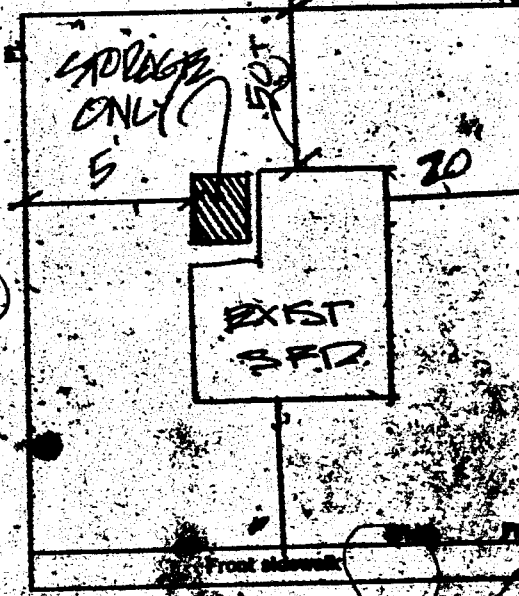

CONDITIONS OF THE PERMIT:

1. I agree to call the City Building Department for inspections before concrete is poured, before rough wiring, electrical, plumbing, framing is covered. Also for air conditioning, sheet-rock and sheathing inspection.
2. I agree that when the job is completed that I will call for final inspection before occupancy.
3. I agree to perform all construction in accordance with City Ordinances and Building Codes.
4. The Contractor's signature below denotes authority from the owner to sign in his behalf and that the owner is aware of all requirements of this application and permit. Separate permits must be taken out for work outlined above this agreement.
5. I have read and understand the contents of this application and permit; I hereby state that the information I have supplied on this application is true and correct.

SIGNED:

Roberta H. Workman

Contractor

Agent or Owner

CLARK COUNTY HEALTH DEPT.

Date

LAS VEGAS FIRE DEPARTMENT

Date

PLANNING DEPT.

PUBLIC WORKS DEPT.

BUILDING DEPT.

#12850

PERMIT NO.

4474

6/13/73

6-13-73

10 00

RECEIPT

\$1010.00 - 8

CITY OF LAS VEGAS

DEPT. OF

BUILDING & SAFETY

PERMIT BE MACHINE VALIDATED

7.3.73