

1904-06 CEDAR AVE.

LOT 3&4 BLK 6 BOULDER DAM HOMESITE #2 ZONE R-1

L. Gatewood 2-13-79

CITY OF LAS VEGAS, NEVADA
DEPARTMENT OF BUILDING & SAFETY
APPLICATION FOR AIR CONDITIONING PERMIT
ADDRESS OF
CONSTRUCTION 1904 Cedar

PERMIT NO. 13042
TELEPHONE NO. 1965
DATE 2-19 1965

CIRCLE: New Bldg. Old Bldg. Addn. Remodel TYPE OF BLDG. SFD. X Apt. Comm.
CONTRACTOR'S NAME Sam Ruck STATE LICENSE 55430 CITY LICENSE 5543E

UNITS	HEATERS	PRICE	FEE	UNITS	GAS	PRICE	FEE
	Unit Heaters (floor, suspended & wall)	\$2.00			Gas piping system 1 to 5 outlets	\$1.00	
	Floor Furnace	\$3.00			Gas piping system over 5 outlets (per outlet)	.20	
	Forced Air or Gravity Type under 100,000 BTU's	\$7.00			Swimming pool heater	\$4.00	
	Steam or hot water heating system under 15 outlets (Boiler Excluded)	\$8.00			VENTS		
	Steam or hot water heating system 15 to 30 outlets (Boiler Excluded)	\$10.00			Combustion products vent other than a chimney	\$1.00	
	Each out. over 30	.50			Residential kitchen or bathroom vent each	.25	
	Radiant type heating system under 1000 sq.ft. to be heated	\$8.00			Commercial Hood	\$4.00	
	Radiant type heating system 1000 to 2000 sq.ft. to be heated	\$10.00			Ventilation system not a portion of any heating or air conditioning system up to \$1,000 valuation	\$5.00	
	Each additional 500 sq.ft. over 2000 sq. ft.	.50			BOILER		
	AIR CONDITIONING				Boiler installation 15 H.P. and under	\$5.00	
	Heat pump or refrigerant 3 tons or less	\$4.00			Boiler installation over 15 H.P.	\$10.00	
	Heat pump or refrigerant 3 tons to 10 tons	\$6.00			REPAIR		
	Each addn. ton over 10 tons	.50			Inspection of alteration or replacement of any mechanical cooling equipment which is a portion of any air conditioning system	\$3.00	
	Refrigeration system 3 H.P. or less	\$5.00			MINIMUM PERMIT FEE	\$4.00	
	Refrigeration system 3 to 10 H.P.	\$7.00			TOTAL PERMIT FEE		
	Each addn. H.P. over 10 H.P.	.50					4.00
	Evaporative cooler 5 outlets and under	\$2.00					
	Evaporative cooler 5 to 10 outlets	\$5.00					
	Each addn. outlet over 10	.25					

I hereby certify that I have carefully examined and read the above application; that the same is true and correct; and that the work herein described is to be done in accordance with all the provisions of the applicable ordinances of the City of Las Vegas, Nevada and the State Laws, whether herein specified or not.

SIGNED: Clayton Vaughn By

23.05

L. Gatewood 2-13-79

CITY OF LAS VEGAS, NEVADA

LOG NO. & AREA

CONST. VAL. \$ 204.00

DEPARTMENT OF BUILDING & SAFETY

APPLICATION & BUILDING PERMIT — for:
Fence, Wall, Retaining Wall.

ADDRESS OF
CONSTRUCTION:

1904 CEDAR

OWNER: CARL L. STARK

LOT(s) 344

BLOCK 6

SUBDIVISION

BOULDER DAM HOMESITE TR#4

ZONE: R-1

Materials of Construction: Block ☐ Concrete ☐ Wire ☐ Wood ☒ Other ☐

PLANS: ☐ ☐

ARCHITECT:

ENGINEER:

CALCS: ☐ ☐

CONTRACTOR:

American Fence


STATE LICENSE # 8581

CITY LICENSE # 7594

TOTAL SQUARE FEET:

TOTAL LINEAL FEET: 102

Remarks:

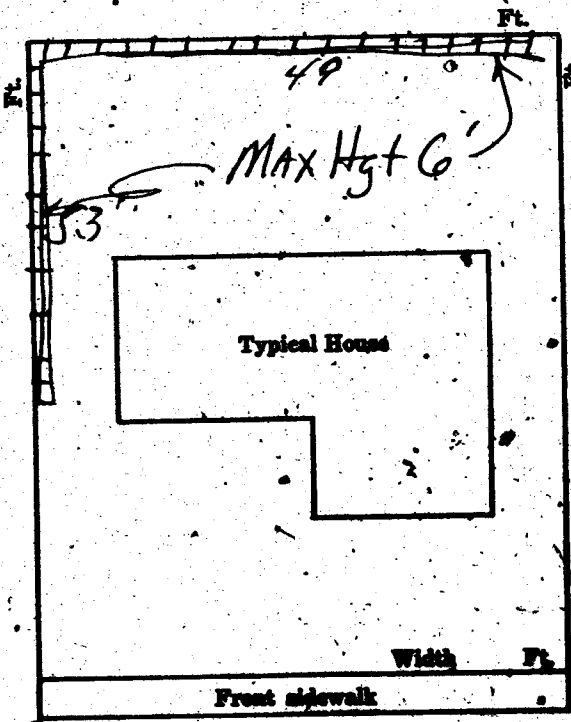

CONDITIONS OF THE PERMIT:

1. Any type of retaining wall must be engineered by a Civil or Structural Engineer.
2. If a home owner takes out the Building Permit and if the owner sublets the work to a Contractor, then the Contractor must take out the permit and pay for it.
3. No fence or wall can be built on City property or rights-of-way, but this is not intended to preclude construction within utility easements if utilities will not be damaged or made inaccessible.
4. The fence or wall shall not enclose any water meter, light standard, or fire alarm box and shall not come closer than 24" from the nearest fire hydrant outlet.
5. Department Inspectors must approve footings before concrete is poured and block wall reinforcing before grouting is done.
6. Maximum height of any wall or fence is 6', side and rear yards; 4' maximum in front yard with the vertical surface above the height of 2' — 50% open and further that fencing within 25' of the interior section of curb faces on corner and through lots is limited to a maximum height of 30".
7. I must not obstruct required on-site parking space (1 space for each dwelling unit) by the erection of this fence or wall.
8. By the signing of this application I herewith agree to the requirements outlined above.

SIGNED:

CONTRACTOR ☐ AGENT ☐ OWNER ☐

DATE: 11-18-69

PLANNING DEPT:

M.C.

Date:

11-20-69

ENGINEERING DEPT:

Date:

BUILDING DEPT:

J. Weingart

Date:

11-25-69

#1285

PERMIT NO:

50193

PERMIT FEE \$

4.00

RECEIPT

5284 \$004.00 -08

CITY OF LAS VEGAS
DEPT. OF
BUILDING & SAFETY

MUST BE MACHINE VALIDATED

25 NOV 69

L. Gatewood 2-13-79

CITY OF LAS VEGAS, NEVADA

DEPARTMENT OF BUILDING & SAFETY - ELECTRICAL APPLICATION & PERMIT

ADDRESS OF
CONSTRUCTION:

1904 Cedar

OWNER'S
NAME:

Carl Stark

CIRCLE: New Bldg.: Add'n: Remodel: TYPE OF BLDG.: SF APT. PUBLIC COMM.

CONTRACTOR'S NAME:

Logan - Sonnet Electric

STATE
LICENSE #

1761

CITY
LICENSE #

18713

NUMBER	FIXTURE OR INSTALLATION	UNIT PRICE	
	Fixture or sockets	.15	
	Light, receptacle or switch outlet	.20	
	Wall or ceiling space heater	.35	
	Blast coil heater per kilowatt	.35	
	Garbage grinder outlet	.35	
	Dishwasher outlet	.35	
1	Clothes dryer outlet	.35	35
	Automatic clothes washer	.35	
	Electric range outlet	.35	
	Electric water heater outlet	.35	
	Mercury arc lamp and equipment	.35	
	Special purpose outlet	.35	
	X-ray unit and its appurtenances	5.00	
	Watts of festoon lighting (Watts) First 3,000 watts	4.00	
	for each additional thousand watts	1.50	
	Horsepower - all motors first horsepower or less	1.25	
	for each additional horsepower	.35	
	Temporary power and lights (temporary pole)	4.00	
1	Electric service (including any single meter socket)	3.00	30
	for each additional socket	.35	
	Air conditioning service amps	1.50	
	Each KW (KVA) Generator (Transformer) (Welder) KW (KVA)	2.00	
	First 100 KVA - For each additional KW (KVA)	.01	
	Special inspection per hour	4.00	
	Speaker outlets	.15	
	Signal or Alarm outlets	.15	
	Amplifiers	.50	
	Control panels	.25	
	T. V. outlets - master system only	.15	
	Radio outlets	.15	
	Main control racks	1.00	
	T. V. and Radio antennas - master system only	.75	
	Minimum fee for any permit	4.00	
	Total fee		<u>400</u>

I hereby certify that I have carefully examined and read the above application; that the same is true and correct; and that the work herein described is to be done in accordance with all the provisions of the applicable Ordinances of the City of Las Vegas, Nevada and State laws whether herein specified or not.

SIGNED

George L. Logan

DATE 2-13-79

MASTER (ELECTRICIAN) (TECHNICIAN) (OWNER)

BUILDING DEPARTMENT

J. W. Wynn

DATE

#12860

PERMIT NO.

29873

PERMIT FEE: \$

400

RECEIPT

9270 - \$004.00 - 6

CITY OF LAS VEGAS

DEPT. OF
BUILDING & SAFETY

16 FEB 79

Y. Gathwood 2-12-79

1970

CITY OF LAS VEGAS, NEVADA
DEPARTMENT OF BUILDING & SAFETY - AIR CONDITIONING APPLICATION & PERMIT

ADDRESS OF CONSTRUCTION: Carl Stark 1904 Cedar OWNER'S NAME: Carl Stark
CIRCLE: New bldg.; Old bldg.; Add'n; Remodel; TYPE OF BLDG. SPD APT. COMM.
CONTRACTOR'S NAME: Emil Pahor STATE LICENSE # 52 CITY LICENSE # C 11-205-2-01078

UNITS	HEATERS	PRICE	FEE	UNITS	GAS	PRICE	FEE
	Unit Heaters (floor, suspended & wall)	\$2.00			Gas piping system 1 to 5 outlets	\$3.00	
	Floor Furnace	\$3.00			Gas piping system over 5 outlets (per outlet)	.20	
	Forced Air or Gravity Type under 100,000 BTU's	\$7.00			Swimming pool heater	\$4.00	
	Steam or hot water heating system under 15 outlets (Boiler Excluded)	\$8.00		VENTS			
	Steam or hot water heating system 15 to 30 outlets (Boiler Excluded)	\$10.00			Combustion products vent other than a chimney	\$1.00	
	Each outlet over 30	.50			Residential kitchen or bathroom vent each	.25	
	Radiant type heating system under 1000 sq. ft. to be heated	\$8.00			Commercial Hood	\$4.00	
	Radiant type heating system 1000 to 2000 sq. ft. to be heated	\$10.00			Ventilation system not a portion of any heating or air conditioning system up to \$1,000 valuation	\$5.00	
	Each additional 500 sq. ft. over 2000 sq. ft.	.50		BOILER			
AIR CONDITIONING					Boiler installation 15 H.P. and under	\$5.00	
	Heat pump or refrigerant 3 tons or less.	\$4.00			Boiler installation over 15 H.P.	\$10.00	
1	Heat pump or refrigerant 3 tons to 10 tons	\$6.00	6.00	REPAIR			
	Each addn. ton over 10 ton	.50			Inspection of alteration or replacement of any mechanical cooling equipment which is a portion of any air conditioning system	\$3.00	
	Refrigeration system 3 ton or less	\$5.00			DUCT WORK ONLY (each opening)	.25	
	Refrigeration system 3 to 10 ton	\$7.00			WATER TOWER	\$4.00	
	Each addn. ton over 10 ton	.50			REVISION PERMIT FEE	\$4.00	XXXX
	Evaporative cooler 5 outlets and under	\$3.00			FOR ISSUANCE EACH PERMIT		3.00
	Evaporative cooler 5 to 10 outlets	\$5.00			TOTAL PERMIT FEE	9.00	XXXXXX
	Each addn. outlet over 10	.25					

I hereby certify that I have carefully examined and read the above application; that the same is true and correct; and that the work herein described is to be done in accordance with all the provisions of the applicable Ordinances of the City of Las Vegas, Nevada and the State laws, whether herein specified or not.

SIGNED Emil M. Pahor Date 2/19/70
AIR CONDITIONING CONTRACTOR - OWNER
BUILDING DEPARTMENT James M. Meyer Date 2/19/70
#12890 PERMIT NO. 28542 PERMIT FEE \$ 9.00

RECEIPT
9459 \$009.00 - 4

CITY OF LAS VEGAS
DEPT. OF
BUILDING & SAFETY
MUST BE MACHINE VALIDATED

19 FEB 70

M. Gatewood 2-13-79

CITY OF LAS VEGAS, NEVADA
DEPT. OF PUBLIC SERVICES

LOG NO. & AREA
14-09
DIVISION OF BUILDING & SAFETY
PHONE: 386-6251

CONST. VAL. \$ 522.00

APPLICATION & BUILDING PERMIT - for:
Dwellings, Duplexes, Misc. Residential Const.

ADDRESS OF CONSTRUCTION: 1904 Cedar Ave.

OWNER: Carl Stark

LOT(s) 344 BLOCK 6 SUBDIVISION *Grandview Home Tract* ZONE *R-1*

Existing structure on lot: Dwelling ☐ Accessory bldgs. ☐ Vacant lot ☐ Other ☐

PROPOSED CONSTRUCTION: Alum Patio Cover

USE: *Patio*

MATERIALS OF CONSTRUCTION: Wood Frame ☐ Concrete Block ☐ Reinforced Concrete ☐ Steel Frame ☐

SQ. FEET OF FLOOR AREAS: 1st 2nd 3rd Other TOTAL SQ. FT. 209

FIRE ZONE: Occupancy Group

CONST. TYPE:

ARCHITECT: ENGINEER: NO. of UNITS NO. of STORIES


Plans Submitted: Yes ☐ No ☐ Calculations Submitted: Yes ☐ No ☐ Sewer Fee Req'd. Yes ☐ No ☐

CONTRACTOR: DURABILT, INC.

STATE LICENSE # 12692

CITY LICENSE # 11107

ADD'L PERMITS REQ'D: Air Cond. ☐ Elec. ☐ Plumbing ☐ Signs ☐ Paving ☐ Fence ☐ Public Walks ☐ Curb-gutters ☐
Incinerators ☐ Fire Sprinkling System ☐

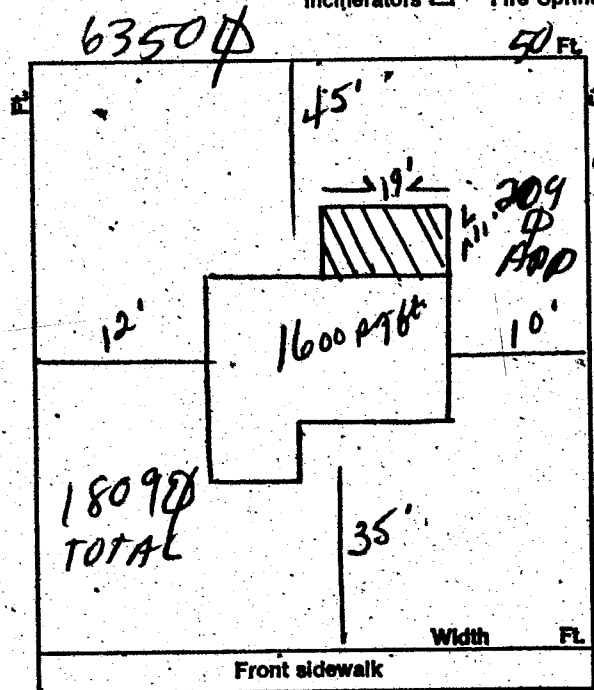

CONDITIONS OF THE PERMIT:

1. I agree to call the City Building Department for inspections before concrete is poured, before rough wiring, electrical, plumbing, framing is covered. Also for air conditioning, sheet-rock and sheathing inspection.
2. I agree that when the job is completed that I will call for final inspection before occupancy.
3. I agree to perform all construction in accordance with City Ordinances and Building Codes.
4. The Contractor's signature below denotes authority from the owner to sign in his behalf and that the owner is aware of all requirements of this application and permit. Separate permits must be taken out for work outlined above this agreement.
5. I have read and understand the contents of this application and permit; I hereby state that the information I have supplied on this application is true and correct.

SIGNED: *Durabilt, Inc.* Contractor

BY: *Branda Stark* Agent of Owner

CLARK COUNTY HEALTH DEPT.

LAS VEGAS FIRE DEPARTMENT

PLANNING DEPT.: *[Signature]* Date: 3-17-77

PUBLIC WORKS DEPT.: *[Signature]* Date: 3-17-77

BUILDING DEPT.: *[Signature]* Date: 3-17-77

PERMIT NO.: 1446 PERMIT FEE \$ 8.00

154-01-220
78-11-14

7018 RECEIVED - 8

CITY OF LAS VEGAS
DEPT. OF PUBLIC SERVICES
BUILDING & SAFETY

MUST BE RE-EXAMINED

Handwritten: 02913-79

CITY OF LAS VEGAS, NEVADA

LOG NO. & AREA

DEPARTMENT OF BUILDING & SAFETY

CONST. VAL. \$

18000

APPLICATION & BUILDING PERMIT - for:

Dwellings, Depts., Misc. Residential Const.

ADDRESS OF CONSTRUCTION:

1905 Cedar

OWNER:

Herbert Bailey

LOT(s)

47+48

BLOCK

7

SUBDIVISION

Builder's Homebldg #2

ZONE:

R-1

Existing structure on lot: Dwelling



Accessory bldg.



Vacant lot



Other



PROPOSED CONSTRUCTION:

Storage Rooms (separation)

USE:

Same

MATERIALS OF CONSTRUCTION:

Wood Frame



Concrete Block



Reinforced Concrete



Steel Frame



SQ. FEET OF FLOOR AREAS:

1st

2nd

3rd

Other

TOTAL SQ. FT.

60

FIRE ZONE: 1 2 3

Occupancy Group 1 2 3 4

CON. TYPE

I II III IV V

ARCHITECT:

ENGINEER:

NO. of UNITS

NO. of STORIES

Plans Submitted:

Yes



No



Calculations Submitted

Yes



No



Sewer P. Req'd.

Yes



No



CONTRACTOR:

Dwayer

STATE LICENSE

CITY LICENSE

ADD'L. PERMITS REQ'D:

Air Cond.



Incinerators



Elec.



Plumbing



Signs



Paving




Fence



Public Works



Curb-gutters

 

CONDITIONS OF THE PERMIT:

1. I agree to call the City Building Department for inspections before concrete is poured, before rough work, electrical, plumbing, framing is covered. Also for air conditioning, heat-rock, sheet-rock, sheathing inspection.
2. I agree that when the job is completed that I will call for final inspection before occupancy.
3. I agree to perform all construction in accordance with City Ordinances and Building Codes.
4. The Contractor's signature below denotes authority from the owner to sign in his behalf and that the owner is aware of all requirements of this application and permit. Separate permits must be taken out for work outlined above this agreement.
5. I have read and understand the contents of this application and permit; I hereby state that the information I have supplied on this application is true and correct.

Approval for the work under this permit will be given only after refuse and debris have been removed from job site and public right of way.

SIGNED:

Herb Bailey

Contractor

BY:

Agent or Owner

CLARK COUNTY HEALTH DEPT.

Date

LAS VEGAS FIRE DEPARTMENT

Date

PLANNING DEPT.:

Date:

1-10-75

PUBLIC WORKS DEPT.:

Date:

BUILDING DEPT.:

Date:

1-10-75

12850

PERMIT NO.:

65

PERMIT FEE \$

500

RECEIPT

100 \$005.00 - 8

CITY OF LAS VEGAS
DEPT. OF
BUILDING & SAFETY
MUST BE MACHINE VALIDATED

10 JAN 75

Department of Building & Safety
City of Las Vegas, Nevada

Special Kardex
Elect. only-Plbg. only-A.C. only

Owner Carl C. Stark Address 1904 Cedar Date 8/19/65
Contractor Sears Roebuck Permit No. 13042
Lot _____ Block _____ Subdivision _____

Electric Only	Plumbing Only	Heat & Vent. A.C. Only
Contractor _____	Contractor _____	Contractor <u>Sears & Roebuck</u>
Permit No. _____	Permit No. _____	Permit No. <u>13042</u>
Slab _____	Rough Soil _____	A.C. Rough Duct _____
Rough Elect. _____	Rough Water _____	Ref. Ro. Piping _____
Final Rough _____	Top Out _____	Rough Gas _____
Final Fixture _____	Rough Gas _____	Final Refrig. <u>R/S & 20-45</u>
Final Elect. _____	Final Plbg. _____	Final Air Cond. _____
Temp. Service _____	Final Gas _____	Final Gas _____
	Final Sewer _____	
	Final Septic Tank _____	

23.06 D Address 1904 Cedar Log No. _____ Area _____

DIVISION of BUILDING & SAFETY - CITY of LAS VEGAS, NEVADA
OWNER Carl Stark ADDRESS 1904 Cedar Ave. DATE 3-17-77
GEN. CONT. Durabilt Inc.
PERMIT NO. 1446 TYPE OF STRUCTURE alum patio cover
LEGAL DESCRIPTION L 3 & 4 B 6 Boulder Dam Homesite

BUILDING	MECHANICAL	ELECTRICAL
Investigation _____	Plumbing Cont. _____	Temp. pole cont. _____
Location & Footing _____	Permit No. _____ Date _____	Permit No. _____ Date _____
Stem Wall _____	Heat & Vent. A/C Cont. _____	Inspection _____ Date _____
Concrete Slab Floor _____	Permit No. _____ Date _____	Electrical Cont. _____
Floor Framing _____	Sewer Cont. _____	Permit No. _____ Date _____
Fireplace Footing _____	Permit No. _____ Date _____	Fixtures Cont. _____
Chimney Steel _____	Rough Soil _____	Permit No. _____ Date _____
Vert. Steel Reinf. _____	Rough Water _____	Slab _____
Horiz. Steel Reinf. _____	Top-Out _____	Rough _____
Roof Sheathing _____	Rough Gas _____	Final Rough _____
Framing _____	A/C Rough Duct _____	Final Fixture _____
Backing for siding _____	Ref. Rough Piping _____	Final Electrical _____
Ext. Lath _____	Final Plumbing _____	
Ext. Scratch _____	Final Gas _____	Temporary Service _____
Ext. Brown _____	Final Air Cond. _____	
Int. Lath _____	Final Refrig. _____	
Int. Brown _____	Final Sewer _____	
Drywall _____	Final Septic Tank _____	
Insulation _____		
Final Building _____		
Appr. for Occu. _____		

INSPECTOR: BW 6-2-77

DATE _____

APPROVED FOR OCCUPANCY & METER _____

PLEASE NOTE REMARKS ON REVERSE SIDE

1904 Cedar Ave.

LOG # _____

AREA # _____

76-11-4

Department of Building & Safety
City of Las Vegas, Nevada

Special Kardex
Elec. only, Plbg. only, A.C. only

Owner Carl Stark Address 1904 Cedar Date: 2-13-70
Contractor _____ Permit No. _____
Lot _____ Block _____ Subdivision _____

Electric Only	Plumbing Only	Heat & Vent. A. C. Only
Contractor <u>Logan & Tomsik</u>	Contractor _____	Contractor _____
Permit No. <u>29875</u>	Permit No. _____	Permit No. _____
Slab _____	Rough Soil _____	A.C. Rough Duct _____
Rough Elect _____	Rough Water _____	Ref. Ro. Piping _____
Final Rough _____	Top Out _____	Rough Gas _____
Final Fixture _____	Rough Gas _____	Final Refrig _____
Final Elec <u>2-18-70</u>	Final Plbg. _____	Final Air Cond _____
Temp. Service _____	Final Gas _____	Final Gas _____
	Final Sewer _____	
	Final Septic Tank _____	

23.06 D Address 1904 Cedar Log No. _____ Area _____

Department of Building & Safety
City of Las Vegas, Nevada

Special Kardex
Elec. only, Plbg. only, A.C. only

Owner Carl Stark Address 1904 Cedar Date: 2/19/70
Contractor _____ Permit No. _____
Lot _____ Block _____ Subdivision _____

Electric Only	Plumbing Only	Heat & Vent. A. C. Only
Contractor _____	Contractor _____	Contractor <u>EMIL PAHOR</u>
Permit No. _____	Permit No. _____	Permit No. <u>28542</u>
Slab _____	Rough Soil _____	A.C. Rough Duct _____
Rough Elect _____	Rough Water _____	Ref. Ro. Piping _____
Final Rough _____	Top Out _____	Rough Gas _____
Final Fixture _____	Rough Gas _____	Final Refrig _____
Final Elec _____	Final Plbg. _____	Final Air Cond <u>2-13-70</u>
Temp. Service _____	Final Gas _____	Final Gas _____
	Final Sewer _____	
	Final Septic Tank _____	

23.06 D Address 1904 Cedar Log No. _____ Area _____

Angela J. Jackson

DEPARTMENT OF BUILDING & SAFETY
CITY OF LAS VEGAS, NEVADA

KARDEX CARD
FENCE & RETAINING
WALLS

OWNER Carl Stark ADDRESS 1904 Cedar DATE 11/25/69

CONTRACTOR American Fence PERMIT NO. 50193

LOT 3 & 4 BLOCK 6 SUBDIVISION Boulder Dam Homesite #2
Wood

Fence (wire, wood, etc.)	Walls (masonry, rock, etc.)
Location _____	Location _____
Final Inspection <u>11/28/69</u>	Footings _____
	Wall Steel 1st _____ 2d _____ 3d _____
	Final Inspection _____
Retaining Wall (masonry)	Retaining Wall (concrete)
Location _____	Location _____
Footings _____	Footings _____
Wall Steel 1st _____ 2d _____ 3d _____	Wall Steel 1st _____ 2d _____ 3d _____
Bond Beam 1st _____ 2d _____ 3d _____	Final Inspection _____
Final Inspection _____	

23.14 B

ADDRESS 1904 Cedar LOG NO. _____ AREA _____

Debbie Ingman 12-23-86

CITY OF LAS VEGAS, NEVADA

LOG NO. & AREA _____ DATE _____ CONST. VAL. \$ _____

DEPARTMENT OF BUILDING AND SAFETY
PHONE 386-6251

AIR CONDITIONING PERMIT

ADDRESS OF CONSTRUCTION 1904 E. Cedar OWNER Stark PHONE 386-9082

CONTRACTOR Tahor Ritz & Mc Serri STATE LICENSE NO. 9291A CITY LICENSE NO. 23844

LOT(s) _____ BLOCK _____ SUBDIVISION _____ ZONE _____

PROPOSED CONSTRUCTION Replacement
AIR COND. 3675
PERMIT NO. 3675

USE _____

UNITS	DESCRIPTION	FEE	TOTAL
PERMIT ISSUANCE			
1	For the issuance of each permit	15.00	15.00
	For issuing each supplemental permit	4.50	
UNIT FEE SCHEDULE			
	For the installation or relocation of each forced-air or gravity-type furnace or burner, including ducts and vents attached to such appliance, up to and including 100,000 Btu/h.	9.00	
	For the installation or relocation of each forced-air or gravity-type furnace or burner, including ducts and vents attached to such appliance over 100,000 Btu/h.	11.00	
	For the installation or relocation of each floor furnace, including vent.	9.00	
	For the installation or relocation of each suspended heater, recessed wall heater or floor-mounted unit heater.	9.00	
	For the installation, relocation or replacement of each appliance vent installed and not included in an appliance permit.	4.50	
	For the repair, alteration of, or addition to each heating appliance, refrigeration unit, cooling unit, absorption unit, or each heating, cooling, absorption, or evaporative cooling system, including installation of controls regulated by this code.	9.00	
	For the installation or relocation of each boiler or compressor to and including three horsepower, or each absorption system to and including 100,000 Btu/h.	9.00	
	For the installation or relocation of each boiler or compressor over three horsepower to and including 15 horsepower, or each absorption system over 100,000 Btu/h and including 500,000 Btu/h.	18.50	16.50
	For the installation or relocation of each boiler or compressor over 15 horsepower to and including 30 horsepower, or each absorption system over 500,000 Btu/h to and including 1,000,000 Btu/h.	22.50	
	For the installation or relocation of each boiler or compressor over 30 horsepower to and including 50 horsepower, or for each absorption system over 1,000,000 Btu/h to and including 1,750,000 Btu/h.	33.50	
	For the installation or relocation of each boiler or refrigeration compressor over 50 horsepower, or each absorption system over 1,750,000 Btu/h.	66.00	

Approval for the work under this permit will be given only after refuse and debris have been removed from job site and public right of way.

UNITS	DESCRIPTION	FEE	TOTAL
1	For each air-handling unit to and including 10,000 cubic feet per minute, including ducts attached thereto. <i>Note: This fee shall not apply to an air-handling unit which is a portion of a factory-assembled appliance, cooling unit, evaporative cooler or absorption unit for which a permit is required elsewhere in this code.</i>	6.50	
	For each air-handling unit over 10,000 cfm.	11.00	
	For each evaporative cooler other than portable type	6.50	
	For each ventilation fan*	COMMERCIAL 4.50 RESIDENTIAL 2.35	
	For each ventilation system which is not a portion of any heating or air-conditioning system authorized by a permit.	6.50	
	For the installation of each hood which is served by mechanical exhaust, including the ducts for such hood.	6.50	
	For each appliance or piece of equipment regulated by this code but not classed in other appliance categories, or for which no other fee is listed in this code.	6.50	

OTHER INSPECTIONS AND FEES:

	Inspections outside of normal business hours (minimum charge — three hours)	25.00 per hour	
	Reinspection fee assessed under provisions of TABLE 3-A of the Uniform Building Code = \$15.00 EACH	15.00 each	
	Inspections for which no fee is specifically indicated (minimum charge — one-half hour).	30.00 per hour	
	Additional plan review required by changes, additions or revisions to approved plans (minimum charge — two hours).	30.00 per hour	
	Mechanical permit fees may be computed the same as building permit fees by using the cost of installation for valuation amount when such work is not included in the above schedule.		
	Gas piping which is directly related and necessary to the repair or replacement of heating, air conditioning, or refrigeration systems not exceeding 500,000 B.T.U.H.	6.00	

2310-2405

RECEIVED 03**

A/C 31.50
CHECK 31.50
3675A000 13:58

12/19/86

I hereby certify that I have carefully examined and read the above application; that the same is true and correct; and that the work herein described is to be done in accordance with all the provisions of the applicable Ordinances of the City of Las Vegas, Nevada and the State Laws, whether herein specified or not.

SIGNED Bill W. [Signature] CONTRACTOR MASTER CARD NO. _____

BY P. Alfano 12-19-86 Spec. Contr. or Owner
BUILDING DEPT. DATE

PERMIT FEE 31.50

TOTAL FEES 31.50

Permit Expires 180 Days After Abandonment of Work

MUST BE MACHINE VALIDATED

Libbie Ingraham 10-21-87

ELEC. ONLY PLBG. ONLY, A.C. ONLY		
OWNER		DATE
ADDRESS		
CONTRACTOR	PERMIT NO.	FINAL INSPECTION
LOT	BLOCK	SUBDIVISION
LOG NO.		AREA
ELECTRIC ONLY		PLUMBING ONLY
Contractor		Contractor
Permit No.		Permit No.
Rough Elec.		Rough Soil
Final Rough		Rough Water
Final Elec.		Top Out
Temp. Service		Rough Gas
HEAT & VENT. A/C ONLY		Final Plbg.
Contractor		Final Gas
Permit No.		Sewer Final
A/C Rough Duct		
Rough Gas		
Final A/C		
Final Gas		

720-33 (R11-87) DEPT. OF BLDG. & SAFETY
CITY OF LAS VEGAS