

6212 Fargo

L-10 Blk.-2 Sub Char Hgts 29-B Zone R-1

Sharon Brenna May 14, 1979

CITY OF LAS VEGAS, NEVADA

LOG NO. & AREA _____ 1971 _____ CONST. VAL. \$ 2700

DEPARTMENT OF BUILDING & SAFETY

APPLICATION & BUILDING PERMIT — for: Dwellings; Duplexes, Misc. Residential Const.

ADDRESS OF CONSTRUCTION: 6212 Fargo

OWNER: NILS BAYLES

LOT(s) 10 BLOCK 2 SUBDIVISION CHARLESTON HETS 29-B ZONE: R1

Existing structure on lot: Dwelling Accessory bldgs. Vacant lot Other

PROPOSED CONSTRUCTION: PATIO & COVER & SLAB STORAGE BUILD USE:

MATERIALS OF CONSTRUCTION: Wood Frame Concrete Block Reinforced Concrete Steel Frame

SQUARE FEET OF FLOOR AREAS: 1st _____ 2nd _____ 3rd _____ Other _____ TOTAL SQ. FT. 150/30


FIRE ZONE: 1 2 3 Occupancy Group A B C D E F G H I J-1-2-3-4-5 CONST. TYPE: I II III IV V

ARCHITECT: _____ ENGINEER: _____ NO. of UNITS: _____ NO. of STORIES: 5

Plans Submitted: Yes No Calculations Submitted: Yes No Sewer Fee Req'd: Yes No

CONTRACTOR: OWNER STATE LICENSE # _____ CITY LICENSE # _____

ADD'L PERMITS REQ'D: Air Cond. Elec. Plumbing Signs Paving Fence Public Walks Curb-gutters Incinerator Fire Sprinkling System

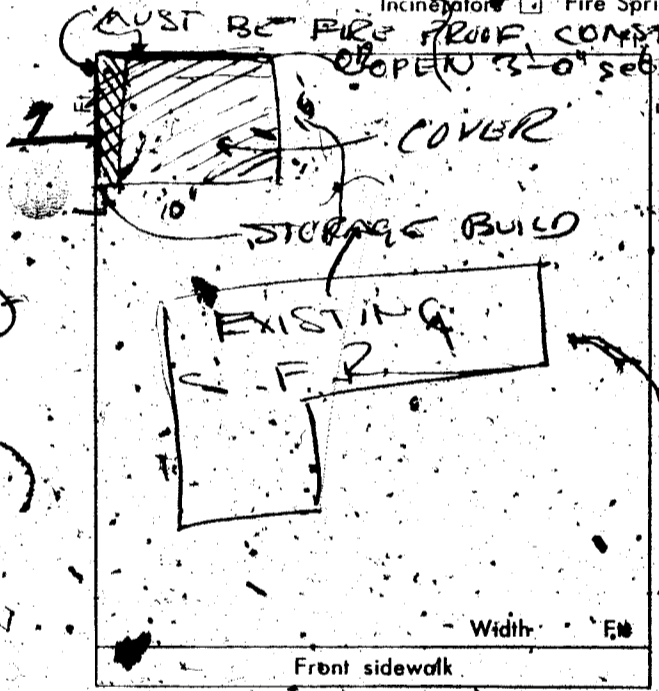

HEIGHT OF MAIN BUILDING SHALL NOT EXCEED ACCESSORY BUILDING

PLANNING DEPT. Date: 3/29/71

PUBLIC WORKS DEPT. Date: _____

BUILDING DEPT. Date: 3-29-71

PERMIT NO. 57707 PERMIT FEE \$ 500

CONDITIONS OF THE PERMIT:

- 1. I agree to call the City Building Department for inspections before concrete is poured, before rough wiring, electrical, plumbing, framing is covered. Also for Air conditioning, sheet-rock and sheathing inspection.
2. I agree that when the job is completed that I will call for final inspection before occupancy.
3. I agree to perform all construction in accordance with City Ordinances and Building Codes.
4. The Contractor's signature below denotes authority from the owner to sign in his behalf and that the owner is aware of all requirements of this application and permit. Separate permits must be taken out for work outlined above this agreement.
5. I have read and understand contents of this application and permit, I hereby state that the information I have supplied on this application is true and correct.

SIGNED: NILS BAYLES Contractor

BY: [Signature] Agent or Owner

CLARK COUNTY HEALTH DEPT. Date: _____

LAS VEGAS FIRE DEPARTMENT Date: _____

RECEIPT 095 005.00 CITY OF LAS VEGAS DEPARTMENT OF BUILDING & SAFETY MUST BE MACHINE VALIDATED

Karon Lescira May 14, 1979

**CITY OF LAS VEGAS, NEVADA
DEPT. OF PUBLIC SERVICES**

LOG NO. & AREA: 7-15 DIVISION OF BUILDING & SAFETY PHONE: 386-6251

CONST. VAL \$ 2,000

APPLICATION & BUILDING PERMIT - for: Dwellings, Duplexes, Misc. Residential Const.

ADDRESS OF CONSTRUCTION: 705 Flower OWNER: JAMES M. LEMOS

LOT(S) 21 BLOCK 4E SUBDIVISION Waterbury ZONE: R-1

Existing structure on lot: Dwelling Accessory bldgs. Vacant lot Other

PROPOSED CONSTRUCTION: room add USE: Bedroom

MATERIALS OF CONSTRUCTION: Wood Frame Concrete Block Reinforced Concrete Steel Frame



FIRE ZONE: _____ OCCUPANCY GROUP: _____ CONST. TYPE: _____

ARCHITECT: _____ ENGINEER: _____ NO. of UNITS: _____ NO. of STORIES: _____

Plans Submitted: Yes No Calculations Submitted: Yes No Sewer Fee Req'd. Yes No

CONTRACTOR: owner STATE LICENSE # _____ CITY LICENSE # _____

ADD'L. PERMITS REQ'D: Air Cond. Elec. Plumbing Signs Paving Fence Public Walks Curb gutters
Incinerators Fire Sprinkling System

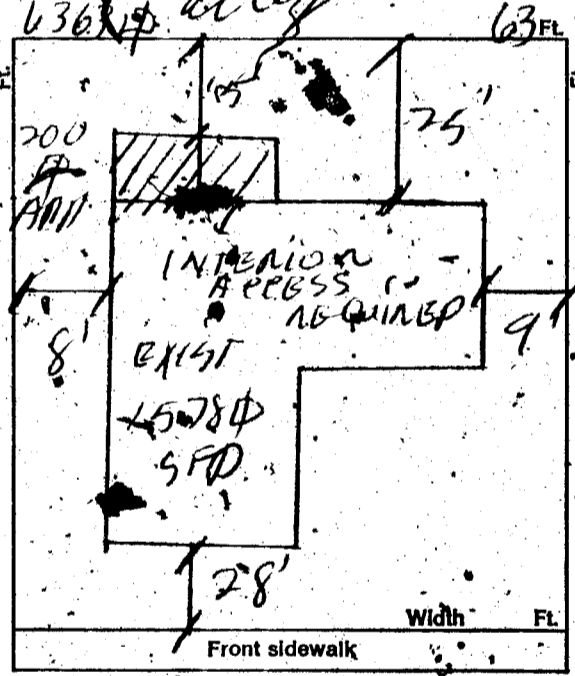

CONDITIONS OF THE PERMIT:

1. I agree to call the City Building Department for inspections before concrete is poured, before rough wiring, electrical, plumbing, framing is covered. Also for air conditioning, sheet-rock and sheathing inspection.
2. I agree that when the job is completed that I will call for final inspection before occupancy.
3. I agree to perform all construction in accordance with City Ordinances and Building Codes.
4. The Contractor's signature below denotes authority from the owner to sign in his behalf and that the owner is aware of all requirements of this application and permit. Separate permits must be taken out for work outlined above this agreement.
5. I have read and understand the contents of this application and permit; I hereby state that the information I have supplied on this application is true and correct.

SIGNED: _____ Contractor

BY: James M. Lemos Agent of Owner

CLARK COUNTY HEALTH DEPT. Date: _____

LAS VEGAS FIRE DEPARTMENT Date: _____

PLANNING DEPT.: _____ Date: 3-29-77

PUBLIC WORKS DEPT.: _____ Date: _____

BUILDING DEPT.: H.T. Keller Date: 3-24-77

PERMIT NO.: 705 PERMIT FEE \$ 15.00

7487 800500 8

CITY OF LAS VEGAS
DEPT. OF PUBLIC SERVICES
BUILDING & SAFETY

MUST BE MACHINE VALIDATED

Maion Pereira May 16, 1979

CITY OF LAS VEGAS, NEVADA

DIVISION OF BUILDING & SAFETY - ELECTRICAL APPLICATION & PERMIT

ADDRESS OF CONSTRUCTION: 705 Flower

OWNER'S NAME: James M. Lemos

CIRCLE: New Bldg.; Add'n.; Remodel; TYPE OF BLDG.: SFD. APT. PUBLIC COMM.

CONTRACTOR'S NAME: STATE LICENSE # CITY LICENSE #

NUMBER	FIXTURE OR INSTALLATION	UNIT PRICE	TOTAL
	Rm addition, carport or garage enclosure	4.00	
	Temporary Power	4.00	
	Light, receptacle or switch outlet	.20	
	Wall or ceiling space heater	.35	
	Garbage chnder outlet	.35	
	Dishwasher outlet	.35	
	Clothes dryer outlet	.35	
	Automatic clothes washer	.35	
	Electric range outlet	.35	
	Electric water heater outlet	.35	
	Special purpose outlet	.35	
	X-ray unit and its appurtenances	5.00	
	Watts of festoon lighting (Watts) First 3,000 watts	4.00	
	for each additional thousand watts	1.50	
	Horsepower-each motor first horsepower or less	1.75	
	for each additional horsepower	.35	
	Electric service (including any single meter socket)	3.00	
	for each additional socket	.35	
	Air conditioning service	1.50	
	Each KW(KVA) Generator (Transformer, Welder) First 100 KVA	2.00	
	for each additional KW(KVA)	.01	
	Speaker, signal or alarm outlet	.15	
	Amplifiers	.50	
	Control panels	.25	
	Main control racks	1.00	
	T.V. and radio antennas-master system only	.75	
	Minimum fee for any permit	4.00	
	TOTAL FEE		4.00

Approval for the work under this permit will be given only after refuse and debris have been removed from job site and public right of way.

I hereby certify, that I have carefully examined and read the above application; that the same is true and correct; and that the work herein described is to be done in accordance with all the provisions of the applicable Ordinances of the City of Las Vegas, Nevada and State laws whether herein specified or not.

SIGNED: James M. Lemos DATE: 3-24-77
MASTER (ELECTRICIAN) (TECHNICIAN) (OWNER)

BUILDING DEPARTMENT DATE

PERMIT NO. 705 PERMIT FEE: \$ 4.00

RECEIPT
7486 \$004.00 - 6
CITY OF LAS VEGAS
DEPT. OF BUILDING & SAFETY
MUST BE MACHINE VALIDATED
24 MAR 77

77-1-13
154-01-221

Marion Perera May 16, 1979

CITY OF LAS VEGAS, NEVADA
DEPT. OF PUBLIC SERVICES

LOG NO. & AREA: 21-07 DIVISION OF BUILDING & SAFETY
PHONE: 386-6251

CONST. VAL. \$ 2000

APPLICATION & BUILDING PERMIT - for:
Dwellings, Duplexes, Miso. Residential Const.

ADDRESS OF CONSTRUCTION: 6217 FARGO OWNER: D.R. Gordon

LOT(s) 20 BLOCK 3 SUBDIVISION Charlton Hys 29-B ZONE: R-1

Existing structure on lot: Dwelling - Accessory bldgs. Vacant lot - Other

PROPOSED CONSTRUCTION: ENC Patio W/FP USE: DEK

MATERIALS OF CONSTRUCTION: Wood Frame Concrete Block Reinforced Concrete Steel Frame

SQ. FEET OF FLOOR AREAS: 1st _____ 2nd _____ 3rd _____ Other _____ TOTAL SQ. FT. 216


FIRE ZONE: _____ Occupancy Group _____ CONST. TYPE: _____

ARCHITECT: _____ ENGINEER: _____ NO. of UNITS _____ NO. of STORIES _____

Plans Submitted: Yes No Calculations Submitted: Yes No Sewer Fee Req'd. Yes No

CONTRACTOR: OWNER STATE LICENSE # _____ CITY LICENSE # _____

ADD'L. PERMITS REQ'D: Air Cond. Elec. Plumbing Signs Paving Fence Public Walks Curb-gutters
Incinerators Fire Sprinkling System

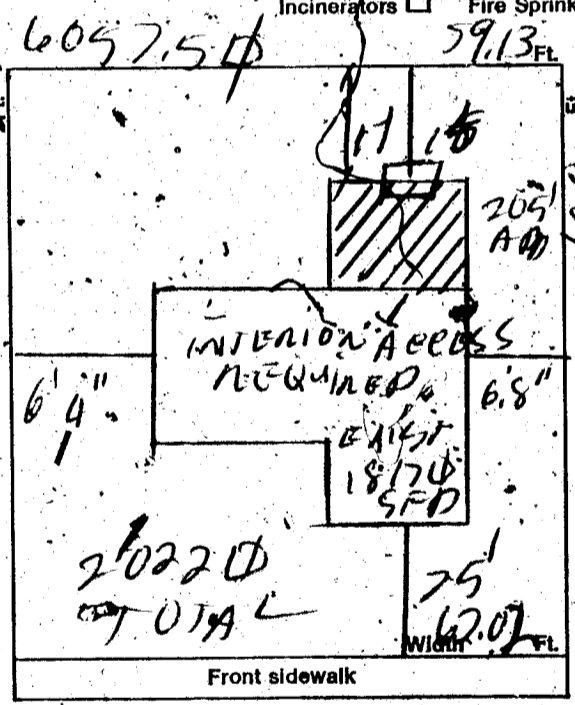

CONDITIONS OF THE PERMIT:

- 1. I agree to call the City Building Department for inspections before concrete is poured, before rough wiring, electrical, plumbing, framing is covered. Also for air conditioning, sheetrock and sheathing inspection.
- 2. I agree that when the job is completed that I will call for final inspection before occupancy.
- 3. I agree to perform all construction in accordance with City Ordinances and Building Codes.
- 4. The Contractor's signature below denotes authority from the owner to sign in his behalf and that the owner is aware of all requirements of this application and permit. Separate permits must be taken for work outlined above this agreement.
- 5. I have read and understand the contents of this application and permit; I hereby state that the information I have supplied on this application is true and correct.

SIGNED: D.R. Gordon Contractor

BY: _____ Agent or Owner

CLARK COUNTY HEALTH DEPT. Date _____

LAS VEGAS FIRE DEPARTMENT Date _____

PLANNING DEPT.: [Signature] Date: 3-25-77

PUBLIC WORKS DEPT.: _____ Date: _____

BUILDING DEPT.: [Signature] Date: 3/25/77

PERMIT NO.: 1615 PERMIT FEE \$ 1500

7561 8095.00 - 8
CITY OF LAS VEGAS
DIV. OF
BUILDING & SAFETY
MUS 28 77 VALIDATED

Marion Perera May 16, 1979

CITY OF LAS VEGAS, NEVADA

DIVISION OF BUILDING & SAFETY - ELECTRICAL APPLICATION & PERMIT

ADDRESS OF CONSTRUCTION: *East 7 Fargo*

OWNER'S NAME: *D.R. Gordon*

CIRCLE: New Bldg.; Add'n.; Remodel TYPE OF BLDG: SFD APT. PUBLIC COMM.

CONTRACTOR'S NAME: *Owner*

STATE LICENSE #

CITY LICENSE #

NUMBER	FIXTURE OR INSTALLATION	UNIT PRICE	TOTAL
	Rm addition, carport or garage enclosure <i>Patio</i>	4.00	<i>4.00</i>
	Temporary Power	4.00	
	Light, receptacle or switch outlet	.20	
	Wall or ceiling space heater	.35	
	Garbage grinder outlet	.35	
	Dishwasher outlet	.35	
	Clothes dryer outlet	.35	
	Automatic clothes washer	.35	
	Electric range outlet	.35	
	Electric water heater outlet	.35	
	Special purpose outlet	.35	
	X-ray unit and its appurtenances	5.00	
	Watts of festoon lighting (Watts) First 3,000 watts	4.00	
	for each additional thousand watts	1.50	
	Horsepower each motor first horsepower or less	1.75	
	for each additional horsepower	.35	
	Electric service (including any single meter socket)	3.00	
	for each additional socket	.35	
	Air conditioning service	1.50	
	Each KW(KVA) Generator (Transformer, Welder) First 100 KVA	2.00	
	for each additional KW(KVA)	.01	
	Speaker, signal or alarm outlet	.15	
	Amplifiers	.50	
	Control panels	.25	
	Main control racks	1.00	
	T.V. and radio antennas-master system only	.75	
	Minimum fee for any permit	4.00	
	TOTAL FEE		<i>4.00</i>

Approval for the work under this permit will be given only after refuse and debris have been removed from job site and public right of way.

I hereby certify that I have carefully examined and read the above application; that the same is true and correct; and that the work herein described is to be done in accordance with all the provisions of the applicable Ordinances of the City of Las Vegas, Nevada and State laws whether herein specified or not.

SIGNED *D.R. Gordon*
MASTER (ELECTRICIAN) (TECHNICIAN) (OWNER)

DATE *3/25/77*

BUILDING DEPARTMENT *WR7*

PERMIT NO. *774* PERMIT FEE: \$ *4.00*

RECEIPT
7560 \$004.00 - 6
CITY OF LAS VEGAS
DIVISION OF BUILDING & SAFETY
MUST BE MACHINE VALIDATED
2 APR 77

77-1-13
154-01-221

DEPT. of BLDG & SAFETY - CITY of LAS VEGAS, NEVADA

OWNER Sproul Homes, Inc ADDRESS 6212 Fargo Ave DATE 8-21-63
 GEN. CONT. S. me TYPE OF STRUCTURE SFD
 PERMIT NO. 18539 LEGAL DESCRIPTION Lot 10 block 2, Chas Heights 298

BUILDING	MECHANICAL	ELECTRICAL
LOCATION _____	PLUMBING CONT. <u>United</u>	TEMP. POLE CONT. _____
FIREPLACE FTS. _____	PERMIT NO. <u>13038</u> DATE <u>8-21-63</u>	PERMIT NO. _____ DATE _____
FOOTINGS <u>12-10-63</u>	HEAT & VENT. AC CONT. <u>J.B. Parker</u>	INSPECTION _____ DATE _____
FOUNDATION WALL <u>12-16-63</u>	PERMIT NO. <u>10438</u> DATE <u>1-12-64</u>	ELECTRICAL CONT. <u>Philebo</u>
FLOOR FRAMING _____	SEWER CONT. <u>United</u>	PERMIT NO. <u>13751</u> DATE <u>1-31-64</u>
SLAB <u>1-3-64</u>	PERMIT NO. <u>13938</u> DATE <u>8-21-63</u>	FIXTURES CONT. <u>Philebo</u>
CHIMNEY STEEL (FIREPLACE) _____	ROUGH SOL. <u>Philebo</u> <u>12-30-63</u>	PERMIT NO. <u>15757</u> DATE <u>1-30-64</u>
WALL STEEL _____	ROUGH WATER <u>Philebo</u> <u>12-27-63</u>	SLAB _____
COLUMN STEEL _____	TOP-OUT <u>Philebo</u> <u>1-28-64</u>	ROUGH <u>Philebo</u> <u>1-30-64</u>
BEAM STEEL _____	ROUGH GAS _____	FINAL ROUGH _____
FRAMING _____	AC ROUGH DUCT <u>Philebo</u> <u>1-28-64</u>	FINAL FIXTURE _____
ROOF SHEATHING _____	REP. ROUGH PIPING _____	FINAL ELECTRICAL <u>Philebo</u> <u>1-30-64</u>
DRYWALL _____	FINAL PLUMBING <u>Philebo</u> <u>3-2-64</u>	TEMPORARY SERVICE _____
LATHING _____	FINAL GAS _____	MISCELLANEOUS _____
BACKING (SIDING) _____	FINAL AIR COND. <u>Philebo</u> <u>3-2-64</u>	GRADING & DRAINAGE _____
PLASTER SCRATCH _____	FINAL REFRIG. _____	ON-SITE PARKING SPACES _____ APP. _____
PLASTER BROWN _____	FINAL SEWER <u>Philebo</u> <u>1-7-64</u>	ENG. APPROVAL OF _____
URBAN REDEVELOPMENT APPROVAL _____	FINAL SEPTIC TANK _____	OFF-SITE IMPROVEMENTS _____
FINAL BLDG. <u>Philebo</u> DATE <u>2-5-64</u>		

APPROVED FOR OCCUPANCY & METER West INSPECTOR West DATE 3-5-64

PLEASE NOTE REMARKS ON REVERSE SIDE LOG: # _____ AREA: # _____ 23.04

6212 Fargo Ave T65 4

DEPT. of BLDG & SAFETY - CITY of LAS VEGAS, NEVADA

OWNER Nils Bayles ADDRESS 6212 Fargo DATE 3-29-74
 GEN. CONT. Owner TYPE OF STRUCTURE ratio cover
 PERMIT NO. 57707 LEGAL DESCRIPTION 110 R 2 F slab & storage room

BUILDING	MECHANICAL	ELECTRICAL
LOCATION _____	PLUMBING CONT. _____	TEMP. POLE CONT. _____
FIREPLACE FTS. _____	PERMIT NO. _____ DATE _____	PERMIT NO. _____ DATE _____
FOOTINGS _____	HEAT & VENT. AC _____	INSPECTION _____ DATE _____
FOUNDATION WALL _____	PERMIT NO. _____ DATE _____	ELECTRICAL CONT. _____
FLOOR FRAMING _____	SEWER CONT. _____	PERMIT NO. _____ DATE _____
SLAB _____	PERMIT NO. _____ DATE _____	FIXTURES CONT. _____
CHIMNEY STEEL (FIREPLACE) _____	ROUGH SOL. _____	PERMIT NO. _____ DATE _____
WALL STEEL _____	ROUGH WATER _____	SLAB _____
COLUMN STEEL _____	TOP-OUT _____	ROUGH _____
BEAM STEEL _____	ROUGH GAS _____	FINAL ROUGH _____
FRAMING _____	AC ROUGH DUCT _____	FINAL FIXTURE _____
ROOF SHEATHING _____	REP. ROUGH PIPING _____	FINAL ELECTRICAL _____
DRYWALL _____	FINAL PLUMBING _____	TEMPORARY SERVICE _____
LATHING _____	FINAL GAS _____	MISCELLANEOUS _____
BACKING (SIDING) _____	FINAL AIR COND. _____	GRADING & DRAINAGE _____
PLASTER SCRATCH _____	FINAL REFRIG. _____	ON-SITE PARKING SPACES _____ APP. _____
PLASTER BROWN _____	FINAL SEWER _____	ENG. APPROVAL OF _____
URBAN REDEVELOPMENT APPROVAL _____	FINAL SEPTIC TANK _____	OFF-SITE IMPROVEMENTS _____
FINAL BLDG. _____ DATE _____		

APPROVED FOR OCCUPANCY & METER _____ INSPECTOR _____ DATE _____

PLEASE NOTE REMARKS ON REVERSE SIDE LOG: # _____ AREA: # _____ 23.04

6212 Fargo

DEPT. of BLDG & SAFETY - CITY of LAS VEGAS, NEVADA

OWNER Nils G. Bayles ADDRESS 6212 Fargo DATE 6-29-64
 GEN CONT. Same TYPE OF STRUCTURE wood fence
 PERMIT NO. 26817 LEGAL DESCRIPTION Lot 10 Blk 2 Chas Hts 29-B

BUILDING		MECHANICAL	ELECTRICAL
LOCATION		PLUMBING CONT.	TEMP. POLE CONT.
FIREPLACE FTS		PERMIT NO. _____ DATE _____	PERMIT NO. _____ DATE _____
FOOTINGS		HEAT & VENT. AC CONT.	INSPECTION _____ DATE _____
FOUNDATION WALL		PERMIT NO. _____ DATE _____	ELECTRICAL CONT. _____ DATE _____
FLOOR FRAMING		SEWER CONT.	PERMIT NO. _____ DATE _____
SLAB		PERMIT NO. _____ DATE _____	FIXTURES CONT. _____ DATE _____
CHIMNEY STEEL (FIREPLACE)		ROUGH SOL.	PERMIT NO. _____ DATE _____
WALL STEEL		ROUGH WATER	SLAB _____
COLUMN STEEL		TOP-OUT	ROUGH _____
BEAM STEEL		ROUGH GAS	FINAL ROUGH _____
FRAMING		AC ROUGH DUCT	FINAL FIXTURE _____
ROOF SHEATHING	INTERIOR _____ EXTERIOR _____	REF. ROUGH PIPING	FINAL ELECTRICAL _____
DRYWALL		FINAL PLUMBING	TEMPORARY SERVICE _____
LATHING		FINAL GAS	
BACKING (SIDING)		FINAL AIR COND.	
PLASTER	SCRATCH _____ BROWN _____	FINAL REFRIG.	
URBAN REDEVELOPMENT APPROVAL		FINAL SEWER	
FINAL BLDG <u>HH</u>	DATE <u>7-2-64</u>	FINAL SEPTIC TANK	
			MISCELLANEOUS:
			GRADING & DRAINAGE _____
			ON-SITE PARKING SPACES _____ APP. _____
			ENG. APPROVAL OF _____
			OFF-SITE IMPROVEMENTS _____

APPROVED FOR OCCUPANCY METER _____ INSPECTOR _____ DATE _____
 PLEASE NOTE REMARKS ON REVERSE SIDE LOG: # _____ AREA: # _____ 23.04

6212 Fargo