

5921 FAWN AVE.

LOT 31 BK 6 CHARLESTON HGTS #45 -D ZONE R_1

Sharon Lewis April 27, 1979

1968
CITY OF LAS VEGAS, NEVADA

LOG NO. & AREA

CONST. VAL. \$

DEPARTMENT OF BUILDING & SAFETY

APPLICATION & BUILDING PERMIT — for:
Dwellings, Duplexes, Misc. Residential Const.

ADDRESS OF
CONSTRUCTION:

OWNER:

LOT(s)

BLOCK

SUBDIVISION

ZONE

Existing structure on lot: Dwelling ☒ Accessory bldgs. ☐ Vacant lot ☐ Other ☐

PROPOSED CONSTRUCTION:

USE:

MATERIALS OF CONSTRUCTION: Wood Frame ☐ Concrete Block ☐ Reinforced Concrete ☐ Steel Frame ☐

SQUARE FEET OF FLOOR AREAS: 1st 2nd 3rd Other TOTAL SQ. FT.

FIRE ZONE: 1 2 3 Occupancy Group A B C D E F G H I J-1-2-3-4-5 CONST. TYPE: I II III IV V

ARCHITECT:

ENGINEER:

NO. of UNITS

NO. of STORIES

Plans Submitted: Yes ☐ No ☐

Calculations Submitted: Yes ☐ No ☐


Sewer Fee Req'd: Yes ☐ No ☐

CONTRACTOR:

STATE
LICENSE #

CITY
LICENSE #

ADD'L. PERMITS REQ'D: Air Cond. ☐ Elec. ☒ Plumbing ☐ Signs ☐ Paving ☐ Fence ☐ Public Walks ☐ Curb-gutters ☐
Incinerators ☐ Fire Sprinkling System ☐

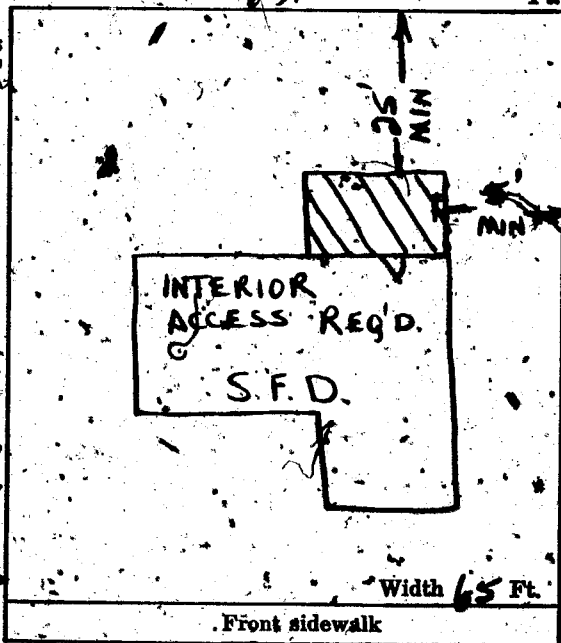

CONDITIONS OF THE PERMIT:

1. I agree to call the City Building Department for inspections before concrete is poured, before rough wiring, electrical, plumbing, framing is covered. Also for Air conditioning, sheet-rock and sheathing inspection.
2. I agree that when the job is completed that I will call for final inspection before occupancy.
3. I agree to perform all construction in accordance with City Ordinances and Building Codes.
4. The Contractor's signature below denotes authority from the owner to sign in his behalf and that the owner is aware of all requirements of this application and permit. Separate permits must be taken out for work outlined above this agreement.
5. I have read and understand the contents of this application and permit; I hereby state that the information I have supplied on this application is true and correct.

SIGNED

Contractor

BY:

Agent or Owner

CLARK COUNTY HEALTH DEPT.

LAS VEGAS FIRE DEPARTMENT

RECEIPT

5496 \$340.00 - 8

CITY OF LAS VEGAS
DEPT. OF
BUILDING & SAFETY

MUST BE MACHINE VALIDATED

8 MAR 68

PLANNING DEPT:

Date: 3-8-68

ENGINEERING DEPT:

Date:

BUILDING DEPT:

Date: 3-8-68

#12850

PERMIT NO:

40694

PERMIT FEE \$

\$ 40.00 Double 15.00

Sharon Leva April 27, 1979

CITY OF LAS VEGAS, NEVADA

DEPARTMENT OF BUILDING & SAFETY - ELECTRICAL APPLICATION & PERMIT

ADDRESS OF
CONSTRUCTION:

5921 Fern

OWNER'S

NAME:

Carl Jensen

LOT(S)

BLOCK

SUBDIVISION

Type of bldg.

SFD ☐

Apt. ☐

Comm. ☐

Check Proper Construction:

New Bldg. ☐

Addn. ☐

Remodel ☐

Temporary Pole ☐

Old Bldg. ☐

CONTRACTOR'S NAME:

STATE
LICENSE #

CITY
LICENSE #

NUMBER	FIXTURE OR INSTALLATION	UNIT PRICE	
	Fixture or sockets	.15	
	Light, receptacle or switch outlet	.20	
	Wall or ceiling space heater	.35	
	Blast coil heater per kilowatt	.35	
	Garbage grinder outlet	.35	
	Dishwasher outlet	.35	
	Clothes dryer outlet	.35	
	Automatic clothes washer	.35	
	Electric range outlet	.35	
	Electric water heater outlet	.35	
	Mercury arc lamp and equipment	.35	
	Special purpose outlet	.35	
	X-ray unit and its appurtenances	5.00	
	Watts of festoon lighting (Watts) First 3,000 watts	4.00	
	for each additional thousand watts	1.50	
	Horsepower - all motors first horsepower or less	1.75	
	for each additional horsepower	.35	
	Temporary power and lights (temporary pole)	4.00	
	Electric service (including any single meter socket)	3.00	
	for each additional socket	.35	
	Air conditioning service	amps 1.50	
	Each KW (KVA) Generator (Transformer) (Welder) KW (KVA)	2.00	
	First 100 KVA - For each additional KW (KVA)	.01	
	Special inspection per hour	4.00	
	Speaker outlets	.15	
	Signal or Alarm outlets	.15	
	Amplifiers	.50	
	Control panels	.25	
	T. V. outlets - master system only	.15	
	Radio outlets	.15	
	Main control racks	1.00	
	T. V. and Radio antennas - master system only	.75	
	Minimum fee for any permit	4.00	
	Total fee		400

I hereby certify that I have carefully examined and read the above application; that the same is true and correct; and that the work herein described is to be done in accordance with all the provisions of the applicable Ordinances of the City of Las Vegas, Nevada and State laws whether herein specified or not.

SIGNED

MASTER (ELECTRICIAN) (TECHNICIAN) (OWNER)

Date

BUILDING DEPARTMENT

Date

#12860

PERMIT NO 24927 - PERMIT FEE: \$ 400

RECEIPT

5775 5004.00 + 6

CITY OF LAS VEGAS

DEPT. OF
BUILDING & SAFETY

MUST BE MACHINE VALIDATED

Sharon L. L. April 27, 1977

CITY OF LAS VEGAS, NEVADA
DEPARTMENT OF BUILDING & SAFETY - AIR CONDITIONING APPLICATION & PERMIT

ADDRESS OF CONSTRUCTION: 5921 Fawn Ave.

OWNER'S NAME: Earl H. Jensen

CIRCLE: New bldg.; Old bldg.; Add'n; Remodel; TYPE OF BLDG. SFD. APT. COMM.

CONTRACTOR'S NAME: STATE LICENSE # CITY LICENSE #

UNITS	HEATERS	PRICE	FEE	UNITS	GAS	PRICE	FEE
	Unit Heaters (floor, suspended & wall)	\$2.00			Gas piping system 1 to 5 outlets	\$3.00	
	Floor Furnace	\$3.00			Gas piping system over 5 outlets (per outlet)	.20	
	Forced Air or Gravity-Type under 100,000 BTU's	\$7.00			Swimming pool heater	\$4.00	
	Steam or hot water heating system under 15 outlets (Boiler Excluded)	\$8.00		VENTS			
	Steam or hot water heating system 15 to 30 outlets (Boiler Excluded)	\$10.00			Combustion products vent other than a chimney	\$1.00	
	Each outlet over 30	.50			Residential kitchen or bathroom vent each	.25	
	Radiant type heating system under 1000 sq. ft. to be heated	\$8.00			Commercial Hood	\$4.00	
	Radiant type heating system 1000 to 2000 sq. ft. to be heated	\$10.00			Ventilation system not a portion of any heating or air conditioning system up to \$1,000 valuation	\$5.00	
✓	Each additional 500 sq. ft. over 2000 sq. ft.	.50		BOILER			
AIR CONDITIONING					Boiler installation 15 H.P. and under	\$5.00	
✓	Heat pump or refrigerant 3 tons or less.	\$4.00	4.00		Boiler installation over 15 H.P.	\$10.00	
	Heat pump or refrigerant 3 tons to 10 tons	\$6.00		REPAIR			
	Each addn. ton over 10 ton	.50			Inspection of alteration or replacement of any mechanical cooling equipment which is a portion of any air conditioning system	\$3.00	
	Refrigeration system 3 ton or less	\$5.00			DUCT WORK ONLY (each opening)	.25	
	Refrigeration system 3 to 10 ton	\$7.00			WATER TOWER	\$4.00	
	Each addn. ton over 10 ton	.50			MINIMUM PERMIT FEE	\$4.00	
	Evaporative cooler 5 outlets and under	\$3.00		TOTAL PERMIT FEE			
	Evaporative cooler 5 to 10 outlets	\$5.00					
	Each addn. outlet over 10	.25					

I hereby certify that I have carefully examined and read the above application; that the same is true and correct; and that the work herein described is to be done in accordance with all the provisions of the applicable Ordinances of the City of Las Vegas, Nevada and the State laws, whether herein specified or not.

SIGNED: Earl H. Jensen Date: 4-22-68
AIR CONDITIONING CONTRACTOR OWNER
BUILDING DEPARTMENT: J. W. Smith Date: 4-22-68
#1289 PERMIT NO. 15947 PERMIT FEE \$ 4.00

RECEIPT
8224 - \$004.00 - 4
CITY OF LAS VEGAS
DEPT. OF BUILDING & SAFETY
MUST BE MACHINE VALIDATED
23 APR 68

Sharon Verina April 27, 1977

CITY OF LAS VEGAS, NEVADA

LOG NO. & AREA

CONST. VAL. \$ 504⁰⁰

DEPARTMENT OF BUILDING & SAFETY

APPLICATION & BUILDING PERMIT — for:
Dwellings, Duplexes, Misc. Residential Const.

ADDRESS OF
CONSTRUCTION:

5921 Fawn

OWNER:

Earl Jensen

LOT(s)

31

BLOCK

C

SUBDIVISION

CHARLESTON HEIGHTS 45-D

ZONE:

R-1

Existing structure on lot: Dwelling ☐ Accessory bldg. ☐ Vacant lot ☐ Other ☐

PROPOSED CONSTRUCTION:

patio Roof

USE: PATIO

MATERIALS OF CONSTRUCTION: Wood Frame ☐ Concrete Block ☐ Reinforced Concrete ☐ Steel Frame ☐

SQUARE FEET OF FLOOR AREAS: 1st _____ 2nd _____ 3rd _____ Other _____ TOTAL SQ. FT. 336⁰

FIRE ZONE: 1 2 3 .. Occupancy Group A B C D E F G H I J-1-2-3-4-5 CONST. TYPE: I II III IV V

ARCHITECT:

ENGINEER:

NO. of UNITS

NO. of STORIES

Plans Submitted: Yes ☐ No ☐

Calculations Submitted Yes ☐ No ☐

Sewer Fee Req'd. Yes ☐ No ☐

CONTRACTOR:


OWNER

STATE
LICENSE #

CITY

LICENSE #

ADD'L. PERMITS REQ'D: Air Cond. ☐ Elec. ☐ Plumbing ☐ Signs ☐ Paving ☐ Fence ☐ Public Walks ☐ Curb-gutters ☐
Incinerators ☐ Fire Sprinkling System ☐

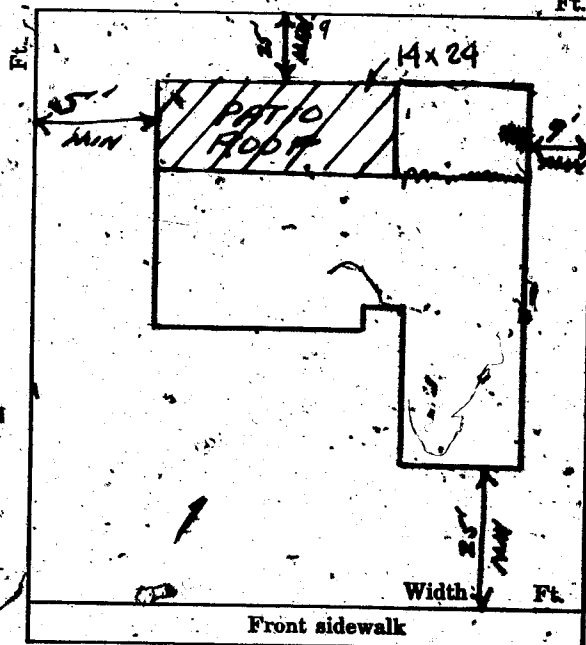

CONDITIONS OF THE PERMIT:

1. I agree to call the City Building Department for inspections before concrete is poured, before rough wiring, electrical, plumbing, framing is covered. Also for Air conditioning, sheet-rock and sheathing inspection.
2. I agree that when the job is completed that I will call for final inspection before occupancy.
3. I agree to perform all construction in accordance with City Ordinances and Building Codes.
4. The Contractor's signature below denotes authority, from the owner to sign in his behalf and that the owner is aware of all requirements of this application and permit. Separate permits must be taken out for work outlined above this agreement.
5. I have read and understand the contents of this application and permit; I hereby state that the information I have supplied on this application is true and correct.

SIGNED:

Earl Jensen

Contractor

BY:

Agent or Owner

CLARK COUNTY HEALTH DEPT.

Date

LAS VEGAS FIRE DEPARTMENT

Date

RECEIPT

36 \$006.00 - 8

CITY OF LAS VEGAS
DEPT. OF
BUILDING & SAFETY

MUST BE MACHINE VALIDATED

21 JAN 69

PLANNING DEPT:

Date: 1-20-69

ENGINEERING DEPT:

Date:

BUILDING DEPT:

Date: 1-20-69

#12350

PERMIT NO:

45699

PERMIT FEE \$

6⁰⁰

Sharon Perera April 27, 1976

CITY OF LAS VEGAS, NEVADA

DEPARTMENT OF BUILDING & SAFETY - APPLICATION AND PERMIT FOR PLUMBING

ADDRESS OF CONSTRUCTION: 5921 Fawn

OWNER'S NAME: Carl Jensen

CIRCLE: New Bldg.; Add'n; Remodel; TYPE OF BLDG.: SFD. APT. PUBLIC COMM.

CONTRACTOR'S NAME:

STATE LICENSE #

CITY LICENSE #

UNITS	DESCRIPTION	FEE	TOTAL
	Bathtub	1.00	
	Shower	1.00	
	Lavatory	1.00	
	Toilet	1.00	
	Urinal	1.00	
	Floor Drain	1.00	
	Floor Sink	1.00	
	Wash Tray	1.00	
	Sink	1.00	
	Garbage Disposal	1.00	
	Garbage Disposal (comm.)	3.00	
	Clothes Dryer (gas)	1.00	
	Clothes Washer	1.00	
	Clothes Washer (comm.)	5.00	
	Dishwasher	1.00	
	Dishwasher (commercial)	5.00	
	Dental Unit	10.00	
	Drinking Fountain	1.00	
	Any Water using Equipment	1.00	
	Water Heater (gas) (elect.)	1.00	
	Sewer System - New, Replacement, or any Drainage System	4.00	
	Grease or Sand Trap	2.00	
	Trailer Trap	2.00	
	Septic Disposal System	4.00	
WATER SOFTENERS			
	Nonpermanent Type	4.00	
	Permanent Type (connected to Drainage)	5.00	
SWIMMING POOLS			
	Private or Wading Pool	10.00	
	Public or Semi-public	20.00	

UNITS	DESCRIPTION	FEE	TOTAL
WATER DISTRIBUTION SYSTEM			
	Single Family Dwelling	4.00	
	Multiple Family Dwelling plus each unit	4.00 2.00	
	Bldg. Group "A" thru "G" per each floor	6.00	
	Hotel or Motel plus each bath	4.00 1.50	
	Trailer Park plus each space	20.00 1.00	
	Irrigation	4.00	4.00
GAS PIPING SYSTEM			
	Single Family Dwelling	3.00	
	Multiple Family Dwelling plus each unit	6.00 1.00	
	Commercial Bldg. per floor plus each unit	3.00 3.00	
	Gas Appliance (any type)	1.00	
AUTOMATIC FIRE EXTINGUISHING SYSTEM			
	Underground Piping	10.00	
	Distribution Piping ea. ft.	.01	
	Sprinkler Head each	.10	
	In Range Hood and Vent	5.00	
DRY STANDPIPE SYSTEM			
	Piping	50.00	
	Each Outlet	1.00	
WET STANDPIPE SYSTEM			
	Piping	5.00	
	Fire Hose Cabinet	1.00	
	MINIMUM PERMIT FEE	4.00	
TOTAL PERMIT FEE \$ 4.00			

I hereby certify that I have carefully examined and read the above application; that the same is true and correct; and that the work herein described is to be done in accordance with all the provisions of the applicable Ordinances of the City of Las Vegas, Nevada and the State Laws, whether herein specified or not.

Signed

Carl Jensen

Date:

Building Department

J. Wenzel

Date:

1-21-69

#12870

Permit No.

256R3

Permit Fee \$

RECEIPT
37 \$004.00 - 7

CITY OF LAS VEGAS
DEPT. OF
BUILDING & SAFETY

MUST BE MACHINE VALIDATED
21 JAN 69

Sharon Treva April 27, 1979

CITY OF LAS VEGAS, NEVADA

LOG NO. & AREA

CONST. VAL. 390

DEPARTMENT OF BUILDING & SAFETY

APPLICATION & BUILDING PERMIT for:
Fence, Wall, Retaining Wall.

ADDRESS OF

CONSTRUCTION: 5921 FAWN

OWNER: EARL JENSEN

LOT(s) 31

BLOCK 6

SUBDIVISION

CHARLESTON HEIGHTS

45-0

ZONE: R-1

Materials of Construction:

Block

Concrete

Wire

Wood

Other

Yes No

ARCHITECT:

ENGINEER:

PLANS: ☐ ☐

CALCS: ☐ ☐

CONTRACTOR: OWNER

STATE
LICENSE #

CITY
LICENSE #

TOTAL SQUARE FEET:


TOTAL LINEAL FEET:

65

Remarks:

CONDITIONS OF THE PERMIT:

1. Any type of retaining wall must be engineered by a Civil or Structural Engineer.
2. If a home owner takes out the Building Permit and if the owner sublets the work to a Contractor, then the Contractor must take out the permit and pay for it.
3. No fence or wall can be built on City property or rights-of-way, but this is not intended to preclude construction within utility easements if utilities will not be damaged or made inaccessible.
4. The fence or wall shall not enclose any water meter, light standard, or fire alarm box and shall not come closer than 24" from the nearest fire hydrant outlet.
5. Department Inspectors must approve footings before concrete is poured and block wall reinforcing before grouting is done.
6. Maximum height of any wall or fence is 6', side and rear yards; 4' maximum in front yard with the vertical surface above the height of 2' — 50% open and further that fencing within 25' of the intersection of curb faces on corner and through lots is limited to a maximum height of 30".
7. I must not obstruct required onsite parking space (1 space for each dwelling unit) by the erection of this fence or wall.
8. By the signing of this application I herewith agree to the requirements outlined above.

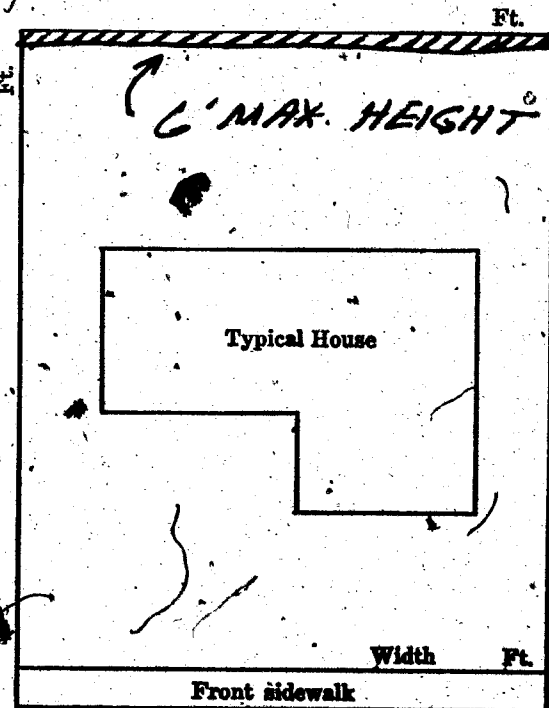

SIGNED:

Earl Jensen

DATE:

1-20-69

CONTRACTOR ☐

AGENT ☐

OWNER ☐

PLANNING DEPT:

Date:

1-20-69

ENGINEERING DEPT:

Date:

BUILDING DEPT:

Date:

1-21-69

#1285

PERMIT NO:

45698

PERMIT FEE \$

4.00

RECEIPT

35 \$004.00 - 8

CITY OF LAS VEGAS

DEPT. OF
BUILDING & SAFETY

MUST BE MACHINE VALIDATED

21 JAN 69

Sharon Ferreira April 27, 1979

LOG NO. & AREA

CITY OF LAS VEGAS, NEVADA

CONST. VAL. 390

DEPARTMENT OF BUILDING & SAFETY

APPLICATION & BUILDING PERMIT for:
Fence, Wall, Retaining Wall.

ADDRESS OF
CONSTRUCTION:

5921 FAWN

OWNER: EARL JENSEN

LOT(s) 31

BLOCK 6

SUBDIVISION

CHARLESTON HEIGHTS 45-D

ZONE: R-1

Materials of

Construction:

Block

Concrete

Wire

Wood

Other

Yes No

ARCHITECT:

ENGINEER:

PLANS: ☐ ☐

CALCS: ☐ ☐

CONTRACTOR:

OWNER

STATE

LICENSE #

CITY

LICENSE #


TOTAL SQUARE FEET:

TOTAL LINEAL FEET: 65

Remarks:

CONDITIONS OF THE PERMIT:

1. Any type of retaining wall must be engineered by a Civil or Structural Engineer.
2. If a home owner takes out the Building Permit and if the owner sublets the work to a Contractor, then the Contractor must take out the permit and pay for it.
3. No fence or wall can be built on City property or rights-of-way, but this is not intended to preclude construction within utility easements if utilities will not be damaged or made inaccessible.
4. The fence or wall shall not enclose any water meter, light standard, or fire alarm box and shall not come closer than 24" from the nearest fire hydrant outlet.
5. Department Inspectors must approve footings before concrete is poured and block wall reinforcing before grouting is done.
6. Maximum height of any wall or fence is 6', side and rear yards; 4' maximum in front yard with the vertical surface above the height of 2' — 50% open and further that fencing within 25' of the intersection of curb faces on corner and through lots is limited to a maximum height of 30".
7. I must not obstruct required onsite parking space (1 space for each dwelling unit) by the erection of this fence or wall.
8. By the signing of this application I herewith agree to the requirements outlined above.

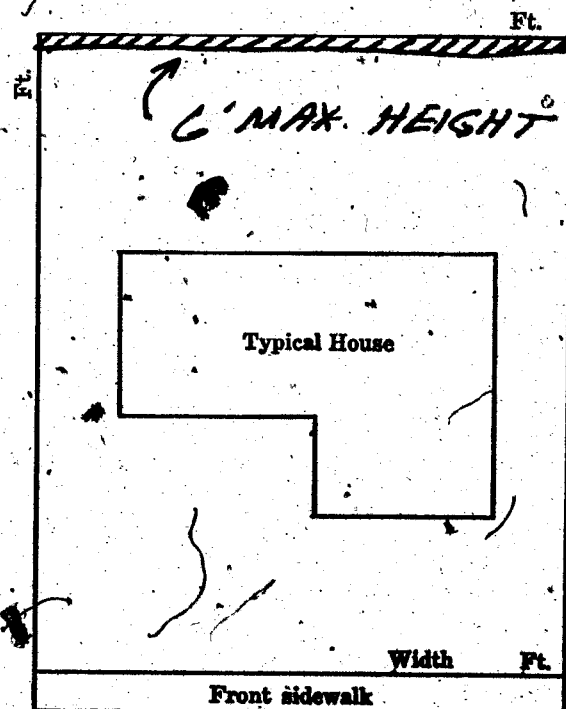

SIGNED:

CONTRACTOR ☐

AGENT ☐

OWNER ☐

DATE: 1-20-69

PLANNING DEPT:

Date: 1-20-68

ENGINEERING DEPT:

Date:

BUILDING DEPT:

Date: 1-21-69

#1285

PERMIT NO: 45698

PERMIT FEE \$ 400

RECEIPT

35 \$004.00 - 8

CITY OF LAS VEGAS

DEPT. OF
BUILDING & SAFETY

MUST BE MACHINE VALIDATED

21 JAN 69

Department of Building & Safety
City of Las Vegas, Nevada

Special Kardex
Elec. only, Plbg. only, A.C. only

Owner Earl Jensen Address 5921 Fawn Date: 1/20/69
Contractor _____ Permit No. _____
Lot _____ Block _____ Subdivision _____

Electric Only	Plumbing Only	Heat & Vent. A. C. Only
Contractor _____	Contractor _____ Owner _____	Contractor _____
Permit No. _____	Permit No. <u>25683</u>	Permit No. _____
Slab _____	Rough Soil _____	A.C. Rough Duct _____
Rough Elect _____	Rough Water _____	Ref. Ro. Piping _____
Final Rough _____	Top Out _____	Rough Gas _____
Final Fixture _____	Rough Gas _____	Final Refrig _____
Final Elec _____	Final Plbg. <u>1-22-69</u>	Final Air Cond _____
Temp. Service _____	Final Gas _____	Final Gas _____
	Final Sewer _____	
	Final Septic Tank _____	

23.06 D Address 5921 Fawn Log No. _____ Sprinkler _____ Area _____

DEPT. of BLDG & SAFETY—CITY of LAS VEGAS, NEVADA

OWNER Earl Jensen ADDRESS 5921 Fawn DATE 1/20/69
GEN. CONT. Owner TYPE OF STRUCTURE Patio Roof
PERMIT NO. 45699 LEGAL DESCRIPTION L 31 B 6 Charleston Heights 45-D/

BUILDING	MECHANICAL	ELECTRICAL
LOCATION <u>ES 2-6-69</u>	PLUMBING CONT. _____	TEMP. POLE CONT. _____
FIREPLACE FTS. _____	PERMIT NO. _____ DATE _____	PERMIT NO. _____ DATE _____
FOUNDINGS <u>ES 2-6-69</u>	HEAT & VENT. AC CONT. _____	INSPECTION _____ DATE _____
FOUNDATION WALL _____	PERMIT NO. _____ DATE _____	ELECTRICAL CONT. _____
FLOOR FRAMING _____	SEWER CONT. _____	PERMIT NO. _____ DATE _____
SLAB _____	PERMIT NO. _____ DATE _____	FIXTURES CONT. _____
CHIMNEY STEEL (FIREPLACE) _____	ROUGH SOIL _____	PERMIT NO. _____ DATE _____
WALL STEEL _____	ROUGH WATER _____	SLAB _____
COLUMN STEEL _____	TOP-OUT _____	ROUGH _____
BEAM STEEL _____	ROUGH GAS _____	FINAL ROUGH _____
FRAMING _____	AC ROUGH DUCT _____	FINAL FIXTURE _____
ROOF SHEATHING _____	REF. ROUGH PIPING _____	FINAL ELECTRICAL _____
INTERIOR _____	FINAL PLUMBING _____	TEMPORARY SERVICE _____
EXTERIOR _____	FINAL GAS _____	
DRYWALL _____	FINAL AIR COND. _____	
LATHING _____	FINAL REFRIG. _____	
BACKING (SIDING) _____	FINAL SEWER _____	
PLASTER _____	FINAL SEPTIC TANK _____	
SCRATCH _____		
BROWN _____		
URBAN REDEVELOPMENT APPROVAL _____		
FINAL BLDG _____ DATE _____		

INSPECTOR _____ DATE _____

APPROVED FOR OCCUPANCY & MEYER _____

PLEASE NOTE REMARKS ON REVERSE SIDE 5921 Fawn LOG: # _____ AREA: # _____ 23.04

DEPARTMENT OF BUILDING & SAFETY
CITY OF LAS VEGAS, NEVADA

KARDEX CARD
FENCE & RETAINING
WALLS

OWNER Earl Jensen ADDRESS 5921 Fawn DATE 1/20/69

CONTRACTOR Owner PERMIT NO. 45698

LOT 31 BLOCK 6 SUBDIVISION Charleston Heights 45-D
Block

Fence (wire, wood, etc.)	Walls (masonry, rock, etc.)
Location _____	Location _____
Final Inspection _____	Footings _____
	Wall Steel 1st _____ 2d _____ 3d _____
	Final Inspection <u>Office 2-17-71</u>
Retaining Wall (masonry)	Retaining Wall (concrete)
Location _____	Location _____
Footings _____	Footings _____
Wall Steel 1st _____ 2d _____ 3d _____	Wall Steel 1st _____ 2d _____ 3d _____
Bond Beam 1st _____ 2d _____ 3d _____	Final Inspection _____
Final Inspection _____	

23.14 B ADDRESS 5921 Fawn LOT NO. _____ AREA _____

DEPT. of BLDG. & SAFETY—CITY of LAS VEGAS, NEVADA
OWNER Earl Jensen ADDRESS 5921 Fawn DATE 3/8/68
GEN. CONT. Owner TYPE OF STRUCTURE Add & fireplace
PERMIT NO. 10694 LEGAL DESCRIPTION L 31 B 6 Charleston Heights #45-D

BUILDING	MECHANICAL	ELECTRICAL
LOCATION _____	PLUMBING CONT. _____	TEMP. POLE CONT. _____
FIREPLACE FTS. _____	PERMIT NO. _____ DATE _____	PERMIT NO. _____ DATE _____
FOOTINGS _____	HEAT & VENT. AC CONT. <u>Owner</u>	INSPECTION _____ DATE _____
FOUNDATION WALL _____	PERMIT NO. <u>15947</u> DATE <u>4-22-68</u>	ELECTRICAL CONT. <u>Owner</u>
FLOOR FRAMING _____	SEWER CONT. _____	PERMIT NO. <u>21927</u> DATE <u>3/8/68</u>
SLAB _____	PERMIT NO. _____ DATE _____	FIXTURES CONT. _____
CHIMNEY STEEL (FIREPLACE) _____	ROUGH SOIL _____	PERMIT NO. _____ DATE _____
WALL STEEL _____	ROUGH WATER _____	SLAB _____
COLUMN STEEL _____	TOP-OUT _____	ROUGH _____
BEAM STEEL _____	ROUGH GAS _____	FINAL ROUGH _____
FRAMING _____	AC ROUGH DUCT _____	FINAL FIXTURE _____
ROOF SHEATHING _____	REF. ROUGH PIPING _____	FINAL ELECTRICAL _____
INTERIOR _____	FINAL PLUMBING _____	TEMPORARY SERVICE _____
DRYWALL _____	FINAL GAS _____	
LATHING _____	FINAL AIR COND. _____	
BACKING (SIDING) _____	FINAL REFRIG. _____	
PLASTER SCRATCH _____	FINAL SEWER _____	
PLASTER BROWN _____	FINAL SEPTIC TANK _____	
URBAN REDEVELOPMENT APPROVAL _____		
FINAL BLDG _____ DATE _____		

APPROVED FOR OCCUPANCY: METER Office 2-17-71 INSPECTOR _____ DATE _____
PLEASE, NOTE REMARKS ON REVERSE SIDE. 5921 Fawn LOG # _____ AREA # _____

OWNER Sproul Homes DEPT. of BLDG. & SAFETY - CITY of LAS VEGAS, NEVADA
GEN. CONT. Same ADDRESS 5921 Fawn DATE 5-15-64
PERMIT NO. 26701 LEGAL DESCRIPTION Lot 31 Blk 6 Chas Hts 45-D TYPE OF STRUCTURE SFD

BUILDING		MECHANICAL	ELECTRICAL
LOCATION <u>HP 6-28-64</u>		PLUMBING CONT. <u>united</u>	TEMP. POLE CONT. _____
FIREPLACE FTS. _____		PERMIT NO. <u>15816</u> DATE <u>5-12-64</u>	PERMIT NO. _____ DATE _____
FOOTINGS <u>HP 5-28-64</u>		HEAT & VENT. AC CONT. <u>united</u>	INSPECTION _____ DATE _____
FOUNDATION WALL _____		PERMIT NO. <u>115251</u> DATE <u>6-12-64</u>	ELECTRICAL CONT. <u>Bobell</u>
FLOOR FRAMING _____		SEWER CONT. <u>united</u>	PERMIT NO. <u>17795</u> DATE <u>7-21-64</u>
SLAB _____		PERMIT NO. <u>15816</u> DATE _____	FIXTURES CONT. <u>Bobell</u>
CHIMNEY STEEL (FIREPLACE) _____		ROUGH SOIL <u>Philburn 6-8-64</u>	PERMIT NO. <u>17795</u> DATE <u>7-21-64</u>
WALL STEEL _____		ROUGH WATER <u>Philburn 6-8-64</u>	SLAB _____
COLUMN STEEL _____		TOP-OUT <u>Philburn 6-26-64</u>	ROUGH <u>Philburn 6-25-64 6-26-64</u>
BEAM STEEL _____		ROUGH GAS _____	FINAL ROUGH _____
FRAMING _____		AC ROUGH DUCT <u>Philburn 6-26-64</u>	FINAL FIXTURE _____
ROOF SHEATHING <u>HP 2-25-64</u>		REF. ROUGH PIPING _____	FINAL ELECTRICAL <u>West 7-22-64</u>
INTERIOR <u>HP 7-10-64</u>	EXTERIOR _____	FINAL PLUMBING <u>HP 7-28-64</u>	TEMPORARY SERVICE _____
DRYWALL _____		FINAL GAS _____	MISCELLANEOUS
LATHING _____		FINAL AIR COND. <u>HP 7-28-64</u>	GRADING & DRAINAGE _____
BACKING (STONS) _____		FINAL REFRIG. _____	ON-SITE PARKING SPACES _____ APP. _____
SCRATCH _____		FINAL SEWER _____	ENG. APPROVAL OF _____
PLASTER BROWN _____		FINAL SEPTIC TANK _____	OFF-SITE IMPROVEMENTS _____
URBAN REDEVELOPMENT APPROVAL _____			
FINAL BLDG. <u>HP</u> DATE <u>7-25-64</u>			

APPROVED FOR OCCUPANCY & METER

INSPECTOR 4230

DATE

PLEASE NOTE REMARKS ON REVERSE SIDE

5921 Fawn

LOG #

T 16

AREA #

23.04