

6100 Fawn | Cir

Dated February 19, 1980

CITY OF LAS VEGAS, NEVADA

LOG NO. & AREA

DEPARTMENT OF BUILDING & SAFETY

CONST. VAL. \$

500.00

APPLICATION & BUILDING PERMIT - for:

Fence Wall, Retaining Wall.

ADDRESS OF CONSTRUCTION:

6100 Irvine Blvd

OWNER:

Dean Below

LOT(s):

75

BLOCK

SUBDIVISION

Chandler

HTS. No.

20-A

ZONE

R-1

Materials of Construction:

Block ☒

Concrete ☐

Wire ☐

Wood ☐

Other ☐

Yes

No

PLANS:

☐

☐

CALCS:

☐

☐

ARCHITECT:

ENGINEER:

CONTRACTOR:

Owner

STATE LICENSE #

CITY LICENSE #

TOTAL SQUARE FEET:

224


TOTAL LINEAL FEET:

128

Remarks:

CONDITIONS OF THE PERMIT:

- Any type of retaining wall must be engineered by a Civil or Structural Engineer.
- If a home owner takes out the Building Permit and if the owner sublets the work to a Contractor, then the Contractor must take out the permit and pay for it.
- No fence or wall can be built on City property or rights-of-way, but this is not intended to preclude construction within utility easements if utilities will not be damaged or made inaccessible.
- The fence or wall shall not enclose any water meter, light standard, or fire alarm box, and shall not come closer than 24" from the nearest fire hydrant outlet.
- Department Inspectors must approve footings before concrete is poured and block wall reinforcing before grouting is done.
- Maximum height of any wall or fence is 6' side and rear yards; 4' maximum in front yard with the vertical surface above the height of 2' - 50% open.
- I must not obstruct required on-site parking space (1 space for each dwelling unit) by the erection of this fence or wall.
- By the signing of this application I herewith agree to the requirements outlined above.

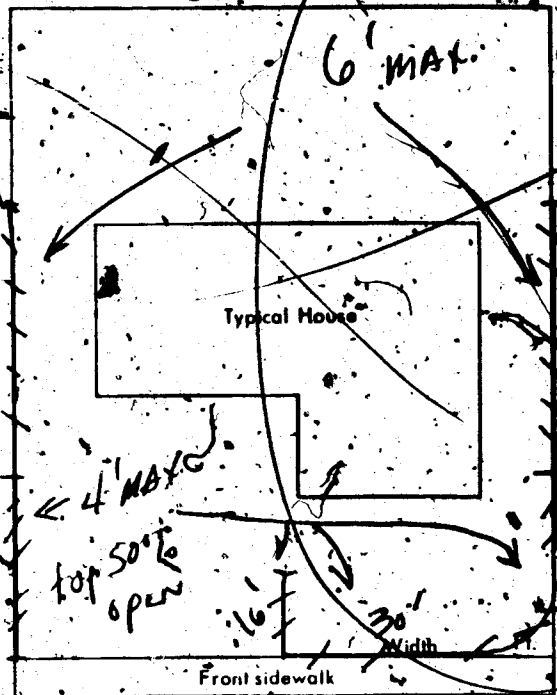

SIGNED:

Dean Below

CONTRACTOR ☐

AGENT ☐

11.00






PLANNING DEPT.:

Date:

07/08/80

PUBLIC WORKS DEPT.:

Date:

2/8/80

BUILDING DEPT.:

Date:

2/8/80

#12850

PERMIT NO.:

0120

PERMIT FEE \$

8.00

RECEIVED
CITY - LAS VEGAS
BLDG. & SAFETY
02/08/80

MUST BE MACHINE VALIDATED

House Report 11-14-80

CITY OF LAS VEGAS, NEVADA

LOG NO. & AREA

CONST. VAL. \$

840.00

DEPARTMENT OF PUBLIC SERVICES
DIVISION OF BUILDING AND SAFETY

APPLICATION & BUILDING PERMIT - for:
Dwellings, Duplexes, Misc. Residential Const.

ADDRESS OF
CONSTRUCTION:

6100 Town Circle

OWNER

Dean Barlow

LOT(S)

75

BLOCK

1

SUBDIVISION

Charleston Dpts 28A

ZONE

R-1

Existing structure on lot:

Dwelling ☐

Accessory Bldgs. ☐

Vacant Lot ☐

Other ☐

PROPOSED CONSTRUCTION:

Storage Shed

USE:

MATERIALS OF CONSTRUCTION:

Wood Frame ☐

Concrete Block ☐

Reinforced Concrete ☒

Steel Frame ☐

SQUARE FEET OF FLOOR AREA:

1st

2nd

3rd

Other

TOTAL SQ. FT.

1168

FIRE ZONE:

Occupancy Group

CONST. TYPE:

ARCHITECT

ENGINEER

NO. of UNITS

NO. of STORIES

Plans Submitted:

Yes ☐

No ☐

Calculations Submitted:

Yes ☐

No ☐

Sewer Fee Req'd.

Yes ☐

No ☐

CONTRACTOR:

Curtis

STATE
LICENSE #

CITY
LICENSE #

ADD'L. PERMITS REQ'D:

Air Cond. ☐

Elec. ☐

Plumbing ☐

Signs ☐

Paving ☐

Fence ☐

Public Walks ☐

Curb/gutters ☐

Incinerators ☐

Fire Sprinkling System ☐

CONDITIONS OF THE PERMIT:

1. I agree to call the City Building Department for inspections before concrete is poured; before rough wiring, electrical, plumbing, framing is covered. Also for Air conditioning, drywall and sheathing inspection.
2. I agree that when the job is completed that I will call for final inspection before occupancy.
3. I agree to perform all construction in accordance with City Ordinances and Building Codes.
4. The Contractor's signature below denotes authority from the owner to sign in his behalf and that the owner is aware of all requirements of this application and permit. Separate permits must be taken out for work outlined above this agreement.
5. I have read and understand the contents of this application and permit; I hereby state that the information I have supplied on this application is true and correct.

Approval for the work under this permit will be given only after refuse and debris have been removed from job site and public right of way.


SIGNED

Dean J. Barlow

Contractor

BY

Agent or Owner

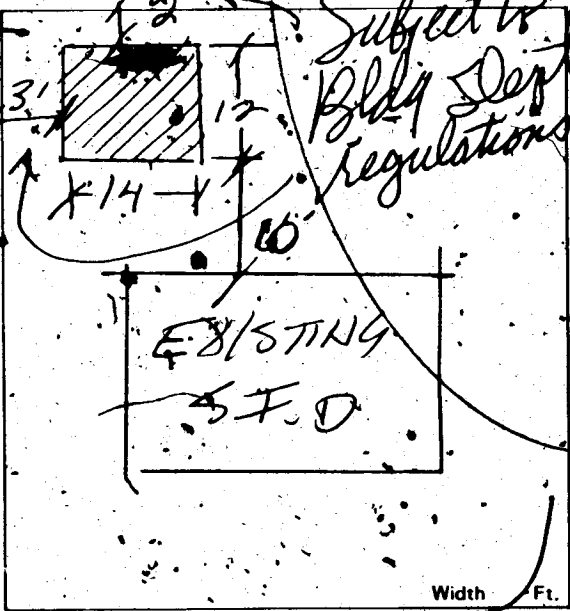

Front property line

PLANNING DEPT.

J. Roberts

Date:

11/12/80

PUBLIC WORKS DEPT.

Date:

11/12/80

BUILDING DIVISION:

Toni

Date:

11/12/80

PERMIT NO.

6462

PERMIT FEE \$

14.50

1721-2401

RECEIPT

MUST BE MACHINE VALIDATED

DEPT. of BLDG. & SAFETY - CITY of LAS VEGAS, NEVADA
OWNER Sproul Homes, Inc. ADDRESS 6100 Pavn Circle DATE Sept. 5, 1961
GEN. CONT. Sproul Homes, Inc. TYPE OF STRUCTURE S. F. DWG.
PERMIT NO. 5922 LEGAL DESCRIPTION L. 75, Blk. 1, C has. Hts. 28-A

LOCATION Fireplace Pts.
FOOTINGS 9-26-61
FOUND. 9-26-61
FLOOR 9-26-61
ANCHOR BOLTS BASE PLATES
WALL STEEL
COLUMN STEEL
BEAM STEEL
FRAMING 11-3-61
ROOF SHEATHING 11-3-61
STEEL FABRICATION
STEEL CONNECTION
INTERIOR EXTERIOR
LATHING 11-2-61
BACKING
PLASTER SCRATCH
PLASTER BROWN
FINAL BLDG. 11-29-61
GRADING & DRAINAGE
ON-SITE PARKING
ENG. APPROVAL OF
OFF-SITE IMPROVEMENTS

PLUMBING CONT. 11-2-61
PERMIT NO. 3620 DATE 9-11-61
HEAT & VENT. CONT. 11-2-61
PERMIT NO. 3620 DATE 9-11-61
SEWER CONT. 11-2-61
PERMIT NO. 3620 DATE 9-11-61
ROUGH SOIL 9-22-61
ROUGH WATER 9-22-61
TOP-OUT 11-19-61
ROUGH GAS 11-19-61
AC ROUGH DUCT 11-19-61
REF. ROUGH PIPING
SEWER 11-20-61
SEPIC TANK
FINAL PLUMBING 11-29-61
FINAL GAS 11-29-61
FINAL HEATING 11-29-61
FINAL AIR COND. 11-29-61
FINAL REFRIG. 11-29-61

TEMP. POLE CONT.
PERMIT NO. DATE
INSPECTION DATE
ELECTRICAL CONT. 11-2-61
PERMIT NO. 4231 DATE 10-13-61
OUTLETS 43
MOTORS
SLAB
ROUGH 11-1-61
FINAL ROUGH
FIXTURES CONT. 11-2-61
PERMIT NO. 4231 DATE 10-13-61
FIXTURES 9
FINAL FIXTURE 11-29-61
URBAN REDEVELOPMENT APPROVAL

INSPECTOR
APPROVED FOR OCCUPANCY 11-29-61

APPROVED FOR METER 11-29-61
PLEASE NOTE REMARKS ON REVERSE SIDE 6100 Pavn Circle 975/61

LOG # T-17 AREA 4 23.04

OWNER Dean Barlow ADDRESS 6100 Pavn Circle
DATE 11-12-80 GEN. CONT. owner
TYPE OF STRUCTURE Storage shed PERMIT NO. 6462
LEGAL DESCRIPTION L. 75, Blk. 1, C has. Hts. 28-A AREA 1

APPROVED FOR OCCUPANCY & METER

BUILDING	MECHANICAL
Investigation	Plumbing Cont.
Location & Footing	Permit No. Date
Concrete Slab Floor	Heat & Vent. A/C Cont.
Fireplace Footing	Permit No. Date
Chimney Steel	Sewer Cont.
Vert. Steel Roof	Permit No. Date
Horiz. Steel Roof	Rough Soil
Framing	Rough Water
Ext. Lath	Top-Out
Ext. Brown	Rough Gas
Drywall	A/C Rough Duct
Final Building <u>11-1-61</u>	Final Plumbing
Appr. for Occu. <u>11-1-61</u>	Final Gas
ELECTRICAL	Final Air Cond.
Temp. Pole Cont.	Final Sewer
Permit No. Date	REMARKS
Inspection Date	
Electrical Cont.	
Permit No. Date	
Rough	PLEASE NOTE ADDITIONAL REMARKS ON REVERSE SIDE.
Final Rough	DIV. OF BLDG. & SAFETY CITY OF LAS VEGAS REV. 10-78
Final Electrical	79-3-16
Temporary Service	