

1409 FAY BLVD.

LOT 7 BL 9 GOLFRIDGE TERRACE 7-C ZONE R-1

Sharon Lerena April 27, 1979

1967
CITY OF LAS VEGAS, NEVADA

LOG NO. & AREA _____

CONST. VAL. \$ 1232⁰⁰

DEPARTMENT OF BUILDING & SAFETY

APPLICATION & BUILDING PERMIT — for:

Dwellings, Duplexes, Misc. Residential Const.

ADDRESS OF
CONSTRUCTION: 1409 Fay Blvd.

OWNER: Michael P Tierney

LOT(s) 7

BLOCK 9

SUBDIVISION Goldridge Terrace 7-C

ZONE: R-1

Existing structure on lot: Dwelling ☒ Accessory Bldgs. ☐ Vacant lot ☐ Other ☐

PROPOSED CONSTRUCTION: One bedroom addition

USE: Sleep

MATERIALS OF CONSTRUCTION: Wood Frame ☐ Concrete Block ☒ Reinforced Concrete ☐ Steel Frame ☐

SQUARE FEET OF FLOOR AREAS: 1st _____ 2nd _____ 3rd _____ Other _____ TOTAL SQ. FT. 228


FIRE ZONE: 1 2 3 Occupancy Group: A B C D E F G H I J 1-2-3-4-5 CONST. TYPE: I II III IV V

ARCHITECT: _____ ENGINEER: _____ NO. of UNITS _____ NO. of STORIES _____

Plans Submitted: Yes ☐ No ☐ Calculations Submitted: Yes ☐ No ☐ Sewer Fee Req'd: Yes ☐ No ☐

CONTRACTOR: [Signature] STATE LICENSE # _____ CITY LICENSE # _____

ADD'L. PERMITS REQ'D: Air Cond. ☐ Elec. ☐ Plumbing ☐ Signs ☐ Paving ☐ Fence ☐ Public Walks ☐ Curb-gutters ☐
Incinerators ☐ Fire Sprinkling System ☐

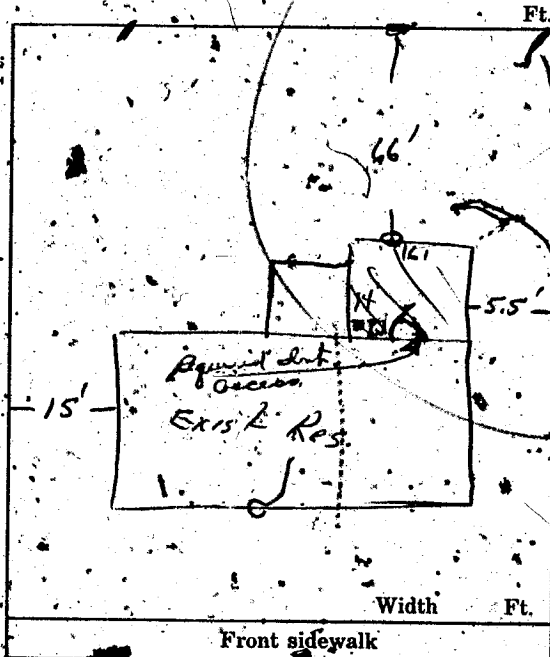

CONDITIONS OF THE PERMIT:

1. I agree to call the City Building Department for inspections before concrete is poured, before rough wiring, electrical, plumbing, framing is covered. Also for Air conditioning, sheet-rock and sheathing inspection.
2. I agree that when the job is completed that I will call for final inspection before occupancy.
3. I agree to perform all construction in accordance with City Ordinances and Building Codes.
4. The Contractor's signature below denotes authority from the owner to sign in his behalf and that the owner is aware of all requirements of this application and permit. Separate permits must be taken out for work outlined above this agreement.
5. I have read and understand the contents of this application and permit; I hereby state that the information I have supplied on this application is true and correct.

SIGNED: [Signature] Contractor

BY: [Signature] Agent or Owner

CLARK COUNTY HEALTH DEPT.

LAS VEGAS FIRE DEPARTMENT

PLANNING DEPT: [Signature]

Date: 3/10/67

ENGINEERING DEPT: [Signature]

Date: 3/10/67

BUILDING DEPT: John Repeorge

Date: 3-10-67

#1285

PERMIT NO: 36394

PERMIT FEE \$ 12.00

RECEIPT

\$012.00 - 8

CITY OF LAS VEGAS
DEPT. OF
BUILDING & SAFETY

MUST BE MACHINE VALIDATED

13 MAR 67

Sharon Levee April 27, 1979

CITY OF LAS VEGAS, NEVADA
DEPARTMENT OF BUILDING & SAFETY

PERMIT FEE \$ 7.00 + 14.00 = 21.00
APPLICATION & PERMIT FOR PLUMBING

JOB ADDRESS: 1409 Fay Blvd

OWNER'S

NAME: Michael P. Tierney

LOT BLOCK SUBDIVISION

Bldg. type: SFD APT COMM

Circle: New bldg; Old bldg; Add'n; Remodel; Pool; Wtr. Sftner; Lawn Sprkr; Other

CONTRACTOR: Owner

State Lic.#

City Lic.#

QUANTITY	FIXTURE OR INSTALLATION	Unit Price	AMOUNT
	Bathtub	1.00	
	Clothes dryer (gas)	1.00	
	Clothes washer	1.00	
	Dental unit	1.00	
	Dishwasher	1.00	
	Drinking fountain	1.00	
	Fire sprinkling - underground piping	5.00	
	Fire sprinkling - distribution piping per each foot	1.00	
	Fire sprinkling heads - per each head	.10	
	Floor drain \$1.00 Floor sink	1.00	
	Gas appliance, (any type)	1.00	
	Gas piping system - single family dwelling	3.00	
	Gas piping system - multiple family \$3 per each unit plus	1.00	
	Gas piping system - commercial bldg. per each floor	3.00	
	Grease trap	1.00	
	Irrigation system	4.00	
	Lavatory	1.00	
	Minimum fee for any permit	4.00	
	Piping, Drainage	4.00	4.00
	Sewer replacement	4.00	
	Sewer disposal system - Health Dept. approval required	4.00	
	Showers	1.00	1.00
	Sink - kitchen type <u>Bar Type</u>	1.00	1.00
	Swimming pool - private - wading pool	8.00	
	Swimming pool - public - semi-public	12.00	
	Toilet	1.00	1.00
	Urinal	1.00	
	Water distribution system, single family dwelling	4.00	
	Water distribution system multiple dwg. \$4 + each unit	1.00	
	Water distribution system, Group "A" thru "G" per each floor	4.00	
	Water distribution system, Group "H" (hotel) \$4 + per bath*	.50	
	Water heater (gas) (electric)	1.00	
	Water using equipment	1.00	
	Water softener nonpermanent type	4.00	
	Water softener permanent (connected to drainage)	5.00	
	Wash-tray	1.00	

I hereby certify that I have carefully examined & read the above application; that the same is true & correct; and the work herein described is to be done in accordance with the provisions of City of Las Vegas Ordinances & State Laws, whether herein specified or not, as defined in City Code and Ordinances.

SIGNED: Michael P. Tierney Date: 10/20/67
Registered Plumber Spec. Cont'r, Owner

Engineering Dept. Date 10/20/67

Sewer Conn. Fees

Paid in Engr. Dept.

23.10

#1287

PERMIT NO. 22114

PERMIT FEE \$ 7.00

Must be machine validated

TOTAL FEE \$ 7.00 + 14.00 = 21.00

RECEIPT

\$21.00

CITY OF LAS VEGAS
DEPT. OF
BUILDING & SAFETY

23 OCT 67

Sharon Leiva April 27, 1979

CITY OF LAS VEGAS, NEVADA
DEPARTMENT OF BUILDING & SAFETY

PERMIT FEE \$ 700 + 1400 = 2100
APPLICATION & PERMIT FOR PLUMBING

JOB ADDRESS: 1409 Fay Blvd

OWNER'S NAME: Michael P. Tierney

LOT BLOCK SUBDIVISION

Bldg. type: SFD APT COMM

Circle: New bldg; Old bldg; Add'n; Remodel; Pool; Wtr. Sftner; Lawn Sprkr; Other

CONTRACTOR: Quinsey

State Lic. #

City Lic. #

QUANTITY	FIXTURE OR INSTALLATION	Unit Price	AMOUNT
	Bathtub	1.00	
	Clothes dryer (gas)	1.00	
	Clothes washer	1.00	
	Dental unit	1.00	
	Dishwasher	1.00	
	Drinking fountain	1.00	
	Fire sprinkling - underground piping	5.00	
	Fire sprinkling - distribution piping per each foot	1.00	
	Fire sprinkling heads - per each head	.10	
	Floor drain \$1.00 Floor sink	1.00	
	Gas appliance (any type)	1.00	
	Gas piping system - single family dwelling	3.00	
	Gas piping system - multiple family \$3 per each unit plus	1.00	
	Gas piping system - commercial bldg. per each floor	3.00	
	Grease trap	1.00	
	Irrigation system	4.00	
	Lavatory	1.00	
	Minimum fee for any permit	4.00	
	Piping, Drainage	4.00	4.00
	Sewer replacement	4.00	
	Septic disposal system - Health Dept. approval required	4.00	
	Showers	1.00	1.00
	Sink - kitchen type Bar Type	1.00	1.00
	Swimming pool - private - wading pool	8.00	
	Swimming pool - public - semi-public	12.00	
	Toilet	1.00	1.00
	Urinal	1.00	
	Water distribution system, single family dwelling	4.00	
	Water distribution system multiple dwg. \$4 + each unit	1.00	
	Water distribution system, Group "A" thru "G" per each floor	4.00	
	Water distribution system, Group "H" (hotel) \$4 + per bath*	.50	
	Water heater (gas) (electric)	1.00	
	Water using equipment	1.00	
	Water softener nonpermanent type	4.00	
	Water softener permanent (connected to drainage)	5.00	
	Wash-tray	1.00	

I hereby certify that I have carefully examined & read the above application; that the same is true & correct; and the work herein described is to be done in accordance with the provisions of City of Las Vegas Ordinances & State Laws, whether herein specified or not, as defined in City Code and Ordinances.

SIGNED: Michael P. Tierney Date: 10/20/67
Registered Plumber Spec. Cont'r, Owner

Engineering Dept. Date

Building Department Date

Sewer Conn. Fees

Paid in Engr. Dept.

PERMIT NO. 22114

PERMIT FEE \$ 7

23.10

#1287

\$14

TOTAL FEE \$ 7.00 + 1400 = 2100

RECEIPT

\$2100.00

CITY OF LAS VEGAS

DEPT. OF
BUILDING & SAFETY

Must be machine validated

23 DEC 67

Sharon Pereira April 27, 1979

CITY OF LAS VEGAS, NEVADA

DEPARTMENT OF BUILDING & SAFETY - ELECTRICAL APPLICATION & PERMIT

ADDRESS OF
CONSTRUCTION: 1409 Fay Blvd.

OWNER'S
NAME: M. B. Tierney

LOT(S) _____ BLOCK _____ SUBDIVISION _____ Type of bldg. SFD ☒ Apt. ☐ Comm. ☐

Check Proper Construction: Service Change ☒ New Bldg. ☐ Addn. ☐ Remodel ☐ Temporary Pole ☐ Old Bldg. ☐

CONTRACTOR'S NAME: FitzGerald Electric Inc. STATE LICENSE # 3851 CITY LICENSE # 1041

NUMBER	FIXTURE OR INSTALLATION	UNIT PRICE	
	Fixture or sockets.	.15	
	Light, receptacle or switch outlet	.20	
	Wall or ceiling space heater	.35	
	Blast coil heater per kilowatt	.35	
	Garbage grinder outlet	.35	
	Dishwasher outlet	.35	
	Clothes dryer outlet	.35	
	Automatic clothes washer	.35	
	Electric range outlet	.35	
	Electric water heater outlet	.35	
	Mercury arc lamp and equipment	.35	
	Special purpose outlet	.35	
	X-ray unit and its appurtenances	5.00	
	Watts of festoon lighting (Watts) First 3,000 watts	4.00	
	for each additional thousand watts	1.50	
	Horsepower - all motors first horsepower or less	1.75	
	for each additional horsepower	.35	
	Temporary power and lights (temporary pole)	4.00	
	Electric service (including any single meter socket)	3.00	
	for each additional socket	.35	
	Air conditioning service amps.	1.50	
	Each KW (KVA) Generator (Transformer) (Welder) KW (KVA)	2.00	
	First 100 KVA - For each additional KW (KVA)	.01	
	Special inspection per hour	4.00	
	Speaker outlets	.15	
	Signal or Alarm outlets	.15	
	Amplifiers	.50	
	Control panels	.25	
	T. V. outlets - master system only	.15	
	Radio outlets	.15	
	Main control racks	1.00	
	T. V. and Radio antennas - master system only	.75	
	Minimum fee for any permit	4.00	4.00
	Total fee		4.00

I hereby certify that I have carefully examined and read the above application; that the same is true and correct; and that the work herein described is to be done in accordance with all the provisions of the applicable Ordinances of the City of Las Vegas, Nevada and State laws whether herein specified or not.

SIGNED [Signature] Date 10-19-67
MASTER (ELECTRICIAN) (TECHNICIAN) (OWNER)
BUILDING DEPARTMENT [Signature] Date 10/23/67
#1286 PERMIT NO. 24154 PERMIT FEE: 4.00

RECEIPT
996 \$004.00 - 6
CITY OF LAS VEGAS
DEPT. OF
BUILDING & SAFETY
MUST BE MACHINE VALIDATED
23 OCT 67

Sharon Davis April 27, 1979

1968
CITY OF LAS VEGAS, NEVADA

LOG NO. & AREA

CONST. VAL. \$ 40.00

DEPARTMENT OF BUILDING & SAFETY

APPLICATION & BUILDING PERMIT — for:
Fence, Wall, Retaining Wall.

ADDRESS OF
CONSTRUCTION:

1409

FAY

BLVD.

OWNER:

Lierney

LOT(s)

7

BLOCK

9

SUBDIVISION

GOLF RIDGE TERR. No 7-C

ZONE:

R-1

Materials of

Construction:

Block ☒

Concrete ☐

Wire ☐

Wood ☐

Other ☐

Yes No

PLANS:

☐ ☒

ARCHITECT:

ENGINEER:

CALCS:

☐ ☒

CONTRACTOR:

OWNER

STATE

LICENSE #

CITY

LICENSE #


TOTAL SQUARE FEET:

TOTAL LINEAL FEET: 20

Remarks:

CONDITIONS OF THE PERMIT:

1. Any type of retaining wall must be engineered by a Civil or Structural Engineer.
2. If a home owner takes out the Building Permit, and if the owner sublets the work to a Contractor, then the Contractor must take out the permit and pay for it.
3. No fence or wall can be built on City property or rights-of-way, but this is not intended to preclude construction within utility easements if utilities will not be damaged or made inaccessible.
4. The fence or wall shall not enclose any water meter, light standard, or fire alarm box and shall not come closer than 24" from the nearest fire hydrant outlet.
5. Department Inspectors must approve footings before concrete is poured and block wall reinforcing before grouting is done.
6. Maximum height of any wall or fence is 6', side and rear yards; 4' maximum in front yard with the vertical surface above the height of 2' — 50% open and farther that fencing within 25' of the lot section of curb faces on corner and through lots is limited to a maximum height of 30".
7. I must not obstruct required onsite parking space (1 space for each dwelling unit) by the erection of this fence or wall.
8. By the signing of this application I herewith agree to the requirements outlined above.

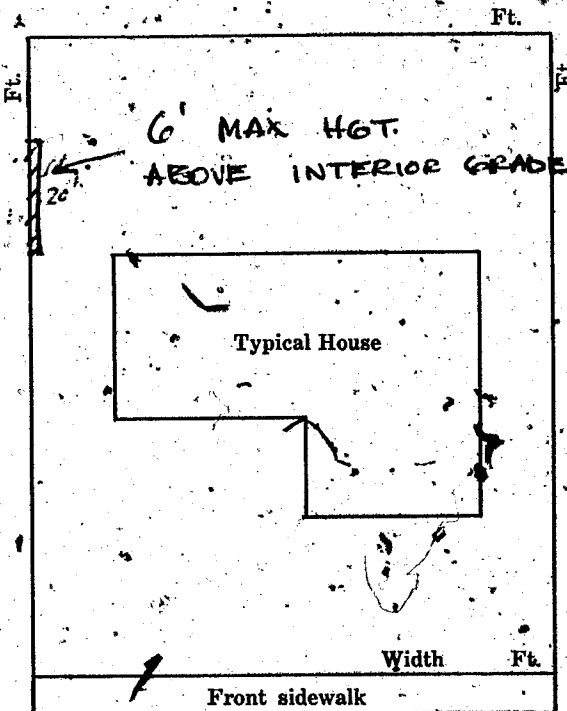

SIGNED

CONTRACTOR ☐ AGENT ☐ OWNER ☒

DATE:

1-15-68

PLANNING DEPT:

Date:

1-15-68

ENGINEERING DEPT:

Date:

BUILDING DEPT:

Date:

1-15-68

#1285

PERMIT NO:

39875

PERMIT FEE:

30.00

RECEIPT

3243

\$803.00

CITY OF LAS VEGAS

DEPT. OF

BUILDING & SAFETY

MUST BE MACHINE VALIDATED

1-15-68

Sharon L. Lera April 27, 1979

CITY OF LAS VEGAS, NEVADA

LOG NO. & AREA

DEPARTMENT OF BUILDING & SAFETY

CONST. VAL. \$

40.00

APPLICATION & BUILDING PERMIT for:
Fence, Wall, Retaining Wall.

ADDRESS OF
CONSTRUCTION:

1409 FAY BLVD.

OWNER:

Lierney

LOT(s)

7

BLOCK

9

SUBDIVISION

GOLE RIDGE TERR. No 7-C

ZONE:

R-1

Materials of Construction:

Block

Concrete

Wire

Wood

Other

Yes No

PLANS:

Yes No

ARCHITECT:

ENGINEER:

CALCS:

Yes No

CONTRACTOR:

OWNER

STATE

LICENSE #

CITY

LICENSE #

TOTAL SQUARE FEET:


TOTAL LINEAL FEET:

20

Remarks:

CONDITIONS OF THE PERMIT:

1. Any type of retaining wall must be engineered by a Civil or Structural Engineer.
2. If a home owner takes out the Building Permit and if the owner sublets the work to a Contractor, then the Contractor must take out the permit and pay for it.
3. No fence or wall can be built on City property or rights-of-way, but this is not intended to preclude construction within utility easements if utilities will not be damaged or made inaccessible.
4. The fence or wall shall not enclose any water meter, light standard, or fire alarm box and shall not come closer than 24" from the nearest fire hydrant outlet.
5. Department Inspectors must approve footings before concrete is poured and block wall reinforcing before grouting is done.
6. Maximum height of any wall or fence is 6', side and rear yards; 4' maximum in front yard with the vertical surface above the height of 2' - 50% open and farther that fencing within 25' of the lot section of curb faces on corner and through lots is limited to a maximum height of 30".
7. I must not obstruct required onsite parking space (1 space for each dwelling unit) by the erection of this fence or wall.
8. By the signing of this application I herewith agree to the requirements outlined above.

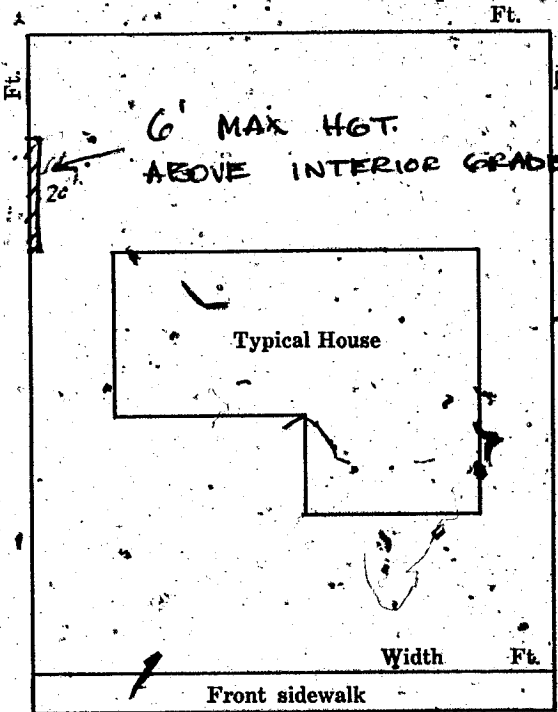

SIGNED

CONTRACTOR ☐ AGENT ☐ OWNER ☐

DATE:

1-15-68

PLANNING DEPT:

Date:

1-15-68

ENGINEERING DEPT:

Date:

BUILDING DEPT:

Date:

1-15-68

#1285

PERMIT NO:

39875

PERMIT FEE:

300

RECEIPT

3243 \$803.00

CITY OF LAS VEGAS

DEPT. OF
BUILDING & SAFETY


MUST BE MACHINE VALIDATED

1-15-68

Sharon Pereira April 27, 1979

CITY OF LAS VEGAS, NEVADA
Department of Building and Safety

CERTIFICATE OF INSPECTION

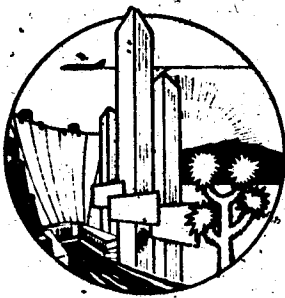

Address 1409 Fay Blvd

Owner Bill Ragdale

Legal Lot 7 Blk 9 Colfridge Terrace # Date 6-28-78

This certificate issued pursuant to the requirements of Section 306 of the
UNIFORM BUILDING CODE certifying that at the time of this issuance
the improvements on this property were in compliance with CITY OF LAS
VEGAS, HOUSING, BUILDING, ELECTRICAL, PLUMBING and MECH-
ANICAL CODES

DIRECTOR
Department of Building & Safety

[Signature]

This Certificate does not include conditions subject to normal maintenance.

No. GR-314807

Fee \$ 25.00

12850

RECEIPT

Must be machine validated

PAID

N.M.

6-21-78

DEPT. of BLDG. & SAFETY—CITY of LAS VEGAS, NEVADA

OWNER MIRANTI CONST. CO. ADDRESS 1409 Fay Blvd. DATE 2-15-62
 GEN. CONT. SAME TYPE OF STRUCTURE S.F. Dwl.
 PERMIT NO. 7957 LEGAL DESCRIPTION Lot 7-Block 9 Gold Ridge Terr #7-C

BUILDING		MECHANICAL		ELECTRICAL	
LOCATION <u>Sublot 3-6-62</u>	PLUMBING CONT. <u>Deane</u>	TEMP. POLE CONT.	PERMIT NO.	DATE	
FIREPLACE FTS.	PERMIT NO. <u>57877</u>	DATE <u>6-6-62</u>	INSPECTION	DATE	
FOUNDATIONS <u>Sublot 3-6-62</u>	HEAT & VENT. AC CONT. <u>Hammock</u>	ELECTRICAL CONT. <u>Deane</u>	PERMIT NO. <u>5735</u>	DATE <u>3-28-62</u>	
FOUNDATION WALL	PERMIT NO. <u>21661</u>	DATE <u>3-28-62</u>	FIXTURES CONT. <u>Deane</u>	PERMIT NO. <u>5735</u>	DATE <u>3-28-62</u>
STEM WALL <u>Sublot 3-9-62</u>	SEWER CONT. <u>Deane</u>	DATE <u>6-6-62</u>	SLAB <u>Miller</u>	DATE <u>1-17-62</u>	
FLOOR FRAMING	PERMIT NO. <u>2877</u>	DATE <u>3-15-62</u>	ROUGH	DATE	
SLAB <u>10-8-3-19-62</u>	ROUGH SOIL <u>Deane</u>	DATE <u>3-15-62</u>	FINAL ROUGH	DATE	
CHIMNEY STEEL (FIREPLACE)	ROUGH WATER <u>Deane</u>	DATE <u>3-15-62</u>	FINAL FIXTURE	DATE	
WALL STEEL <u>Sublot 4-3-62</u>	TOP-OUT <u>Deane</u>	DATE <u>4-23-62</u>	TEMPORARY SERVICE	DATE	
COLUMN STEEL	ROUGH GAS <u>Deane</u>	DATE <u>4-23-62</u>			
BEAM STEEL <u>Sublot 4-3-62</u>	AC ROUGH DUCT <u>Deane</u>	DATE <u>4-1-62</u>			
STEEL FABRICATION	REF. ROUGH PIPING				
FRAMING <u>Sublot 4-17-62</u>	FINAL PLUMBING <u>Deane</u>	DATE <u>5-28-62</u>			
ROOF SHEATHING <u>Sublot 4-18-62</u>	FINAL GAS <u>Deane</u>	DATE <u>5-28-62</u>			
INTERIOR	FINAL AIR COND. <u>Deane</u>	DATE <u>5-28-62</u>			
EXTERIOR	FINAL REFRIG. <u>Deane</u>	DATE <u>5-28-62</u>			
DRYWALL	FINAL SEWER <u>Deane</u>	DATE <u>5-28-62</u>			
LATHING	FINAL SEPTIC TANK				
BACKING (SIDING)					
PLASTER					
SCRATCH					
BROWN					
FINAL BLDG. <u>4-8-62</u>	DATE <u>6-21-62</u>				

APPROVED FOR OCCUPANCY Sealed 6-21-62 INSPECTOR Miller DATE 6-21-62
 APPROVED FOR METER Miller DATE 6-21-62
 PLEASE NOTE REMARKS ON REVERSE SIDE

1409 Fay Blvd.

T-4

3

DEPT. of BLDG. & SAFETY—CITY of LAS VEGAS, NEVADA

OWNER MICHAEL P. TIERNEY ADDRESS 1409 Fay Blvd. DATE 3/10/67
 GEN. CONT. OWNER TYPE OF STRUCTURE Bedroom
 PERMIT NO. 36394 LEGAL DESCRIPTION Lot 7, Block 9, Goldridge Terrace Addition

BUILDING		MECHANICAL		ELECTRICAL	
LOCATION	PLUMBING CONT. <u>Miller</u>	TEMP. POLE CONT.	PERMIT NO.	DATE	
FIREPLACE FTS.	PERMIT NO. <u>22114</u>	DATE <u>10-20-67</u>	INSPECTION	DATE	
FOUNDATIONS	HEAT & VENT. AC CONT.		ELECTRICAL CONT. <u>Miller</u>	DATE <u>10-20-67</u>	
FOUNDATION WALL	PERMIT NO.	DATE	PERMIT NO. <u>24154</u>	DATE <u>10-23-67</u>	
FLOOR FRAMING	SEWER CONT.		FIXTURES CONT.	DATE	
SLAB	PERMIT NO.	DATE	PERMIT NO.	DATE	
CHIMNEY STEEL (FIREPLACE)	ROUGH SOIL		SLAB		
WALL STEEL <u>Sublot 3-6-62</u>	ROUGH WATER		ROUGH		
COLUMN STEEL	TOP-OUT		FINAL ROUGH		
BEAM STEEL <u>Sublot 3-6-62</u>	ROUGH GAS		FINAL FIXTURE		
FRAMING	AC ROUGH DUCT		FINAL ELECTRICAL <u>Miller</u>	DATE <u>11-13-67</u>	
ROOF SHEATHING	REF. ROUGH PIPING		TEMPORARY SERVICE		
INTERIOR	FINAL PLUMBING				
EXTERIOR	FINAL GAS				
DRYWALL	FINAL AIR COND.				
LATHING	FINAL REFRIG.				
BACKING (SIDING)	FINAL SEWER				
PLASTER	FINAL SEPTIC TANK				
SCRATCH					
BROWN					
URBAN REDEVELOPMENT APPROVAL					
FINAL BLDG. <u>4-8-62</u>	DATE <u>6-21-62</u>				

APPROVED FOR OCCUPANCY & METER Miller DATE 6-21-62 INSPECTOR Miller DATE 6-21-62
 PLEASE NOTE REMARKS ON REVERSE SIDE

1409 Fay Blvd.

LOG: #

AREA: #

23.04

DEPT. of BLDG & SAFETY—CITY of LAS VEGAS, NEVADA
OWNER MIKE TIERNEY ADDRESS 1409 Fay Blvd. DATE 7-25-62
GEN. CONT. Desert Royal Pools TYPE OF STRUCTURE pool
PERMIT NO. 11479 LEGAL DESCRIPTION _____

BUILDING		MECHANICAL		ELECTRICAL	
LOCATION		PLUMBING CONT.		TEMP. POLE CONT.	
FIREPLACE FTS.		PERMIT NO. <u>11479</u>	DATE <u>7-26-62</u>	PERMIT NO.	DATE
FOOTINGS		HEAT & VENT. AC CONT.		INSPECTION	DATE
FOUNDATION WALL		PERMIT NO.	DATE	ELECTRICAL CONT.	DATE
STEM WALL		SEWER CONT.		PERMIT NO.	DATE
FLOOR FRAMING		PERMIT NO.	DATE	FIXTURES CONT.	DATE
SLAB		ROUGH SOIL		PERMIT NO.	DATE
CHIMNEY STEEL (FIREPLACE)		ROUGH WATER		SLAB	
WALL STEEL		TOP-OUT		ROUGH	
COLUMN STEEL		ROUGH GAS		FINAL ROUGH	
BEAM STEEL		AC ROUGH DUCT		FINAL FIXTURE	
STEEL FABRICATION <u>W 7-27-62</u>		REF. ROUGH PIPING		TEMPORARY SERVICE	
FRAMING		FINAL PLUMBING		MISCELLANEOUS	
ROOF SHEATHING		FINAL GAS		URBAN REDEVELOPMENT APPROVAL	
INTERIOR	EXTERIOR	FINAL AIR COND.		☐	
DRYWALL		FINAL REFRIG.		GRADING & DRAINAGE	
LATHING		FINAL SEWER		ON-SITE PARKING SPACES	
BACKING (SIDING)		FINAL SEPTIC TANK		ENG. APPROVAL OF	
PLASTER	SCRATCH			OFF-SITE IMPROVEMENTS	
BROWN				DATE	
FINAL BLDG.	DATE				

APPROVED FOR OCCUPANCY _____
APPROVED FOR METER _____
PLEASE NOTE REMARKS ON REVERSE SIDE 7-27-62 LOG: # _____ AREA: # _____ 23.04

1409 Fay Blvd.

Plans attached to application

DEPARTMENT OF BUILDING & SAFETY
CITY OF LAS VEGAS, NEVADA

KARDEX CARD
FENCE & RETAINING
WALLS

OWNER Tierney ADDRESS 1409 Fay Blvd DATE 1/16/68

CONTRACTOR Owner PERMIT NO. 39875

LOT 7 BLOCK 9 SUBDIVISION Golfridge Terrace #7-C
Block Wall

Fence (wire, wood, etc.)		Walls (masonry, rock, etc.)	
Location		Location	
Final Inspection		Footings	
		Wall Steel 1st _____ 2d _____ 3d _____	
		Final Inspection	
Retaining Wall (masonry)		Retaining Wall (concrete)	
Location		Location	
Footings		Footings	
Wall Steel 1st _____ 2d _____ 3d _____		Wall Steel 1st _____ 2d _____ 3d _____	
Bond Beam 1st _____ 2d _____ 3d _____		Final Inspection	
Final Inspection			

23.14 B

ADDRESS 1409 Fay Blvd.

LOG NO. _____

AREA _____