

4712 FULTON PLACE

LOT 541 BLK 23 HYDE PARK #3 ZONE R-1

D. Gatewood 5-1-79

CITY OF LAS VEGAS, NEVADA

LOG NO. & AREA _____
DEPARTMENT OF BUILDING & SAFETY

CONST. VAL. \$ 600

APPLICATION: BUILDING PERMIT — for:
Dwellings, Duplexes, Misc. Residential Const.

ADDRESS OF CONSTRUCTION: 4712 Fulton Place

OWNER: MARTHA MAYCOTTE

LOT(s) 591 BLOCK 23 SUBDIVISION Hyde Park Subdivision No 3 ZONE: R-1

Existing structure on lot: Dwelling Accessory bldgs. Vacant lot Other

ENCLOSE CAR PORT

PROPOSED CONSTRUCTION:

USE: Family Room

MATERIALS OF CONSTRUCTION: Wood Frame Concrete Block Reinforced Concrete Steel Frame

SQ. FEET OF FLOOR AREAS: 1st _____ 2nd _____ 3rd _____ Other _____ TOTAL SQ. FT. 200


FIRE ZONE: 1 2 3 Occupancy Group: J 1-2 CONST. TYPE: I II III IV V

ARCHITECT: _____ ENGINEER: _____ NO. of UNITS _____ NO. of STORIES _____

Plans Submitted: Yes No Calculations Submitted: Yes No Sewer Fee Req'd.: Yes No

CONTRACTOR: _____ OWNER _____ STATE LICENSE # _____ CITY LICENSE # _____

ADD'L. PERMITS REQ'D.: Air Cond. Elec. Plumbing Signs Paying Fence Public Walks Curb-gutters
Incinerators Fire Sprinkling System

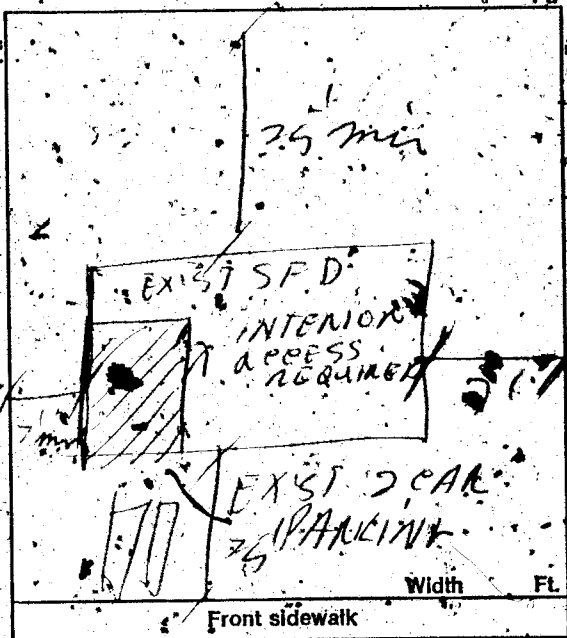

CONDITIONS OF THE PERMIT:

- I agree to call the City Building Department for inspections before concrete is poured, before rough wiring, electrical, plumbing, framing is covered. Also for air conditioning, sheet-rock and sheathing inspection.
- I agree that when the job is completed that I will call for final inspection before occupancy.
- I agree to perform all construction in accordance with City Ordinances and Building Codes.
- The Contractor's signature below denotes authority from the owner to sign in his behalf and that the owner is aware of all requirements of this application and permit. Separate permits must be taken out for work outlined above this agreement.
- I have read and understand the contents of this application and permit; I hereby state that the information I have supplied on this application is true and correct.

SIGNED: MARTHA MAYCOTTE Contractor

BY: Mrs. Martha Maycotte Agent or Owner

CLARK COUNTY HEALTH DEPT. _____ Date _____

LAS VEGAS FIRE DEPARTMENT _____ Date _____

PLANNING DEPT.: _____ Date: 1-18-73

PUBLIC WORKS DEPT.: _____ Date: _____

BUILDING DEPT.: _____ Date: 1-18-73

#12850 PERMIT NO.: 8880 PERMIT FEE \$ 800

RECEIPT

8792 \$008.00 - 8

CITY OF LAS VEGAS
DEPT. OF BUILDING & SAFETY
MUST BE MACHINE VALIDATED

19 JAN 73

D. Gatewood 5-1-79

CITY OF LAS VEGAS, NEVADA

DEPARTMENT OF BUILDING & SAFETY - ELECTRICAL APPLICATION & PERMIT

ADDRESS OF CONSTRUCTION: 4712 Fulton Place OWNER'S NAME: MARTHA MAYCOTTE

CIRCLE: New Bldg.; Add'n.; Remodel; TYPE OF BLDG.: SFD. APT. PUBLIC COMM.

CONTRACTOR'S NAME: OWNER STATE LICENSE # _____ CITY LICENSE # _____

NUMBER	FIXTURE OR INSTALLATION	UNIT PRICE	TOTAL
✓	Rm addition, carport or garage enclosure	4.00	4.00
	Temporary power	4.00	
	Light, receptacle or switch outlet	.20	
	Wall or ceiling space heater	.35	
	Garbage grinder outlet	.35	
	Dishwasher outlet	.35	
	Clothes dryer outlet	.35	
	Automatic clothes washer	.35	
	Electric range outlet	.35	
	Electric water heater outlet	.35	
	Special purpose outlet	.35	
	X-ray unit and its appurtenances	8.00	
	Watts of festoon lighting (Watts) First 3,000 watts for each additional thousand watts	4.00 1.50	
	Horsepower each motor first horsepower or less for each additional horsepower	1.75 .35	
	Electric service (including any single meter socket) for each additional socket	3.00 .35	
	Air conditioning service	1.50	
	Each KW(KVA) Generator (Transformer, Welder) First 100 KVA for each additional KW(KVA)	2.00 .01	
	Speaker, signal or alarm outlet	.15	
	Amplifiers	.50	
	Control panels	.25	
	Main control racks	1.00	
	T.V. and radio antennas-master system only	.75	
	Minimum fee for any permit	4.00	
	TOTAL FEE		4.00

Approval for the work under this permit will be given only after refuse and debris have been removed from job site and public right of way

I hereby certify that I have carefully examined and read the above application; that the same is true and correct; and that the work herein described is to be done in accordance with all the provisions of the applicable Ordinances of the City of Las Vegas, Nevada and State laws whether herein specified or not.

SIGNED Martha Maycotte DATE _____
MASTER (ELECTRICIAN) (TECHNICIAN) (OWNER)

BUILDING DEPARTMENT _____ DATE 1-18-73

#12860 PERMIT NO. 5198 PERMIT FEE: \$ 4.00

RECEIPT

9291 \$004.00 - 6

CITY OF LAS VEGAS
 DEPT. OF BUILDING & SAFETY
 *MUST BE MACHINE VALIDATED

19 JAN 73

Lilla Collins 2-1-82

DEPT. of BLDG & SAFETY - CITY of LAS VEGAS, NEVADA

OWNER Martha Maycotte ADDRESS 4712 Fulton Place DATE 1-18-73
GEN. CONT. Owner TYPE OF STRUCTURE Enc carport
PERMIT NO. 8880 LEGAL DESCRIPTION L 541 B 23 Hyde Park Subdivision # 3

BUILDING		MECHANICAL		ELECTRICAL	
LOCATION		PLUMBING CONT.		TEMP. POLE CONT.	
FIREPLACE FTS.		PERMIT NO.	DATE	PERMIT NO.	DATE
FOOTINGS		HEAT & VENT. AD CONT.		INSPECTION	DATE
FOUNDATION WALL		PERMIT NO.	DATE	ELECTRICAL CONT.	Owner
FLOOR FRAMING		SEWER CONT.		PERMIT NO.	5198
BLAB		PERMIT NO.	DATE	FIXTURES CONT.	
CHIMNEY STEEL (FIREPLACE)		ROUGH SOIL		PERMIT NO.	DATE
WALL STEEL		ROUGH WATER		SLAB	
COLUMN STEEL		TOP-OUT		ROUGH	
BEAM STEEL		ROUGH GAS		FINAL ROUGH	
FRAMING		AC ROUGH DUCT		FINAL FIXTURE	
ROOF SHEATHING		REP. ROUGH PIPING		FINAL ELECTRICAL	
	INTERIOR	FINAL PLUMBING		TEMPORARY SERVICE	
BRYWALL		FINAL GAS			
LATHING		FINAL AIR COND.		MISCELLANEOUS	
BACKING (SIDING)		FINAL REFRIG.		GRADING & DRAINAGE	
PLASTER	SCRATCH	FINAL SEWER		ON-SITE PARKING SPACES	APP.
	BROWN	FINAL SEPTIC TANK		ENG. APPROVAL OF	
URBAN REDEVELOPMENT APPROVAL				OFF-SITE IMPROVEMENTS	
<input type="checkbox"/> FINAL BLDG	DATE				

APPROVED FOR OCCUPANCY METER PR-11-74 INSPECTOR _____ DATE _____

PLEASE NOTE REMARKS ON REVERSE SIDE LOG: # _____ AREA: # _____ 230

4712 Fulton Place