

· 2125 GLENHEATHER ·

DEPT. of BLDG & SAFETY - CITY of LAS VEGAS, NEVADA

OWNER HAROLD THOMPSON ADDRESS 2125 Glen Heather Way DATE 12-20-61
 GEN. CONT. same TYPE OF STRUCTURE S.F. Dwl.
 PERMIT NO. 7134 LEGAL DESCRIPTION Lot 21 Block 4 Glen Heather #3

BUILDING		MECHANICAL		ELECTRICAL	
LOCATION <u>2125 Glen Heather Way</u>	PLUMBING CONT. <u>1-17-62</u>	TEMP. POLE CONT. <u>DATE</u>			
FIREPLACE FTS <u>4.6</u>	PERMIT NO. <u>7134</u>	PERMIT NO. <u>DATE</u>			
FOOTINGS <u>4.6</u>	HEAT & VENT. AC CONT. <u>1-17-62</u>	INSPECTION <u>DATE</u>			
FOUNDATION WALL <u>4.6</u>	PERMIT NO. <u>7134</u>	ELECTRICAL CONT. <u>DATE</u>			
STEM WALL	SEWER CONT. <u>1-17-62</u>	PERMIT NO. <u>DATE</u>			
FLOOR FRAMING	PERMIT NO. <u>7134</u>	FIXTURES CONT. <u>DATE</u>			
SLAB <u>Burlington 1-24-62</u>	ROUGH SOIL <u>1-22-62</u>	SLAB <u>DATE</u>			
CHIMNEY STEEL (FIREPLACE)	ROUGH WATER <u>1-22-62</u>	ROUGH <u>DATE</u>			
WALL STEEL	TOP-OUT <u>3-19-62</u>	FINAL ROUGH <u>DATE</u>			
COLUMN STEEL	ROUGH GAS <u>3-19-62</u>	FINAL FIXTURE <u>DATE</u>			
BEAM STEEL	AC ROUGH DUCT <u>3-15-62</u>	TEMPORARY SERVICE <u>DATE</u>			
STEEL FABRICATION	REF. ROUGH PIPING <u>3-15-62</u>	MISCELLANEOUS URBAN REDEVELOPMENT APPROVAL ☐ GRADING & DRAINAGE <u>DATE</u> ON-SITE PARKING SPACES <u>APR</u> ENG. APPROVAL OF <u>DATE</u> OFF-SITE IMPROVEMENTS <u>DATE</u>			
FRAMING <u>2-22-62</u>	FINAL PLUMBING <u>6-6-62</u>				
ROOF SHEATHING <u>2-22-62</u>	FINAL GAS <u>6-6-62</u>				
INTERIOR <u>2-22-62</u>	FINAL AIR COND. <u>6-6-62</u>				
EXTERIOR <u>2-22-62</u>	FINAL REFRIG. <u>2-27-62</u>				
DRYWALL <u>2-22-62</u>	FINAL SEWER <u>2-27-62</u>				
LATHING <u>2-22-62</u>	FINAL SEPTIC TANK <u>2-27-62</u>				
BACKING (SIDING) <u>2-22-62</u>					
SCRATCH <u>2-22-62</u>					
PLASTER <u>2-22-62</u>					
BROWN <u>2-22-62</u>					
FINAL BLDG. <u>2-22-62</u>					

APPROVED FOR OCCUPANCY Burlington 2-26-62 INSPECTOR DATE
 APPROVED FOR METER Miller 6-7-62 LOG # AREA # 23.04
 PLEASE NOTE REMARKS ON REVERSE SIDE

2125 Glen Heather Way T-63 4

DEPT. of BLDG & SAFETY - CITY of LAS VEGAS, NEVADA

OWNER B. C. Valder ADDRESS 2125 Glen Heather Way DATE 5-11-64
 GEN. CONT. same TYPE OF STRUCTURE BLK wall
 PERMIT NO. 25429 LEGAL DESCRIPTION Lot 21 BLK 4 Glen Heather #2

BUILDING		MECHANICAL		ELECTRICAL	
LOCATION <u>2125 Glen Heather Way</u>	PLUMBING CONT. <u>DATE</u>	TEMP. POLE CO. <u>DATE</u>			
FIREPLACE FTS <u>13.6</u>	PERMIT NO. <u>DATE</u>	PERMIT NO. <u>DATE</u>			
FOOTINGS <u>13.6</u>	HEAT & VENT. AC CONT. <u>DATE</u>	INSPECTION <u>DATE</u>			
FOUNDATION WALL	PERMIT NO. <u>DATE</u>	ELECTRICAL CONT. <u>DATE</u>			
FLOOR FRAMING	SEWER CONT. <u>DATE</u>	PERMIT NO. <u>DATE</u>			
SI'S	PERMIT NO. <u>DATE</u>	FIXTURES CONT. <u>DATE</u>			
CHIMNEY STEEL (FIREPLACE)	ROUGH SOIL	PERMIT NO. <u>DATE</u>			
WALL STEEL <u>5-18-64</u>	ROUGH WATER	SLAB <u>DATE</u>			
COLUMN STEEL	TOP-OUT	ROUGH <u>DATE</u>			
BEAM STEEL	ROUGH GAS	FINAL ROUGH <u>DATE</u>			
FRAMING	AC ROUGH DUCT	FINAL FIXTURE <u>DATE</u>			
ROOF SHEATHING	REF. ROUGH PIPING	FINAL ELECTRICAL <u>DATE</u>			
INTERIOR	FINAL PLUMBING	TEMPORARY SERVICE <u>DATE</u>			
EXTERIOR	FINAL GAS	MISCELLANEOUS GRADING & DRAINAGE <u>DATE</u> ON-SITE PARKING SPACES <u>APR</u> ENG. APPROVAL OF <u>DATE</u> OFF-SITE IMPROVEMENTS <u>DATE</u>			
DRYWALL	FINAL AIR COND. <u>DATE</u>				
LATHING	FINAL REFRIG. <u>DATE</u>				
BACKING (SIDING)	FINAL SEWER <u>DATE</u>				
SCRATCH	FINAL SEPTIC TANK <u>DATE</u>				
BROWN					
PLASTER					
FINAL BLDG. <u>5-18-64</u>					

APPROVED FOR OCCUPANCY & METER DATE INSPECTOR DATE
 PLEASE NOTE REMARKS ON REVERSE SIDE

2125 Glen Heather Way LOG # AREA # 23.04

Don't Halsey 3-16-13

CITY OF LAS VEGAS, NEVADA

03A-014-010

LOG NO. & AREA

CONST. VAL. \$ 1400

DEPARTMENT OF PUBLIC SERVICES
DIVISION OF BUILDING AND SAFETY

APPLICATION & BUILDING PERMIT - for:
Dwellings, Duplexes, Misc. Residential Const.

ADDRESS OF CONSTRUCTION: 2125 Glen Harbor Wy.

OWNER: DANIEL J. LYONS

LOT(s) 3X BLOCK 4 SUBDIVISION Glen Harbor Estates #3 ZONE R-1

Existing structure on lot: Dwelling ☒ Accessory Bldgs. ☐ Vacant Lot ☐ Other ☐ enlarge

PROPOSED CONSTRUCTION: Enlarge Kitchen using part of Garage USE: Kitchen

MATERIALS OF CONSTRUCTION: Wood Frame ☒ Concrete Block ☐ Reinforced Concrete ☐ Steel Frame ☐

SQUARE FEET OF FLOOR AREAS: 1st 85ft² 2nd 3rd Other TOTAL SQ. FT.


FIRE ZONE: Occupancy Group CONST. TYPE:

ARCHITECT: D. Lyons ENGINEER: D. Lyons NO. of UNITS NO. of STORIES

Plans Submitted: Yes ☒ No ☐ Calculations Submitted: Yes ☐ No ☒ Sewer Fee Req'd: Yes ☐ No ☒

CONTRACTOR: OWNER STATE LICENSE CITY LICENSE

ADD'L. PERMITS REQ'D: Air Cond. ☐ Elec. ☒ Plumbing ☐ Signs ☐ Paving ☐ Fence ☐ Public Walks ☐ Curb-gutters ☐ Incinerators ☐ Fire Sprinkling System ☐

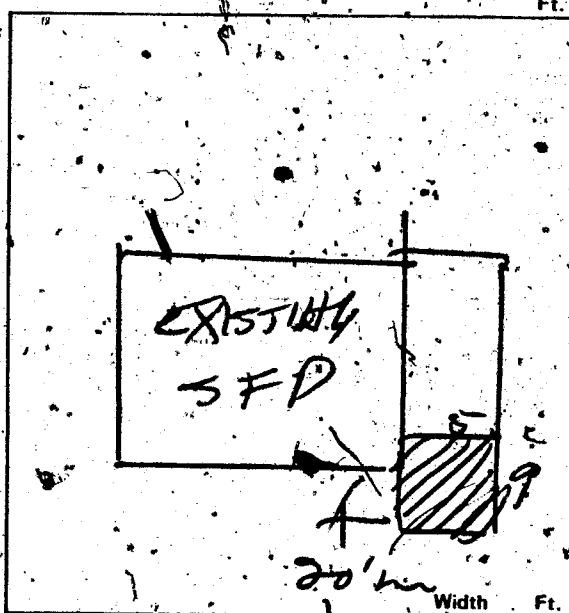

Front property line

CONDITIONS OF THE PERMIT:

1. I agree to call the City Building Department for inspections before concrete is poured, before rough wiring, electrical, plumbing, framing is covered. Also for Air conditioning, drywall and sheathing inspection.
2. I agree that when the job is completed that I will call for final inspection before occupancy.
3. I agree to perform all construction in accordance with City Ordinances and Building Codes.
4. The Contractor's signature below denotes authority from the owner to sign in his behalf and that the owner is aware of all requirements of this application and permit. Separate permits must be taken out for work outlined above this agreement.
5. I have read and understand the contents of this application and permit. I hereby state that the information I have supplied on this application is true and correct.

Approval for the work under this permit will be given only after refuse and debris have been removed from job site and public right of way. Separate permits are required for work within the public right of way.

SIGNED: [Signature] CONTRACTOR \$ 00

BY: [Signature] ELEC \$ 26.30 Agent or Owner

STL \$ 58.80
TOTL \$ 58.80
CHEK \$ 58.80

888088 SR#001/01
CITY - LAS VEGAS
BLDG & SAFETY
03-13-83 RECEIPT

PLANNING DEPT: [Signature] Date: 3/14/83

PUBLIC WORKS DEPT: [Signature] Date: 3/14/83

BUILDING DIVISION: [Signature] Date: 3/14/83

PERMIT NO.: 8088 PERMIT FEE \$ 32.50

2300-2401

MUST BE MACHINE VALIDATED

Donna Hensley 3-16-83

CITY OF LAS VEGAS, NEVADA

DEPARTMENT OF BUILDING AND SAFETY-ELECTRICAL APPLICATION & PERMIT

PHONE NO. 382-9408

ADDRESS OF CONSTRUCTION: 2125 Glen Heather Way

OWNER'S NAME: DANIEL J. LYONS

CIRCLE: Addition Remodel New Bldg.

TYPE OF BLDG.: SFD APT. COMM. PUBLIC

CONTRACTOR'S NAME: Owner

STATE LICENSE #

CITY LICENSE #

UNITS	DESCRIPTION	FEE	TOTAL
1	PERMIT ISSUANCE		
	For Issuing Each Permit	10.00	10.00
	Supplemental Fee	4.50	14.50
	APPLIANCE CHARGE		
10	Receptacle Switch	.40	4.00
30	Each Light Fixture or Socket	.30	9.00
	EACH OUTLET FOR: Dishwasher, Garbage Grinder, Trash Compactor, G.F.L., Clothes Washer, Dryer, Electric Range, Ovens, Smoke Detector, Special Purpose, Water Heater, Space Heater, Blast Coil Heater (PER K.W.), Mercury Lamp, Quartz Lamp, Sodium Lamp	.70	21.00
	X-Ray Unit	10.00	
	Area Lighting (First 3,000 Watts)	8.00	
	Each Additional 1,000 Watts	3.00	
	Motors (1/2 H.P. And Over) Transformers Welders, Generators		
	First H.P. for each Unit	3.00	
	First KVA for Each Unit	.50	
	Each Additional H.P. or KVA	.30	
	Temporary Power or Pole	6.00	
	Electric Service (Incl'd First Meter)	6.00	
1	Up to 200 AMP CAG 100 → 200A.		6.00
	400 AMP And 600 AMP	12.50	
	Over 600 AMP To 1200 AMP	25.00	
	Over 1200 AMP	50.00	
	Each Additional Meter Socket	.50	

UNITS	DESCRIPTION	FEE	TOTAL
1	Sub Panel (Each)	3.00	3.00
	Swimming Pool (Residential)	20.00	
	Swimming Pool (Semi-Public)	30.00	
	Spas	8.00	
	Recreational Vehicle Spaces (Each)	3.00	
	Busways-Trolley or Plug-in (Ea. 100 Ft.)	3.00	
	All Misc. Electric		
	Permanent A/C Unit (Pkg. Units)	3.00	
	Each Air Handler	1.00	
	LOW VOLTAGE INSTALLATIONS		
	Speaker Outlets (Each)	.30	
	Signal or Alarm Outlets (Each)	.30	
	Amplifiers	2.00	
	Control Panel	.50	
	TV Master System	.30	
	Telephone or Computer Outlet	.30	
	Starter Permit		
	Contract Price or Cost of Installation		
	Misc.		
	CONDUIT ONLY		
	TOTAL PERMIT FEE \$	26.30	26.30

Electrical permit fees may be computed the same as building permit fees by using the cost of installation for valuation amount when such work is not included in the above schedule.

FOR BUILDING DEPARTMENT USE ONLY

Plans submitted: ☐ yes ☐ no

Occupancy type: _____

Type of Construction _____

Square Footage _____

Received by PAC: _____

Date: _____

Valuation (declared) \$ _____

Review by Plans Check: _____

Date: _____

Fee calculated \$ _____

Issued by _____

Date: _____

Other Fees (226) \$ _____

Check ☐ Cash ☐

Total Fees \$ _____

Other inspections and fees:

1. Inspections outside of normal business hours = \$25.00 per hour (minimum charge two hours).
2. Re-inspection fee during normal business hours assessed under provisions of TABLE 3-A of the Uniform Building Code = \$15.00 per hour.
3. Inspections during normal business hours for which no fee is specifically indicated = \$15.00 per hour (minimum charge one half hour).
4. Additional plan review required by changes, additions or revisions to approved plans = \$15.00 per hour (minimum charge one half hour).
5. Expires 180 days after appointment of work.

Approval for the work under this permit will be given only after refuse and debris have been removed from job site and public right of way.

I hereby certify that I have carefully examined and read the above application; that the same is true and correct; and that the work herein described is to be done in accordance with all the provisions of the applicable Ordinances of the City of Las Vegas, Nevada and the State Laws, whether herein specified or not. City Master Card No. _____

SIGNED _____

Master (Electrician) (Technician) (Owner)

Date 3/14/83

BUILDING DIVISION _____

Date 3/14/83

PERMIT NO. 8088-1

PERMIT FEE \$ 26.30

2360-2402 (3/82)

RECEIPT

JACKIE B.

2-7-86

OWNER Daniel Lyons ADDRESS 2125 Glen Heather Wy

DATE 3-15-83 GEN. CONT. Owner

TYPE OF STRUCTURE remod.

PERMIT NO. 8088

FINAL INSPECTION

LEGAL DESCRIPTION

21 B 4 Glen Heather Wy

TOS NO.

AREA NO.

APPROVED FOR OCCUPANCY & METER

BUILDING

MECHANICAL

Investigation

Plumbing Cont.

Location & Footing

Permit No.

Date

Concrete Slab Floor

Heat & Vent. A/C Cont.

Fireplace Footing

Permit No.

Date

Chimney Steel

Sewer Cont.

Vert. Steel Reinf.

Permit No.

Date

Horiz. Steel Reinf.

Rough Soil

Framing

DB 4-19-83

Rough Water

Ext. Lath

Top Out

Ext. Brown

Rough Gas

Drywall

DB 4-19-83

A/C Rough Duct

Final Building

DB 4-19-83

Final Plumbing

Appr. for Occu.

Final Gas

ELECTRICAL

Final Air Cond.

Temp. Pole Cont.

Final Sewer

Permit No.

Date

REMARKS

Inspection

Date

Electrical Cont.

Owner

Permit No.

8088-1

Date

3-15-83

Rough

PLEASE NOTE ADDITIONAL REMARKS ON REVERSE SIDE.

Final Rough

DEPT. OF BLDG. & SAFETY

CITY OF LAS VEGAS

REV: 82-3-29

Temporary Service

Parking Holding DB 4-19-83

Debbie Inghram 5-28-87

5580

CITY OF LAS VEGAS, NEVADA

LOG NO. & AREA M-595 DATE 03A-014-010 CONST. VAL. \$ 6287.00

DEPARTMENT OF BUILDING AND SAFETY

BUILDING PERMIT - FOR: Single Family Dwelling, Remodel, Additions, Misc. Residential Construction

ADDRESS OF CONSTRUCTION 2125 Glenn Leather Way PHONE ONE 386-6251 OWNER Don Lyons

LOT 21 BLOCK 3 SUBDIVISION Glenn Leather Way ZONE R-1

PROPOSED CONSTRUCTION addition USE family room/living rm

THIS PERMIT FOR 1215 BLDG. ☒ A/C ☐ ELEC. ☐ PLBG. ☐ OTHER PERMITS REQD.: FENCE ☐ OFF. ☐ SWIM. ☐ POOL ☐



ARCHITECT OWNER ENGINEER OWNER

MASTER PLUMBER/CONTRACTOR OWNER MASTER ELECTRICIAN/CONTRACTOR OWNER

OTHER INSPECTIONS AND FEES

- Inspections outside of normal business hours = \$30.00 per hour (minimum charge three hours)
- Re-inspection fee during normal business hours assessed under provisions of TABLE 3-A of the Uniform Building Code = \$30.00 per hour
- Inspections during normal business hours for which no fee is specifically indicated = \$30.00 per hour (minimum charge one half hour)
- Additional plan review required by changes, additions or revisions to approved plans = \$30.00 per hour (minimum charge two hours)

CONDITIONS OF THE PERMIT:

- I agree to call the City Building Department for inspections before concrete is poured, before rough wiring, electrical, plumbing, framing is covered. Also for air conditioning, drywall and sheathing inspection.
 - I agree that when the job is completed that I will call for final inspection before occupancy.
 - I agree to perform all construction in accordance with City Ordinances and Building Codes.
 - The Contractor's signature below denotes authority from the owner to sign in his behalf and that the owner is aware of all requirements of this application and permit. Separate permits must be taken out for work outlined above this agreement.
 - I have read and understand the contents of this application and permit; I hereby state that the information I have supplied on this application is true and correct.
 - Approval for the work under this permit will be given only after refuse and debris have been removed from job site and public right of way.
- 24 HOUR MINIMUM NOTICE REQUIRED FOR INSPECTIONS.

BY: Don Lyons OWNER

BY: Don Lyons AGENT

I hereby certify that I have reviewed this application and the proposed plans and have found that the proposed development meets the requirements of the City of Las Vegas Flood Hazard Reduction Ordinance for the issuance of this Development Permit.


LAND DEVELOPMENT AND FLOOD CONTROL ENGINEER W.A. DATE 5/19/87

PLANNING DEPT. M.J. DATE 5/19/87

BUILDING DEPT. M.J. DATE 5/19/87

PLUMBING		FEE	ELECTRICAL		FEE
WATER DISTRIBUTION	6.00	6.00	RECEPTACLE <u>11</u> SWITCH <u>5</u>	.40	6.40
SEWER SYSTEM - NEW OR MODIFICATION	10.00	10.00	EACH LIGHT FIXTURE OR SOCKET <u>4</u>	.30	1.20
FIXTURES - WATER-SOFTENER, H.W. HEATER	2.00	6.00	SPECIAL OUTLET, APPL. ETC.	.70	-
GARBAGE DISPOSAL - WASHER	2.00	-	SERVICE/PANEL - SUB/3.00 - 200A/6.00 - 400A/12.50	-	-
FUEL PIPING	6.00	-	A.C. UNIT OR MOTORS	3.00	05/19/87
IRRIGATION SYSTEM	8.00	-	2310 - 2402 TOTAL	-	7.60
MISC.	-	-	MISC.	-	-
2310 - 2403 TOTAL	-	22.00	2310 - 2401 ISSUANCE FEE	-	-
AIR CONDITIONING		FEE	7114 - 3654 SEWER CONNECTION	-	-
NEW UNIT - 3 TON = 9.00 OVER = 16.50	-	-	2310 - 2401 PLAN REVIEW FEE	-	-
FURNACE TO 100,000/9.00 OVER/11.00	-	-	2310 - 2401 BLDG. PERMIT FEE	-	-
VAPORATIVE COOLER	6.50	-	TOTAL FEES	-	75.00
VENTILATION FAN	2.35	-		-	104.60
2310 - 2405 TOTAL	-	-		-	-

Permit Expires 180 Days After Abandonment of Work

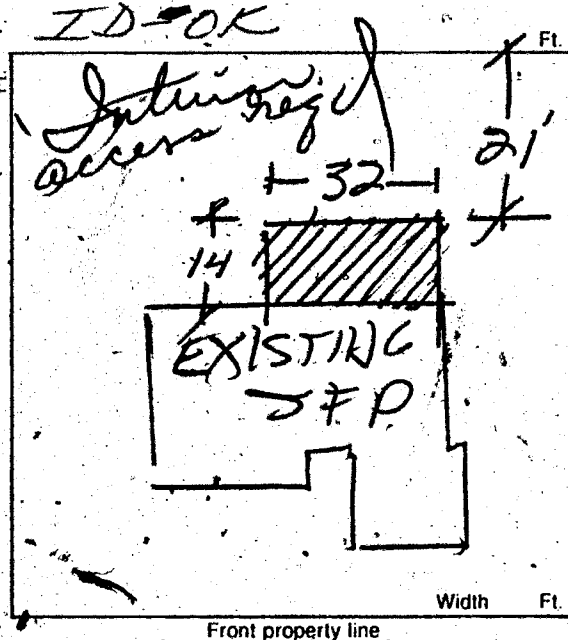

FOR INSPECTIONS
CALL 799-2071

REC#0006**
SFD 104.60
VOID
SFD -104.60
SFD 75.00
ELEC 7.60
PLBG 22.00
CHEK 104.60
8275A000 13:17

#4.60 cash

PERMIT NO. 75
MUST BE MACHINE VALIDATED

Debbie Hughes 5-5-88

OWNER D. Lyons		ADDRESS 2125 Glenn Heather	
DATE 5/19/87	G.C. CONT. Owner		
BUILD TYPE Addn.	PERMIT No. 8275		
LEGAL SEE APPLICATION	LOG No. M-595		
BUILDING		MECHANICAL	
Pt. Loc. & Ft. ☐	Plumbing Cont.		
Location & Footing ☐ TS 7-20-87	Permit No.	Date	
Stemwall ☐	A/C Cont.		
Concrete Slab Floor ☐ TS 7-20-87	Permit No.	Date	
Chimney Steel ☐	Sewer Fee		
Fireplace Footing ☐	Irrig. Cont.		
West. Steel Band. ☐	Permit No.	Date	
Horiz. Steel Band. ☐	Hood Cont.		
Roof Sheathing ☐	Permit No.	Date	
Insulation ☐	Rough Soil ☐ TS 7-20-87		
Framing ☐	Rough Water ☐		
Ext. Lath ☐	Top-Out		
Ext. Scratch ☐	Rough Gas		
Ext. Brown ☐	A/C Rough Duct.		
Drywall ☐	Final Plumbing		
Final Building ☐ EXD5/4/88	Final Gas		
Appr. for Occu. Final Building	Final Air Cond.		
	Final Sewer		
ELECTRICAL		Rough Hood ☐	
Electrical Cont.	Final Hood ☐		
Permit No.	Date	Final Irrig.	
PT Rough			
Ground Electrode	ELECTRICAL		
Temporary Power	Temp. Pole Cont.		
Meter Tag	Permit No.	Date	
Final Electrical	Inspection	Date	

Debbie Hughes 5-5-88

CITY OF LAS VEGAS, NEVADA

LOG NO. & AREA _____ DATE _____ CONST. VAL. \$ _____

DEPARTMENT OF BUILDING AND SAFETY

PHONE 386-3251
ADDRESS OF CONSTRUCTION 2128 Glen Heather Way OWNER Don Lyons
BUILDING PERMIT - FOR: Single Family Dwelling, Removal, Additions, Misc. Residential Construction
PHONE NO. _____

LOT(s) _____ BLOCK _____ SUBDIVISION _____ ZONE _____

PROPOSED CONSTRUCTION addn. renewal USE _____

THIS PERMIT FOR 9900 BLDG. ☐ AC ☐ ELEC. ☒ PLBG ☒ OTHER PERMITS REQD.: FENCE ☐ OFF SITE ☐ SWIM POOL ☐

FLOOR AREA BSMT _____ 1ST _____ 2ND _____ GARAGE _____ PORCH _____ TOTAL _____

CONTRACTOR _____ STATE LICENSE NO. _____ CITY LICENSE NO. _____

ARCHITECT _____ ENGINEER _____

MASTER PLUMBER/CONTRACTOR _____ MASTER ELECTRICIAN/CONTRACTOR _____

OTHER INSPECTIONS AND FEES

1. Inspections outside of normal business hours = \$30.00 per hour (minimum charge three hours)
2. Re-inspection fee during normal business hours assessed under provisions of TABLE 3-A of the Uniform Building Code = \$30.00 per hour
3. Inspections during normal business hours for which no fee is specifically indicated = \$30.00 per hour (minimum charge one half hour)
4. Additional plan review required by changes, additions or revisions to approved plans = \$30.00 per hour (minimum charge two hours)

CONDITIONS OF THE PERMIT:

1. I agree to call the City Building Department for inspections before concrete is poured, before rough wiring, electrical, plumbing, framing is covered. Also for air conditioning, drywall and sheathing inspection.
2. I agree that when the job is completed that I will call for final inspection before occupancy.
3. I agree to perform all construction in accordance with City Ordinances and Building Codes.
4. The Contractor's signature below denotes authority from the owner to sign in his behalf and that the owner is aware of all requirements of this application and permit. Separate permits must be taken out for work outlined above this agreement.
5. I have read and understand the contents of this application and permit; I hereby state that the information I have supplied on this application is true and correct.
6. Approval for the work under this permit will be given only after refuse and debris have been removed from job site and public right of way.
7. 24 HOUR MINIMUM NOTICE REQUIRED FOR INSPECTIONS.

BY: [Signature]
I HEREBY DECLARE THAT I AM THE LEGAL OWNER OF THE ABOVE PROPERTY. OWNER

BY: _____
AGENT

I hereby certify that I have reviewed this application and the proposed plans and have found that the proposed development meets the requirements of the City of Las Vegas Flood Hazard Reduction Ordinance for the issuance of this Development Permit.


LAND DEVELOPMENT AND FLOOD CONTROL ENGINEER

PLANNING DEPT.

BUILDING DEPT.

PLUMBING		FEE	ELECTRICAL		FEE
WATER DISTRIBUTION	6.00		RECEPTACLE _____ SWITCH _____		.40
SEWER SYSTEM - NEW OR MODIFICATION	10.00		EACH LIGHT FIXTURE OR SOCKET _____		.30
FIXTURES - WATER SOFTENER, H.W. HEATER	2.00		SPECIAL OUTLET, APPLIANCE ETC. _____		.70
GARBAGE DISPOSAL - WASHER	2.00		SERVICE/PANEL - SUB/3.00 - 200A/6.00 - 400A/12.50		
FUEL PIPING	6.00		A.C. UNIT OR MOTORS _____		3.00
IRRIGATION SYSTEM	8.00		2310 - 2402 _____	TOTAL	3.80
MISC.		11.00	MISC. _____		
2310 - 2403					
TOTAL			2310 - 2401 ISSUANCE FEE		
AIR CONDITIONING		FEE	7114 - 3654 SEWER CONNECTION		
NEW UNIT - 3 TON = 9.00 OVER = 16.50			2310 - 2401 PLAN REVIEW FEE		
FURNACE TO 100,000/9.00 OVER = 17.00			2310 - 2401 BLDG. PERMIT FEE		37.50
VAPORATIVE COOLER	6.50		TOTAL FEES		52.30
VENTILATION FAN	2.35				
2310 - 2405					
TOTAL					

Permit Expires 180 Days After Abandonment of Work

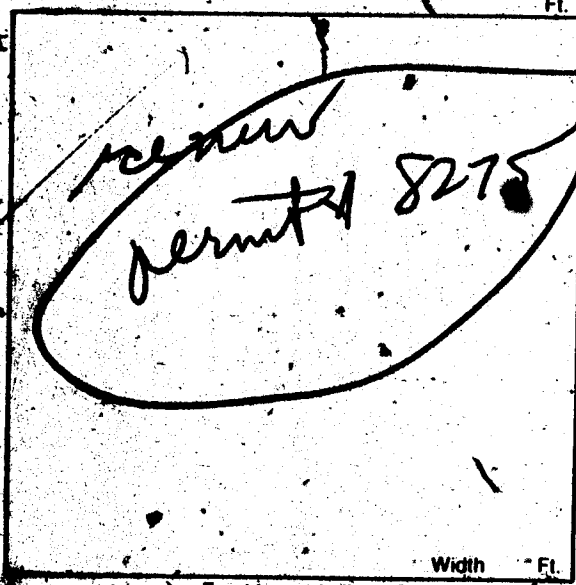

FOR INSPECTIONS
CALL 799-2071

REC-0003**

SFD 37.50
ELEC 3.80
PLBG 11.00
CASH 52.30
9900A000 15:33

PERMIT NO. _____
MUST BE MACHINE VALIDATED