

2025 Goldring

L6 B3 Woodland Park Zone R-E

Station: *May 30, 1979*

6-16-8
12-20-8
10-17-8
BUILDING DEPARTMENT
CITY OF LAS VEGAS

CORRECTION NOTICE

Jonies Grey

Job Located at *2035 Tidding*

I have this day inspected this structure and these premises and have found the following violations of City and/or State laws governing same:

Corrected 3-0-78

*Please, correct
welder work up
on panel at rear of
house. The vice you
have is unsafe -
(condemned to a secure
receipt)
Thank you
I will check back in a
week -*

Old at
You are hereby notified to correct above violation and call for re-inspection.

Date *1-30-78* *Sagibara*
Inspector

23.03 Do not remove this tag!

Sharon Ferrel May 30, 1979

CITY OF LAS VEGAS, NEVADA
DEPT. OF PUBLIC SERVICES

LOG NO. & AREA _____
DIVISION OF BUILDING & SAFETY
PHONE: 386-6251

CONST. VAL. \$ 3600
APPLICATION & BUILDING PERMIT - for
Dwellings, Duplexes, Misc. Residential Const.

ADDRESS OF CONSTRUCTION: 2025 Haldering

OWNER: James Gray

LOT(s) 16 BLOCK 3 SUBDIVISION WOODLAND PK ZONE: RT

Existing structure on lot: Dwelling ☐ Accessory bldgs. ☐ Vacant lot ☐ Other ☐

PROPOSED CONSTRUCTION: detached Storage Bld USE: _____

MATERIALS OF CONSTRUCTION: Wood Frame ☐ Concrete Block ☐ Reinforced Concrete ☐ Steel Frame ☐

SQ. FEET OF FLOOR AREAS: 1st _____ 2nd _____ 3rd _____ Other _____ TOTAL SQ. FT. 720

FIRE CODE: _____ Occupancy Group _____

CONST. TYPE: _____

ARCHITECT: _____ ENGINEER: _____ NO. of UNITS _____ NO. of STORIES _____

Plans Submitted: Yes ☐ No ☐ Calculations Submitted: Yes ☐ No ☐ Sewer Fee Req'd: Yes ☐ No ☐

CONTRACTOR: Sevnes STATE LICENSE # _____ CITY LICENSE # _____

ADD'L. PERMITS REQ'D: Air Cond. ☐ Elec. ☐ Plumbing ☐ Signs ☐ Paving ☐ Fence ☐ Public Walks ☐ Curb-gutters ☐
Incinerators ☐ Fire Sprinkling System ☐

CONDITIONS OF THE PERMIT:


1. I agree to call the City Building Department for inspections before concrete is poured, before rough wiring, electrical, plumbing, framing is covered. Also for air conditioning, sheet-rock and sheathing inspection.
2. I agree that when the job is completed that I will call for final inspection before occupancy.
3. I agree to perform all construction in accordance with City Ordinances and Building Codes.
4. The Contractor's signature below denotes authority from the owner to sign in his behalf and that the owner is aware of all requirements of this application and permit. Separate permits must be taken out for work outlined above this agreement.
5. I have read and understand the contents of this application and permit; I hereby state that the information I have supplied on this application is true and correct.

SIGNED: James R. Sevnes Contractor

BY: _____ Agent or Owner

CLARK COUNTY HEALTH DEPT.

LAS VEGAS FIRE DEPARTMENT

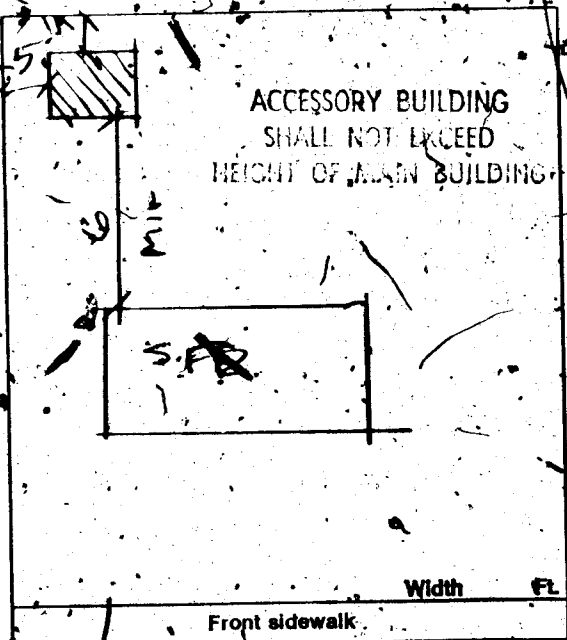

PLANNING DEPT. _____ Date: 3-2-77

PUBLIC WORKS DEPT. _____ Date: _____

BUILDING DEPT. WFA Date: 3/2/77

PERMIT NO. 1112

PERMIT FEE \$ 24.00

6077 RECORDS - 8

CITY OF LAS VEGAS
DEPT. OF PUBLIC SERVICES
BUILDING & SAFETY

MUST BE REVALIDATED

Sharon Ferrel May 30, 1979

CITY OF LAS VEGAS, NEVADA
DEPT. OF PUBLIC SERVICES

LOG NO. & AREA

DIVISION OF BUILDING & SAFETY

PHONE: 386-6251

CONST. VAL. \$ 3600

APPLICATION & BUILDING PERMIT - for
Dwellings, Duplexes, Misc. Residential Const.

ADDRESS OF
CONSTRUCTION:

2025 Hildering

OWNER:

James Gray

LOT(s)

16

BLOCK

3

SUBDIVISION

WOODLAND PK

ZONE

EE

Existing structure on lot: Dwelling ☐

Accessory bldgs. ☐

Vacant lot ☐

Other ☐

PROPOSED CONSTRUCTION:

~~Detached Storage Bld~~ detached Storage Bld

USE:

MATERIALS OF CONSTRUCTION:

Wood Frame ☐

Concrete Block ☐

Reinforced Concrete ☐

Steel Frame ☐

SQ. FEET OF FLOOR AREAS: 1st

2nd

3rd

Other

TOTAL SQ. FT.

720

FIRE CODE:

Occupancy Group

CONST. TYPE:

ARCHITECT:

ENGINEER:

NO. of UNITS

NO. of STORIES

Plans Submitted: Yes ☐ No ☐

Calculations Submitted: Yes ☐ No ☐

Sewer Fee Reg'd: Yes ☐ No ☐

CONTRACTOR:

Ocenes

STATE
LICENSE #

CITY
LICENSE #

ADD'L. PERMITS REQ'D: Air Cond. ☐

Elec. ☐

Plumbing ☐

Signs ☐

Paving ☐

Fence ☐

Public Walks ☐

Curb-gutters ☐

Incinerators ☐

Fire Sprinkling System ☐

CONDITIONS OF THE PERMIT:

- I agree to call the City Building Department for inspections before concrete is poured, before rough wiring, electrical, plumbing, framing is covered. Also for air conditioning, sheet-rock and sheathing inspection.
- I agree that when the job is completed that I will call for final inspection before occupancy.
- I agree to perform all construction in accordance with City Ordinances and Building Codes.
- The Contractor's signature below denotes authority from the owner to sign in his behalf and that the owner is aware of all requirements of this application and permit. Separate permits must be taken out for work outlined above this agreement.
- I have read and understand the contents of this application and permit; I hereby state that the information I have supplied on this application is true and correct.

SIGNED:

James R. Gray

Contractor

BY:

Agent or Owner

CLARK COUNTY HEALTH DEPT.

Date

LAS VEGAS FIRE DEPARTMENT

Date

PLANNING DEPT. *[Signature]*

Date: 3-2-77

PUBLIC WORKS DEPT. *[Signature]*

Date: 3/2/77

BUILDING DEPT. *[Signature]*

Date: 3/2/77

PERMIT NO. 1112

PERMIT FEE \$ 24.00

6077 RECEIVED - 8

CITY OF LAS VEGAS

DEPT. OF PUBLIC SERVICES

BUILDING & SAFETY

MUST BE MAINTAINED VALIDATED

Sharon Sierra May 30, 1979

CITY OF LAS VEGAS, NEVADA
DEPT. OF PUBLIC SERVICES

LOG NO. & AREA
DIVISION OF BUILDING & SAFETY
PHONE: 386-6251

CONST. VAL. \$ 700
APPLICATION & BUILDING PERMIT - for:
Dwellings, Duplexes, Misc. Residential Const.

ADDRESS OF CONSTRUCTION: 2025 GOLDRING

OWNER: James Gray

LOT(s) 67 BLOCK 3 SUBDIVISION Woodland

ZONE RE

Existing structure on lot: Dwelling ☐ Accessory bldgs. ☐ Vacant lot ☐ Other ☐

PROPOSED CONSTRUCTION: Fireplace

USE:

MATERIALS OF CONSTRUCTION: Wood Frame ☐ Concrete Block ☐ Reinforced Concrete ☐ Steel Frame ☐

SQ. FEET OF FLOOR AREAS: 1st 2nd 3rd Other TOTAL SQ. FT.


FIRE ZONE: Occupancy Group

CONST. TYPE:

ARCHITECT: ENGINEER: NO. of UNITS NO. of STORIES

Plans Submitted: Yes ☐ No ☐ Calculations Submitted: Yes ☐ No ☐ Sewer Fee Req'd. Yes ☐ No ☐

CONTRACTOR: Owner STATE LICENSE # CITY LICENSE #
ADD'L. PERMITS REQ'D: Air Cond. ☐ Elec. ☐ Plumbing ☐ Signs ☐ Paving ☐ Fence ☐ Public Walks ☐ Gurb-gutters ☐
Incinerators ☐ Fire Sprinkling System ☐

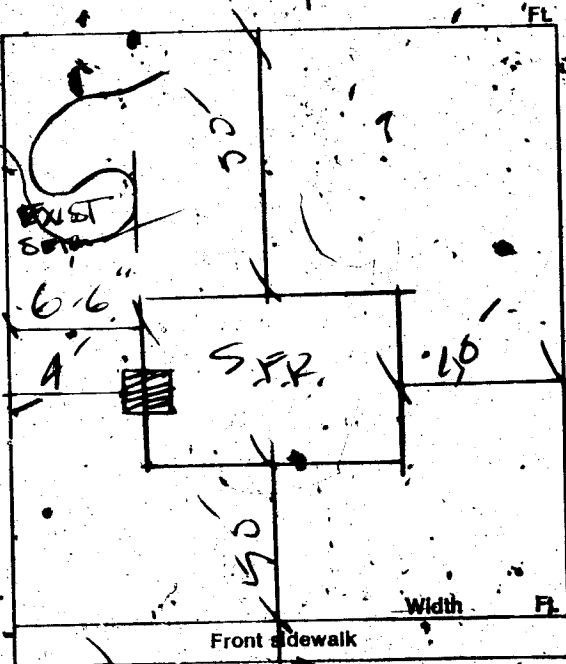

CONDITIONS OF THE PERMIT:

- I agree to call the City Building Department for inspections before concrete is poured, before rough wiring, electrical, plumbing, framing is covered. Also for air conditioning, sheet-rock and sheathing inspection.
- I agree that when the job is completed that I will call for final inspection before occupancy.
- I agree to perform all construction in accordance with City Ordinances and Building Codes.
- The Contractor's signature below denotes authority from the owner to sign in his behalf and that the owner is aware of all requirements of this application and permit. Separate permits must be taken out for work outlined above this agreement.
- I have read and understand the contents of this application and permit; I hereby state that the information I have supplied on this application is true and correct.

SIGNED: Contractor

BY: Agent or Owner

CLARK COUNTY HEALTH DEPT.

LAS VEGAS FIRE DEPARTMENT

PLANNING DEPT.: Date: 3/11/77

PUBLIC WORKS DEPT.: Date:

BUILDING DEPT.: Date: 3-11-77

PERMIT NO.: 1346 PERMIT FEE \$ 10.00

6659 4500.00 + 8

CITY OF LAS VEGAS
DEPT. OF PUBLIC SERVICES
BUILDING & SAFETY

MUST BE REVALIDATED

154-01-220
76-11-14

DIVISION of BUILDING & SAFETY - CITY of LAS VEGAS, NEVADA

OWNER James Gray ADDRESS 2025 Goldring DATE 3-11-77

GEN. CONT. Owner TYPE OF STRUCTURE Fireplace

PERMIT NO. 06 LEGAL DESCRIPTION L 6, B 3 Woodland Park

BUILDING	MECHANICAL	ELECTRICAL
Investigation	Plumbing Cont. _____ Date _____	Temp. pole cont. _____ Date _____
Location & Footing	Permit No. _____	Permit No. _____ Date _____
Stem Wall	Heat & Vent. A/C Cont. _____ Date _____	Inspection _____ Date _____
Concrete Slab Floor	Permit No. _____	Electrical Cont. _____ Date _____
Floor Framing	Sewer Cont. _____ Date _____	Permit No. _____
Fireplace Footing	Permit No. _____	Fixtures Cont. _____ Date _____
Chimney Steel	Rough Soil _____	Permit No. _____ Date _____
Vert. Steel Reinf.	Rough Water _____	Slab _____
Horiz. Steel Reinf.	Top-Out _____	Rough _____
Roof Sheathing	Rough Gas _____	Final Rough _____
Framing	A/C Rough Duct _____	Final Fixture _____
Backing for siding	Ref. Rough Piping _____	Final Electrical _____
Ext. Lath	Final Plumbing _____	Temporary Service _____
Ext. Scratch	Final Gas _____	MISCELLANEOUS
Ext. Brown	Final Air Cond. _____	Grading & Drainage _____ App. _____
Int. Lath	Final Refrig. _____	On-Site Parking Spaces _____
Int. Brown	Final Sewer _____	Eng. Approval of _____
Drywall	Final Septic Tank _____	Off-Site Improvements _____
Insulation		
Final Building		
Appr. for Occu.		

INSPECTOR: _____ DATE _____

APPROVED FOR OCCUPANCY & METER _____

PLEASE NOTE REMARKS ON REVERSE SIDE 2025 Goldring LOG # _____ AREA # _____ 76-114

DIVISION of BUILDING & SAFETY - CITY of LAS VEGAS, NEVADA

OWNER James Gray ADDRESS 2025 Goldring DATE 3/1/77

GEN. CONT. owner TYPE OF STRUCTURE detached stor. building

PERMIT NO. 1112 LEGAL DESCRIPTION Lot 6, block 3, Woodland Pk.

BUILDING	MECHANICAL	ELECTRICAL
Investigation	Plumbing Cont. _____ Date _____	Temp. pole cont. _____ Date _____
Location & Footing	Permit No. _____	Permit No. _____ Date _____
Stem Wall	Heat & Vent. A/C Cont. _____ Date _____	Inspection _____ Date _____
Concrete Slab Floor	Permit No. _____	Electrical Cont. _____ Date _____
Floor Framing	Sewer Cont. _____ Date _____	Permit No. _____
Fireplace Footing	Permit No. _____	Fixtures Cont. _____ Date _____
Chimney Steel	Rough Soil _____	Permit No. _____ Date _____
Vert. Steel Reinf.	Rough Water _____	Slab _____
Horiz. Steel Reinf.	Top-Out _____	Rough _____
Roof Sheathing	Rough Gas _____	Final Rough _____
Framing	A/C Rough Duct _____	Final Fixture _____
Backing for siding	Ref. Rough Piping _____	Final Electrical _____
Ext. Lath	Final Plumbing _____	Temporary Service _____
Ext. Scratch	Final Gas _____	MISCELLANEOUS
Ext. Brown	Final Air Cond. _____	Grading & Drainage _____ App. _____
Int. Lath	Final Refrig. _____	On-Site Parking Spaces _____
Int. Brown	Final Sewer _____	Eng. Approval of _____
Drywall	Final Septic Tank _____	Off-Site Improvements _____
Insulation		
Final Building		
Appr. for Occu.		

INSPECTOR: _____ DATE _____

APPROVED FOR OCCUPANCY & METER _____

PLEASE NOTE REMARKS ON REVERSE SIDE 2025 Goldring LOG # _____ AREA # _____ 76-114

DEPARTMENT OF BUILDING & SAFETY
CITY OF LAS VEGAS, NEVADA

KARDEX CARD
FENCE & RETAINING
WALLS

OWNER Willard Olsen

ADDRESS 2025 Goldring

DATE 6-24-65

CONTRACTOR W. J. Chester

PERMIT NO. 30735

LOT 7

BLOCK 3

SUBDIVISION Woodland Park

Wire fence

Fence (wire, wood, etc.)	Walls (masonry, rock, etc.)
Location _____	Location _____
Final Inspection <i>July 7-1965</i>	Footings _____
	Wall Steel 1st _____ 2d _____ 3d _____
	Final Inspection _____
Retaining Wall (masonry)	Retaining Wall (concrete)
Location _____	Location _____
Footings _____	Footings _____
Wall Steel 1st _____ 2d _____ 3d _____	Wall Steel 1st _____ 2d _____ 3d _____
Bond Beam 1st _____ 2d _____ 3d _____	Final Inspection _____
Final Inspection _____	

23.14 B

ADDRESS 2025 Goldring

LOT NO

AREA

DEPARTMENT OF BUILDING & SAFETY
CITY OF LAS VEGAS, NEVADA

KARDEX CARD
FENCE & RETAINING
WALLS

OWNER Willard Olsen

ADDRESS 2025 Goldring

DATE 6-24-65

CONTRACTOR W. J. Chester

PERMIT NO. 30735

LOT 7

BLOCK 3

SUBDIVISION Woodland Park

Wire fence

Fence (wire, wood, etc.)

Walls (masonry, rock, etc.)

Location

Final Inspection 6-24-65

Location

Footings

Wall Steel 1st 2d 3d

Final Inspection

Retaining Wall (masonry)

Retaining Wall (concrete)

Location

Footings

Wall Steel 1st 2d 3d

Bond Beam 1st 2d 3d

Final Inspection

Location

Footings

Wall Steel 1st 2d 3d

Final Inspection

23.14 B

ADDRESS 2025 Goldring

100 sq ft

AREA

not built 11-2-78
p. 142

not built 11-2-78
p. 142