

· 3812 Golf Lane ·

· L18 B3 Twin Lakes Country Club Est ·

Sharon [unclear] 5/17/79

CITY OF LAS VEGAS, NEVADA  
DEPARTMENT OF BUILDING AND SAFETY  
APPLICATION FOR FENCE, WALL OR  
RETAINING WALL

LOG NO. 1960  
AREA: \_\_\_\_\_  
KARDEX CARD: \_\_\_\_\_  
TELEPHONE: \_\_\_\_\_ DATE: \_\_\_\_\_ 19\_\_

CONSTRUCTION VALUATION: 252.00  
INSPECTION VALUATION: 200.00  
PERMIT FEE: 2.00  
PERMIT NUMBER: 33891

ADDRESS OF CONSTRUCTION: 3812 Golf Lane OWNER'S NAME: Wm. J. Morse OWNER'S ADDRESS: same

Lot (s) 18 Block 3 Subdivision: TWIN LAKES COUNTRY CLUB ESTATES Zone: \_\_\_\_\_

Materials of Construction: Block  Concrete  Wire  Wood  Other

Total Square Feet: 100 Total Linear Feet: 100

CONTRACTOR'S NAME: Owner STATE: 4 CITY: \_\_\_\_\_ LICENSE #: \_\_\_\_\_ LICENSE#: \_\_\_\_\_

Architect's Name: \_\_\_\_\_ PLANS SUBMITTED: Yes  No   
Engineer's Name: \_\_\_\_\_ CALCULATIONS: Yes  No


Street Name: Golf Lane  
Front Yard: 70.0 Feet

I understand that any portion of this (fence) (wall) constructed or erected on City property or right-of-way will be removed from said location at my expense upon request received from the City of Las Vegas, Nevada. I understand that the (fence) (wall) shall not enclose water meter, light standard, fire alarm box and shall not come closer than two (2') feet in any direction from any fire hydrant. I further state that I am familiar with effective Ordinances of the City of Las Vegas, Nev. and effective Statutes of the State of Nevada covering construction and use of above type; I agree to perform said construction in conformity therewith. I further agree that issuance of a permit on above application will not excuse me from conforming with said Ordinances and Statutes, despite any errors on the part of the Building Inspector or Engineer in checking plans and applications herewith submitted.

I have read and understand the contents of above application; I hereby state that same are true and correct.

SIGN HERE: Marjorie Morse  
By: \_\_\_\_\_

APPROVED BY: [Signature]  
PLANNING DEPT. & CODE ASSISTANCE DATE: \_\_\_\_\_  
FIRE DEPARTMENT DATE: \_\_\_\_\_  
ENGINEERING DEPT. DATE: \_\_\_\_\_  
BUILDING & SAFETY DEPT. DATE: 5/26/79

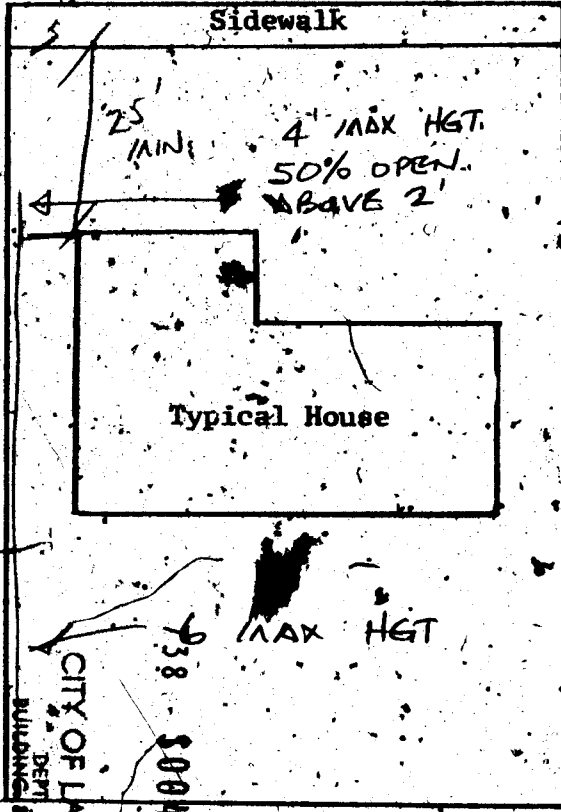

Side Yard Length 118.10 Feet

Side Yard Length 116.48 Feet

Rear Yard Length 70.02 Feet

23.14

Note: Owner or Contractor must call for all inspections required.

Sharon [unclear] 5/17/79

CITY OF LAS VEGAS, NEVADA  
DEPARTMENT OF BUILDING AND SAFETY  
APPLICATION FOR FENCE, WALL OR  
RETAINING WALL

LOG NO. 1960  
AREA: \_\_\_\_\_  
KARDEX CARD: \_\_\_\_\_  
TELEPHONE: \_\_\_\_\_  
CONSTRUCTION VALUATION: 252.00  
INSPECTION VALUATION: 280.00  
PERMIT FEE: 2.00  
PERMIT NUMBER: 83891  
DATE: \_\_\_\_\_ 19\_\_

ADDRESS OF CONSTRUCTION: 3812 Golf Lane  
OWNER'S NAME: Wm. J. Morse  
OWNER'S ADDRESS: same

Lot (s) 18 Block 3 Subdivision: TWIN LAKES COUNTRY CLUB ESTATES Zone: \_\_\_\_\_  
Materials of Construction: Block  Concrete  Wire  Wood  Other

Total Square Feet: 100 Total Lineal Feet: 100

CONTRACTOR'S NAME: Owner STATE: 4 CITY: \_\_\_\_\_  
LICENSE #: \_\_\_\_\_ LICENSE#: \_\_\_\_\_

Architect's Name: \_\_\_\_\_ PLANS SUBMITTED: Yes  No   
Engineer's Name: \_\_\_\_\_ CALCULATIONS: Yes  No


Street Name: Golf Lane  
Front Yard: 70.0 Feet

I understand that any portion of this (fence) (wall) constructed or erected on City property or right-of-way will be removed from said location at my expense upon request received from the City of Las Vegas, Nevada. I understand that the (fence) (wall) shall not enclose water meter, light standard, fire alarm box and shall not come closer than two(2') feet in any direction from any fire hydrant. I further state that I am familiar with effective Ordinances of the City of Las Vegas, Nev. and effective Statutes of the State of Nevada covering construction and use of above type; I agree to perform said construction in conformity therewith. I further agree that issuance of a permit on above application will not excuse me from conforming with said Ordinances and Statutes, despite any errors on the part of the Building Inspector or Engineer in checking plans and applications herewith submitted.

I have read and understand the contents of above application; I hereby state that same are true and correct.

SIGN HERE: Wm. J. Morse  
By: \_\_\_\_\_

APPROVED BY: [Signature] DATE: 5/26/79  
PLANNING DEPT. & CODE ASSISTANCE  
FIRE DEPARTMENT  
ENGINEERING DEPT.  
BUILDING & SAFETY DEPT. DATE: 5/26/79

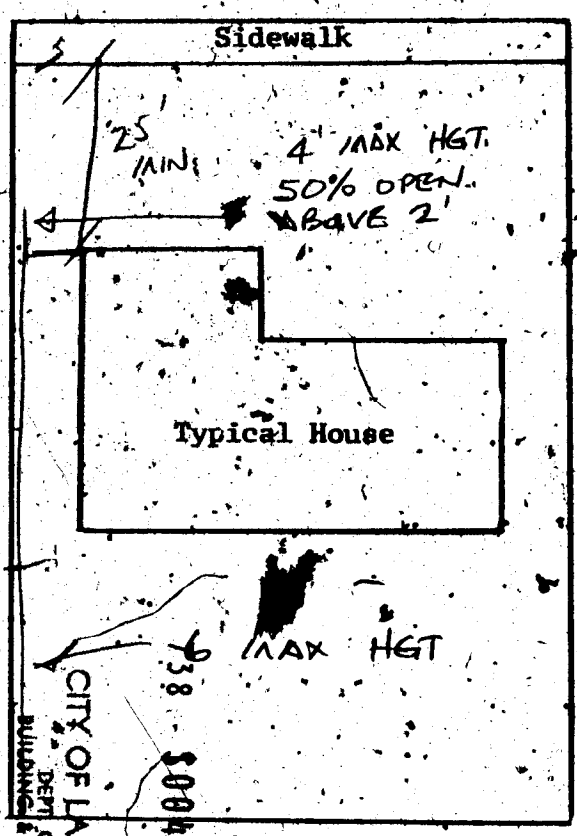

Side Yard Length 118.10 Feet

Side Yard Length 116.48 Feet

CITY OF LAS VEGAS  
DEPT. OF BUILDING & SAFETY

23.14

Note: Owner or Contractor must call for all inspections required.

