

1712 GOODRICH CIR .

CITY OF LAS VEGAS, NEVADA

LOG NO. & AREA T18-3

CONST. VAL. \$ 32,213.00

DEPARTMENT OF PUBLIC SERVICES
DIVISION OF BUILDING AND SAFETY

APPLICATION & BUILDING PERMIT - for:
Dwellings, Duplexes, Misc. Residential Const.

ADDRESS OF CONSTRUCTION: 1712 Goodrich Circle

OWNER: Metropolitan Development Corporation

LOT 53 BLOCK 1 SUBDIVISION Park Vista #2, Phase 2

ZONE R PD8

Existing structure on lot: Dwelling ☒ Accessory Bldg. ☐ Vacant Lot ☒ Other ☐

PROPOSED CONSTRUCTION: S F Dwelling W/F.P. USE Residence

MATERIALS OF CONSTRUCTION: Wood Frame ☒ Concrete Block ☐ Reinforced Concrete ☐ Steel Frame ☐

SQUARE FEET OF FLOOR AREAS: 1st 1132 2nd 384 3rd 41 TOTAL SQ. FT. 1557


FIRE ZONE: 3 Occupancy Group R-3 M-1 CONST. TYPE: 5N

ARCHITECT: David Weiss ENGINEER: David Weiss NO. of UNITS 1 NO. of STORIES 1

Plans Submitted: Yes ☒ No ☐ Calculations Submitted: Yes ☒ No ☐ Sewer Fee Req'd: Yes ☒ No ☐

CONTRACTOR: Metropolitan Dev. Corp. STATE LICENSE # 016269 CITY LICENSE # 16382

ADD'L. PERMITS REQ'D.: Air Cond. ☒ Elec. ☒ Plumbing ☒ Signs ☐ Paving ☐ Fence ☐ Public Walks ☐ Curb-buffers ☐
Incinerators ☐ Fire Sprinkling System ☐

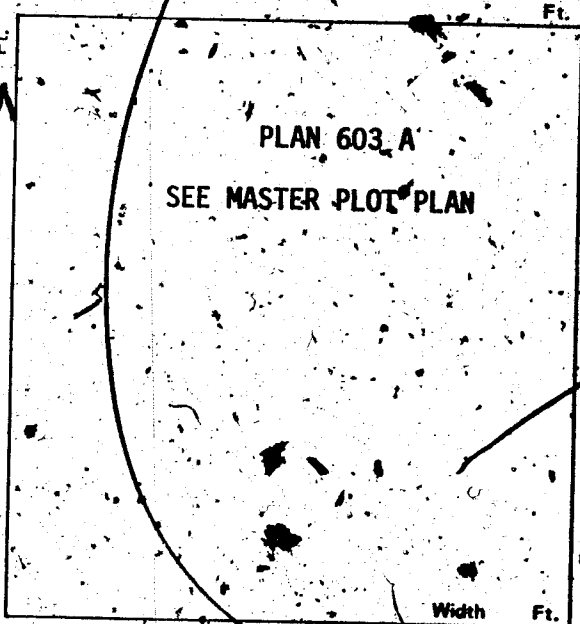

CONDITIONS OF THE PERMIT:

- I agree to call the City Building Department for inspections before concrete is poured, before rough wiring, electrical, plumbing, framing is covered. Also for Air conditioning, drywall and sheathing inspection.
- I agree that when the job is completed that I will call for final inspection before occupancy.
- I agree to perform all construction in accordance with City Ordinances and Building Codes.
- The Contractor's signature below denotes authority from the owner to sign in his behalf and that the owner is aware of all requirements of this application and permit. Separate permits must be taken out for work outlined above this agreement.
- I have read and understand the contents of this application and permit; I hereby state that the information I have supplied on this application is true and correct.

Approval for the work under this permit will be given only after refuse and debris have been removed from job site and public right of way.

SIGNED: Metropolitan Development Corp. Contractor

BY: [Signature] Agent or Owner

Assistant Administrator
Administrator Assistant

PLANNING DEPT. [Signature] Date: 8/12/82

PUBLIC WORKS DEPT. [Signature] Date: 8-12-82

BUILDING DIVISION: [Signature] Date: 8-13-82

PERMIT NO.: 2868-18 PERMIT FEE \$ 155.00

721-2401

RECEIPT

MUST BE MACHINE VALIDATED

CITY OF LAS VEGAS, NEVADA

DEPARTMENT OF BUILDING AND SAFETY - AIR CONDITIONING APPLICATION & PERMIT.

PHONE NO. 454-2192

ADDRESS OF CONSTRUCTION: 1712 Woodrich Circle

OWNER'S NAME: Metropolitan Development

CIRCLE: Addition; Remodel; New Bldg. TYPE OF BLDG: 6FD APT. COMM. PUBLIC

CONTRACTOR'S NAME: Quality Air Conditioning STATE LICENSE # 108674 CITY LICENSE # C11246-200577

UNITS	DESCRIPTION	FEE	TOTAL
PERMIT ISSUANCE			
1	For the issuance of each permit.	10.00	10.00
	For issuing each supplemental permit.	3.00	
UNIT FEE SCHEDULE			
	For the installation or relocation of each forced-air or gravity-type furnace or burner, including ducts and vents attached to such appliance, up to and including 100,000 Btu/h.	6.00	
	For the installation or relocation of each forced-air or gravity-type furnace or burner, including ducts and vents attached to such appliance over 100,000 Btu/h.	7.50	
	For the installation or relocation of each floor furnace, including vent.	6.00	
	For the installation or relocation of each suspended heater, recessed wall heater or floor-mounted unit heater.	6.00	
	For the installation, relocation or replacement of each appliance vent installed and not included in an appliance permit.	3.00	
	For the repair, alteration of, or addition to each heating appliance, refrigeration unit, cooling unit, absorption unit, or each heating, cooling, absorption, or evaporative cooling system, including installation of controls regulated by this code.	6.00	
	For the installation or relocation of each boiler or compressor to and including three horsepower, or each absorption system to and including 100,000 Btu/h.	6.00	6.00
	For the installation or relocation of each boiler or compressor over three horsepower to and including 15 horsepower, or each absorption system over 100,000 Btu/h and including 500,000 Btu/h.	11.00	
	For the installation or relocation of each boiler or compressor over 15 horsepower to and including 30 horsepower, or each absorption system over 500,000 Btu/h to and including 1,000,000 Btu/h.	15.00	
	For the installation or relocation of each boiler or compressor over 30 horsepower to and including 50 horsepower, or for each absorption system over 1,000,000 Btu/h to and including 1,750,000 Btu/h.	22.50	
	For the installation or relocation of each boiler or refrigeration compressor over 50 horsepower, or each absorption system over 1,750,000 Btu/h.	27.50	

UNITS	DESCRIPTION	FEE	TOTAL
	For each air-handling unit to and including 10,000 cubic feet per minute, including ducts attached thereto. Note: This fee shall not apply to an air-handling unit which is a portion of a factory-assembled appliance, cooling unit, evaporative cooler or absorption unit for which a permit is required elsewhere in this code.	4.50	
	For each air-handling unit over 10,000 cfm.	7.50	
	For each evaporative cooler other than portable type.	4.50	
1	For each ventilation fan connected to a single duct.	3.00	3.00
	For each ventilation system which is not a portion of any heating or air-conditioning system authorized by a permit.	4.50	
	For the installation of each hood which is served by mechanical exhaust, including the ducts for such hood.	4.50	
	No. of openings		
	Ductwork		
	For each appliance or piece of equipment regulated by this code but not classed in other appliance categories, or for which no other fee is listed in this code.	4.50	
	When Chapter 22 is applicable (see Section 103), permit fees for fuel-gas piping shall be as follows: For each gas-piping system of one to four outlets.	2.00	
	For each gas-piping system of more than four outlets, per outlet.	.50	
OTHER INSPECTIONS AND FEES:			
	Inspections outside of normal business hours (minimum charge — two hours).	15.00 per hour	
	Reinspection fee assessed under provisions of Section 305 (1).	15.00 each	
	Inspections for which no fee is specifically indicated (minimum charge — one-half hour).	15.00 per hour	
	Additional plan review required by changes, additions or revisions to approved plans (minimum charge — one-half hour).	15.00 per hour	
	Misc.		
	TOTAL PERMIT FEE \$ <u>19.00</u>		

Mechanical permit fees may be computed the same as building permit fees by using the cost of installation for valuation amount when such work is not included in the above schedule.
I hereby certify that I have carefully examined and read the above application; that the same is true and correct; and that the work herein described is to be done in accordance with all the provisions of the applicable Ordinances of the City of Las Vegas, Nevada and the State Laws, whether herein specifically mentioned or not.

Approval for the work under this permit will be given only after refuse and debris have been removed from job site and public right of way.

City Master Card No. _____

SIGNER: Wicki A. Roberts Date: 9-27-82
Air Conditioning Contractor - Owner

BUILDING DIVISION: D. Jones Date: 10-4-82

PERMIT NO. 3914-10 PERMIT FEE \$ 19.00
1321-2405

RECEIPT

CITY OF LAS VEGAS, NEVADA

DEPARTMENT OF BUILDING AND SAFETY - AIR CONDITIONING APPLICATION & PERMIT

ADDRESS OF CONSTRUCTION: 1712 Woodruff Circle

OWNER'S NAME: Metropolitan Development

PHONE NO. 454-2192

CIRCLE: Addition; Remodel; New Bldg. TYPE OF BLDG: OFF APT. COMM. PUBLIC

CONTRACTOR'S NAME: Quality Air Conditioning STATE LICENSE # 108674 CITY LICENSE # C11246-200577

UNITS	DESCRIPTION	FEE	TOTAL
PERMIT ISSUANCE			
1	For the issuance of each permit.	10.00	10.00
	For issuing each supplemental permit.	3.00	
UNIT FEE SCHEDULE			
	For the installation or relocation of each forced-air or gravity-type furnace or burner, including ducts and vents attached to such appliance, up to and including 100,000 Btu/h.	6.00	
	For the installation or relocation of each forced-air or gravity-type furnace or burner, including ducts and vents attached to such appliance over 100,000 Btu/h.	7.50	
	For the installation or relocation of each floor furnace, including vent.	6.00	
	For the installation or relocation of each suspended heater, recessed wall heater or floor-mounted unit heater.	6.00	
	For the installation, relocation or replacement of each appliance vent installed and not included in an appliance permit.	3.00	
	For the repair of, alteration of, or addition to each heating appliance, refrigeration unit, cooling unit, absorption unit, or each heating, cooling, absorption, or evaporative cooling system, including installation of controls regulated by this code.	6.00	
1	For the installation or relocation of each boiler or compressor to and including three horsepower, or each absorption system to and including 100,000 Btu/h.	6.00	6.00
	For the installation or relocation of each boiler or compressor over three horsepower to and including 15 horsepower, or each absorption system over 100,000 Btu/h and including 500,000 Btu/h.	14.00	
	For the installation or relocation of each boiler or compressor over 15 horsepower to and including 30 horsepower, or each absorption system over 500,000 Btu/h to and including 1,000,000 Btu/h.	15.00	
	For the installation or relocation of each boiler or compressor over 30 horsepower to and including 50 horsepower, or for each absorption system over 1,000,000 Btu/h to and including 1,750,000 Btu/h.	22.50	
	For the installation or relocation of each boiler or refrigeration compressor over 50 horsepower, or each absorption system over 1,750,000 Btu/h.	27.50	

UNITS	DESCRIPTION	FEE	TOTAL
	For each air-handling unit to and including 10,000 cubic feet per minute, including ducts attached thereto. Note: This fee shall not apply to an air-handling unit which is a portion of a factory-assembled appliance, cooling unit, evaporative cooler or absorption unit for which a permit is required elsewhere in this code.	4.50	
	For each air-handling unit over 10,000 cfm.	7.50	
	For each evaporative cooler other than portable type.	4.50	
1	For each ventilation fan connected to a single duct.	3.00	3.00
	For each ventilation system which is not a portion of any heating or air-conditioning system authorized by a permit.	4.50	
	For the installation of each hood which is served by mechanical exhaust, including the ducts for such hood.	4.50	
	No. of openings		
	Ductwork		
	For each appliance or piece of equipment regulated by this code but not classed in other appliance categories, or for which no other fee is listed in this code.	4.50	
	When Chapter 22 is applicable (see Section 103), permit fees for fuel-gas piping shall be as follows: For each gas-piping system of one to four outlets.	2.00	
	For each gas-piping system of more than four outlets, per outlet.	.50	
OTHER INSPECTIONS AND FEES:			
	Inspections outside of normal business hours (minimum charge — two hours)	15.00 per hour	
	Reinspection fee assessed under provisions of Section 305 (1).	15.00 each	
	Inspections for which no fee is specifically indicated (minimum charge — one-half hour).	15.00 per hour	
	Additional plan review required by changes, additions or revisions to approved plans (minimum charge — one-half hour).	15.00 per hour	
	Misc.		
	TOTAL PERMIT FEE \$ <u>19.00</u>		

Mechanical permit fees may be computed the same as building permit fees by using the cost of installation for valuation amount when such work is not included in the above schedule.

I hereby certify that I have carefully examined and read the above application; that the same is true and correct; and that the work herein described is to be done in accordance with all the provisions of the applicable Ordinances of the City of Las Vegas, Nevada and the State Laws, whether herein specifically noted.

Approval for the work under this permit will be given only after refuse and debris have been removed from job site and public right of way.

City Master Card No. _____

SIGNER: Wicki S. Roberts Date 9-27-82
Air Conditioning Contractor - Owner

BUILDING DIVISION: C. Jones Date 10-4-82

PERMIT NO. 3914-10 PERMIT FEE \$ 19.00

121-2405

RECEIPT

CITY OF LAS VEGAS, NEVADA

DEPARTMENT OF BUILDING AND SAFETY—PLUMBING APPLICATION & PERMIT

PHONE NO. 454-2102

ADDRESS OF CONSTRUCTION: 1712 Goodrich Circle
 OWNER'S NAME: Metropolitan Development Corp.
 CIRCLE: Addition; Remodel; New Bldg. TYPE OF BLDG.: SFD APT. COMM. PUBLIC
 CONTRACTOR'S NAME: Imperial Plumbing, Inc. STATE LICENSE # 17916 CITY LICENSE # 12057

UNITS	DESCRIPTION	FEE	TOTAL
PERMIT ISSUANCE			
1	For Issuing Each Permit	10.00	10.00
	For Issuing Each Supplemental Permit	4.50	
FIXTURE CHARGE			
4	Bath, Shower, Lavatory, Toilet, Urinal	EA. 2.00	12.00
	Floor Drain, Floor Sink, Wash Tray, Sink	EA. 2.00	2.00
2	Garbage Disposal, Clothes Washer, Dishwasher (residential)	EA. 2.00	4.00
	Garbage Disposal (commercial)	EA. 8.00	
	Clothes Washer, Dishwasher (commercial)	EA. 2.00	
	Clothes Dryer (gas) (venting)	2.00	
	Dental Unit	2.00	
	Drinking Fountain	8.00	
	Refrigerator - Ice Maker, Water Dispenser	2.00	
	Any other water using equipment, Attached Coffee Makers, Ice Makers	2.00	
1	Hot Water Heater (Gas or Electric)	EA. 2.00	2.00
SEWER SYSTEM			
1	New, Replacement, Modification, or Any Drainage Work	10.00	10.00
	Grease or Sand Trap or Interceptor	2.00	
	Trailer Trap (rental parks)	5.00	
WATER SYSTEMS			
	Non Permanent Type (rental)	2.00	
	Permanent Type (connected to drain)	2.00	
SWIMMING POOLS			
	Private or Wading Pool (including spa)	20.00	
	Public or Semi-Public	30.00	
	Spas - Preformed (private)	10.00	
	Spas - Preformed (commercial)	20.00	
WATER DISTRIBUTION SYSTEM			
1	Single Family Dwelling	6.00	6.00
	Multi-Family Dwelling	6.00	
	Plus Each Dwelling Unit	3.00	
	Commercial Building per floor	3.00	
	Plus Each Unit (leased space or office)	2.00	
	Hotel or Motel	8.00	
	Plus Each Unit	3.00	
	Trailer Park	30.00	
	Plus Each Space	2.00	
	Irrigation	8.00	
FUEL PIPING SYSTEM			
1	Single Family Dwelling	6.00	6.00
	Multi-Family Dwelling	10.00	

UNITS	DESCRIPTION	FEE	TOTAL
	Plus Each Unit	2.00	
	Commercial Building (per floor)	6.00	
	Plus Each Unit (leased space or office)	6.00	
	Medium Pressure Gas System (plan check)	12.00	
4	Each Gas Appliance (any type)	2.00	8.00
	Standby Emergency (generating engines)	5.00	
	Steam Boilers	5.00	
	Service Station Fuel Tank and Piping System	10.00	
		10.00	
AUTOMATIC FIRE EXTINGUISHING SYSTEM			
	Underground Piping	20.00	
	Distribution Piping (per foot)	5.00	
	Sprinkler Head (each)	2.00	
	In-Range Hood and Vent	10.00	
	Standpipe System	75.00	
	Piping	2.00	
	Each Outlet	2.00	
	Wet Standpipe System	10.00	
	Piping	2.00	
	Fire Hose Cabinet	2.00	
SOLAR ENERGY SYSTEMS			
	Collectors (including piping) (per collector)	5.00	
	Storage Tanks (each)	5.00	
PIPELINE CONTRACT			
	For Onsite Sewer, Gas or Water Contract Value. Fee based on Building Code Permit Valuation Chart		
	Inspections for which no fee is specifically indicated (minimum charge - one half hour)	15.00 per hour	
	Additional plan review required by changes, additions or revisions to approved plans (minimum charge - one half hour)	15.00 per hour	
	Misc.		
TOTAL PERMIT FEE \$ 60.00			

Plumbing permit fees may be computed the same as building permit fees by using the cost of installation for valuation amount when such work is not included in the above schedule.

I hereby certify that I have carefully examined and read the above application; that the same is true and correct; and that the work herein described is to be done in accordance with all the provisions of the applicable Ordinances of the City of Las Vegas, Nevada and the State Laws, whether herein specified or not.

Approval for the work under this permit will be given only after refuse and debris have been removed from job site and public right of way.

CITY MASTER CARD NO. 5

SIGNED Metropolitan Development Corp. Date 9/29/82
 Registered Master Plumber, Spec. Contr. or Owner

BUILDING DIVISION 1000Date 9/29/82PERMIT NO. 3842-18PERMIT FEE \$ 60.00

=1721-2403

RECEIPT

Dona Hooley 10-15-82

CITY OF LAS VEGAS, NEVADA

DEPARTMENT OF BUILDING AND SAFETY - ELECTRICAL APPLICATION & PERMIT

PHONE NO. 732-1800

ADDRESS OF CONSTRUCTION: 1712 Goodrich Circ.

OWNER'S NAME: METROPOLITAN DEVELOPMENT

CIRCLE: Addition; Remodel; New Bldg. TYPE OF BLDG.: SFD APT. COMM. PUBLIC

CONTRACTOR'S NAME: ANDERSON ELECTRIC

STATE LICENSE # 10997 CITY LICENSE # 090-2-00350

UNITS	DESCRIPTION	FEE	TOTAL
PERMIT ISSUANCE			
1	For Issuing Each Permit	10.00	10.00
	Supplemental Fee	4.50	
APPLIANCE CHARGE			
40	Receptacle 26 Switch 14	.40	16.00
10	Each Light Fixture or Socket	.30	3.00
8	EACH OUTLET FOR: Dishwasher, Garbage Grinder, Trash Compactor, G.F.L., Clothes Washer, Dryer, Electric Range, Ovens, Smoke Detector, Special Purpose, Water Heater, Space Heater, Blast Coil Heater (PER K.W.), Mercury Lamp, Quartz Lamp, Sodium Lamp	.70	5.60
	X-Ray Unit	10.00	
	Area Lighting (First 3,000 Watts)	8.00	
	Each Additional 1,000 Watts	3.00	
	Motors (1/2 H.P. and Over) Transmitters Welders, Generators		
	First H.P. For each Unit	3.00	
	First KVA For Each Unit	.50	
	Each Additional H.P. or KVA	.30	
	Temporary Power or Pole	6.00	
1	Electric Service (Incl'd First Meter) Up to 200 AMP	6.00	6.00
	400 AMP And 600 AMP	12.50	
	Over 600 AMP To 1200 AMP	25.00	
	Over 1200 AMP	50.00	
	Each Additional Meter Socket	.50	

UNITS	DESCRIPTION	FEE	TOTAL
	Sub Panel (Each)	3.00	
	Swimming Pool (Residential)	20.00	
	Swimming Pool (Semi-Public)	30.00	
	Spas	8.00	
	Recreational Vehicle Spaces (Each)	3.00	
	Busways-Trolley or Plug-in (Ea. 100 Ft.)	3.00	
	All Misc. Electric		
1	Permanent A/C Unit (Pkg. Units)	3.00	3.00
	Each Air Handler	1.00	
LOW VOLTAGE INSTALLATIONS			
	Speaker Outlets (Each)	.30	
3	Signal or Alarm Outlets (Each)	.30	.90
	Amplifiers	2.00	
	Control Panel	.50	
	TV Master System	.30	
	Telephone or Computer Outlet	.30	
	Starter Permit		
	Contract Price or Cost of Installation		
	Misc.		
CONDUIT ONLY			
	TOTAL PERMIT FEE \$	44.50	

Electrical permit fees may be computed the same as building permit fees by using the cost of installation for valuation amount when such work is not included in the above schedule.

FOR BUILDING DEPARTMENT USE ONLY

Plans submitted: ☐ yes ☐ no	Occupancy type: _____	Type of Construction: _____	Square Footage: _____
Received by PAC: _____	Date: _____	Valuation (declared) \$ _____	
Review by Plans Check: _____	Date: _____	Fee calculated \$ _____	
Issued by: _____	Date: _____	Other Fees (226) \$ _____	
	Check ☐ Cash ☐	Total Fees \$ _____	

- Other inspections and fees:
1. Inspections outside of normal business hours = \$25.00 per hour (minimum charge two hours).
 2. Re-inspection fee during normal business hours assessed under provisions of TABLE 3-A of the Uniform Building Code = \$15.00 per hour.
 3. Inspections during normal business hours for which no fee is specifically indicated = \$15.00 per hour (minimum charge one-half hour).
 4. Additional plan review required by changes, additions or revisions to approved plans = \$15.00 per hour (minimum charge one-half hour).
 5. Expires 180 days after abandonment of work.

Approval for the work under this permit will be given only after refuse and debris have been removed from job site and public right of way.

RECEIPT

I hereby certify that I have carefully examined and read the above application; that the same is true and correct; and that the work herein described is to be done in accordance with all the provisions of the applicable Ordinances of the City of Las Vegas, Nevada and the State Laws, whether herein specified or not. City Master Card No. 27

SIGNED Dean Anderson Date 9/27/82
Master (Electrician) (Technician) (Owner)

BUILDING DIVISION

PERMIT NO. 4127-12 PERMIT FEE \$ 44.50

Dona 10-15-82

CITY OF LAS VEGAS, NEVADA

DEPARTMENT OF BUILDING AND SAFETY-ELECTRICAL APPLICATION & PERMIT

PHONE NO. 732-1800

ADDRESS OF CONSTRUCTION: 1712 Goodrich Circ.

OWNER'S NAME: METROPOLITAN DEVELOPMENT

CIRCLE: Addition; Remodel; New Bldg. TYPE OF BLDG.: SFD APT. COMM. PUBLIC

CONTRACTOR'S NAME: ANDERSON ELECTRIC

STATE LICENSE # 10997 CITY LICENSE # 090-2-00350

UNITS	DESCRIPTION	FEE	TOTAL
PERMIT ISSUANCE			
1	For Issuing Each Permit	10.00	10.00
	Supplemental Fee	4.50	
APPLIANCE CHARGE			
40	Receptacle 26 Switch 14	.40	16.00
10	Each Light Fixture or Socket	.30	3.00
8	EACH OUTLET FOR: Dishwasher, Garbage Grinder, Trash Compactor, G.F.L., Clothes Washer, Dryer, Electric Range, Ovens, Smoke Detector, Special Purpose, Water Heater, Space Heater, Blast Coil Heater (PER K.W.), Mercury Lamp, Quartz Lamp, Sodium Lamp	.70	5.60
	X-Ray Unit	10.00	
	Area Lighting (First 3,000 Watts)	8.00	
	Each Additional 1,000 Watts	3.00	
	Motors (1/2 H.P. And Over) Transformers Welders, Generators		
	First H.P. For each Unit	3.00	
	First KVA For Each Unit	.50	
	Each Additional H.P. or KVA	.30	
	Temporary Power or Pole	6.00	
1	Electric Service (Incl'd First Meter) Up to 200 AMP	6.00	6.00
	400 AMP And 600 AMP	12.50	
	Over 600 AMP To 1200 AMP	25.00	
	Over 1200 AMP	50.00	
	Each Additional Meter Socket	.50	

UNITS	DESCRIPTION	FEE	TOTAL
	Sub Panel (Each)	3.00	
	Swimming Pool (Residential)	20.00	
	Swimming Pool (Semi-Public)	30.00	
	Spas	8.00	
	Recreational Vehicle Spaces (Each)	3.00	
	Busways-Trolley or Plug-in (Ea. 100 Ft.)	3.00	
	All Misc. Electric		
1	Permanent A/C Unit (Pkg. Units)	3.00	3.00
	Each Air Handler	1.00	
LOW VOLTAGE INSTALLATIONS			
	Speaker Outlets (Each)	.30	
3	Signal or Alarm Outlets (Each)	.30	.90
	Amplifiers	2.00	
	Control Panel	.50	
	TV Master System	.30	
	Telephone or Computer Outlet	.30	
	Starter Permit		
	Contract Price or Cost of Installation		
	Misc.		
CONDUIT ONLY			
	TOTAL PERMIT FEE \$	44.50	

Electrical permit fees may be computed the same as building permit fees by using the cost of installation for valuation amount when such work is not included in the above schedule.

FOR BUILDING DEPARTMENT USE ONLY

Plans submitted: ☐ yes ☐ no

Occupancy type: _____

Type of Construction _____

Square Footage _____

Received by PAC: _____

Date: _____

Valuation (declared) \$ _____

Review by Plans Check: _____

Date: _____

Fee calculated \$ _____

Issued by _____

Date: _____

Other Fees (226) \$ _____

Check ☐ Cash ☐

Total Fees \$ _____

Other inspections and fees:

1. Inspections outside of normal business hours = \$25.00 per hour (minimum charge two hours).
2. Re-inspection fee during normal business hours assessed under provisions of TABLE 3-A of the Uniform Building Code = \$15.00 per hour.
3. Inspections during normal business hours for which no fee is specifically indicated = \$15.00 per hour (minimum charge one-half hour).
4. Additional plan review required by changes, additions or revisions to approved plans = \$15.00 per hour (minimum charge one-half hour).
5. Expires 180 days after abandonment of work.

Approval for the work under this permit will be given only after refuse and debris have been removed from job site and public right of way.

RECEIPT

I hereby certify that I have carefully examined and read the above application; that the same is true and correct; and that the work herein described is to be done in accordance with all the provisions of the applicable Ordinances of the City of Las Vegas, Nevada and the State Laws, whether herein specified or not. City Master Card No. 27

SIGNED _____

Date 9/27/82

Master (Electrician) (Technician) (Owner)

BUILDING DIVISION _____

Date 10/13/82

PERMIT NO. 4127-12

PERMIT FEE \$ 44.50

2360-2402 (3/82)

30-60-
CITY OF LAS VEGAS, NEVADA

LOG NO. & AREA

DEPARTMENT OF BUILDING AND SAFETY

CONST. VAL. \$

APPLICATION & BUILDING PERMIT - for:
Fence, Wall, Retaining Wall.

ADDRESS OF
CONSTRUCTION:

1712 *Hardwick Ave*

OWNER:

Mr. [Signature]

LOT(s) *53*

BLOCK *1*

SUBDIVISION

Park Vista #2

ZONE *RPD14*

Materials of Construction:

Block ☐

Concrete ☐

Wire ☐

Wood ☒

Other ☐

Yes No

ARCHITECT:

ENGINEER:

PLANS: ☐ ☐

CALCS: ☐ ☐

CONTRACTOR:

Feldman Fencing

STATE

LICENSE # *5906A*

CITY

LICENSE # *415062*


Remarks:

TOTAL SQUARE FEET:

TOTAL LINEAL FEET: *8*

CONDITIONS OF THE PERMIT:

1. Any type of retaining wall must be engineered by a Civil or Structural Engineer.
2. If a home owner takes out the Building Permit and if the owner sublets the work to a Contractor, then the Contractor must take out the permit and pay for it.
3. No fence or wall can be built on City property or rights-of-way, but this is not intended to preclude construction within utility easements if utilities will not be damaged or made inaccessible.
4. The fence or wall shall not enclose any water meter, light standard, or fire alarm box and shall not come closer than 24" from the nearest fire hydrant outlet.
5. Department Inspectors must approve footings before concrete is poured and block wall reinforcing before grouting is done.
6. Maximum height of any wall or fence is 6', side and rear yards; 4' maximum in front yard with the vertical surface above the height of 2' 50% open.
7. I must not obstruct required onsite parking space (2 spaces for each dwelling unit) by the erection of this fence or wall.
8. By the signing of this application I herewith agree to the requirements outlined above.

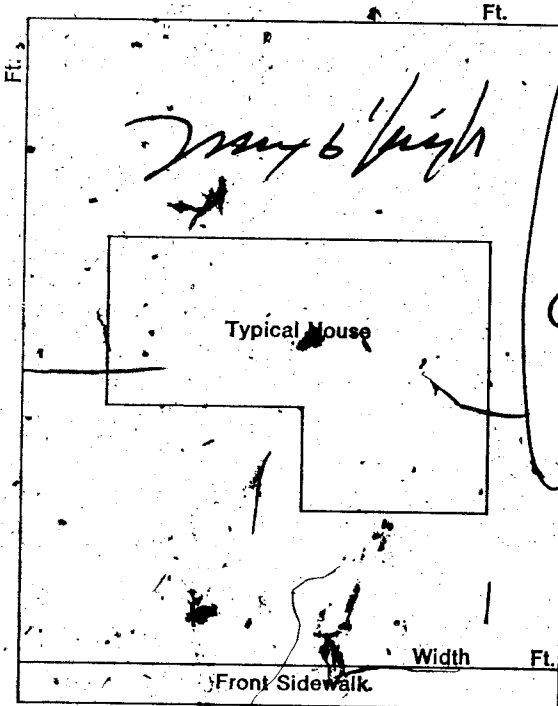

SIGNED:

CONTRACTOR ☒

AGENT ☐

OWNER ☐

DATE:

12/10/82

PLANNING DEPT:

[Signature]

Date:

12/10/82

PUBLIC WORKS DEPT:

W. [Signature]

Date:

12/16/82

BUILDING DIVISION:

Dave

Date:

12/10/82

PERMIT NO:

5455-18

PERMIT FEE \$

10.00

REIPT

MUST BE MACHINE VALIDATED

Donna P. [unclear] 4-6-83

OWNER Metropolitan Dev. ADDRESS 1712 Goodrich Cir.	
DATE 8/16/82	GEN. CONT. Same
TYPE OF STRUCTURE SFD W/FP	PERMIT NO. 2868-18
L-53 B-1 PARK VILLA #	FINAL INSPECTION
LEGAL DESCRIPTION	LOG NO.
APPROVED FOR OCCUPANCY & METER	T-18-3
BUILDING	
Investigation	Plumbing Cont. Imperial
Location & Footing CM 9-22-82	Permit No. 3842 Date 10-4-82
Concrete Slab Floor CM 9-30-82	Heat & Vent. A/C Cont. Duality
Fireplace Footing	Permit No. 3914-10 Date 11-4-82
Chimney Steel	Sewer Cont. Metropolitan Dev
Vert. Steel Reinf.	Permit No. 2867 Date 8/16/82
Horiz. Steel Reinf.	Rough Soil 2-29-82
Framing RB 10-22-82	Rough Water
Ext. Lath TR 10-29-82	Top-Out 2-2 10-21-82
Ext. Brown CM 11-9-82	Rough Gas 9-5 10-21-82
Drywall TR 10-29-82	A/C Rough Duct 9-5 10-21-82
Final Building CM 12-2-82	Final Plumbing 9-5 12-2-82
Appr. for Occu. CM 12-2-82	Final Gas 9-5 12-2-82
ELECTRICAL	
Temp. Pole Cont.	Final Air Cond 9-5 12-2-82
Permit No.	Date
Inspection	Date
Electrical Cont. [unclear]	
Permit No. 4271-2	Date 10-13-82
Rough 11-4 10-22-82	PLEASE NOTE ADDITIONAL REMARKS ON REVERSE SIDE.
Final Rough	DEPT. OF BLDG. & SAFETY
Final Electrical 11-30-82	CITY OF LAS VEGAS
Temporary Service	REV: 82-3-88

Don't Forget

4-6-83





2868-18

Donna F. Hensley

7-1-83

FENCES & RETAINING WALLS		
Contractor: Metro. Dev.		Date: 12-15-82
Address: 1712 Goodrich Cir.		
Contractor: Fortune Fence.	Phone No: 5455-18	Final Inspection
Lot: 53	Block: 1	Subdivision: Park Vista
Lot:	Area:	
FENCES (wire, wood, block, & retaining walls)		
1	Location: CM 12-20-82	
2	Footings: CM 12-20-82	
3	Wall Steps	
	1st	2nd
4	Bond Steps	
	1st	2nd
5	Final: CM 5-2-83	
Specify Type Of Fence		
2-1-83 DIV. OF BLDG. & SAFETY CITY OF LAS VEGAS REV. 10-78		

William Francis, 9-17-84

CITY OF LAS VEGAS, NEVADA

1,935
1300-28

LOG NO. & AREA

DATE

CONST. VAL. \$

DEPARTMENT OF BUILDING AND SAFETY
PHONE 386-6251

DEVELOPMENT PERMIT AND BUILDING PERMIT
FOR: Fence, Wall, Retaining Wall

ADDRESS OF
CONSTRUCTION

1712 Goodrich CR.

OWNER

EDWARD & K. LOCKWOOD

CONTRACTOR

Owner

STATE
LICENSE NO.

CITY
LICENSE NO.

LOT(s)

58

BLOCK

BLA

SUBDIVISION

Risk Vista #32

ZONE: R-CU

PROPOSED CONSTRUCTION:

BUILDING
PERMIT NO.

1858

ENGINEER

Approval for the work under this permit will be given only after refuse and debris have been removed from job site and public right of way.

TOTAL SQUARE FEET


774

TOTAL LINEAL FEET:

Remarks:

Remarks section with lines for notes.

Lorenzi R. Fl.

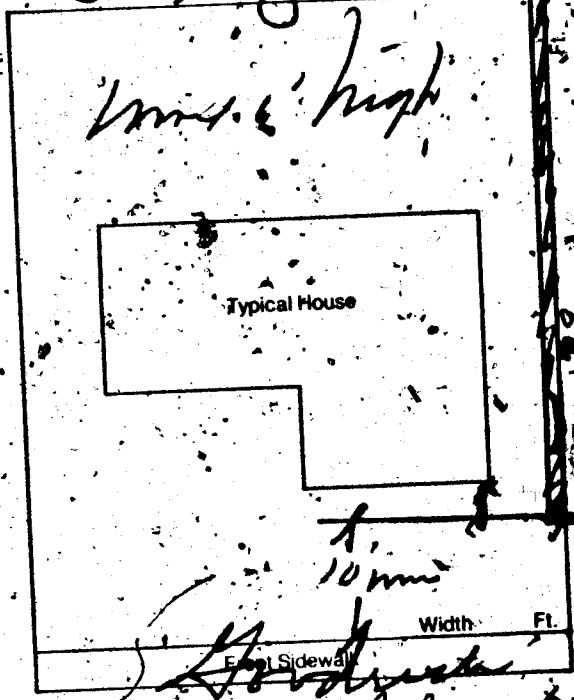

OTHER INSPECTIONS AND FEES

- 1. Inspections outside of normal business hours = \$25.00 per hour (minimum charge three hours).
- 2. Re-inspection fee during normal business hours assessed under provisions of TABLE 3-A of the Uniform Building Code = \$15.00 each.
- 3. Inspections during normal business hours for which no fee is specifically indicated = \$15.00 per hour (minimum charge one half hour).
- 4. Additional plan review required by changes, additions or revisions at approved plans = \$25.00 per hour (minimum charge two hours).

ID 553-66-6508

CONDITIONS OF THE PERMIT:

- 1. Any type of retaining wall must be engineered by a Civil or Structural Engineer.
- 2. If a home owner takes out the Building Permit and if the owner sublets the work to a Contractor, then the Contractor must take out the permit and pay for it.
- 3. No fence or wall can be built on City property or rights-of-way, but this is not intended to preclude construction within utility easements if utilities will not be damaged or made inaccessible.
- 4. The fence or wall shall not enclose any water meter, light standard, or fire alarm box and shall not come closer than 24" from the nearest fire hydrant outlet.
- 5. Department inspectors must approve footings before concrete is poured and block wall reinforcing before grouting is done.
- 6. Maximum height of any wall or fence is 6' side and rear yards, 4' maximum in front yard with the vertical surface above the height of 2' - 50% open.
- 7. I must not obstruct required onsite parking space (2 spaces for each dwelling unit) by the erection of this fence or wall.
- 8. By the signing of this application I herewith agree to the requirements outlined above.

Wall must conform to CCV Specs

SIGNED

PLANNING DEPT.

BUILDING DEPT.

CONTRACTOR - AGENT - OWNER

9/17/84

DATE

PLAN
REVIEW
FEE

PERMIT
FEE

TOTAL
FEES 32.50

I hereby certify that I have reviewed this application and the proposed plans and have found that the proposed development meets the requirements of the City of Las Vegas Flood Hazard Reduction Ordinance for the issuance of this Development Permit.

LAND DEVELOPMENT AND FLOOD CONTROL ENGINEER

DATE

383

Permit Expires 180 Days After Abandonment of Work.

RECEIPT

0004

WALL 32.50
CHK 32.50
1858A000 13:47

09/17/84

MUST BE MACHINE VALIDATED