5817 Gowan Blvd

L100 B3 Twin Lakes Village Unit 14-B Zone R-1

Sharon Perez May 18 1979

CITY OF LAS VEGAS, NEVADA

LOG NO. & AREA: T-44-3 CONST. VAL. $ 33220

DEPARTMENT OF PUBLIC SERVICES
DIVISION OF BUILDING AND SAFETY

APPLICATION & BUILDING PERMIT for:
Dwellings, Duplexes, Misc. Residential Const.

ADDRESS OF CONSTRUCTION: 5817 Gowan Boulevard OWNER: First Western Savings Association

LOT: 100 BLOCK: 3 SUBDIVISION: Twin Lakes Village Unit 1-B ZONE: R-1

Existing structure on lot: Dwelling ☐ Accessory Bldgs. ☐ Vacant Lot ☒ Other ☐

PROPOSED CONSTRUCTION: Single Family Dwelling - New With Fireplace USE: Residential

MATERIALS OF CONSTRUCTION: Wood Frame ☒ Concrete Block ☐ Reinforced Concrete ☐ Steel Frame ☐

SQUARE FEET OF FLOOR AREAS: 1st 1,437 2nd 3rd Other 418 TOTAL SQ. FT. 1855

FIRE ZONE: 3 Occupancy Group R3 + M1 CONST. TYPE: V-N

ARCHITECT: Stanton Construction ENGINEER: NO. of UNITS: 1 NO. of STORIES: 1

Plans Submitted: Yes ☒ No ☐ Calculations Submitted: Yes ☐ No ☒ Sewer Fee Req'd: Yes ☒ No ☐

CONTRACTOR: Stanton Construction, Inc. STATE LICENSE # 12947A CITY LICENSE # C11 18086

ADD'L. PERMITS REQ'D: Air Cond. ☒ Elec. ☒ Plumbing ☒ Signs ☐ Paving ☐ Fence ☐ Public Walks ☐ Curb-gutters ☐ Incinerators ☐ Fire Sprinkling System ☐

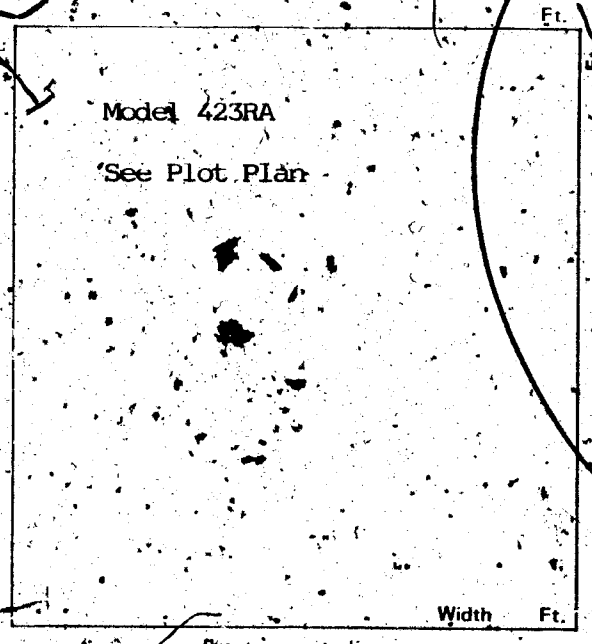

CONDITIONS OF THE PERMIT:

1. I agree to call the City Building Department for inspections before concrete is poured, before rough wiring, electrical, plumbing, framing is covered. Also for Air conditioning, drywall and sheathing inspection.
2. I agree that when the job is completed that I will call for final inspection before occupancy.
3. I agree to perform all construction in accordance with City Ordinances and Building Codes.
4. The Contractor's signature below denotes authority from the owner to sign in his behalf and that the owner is aware of all requirements of this application and permit. Separate permits must be taken out for work outlined above this agreement.
5. I have read and understand the contents of this application and permit. I hereby state that the information I have supplied on this application is true and correct.

Approval for the work under this permit will be given only after refuse and debris have been removed from job site and public right of way

SIGNED: Stanton Construction, Inc. Contractor

BY: [signature] Agent or Owner

Donald L. Wylie, General Manager

PLANNING DEPT: [signature] Date: 10-26-78

PUBLIC WORKS DEPT.: Tuck Date: 10/27/78

BUILDING DIVISION: RCS Date: 11-2-78

PERMIT NO.: 11124-173 PERMIT FEE $: 144.00

154-01-220

RECEIPT

MUST BE MACHINE VALIDATED

Sharon Teresia May 15 1994

CITY OF LAS VEGAS, NEVADA

DEPARTMENT OF PUBLIC SERVICES – AIR CONDITIONING APPLICATION & PERMIT

DIVISION OF BUILDING AND SAFETY

ADDRESS OF CONSTRUCTION: 5817 Gowan Blvd.

OWNER'S NAME: Stanton Construction, Inc.

CIRCLE: Addition; Remodel; New Bldg; TYPE OF BLDG.: SFD APT. COMM. PUBLIC

CONTRACTOR'S NAME: Central Air Conditioning STATE LICENSE # 11997 CITY LICENSE # 00057

UNITS	DESCRIPTION	FEE	TOTAL
	Unit heater – floor, wall or suspended	4.00	
	FOR EACH FORCED-AIR OR GRAVITY-TYPE FURNACE OR BURNER INCLUDING DUCTS AND VENT ATTACHED TO SUCH APPLIANCES:		
	Up to and including 100,000 B.t.u.'s	4.00	
	Over 100,000 B.t.u.'s	6.00	
	FOR EACH HEATING APPLICATION, REFRIGERATION UNIT, COMFORT COOLING AND HEATING UNIT, ABSORPTION UNIT, COMPRESSOR OR BOILER:		
1-3½	Up to and including 3 ton or horsepower, or absorption system up to and including 100,000 B.t.u.'s	4.00	4.00
	Over 3 ton or 3 horsepower up to and including 10, or absorption system over 100,000 B.t.u.'s up to and including 250,000 B.t.u.'s	7.00	
	Over 10 ton or 10 horsepower up to and including 30, or absorption system over 250,000 B.t.u.'s up to and including 1,000,000 B.t.u.'s	12.00	
	Over 30 ton or 30 horsepower up to and including 50, or absorption system over 1,000,000 B.t.u.'s up to and including 1,700,000 B.t.u.'s	20.00	
	Over 50 ton or 50 horsepower, or absorption system over 1,700,000 B.t.u.'s	30.00	
	FOR EACH AIR HANDLING UNIT INCLUDING DUCTS, ATTACHED THERETO:		
	Up to and including 10,000 CFM	2.00	
	Over 10,000 CFM	4.00	

UNITS	DESCRIPTION	FEE	TOTAL
	EVAPORATIVE COOLERS:		
	5 outlets or under	3.00	
	Over 5 and up to and including 10	5.00	
	Each additional outlet over 10	.25	
	VENTILATION:		
	For each fan connected to a single duct	1.00	
	For each commercial or industrial ventilation system	5.00	
	For each commercial kitchen hood	5.00	
	MISCELLANEOUS:		
	For each water cooling tower	8.00	
	Duct work only – each opening	.25	
	For installation or relocation of each commercial or industrial incinerator	15.00	
	Gas piping related to the air cond. work in single family dwelling only	3.00	
	For each appliance, piece of equipment, any mechanical work or alteration or replacement not included in this schedule, the permit fee shall be computed the same as building permit fees by using the cost of installation for the valuation amount.		
	FOR THE ISSUANCE OF EACH PERMIT		3.00
	TOTAL PERMIT FEE $		7.00

I hereby certify that I have carefully examined and read the above application; that the same is true and correct; and that the work herein described is to be done in accordance with all the provisions of the applicable Ordinances of the City of Las Vegas, Nevada and the State Laws, whether herein specified or not.

Approval for the work under this permit will be given only after refuse and debris have been removed from job site and public right of way.

SIGNED A. McDonald Date 12/12/78
Air Conditioning Contractor Owner

BUILDING DIVISION B.D. Date 12-12-78

PERMIT NO. 11546 PERMIT FEE $ 7.00

154-01-224

#12890

RECEIPT

MUST BE MACHINE VALIDATED

Sharon Pereira May 18 1979

CITY OF LAS VEGAS, NEVADA

DEPARTMENT OF PUBLIC SERVICES—APPLICATION AND PERMIT FOR PLUMBING
DIVISION OF BUILDING AND SAFETY

ADDRESS OF CONSTRUCTION: 5817 Gowan Blvd. OWNER'S NAME: Stanton Construction, Inc.

CIRCLE: New Bldg. Add'n.; Remodel; TYPE OF BLDG.: SFD APT. PUBLIC COMM.

CONTRACTOR'S NAME: Mojave Plumbing, Inc. STATE LICENSE # 10312A CITY LICENSE # 12057

UNITS	DESCRIPTION	FEE	TOTAL
1	Bathtub	1.00	1.00
1	Shower	1.00	1.00
2	Lavatory	1.00	2.00
2	Toilet	1.00	2.00
	Urinal	1.00	
	Floor Drain	1.00	
	Floor Sink	1.00	
	Wash Tray	1.00	
1	Sink	1.00	1.00
1	Garbage Disposal	1.00	1.00
	Garbage Disposal (comm.)	3.00	
1	Clothes Dryer (gas)	1.00	1.00
1	Clothes Washer	1.00	1.00
	Clothes Washer (comm.)	5.00	
1	Dishwasher	1.00	1.00
	Dishwasher (commercial)	5.00	
	Dental Unit	10.00	
	Drinking Fountain	1.00	
	Any Water using Equipment	1.00	
1	Water Heater (gas) (elect.)	1.00	1.00
1	Sewer System - New, Replacement, or any Drainage System	4.00	4.00
	Grease or Sand Trap	2.00	
	Trailer Trap	2.00	
	Septic Disposal System	4.00	
	WATER SOFTENERS		
	Nonpermanent Type	4.00	
	Permanent Type (connected to Drainage)	5.00	
	SWIMMING POOLS		
	Private or Wading Pool	10.00	
	Public or Semi public	20.00	

UNITS	DESCRIPTION	FEE	TOTAL
	WATER DISTRIBUTION SYSTEM		
1	Single Family Dwelling	4.00	4.00
	Multiple Family Dwelling	4.00	
	plus each unit	2.00	
	Commercial Bldg. per floor	6.00	
	Hotel or Motel	4.00	
	plus each bath	1.50	
	Trailer Park	20.00	
	plus each space	1.00	
	Irrigation	4.00	
	GAS PIPING SYSTEM		
1	Single Family Dwelling	3.00	3.00
	Multiple Family Dwelling	6.00	
	plus each unit	1.00	
	Commercial Bldg. per floor	3.00	
	plus each unit	3.00	
2	Gas Appliance (any type)	1.00	2.00
	AUTOMATIC FIRE EXTINGUISHING SYSTEM		
	Underground Piping	10.00	
	Distribution Piping ea. ft.	.01	
	Sprinkle. Head each	.10	
	In Range Hood and Vent	5.00	
	DRY STANDPIPE SYSTEM		
	Piping	50.00	
	Each Outlet	1.00	
	WET STANDPIPE SYSTEM		
	Piping	5.00	
	Fire Hose Cabinet	1.00	
	MINIMUM PERMIT FEE	4.00	
	PIPELINE CONTRACTOR, SEC. 14 B.P.F. $		
	TOTAL PERMIT FEE $		25.00

I hereby certify that I have carefully examined and read the above application, that the same is true and correct, and that the work herein described is to be done in accordance with all the provisions of the applicable Ordinances of the City of Las Vegas, Nevada and the State Laws whether herein specified or not.

Approval for the work under this permit will be given only after refuse and debris have been removed from job site and public right of way.

Signed Thomas L Wallace Date:
Registered Master Plumber, Spec. Cont'r, or Owner

Building Division: B.D. Date: 11-30-78

Permit No. 11249-6 Permit Fee $ 25.00

154-01-222

RECEIPT

MUST BE MACHINE VALIDATED

Sharon Pereira May 18 1979

CITY OF LAS VEGAS, NEVADA

DEPARTMENT OF PUBLIC SERVICES—APPLICATION AND PERMIT FOR PLUMBING
DIVISION OF BUILDING AND SAFETY

ADDRESS OF CONSTRUCTION: 5817 Gowan Blvd. OWNER'S NAME: Stanton Construction, Inc.

CIRCLE: New Bldg. Add'n. Remodel TYPE OF BLDG.: SFD APT. PUBLIC COMM.

CONTRACTOR'S NAME: Mojave Plumbing, Inc. STATE LICENSE # 10312A CITY LICENSE # 12057

UNITS	DESCRIPTION	FEE	TOTAL
1	Bathtub	1.00	1.00
1	Shower	1.00	1.00
2	Lavatory	1.00	2.00
2	Toilet	1.00	2.00
	Urinal	1.00	
	Floor Drain	1.00	
	Floor Sink	1.00	
	Wash Tray	1.00	
1	Sink	1.00	1.00
1	Garbage Disposal	1.00	1.00
	Garbage Disposal (comm.)	3.00	
1	Clothes Dryer (gas)	1.00	1.00
1	Clothes Washer	1.00	1.00
	Clothes Washer (comm.)	5.00	
1	Dishwasher	1.00	1.00
	Dishwasher (commercial)	5.00	
	Dental Unit	10.00	
	Drinking Fountain	1.00	
	Any Water using Equipment	1.00	
1	Water Heater (gas) (elect.)	1.00	1.00
1	Sewer System - New, Replacement, or any Drainage System	4.00	4.00
	Grease or Sand Trap	2.00	
	Trailer Trap	2.00	
	Septic Disposal System	4.00	
	WATER SOFTENERS		
	Nonpermanent Type	4.00	
	Permanent Type (connected to Drainage)	5.00	
	SWIMMING POOLS		
	Private & Wading Pool	10.00	
	Public or Semi public	20.00	

UNITS	DESCRIPTION	FEE	TOTAL
	WATER DISTRIBUTION SYSTEM		
1	Single Family Dwelling	4.00	4.00
	Multiple Family Dwelling	4.00	
	plus each unit	2.00	
	Commercial Bldg. per floor	6.00	
	Hotel or Motel	4.00	
	plus each bath	1.50	
	Trailer Park	20.00	
	plus each space	1.00	
	Irrigation	4.00	
	GAS PIPING SYSTEM		
1	Single Family Dwelling	3.00	3.00
	Multiple Family Dwelling	6.00	
	plus each unit	1.00	
	Commercial Bldg. per floor	3.00	
	plus each unit	3.00	
2	Gas Appliance (any type)	1.00	2.00
	AUTOMATIC FIRE EXTINGUISHING SYSTEM		
	Underground Piping	10.00	
	Distribution Piping ea. ft.	.01	
	Sprinkle. Head each	.10	
	In Range Hood and Vent	5.00	
	DRY STANDPIPE SYSTEM		
	Piping	50.00	
	Each Outlet	1.00	
	WET STANDPIPE SYSTEM		
	Piping	5.00	
	Fire Hose Cabinet	1.00	
	MINIMUM PERMIT FEE	4.00	
	PIPELINE CONTRACTOR, SEGT. 14 B.P.F. $		
	TOTAL PERMIT FEE $		25.00

I hereby certify that I have carefully examined and read the above application, that the same is true and correct, and that the work herein described is to be done in accordance with all the provisions of the applicable Ordinances of the City of Las Vegas, Nevada and the State Laws whether herein specified or not.

Approval for the work under this permit will be given only after refuse and debris have been removed from job site and public right of way.

Signed Thomas L Walker Date:
Registered Master Plumber, Spec. Cont'r, or Owner

Building Division: B.D. Date: 11-30-78

Permit No. 11249-6 Permit Fee $ 25.00

154-01-222

RECEIPT

MUST BE MACHINE VALIDATED

Transit Sheet May 18, 1979

CITY OF LAS VEGAS, NEVADA

DEPARTMENT OF PUBLIC SERVICES—ELECTRICAL APPLICATION & PERMIT
DIVISION OF BUILDING AND SAFETY

ADDRESS OF CONSTRUCTION: 5817 Gowan Boulevard

OWNER'S NAME: Stanton Const.

CIRCLE: New Bldg. Add'n. Remodel. TYPE OF BLDG.: SFD. APT. PUBLIC COMM.

CONTRACTOR'S NAME: ABC ELECTRIC

STATE LICENSE # 13214

CITY LICENSE # 09893

NUMBER	FIXTURE OR INSTALLATION	UNIT PRICE	TOTAL
	Rm addition, carport or garage enclosure	4.00	
	Temporary power	4.00	
63	Light, receptacle or switch outlet	.20	12.60
	Wall or ceiling space heater	.35	
1	Garbage grinder outlet	.35	.35
1	Dishwasher outlet	.35	.35
	Clothes dryer outlet	.35	
1	Automatic clothes washer	.35	.35
	Electric range outlet	.35	
	Electric water heater outlet	.35	
	Special purpose outlet	.35	
	X-ray unit and its appurtenances	5.00	
	Watts of festoon lighting (Watts) First 3,000 watts for each additional thousand watts	4.00 1.50	
	Horsepower each motor first horsepower or less for each additional horsepower	1.75 .35	
1	Electric service (including any single meter socket) for each additional socket	3.00 .35	3.00
	Air conditioning service	1.50	.50
	Each KW(KVA) Generator (Transformer; Welder) First 100 KVA for each additional KW(KVA)	2.00 .01	
	Speaker, signal or alarm outlet	.15	
	Amplifiers	.50	
	Control panels	.25	
	Main control racks	1.00	
	T.V. and radio antennas-master system only	.75	
	Minimum fee for any permit	4.00	
	TOTAL FEE		~~16.65~~ 18.15

Approval for the work under this permit will be given only after refuse and debris have been removed from job site and public right of way.

I hereby certify that I have carefully examined and read the above application; that the same is true and correct; and that the work herein described is to be done in accordance with all the provisions of the applicable Ordinances of the City of Las Vegas, Nevada and State laws whether herein specified or not.

SIGNED Patricia Y. Barnum DATE 1-26-79
MASTER (ELECTRICIAN) (TECHNICIAN) (OWNER)

BUILDING DIVISION: BO DATE 1-30-79

PERMIT NO. 0641-4 PERMIT FEE $ 18.15

RECEIPT

MUST BE MACHINE VALIDATED

154-01-221

Stanton Const. May 18, 1979

CITY OF LAS VEGAS, NEVADA

DEPARTMENT OF PUBLIC SERVICES—ELECTRICAL APPLICATION & PERMIT
DIVISION OF BUILDING AND SAFETY

ADDRESS OF CONSTRUCTION: 5817 Gowan Boulevard

OWNER'S NAME: Stanton Const.

CIRCLE: New Bldg. Add'n. Remodel. TYPE OF BLDG.: SFD. APT. PUBLIC COMM.

CONTRACTOR'S NAME: ABC ELECTRIC

STATE LICENSE # 13214

CITY LICENSE # 09893

NUMBER	FIXTURE OR INSTALLATION	UNIT PRICE	TOTAL
	Rm addition, carport or garage enclosure	4.00	
	Temporary power	4.00	
63	Light, receptacle or switch outlet	.20	12.60
	Wall or ceiling space heater	.35	
1	Garbage grinder outlet	.35	.35
1	Dishwasher outlet	.35	.35
	Clothes dryer outlet	.35	
1	Automatic clothes washer	.35	.35
	Electric range outlet	.35	
	Electric water heater outlet	.35	
	Special purpose outlet	.35	
	X-ray unit and its appurtenances	5.00	
	Watts of festoon lighting (Watts) First 3,000 watts for each additional thousand watts	4.00 1.50	
	Horsepower each motor first horsepower or less for each additional horsepower	1.75 .35	
1	Electric service (including any single meter socket) for each additional socket	3.00 .35	3.00
	Air conditioning service	1.50	1.50
	Each KW(KVA) Generator (Transformer; Welder) First 100 KVA for each additional KW(KVA)	2.00 .01	
	Speaker, signal or alarm outlet	.15	
	Amplifiers	.50	
	Control panels	.25	
	Main control racks	1.00	
	T.V. and radio antennas-master system only	.75	
	Minimum fee for any permit	4.00	
	TOTAL FEE		~~16.65~~ 18.15

Approval for the work under this permit will be given only after refuse and debris have been removed from job site and public right of way.

I hereby certify that I have carefully examined and read the above application; that the same is true and correct; and that the work herein described is to be done in accordance with all the provisions of the applicable Ordinances of the City of Las Vegas, Nevada and State laws whether herein specified or not.

SIGNED Patricia Y. Barnum DATE 1-26-79
MASTER (ELECTRICIAN) (TECHNICIAN) (OWNER)

BUILDING DIVISION: BQ DATE 1-30-79

PERMIT NO. 0641-4 PERMIT FEE $ 18.15

RECEIPT

MUST BE MACHINE VALIDATED

154-01-221

V. Pollard 8-23-77

CITY OF LAS VEGAS, NEVADA

LOG NO. & AREA: _____ CONST. VAL. $ 705.00

DEPARTMENT OF PUBLIC SERVICES
DIVISION OF BUILDING & SAFETY

APPLICATION & BUILDING PERMIT – for: Fence, Wall, Retaining Wall.

ADDRESS OF CONSTRUCTION: 5817 Garson Rd. OWNER: Jeff Gates

LOT(s) 100 BLOCK 3 SUBDIVISION [illegible] 14-B ZONE: R-1

Materials of Construction: Block ☒ Concrete ☐ Wire ☐ Wood ☐ Other ☐

	Yes	No
PLANS:	☐	☐
CALCS:	☐	☐

ARCHITECT: _____ ENGINEER: _____

CONTRACTOR: owner STATE LICENSE # _____ CITY LICENSE # _____

TOTAL SQUARE FEET: 282 TOTAL LINEAL FEET: 47

Remarks:

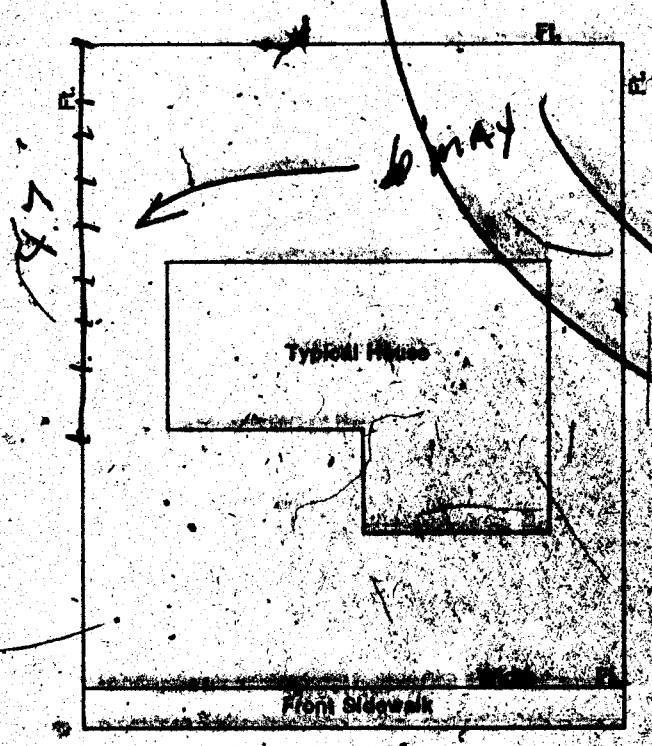

CONDITIONS OF THE PERMIT:

1. Any type of retaining wall must be engineered by a Civil or Structural Engineer.
2. If a home owner takes out the Building Permit and if the owner sublets the work to a Contractor then the Contractor must take out the permit and pay for it.
3. No fence or wall can be built on City property or rights-of-way, but this is not intended to preclude construction within utility easements if utilities will not be damaged of made inaccessible.
4. The fence or wall shall not enclose any water meter, light standard, or fire alarm box and shall not come closer than 24" from the nearest fire hydrant outlet.
5. Department Inspectors must approve footings before concrete is poured and block wall reinforcing before grouting is done.
6. Maximum height of any wall or fence is 6' side and rear yards; 4' maximum in front yard with the vertical surface above the height of 2' — 50% open.
7. I must not obstruct required onsite parking spaces (2 spaces for each dwelling unit) by the erection of this fence or wall.
8. By the signing of this application I hereby agree to the requirements outlined above.

1LUBA $ .00
WALL $ 9.00
STL $ 9.00
TOTL $ 9.00
CHEK $ 9.00
R06324 SR#001/01
CITY – LAS VEGAS
BLDG. & SAFETY
08/16/79

SIGNED: Jeff Gates DATE: _____
CONTRACTOR ☐ AGENT ☐ OWNER ☐

PLANNING DEPT: _____ Date: 16 Aug 79
PUBLIC WORKS DEPT: [illegible] Date: 8-16-79
BUILDING DIVISION: [illegible] Date: 8/16/79
#12050 PERMIT NO: 16324 Permit Fee $ 9.00

RECEIPT

MUST BE MACHINE VALIDATED

L. Collins 2-24-82

OWNER First Western Savings ADDRESS 5817 Gowan Rd.

DATE 11-29-78 GEN. CONT. Stanton Const.

TYPE OF STRUCTURE SFD PERMIT NO. 111.24-17 FINAL INSPECTION

LEGAL DESCRIPTION New W/F.P. L-100 B-3 LOG # T44-3 AREA #

APPROVED FOR OCCUPANCY & METER Twin Lakes Village Unit 14-B

BUILDING	MECHANICAL
Investigation	Plumbing Cont. Murphy
Location & Footing EC 12-28-78	Permit No. 249-8 Date 11-30-78
Concrete Slab Floor EC 12-28-78	Heat & Vent. A/C Cont.
Fireplace Footing	Permit No. 11546-16 Date 12-12-78
Chimney Steel EC 2-15-79	First Western Savings Assoc.
Vert. Steel Reinf.	Sewer Cont.
Horiz. Steel Reing. EC 12-28-78	Permit No. 11123 Date 1-22-78
Roof Sheath. EC 1-31-79	Rough Soil JL 12-22-78
Framing EC 2-14-79	Rough Water
Ext. Lath JL 2-16-79	Top-Out JL 2-13-79
Ext. Brown EC 2-26-79	Rough Gas JL 2/13/79
Drywall EC 2-26-79	A/C Rough Duct JL 2/13/79
Final Building EC 4-16-79	Final Plumbing
Appr. for Occu. EC 4-16-79	Final Gas JL 4-12-79
ELECTRICAL	Final Air Cond. JL 4-12-79
Temp. Pole Cont.	Final Sewer MC 2-16-79
Permit No. Date	REMARKS
Inspection Date	Insulation: JL 2-16-79
Electrical Cont. A B C	
Permit No. 3641-4 Date 1-30-79	
Rough CW 2-16-79	PLEASE NOTE ADDITIONAL REMARKS ON REVERSE SIDE.
Final Rough	DIV. OF BLDG. & SAFETY CITY OF LAS VEGAS REV. 10-78
Final Electrical JL 4-12-79	2-1-31
Temporary Service	

E-Z-WAY SYSTEMS © NEWARK OH 43055 LITHO IN U.S.A.

	2-12-79	DATE
	PERMIT NO. 6324	FINAL INSPECTION Blk wall
BLOCK		SUBDIVISION
	3 Twin Lakes Village unit 14-B	
	AREA	

Final wood, block, & retaining walls

Inspect UHF 3-1-79

2nd

2nd

L. Collins 2-24-8

ent smith EE 2.26.79

pir# 11124-17

Don Tinsley 11-16-82

CITY OF LAS VEGAS, NEVADA

LOG NO. & AREA _____ CONST. VAL. $ 560.00

DEPARTMENT OF PUBLIC SERVICES
DIVISION OF BUILDING AND SAFETY

APPLICATION & BUILDING PERMIT — for:
Dwellings, Duplexes, Misc. Residential Const.

ADDRESS OF CONSTRUCTION: 5817 Gawain Rd OWNER: Charles Fay


Existing structure on lot: Dwelling ☐ Accessory Bldgs. ☐ Vacant Lot ☐ Other ☐

PROPOSED CONSTRUCTION: Gazebo & Deck 10X14 USE: _____

MATERIALS OF CONSTRUCTION: Wood Frame ☐ Concrete Block ☐ Reinforced Concrete ☐ Steel Frame ☐

SQUARE FEET OF FLOOR AREAS: 1st _____ 2nd _____ 3rd _____ Other _____ TOTAL SQ. FT. _____

FIRE ZONE: _____ Occupancy Group _____ CONST. TYPE: _____

ARCHITECT: _____ ENGINEER: _____ NO. of UNITS _____ NO. of STORIES _____

Plans Submitted: Yes ☐ No ☐ Calculations Submitted Yes ☐ No ☐ Sewer Fee Req'd. Yes ☐ No ☐

CONTRACTOR: Owner STATE LICENSE # _____ CITY LICENSE # _____

ADD'L. PERMITS REQ'D.: Air Cond. ☐ Elec. ☐ Plumbing ☐ Signs ☐ Paving ☐ Fence ☐ Public Walks ☐ Curb-gutters ☐ Incinerators ☐ Fire Sprinkling System ☐

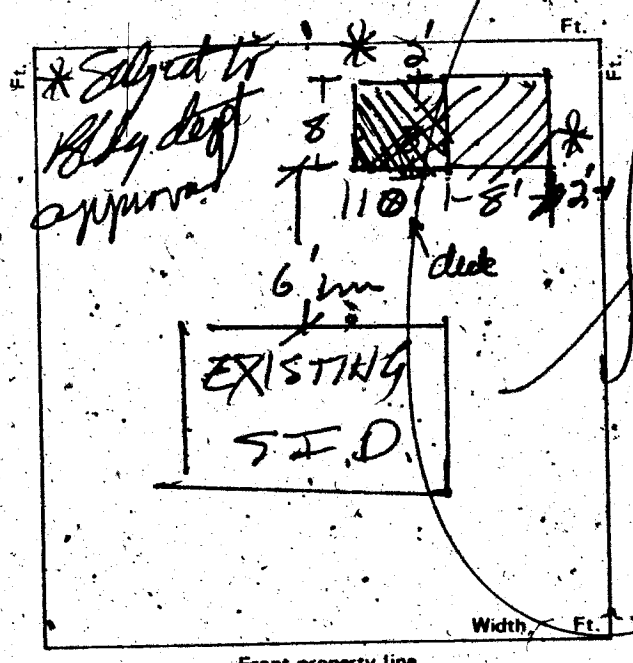

CONDITIONS OF THE PERMIT:

1. I agree to call the City Building Department for inspections before concrete is poured, before rough wiring, electrical, plumbing, framing is covered. Also for Air conditioning, drywall and sheathing inspection.
2. I agree that when the job is completed that I will call for final inspection before occupancy.
3. I agree to perform all construction in accordance with City Ordinances and Building Codes.
4. The Contractor's signature below denotes authority from the owner to sign in his behalf and that the owner is aware of all requirements of this application and permit. Separate permits must be taken out for work outlined above this agreement.
5. I have read and understand the contents of this application and permit; I hereby state that the information I have supplied on this application is true and correct.

Approval for the work under this permit will be given only after refuse and debris have been removed from job site and public right of way. Separate permits are required for work within the public right of way.

SIGNED: _____ Contractor

BY: Charles A. Fay Agent or Owner

ILBLA $ .00
BLD $ 11.50
STL $ 11.50
TOTL $ 11.50

CASH $ 11.50
A#4828 SR#001/01
CITY - LAS VEGAS
BLDG. & SAFETY
11/12/82

RECEIPTS

PLANNING DEPT.: _____ Date: 11/12/82

PUBLIC WORKS DEPT.: _____ Date: 11/12/82

BUILDING DIVISION: _____ Date: _____

PERMIT NO.: 4828 PERMIT FEE $ 11.50

MUST BE MACHINE VALIDATED

2300-2401

Dona Hresly 6-24-83

OWNER Charles Fay ADDRESS 5817 Gowan Road

DATE 11-12-82 GEN. CONT. Owner

TYPE OF STRUCTURE Gazebo & Deck PERMIT NO. 4828 FINAL INSPECTION

LEGAL DESCRIPTION L 100 B 3 Twin Lakes Village LOG NO. AREA NO.

APPROVED FOR OCCUPANCY & METER

BUILDING	MECHANICAL
Investigation	Plumbing Cont.
Location & Footing	Permit No. Date
Concrete Slab Floor	Heat & Vent. A/C Cont.
Fireplace Footing	Permit No. Date
Chimney Steel	Sewer Cont.
Vert. Steel Reinf.	Permit No. Date
Horiz. Steel Reinf.	Rough Soil
Framing	Rough Water
Ext. Lath	Tap-Out
Ext. Brown	Rough Gas
Drywall	A/C Rough Duct
Final Building WS 6-20-83	Final Plumbing
Appr. for Occu.	Final Gas
ELECTRICAL	Final Air Cond.
Temp. Pole Cont.	Final Sewer
Permit No. Date	**REMARKS**
Inspection Date	
Electrical Cont.	
Permit No. Date	
Rough	PLEASE NOTE ADDITIONAL REMARKS ON REVERSE SIDE.
Final Rough	DEPT. OF BLDG. & SAFETY CITY OF LAS VEGAS REV. 82-3-29
Final Electrical	
Temporary Service	