

1817 Granite

L14 B1 Twin Lakes Vill #11 Zone R-1

Sharon Duran May 30, 1979

CITY OF LAS VEGAS, NEVADA

LOG NO. & AREA

DEPARTMENT OF BUILDING & SAFETY

CONST. VAL. 140.00

APPLICATION & BUILDING PERMIT for:
Dwellings, Duplexes, Misc. Residential Const.

ADDRESS OF
CONSTRUCTION:

1817 Granite

OWNER:

R. T. A. TEAS

LOT(s)

1A

BLOCK

1

SUBDIVISION

TWIN LAKES VILL. #1

ZONE

21

Existing structure on lot: Dwelling

☐

Accessory bldgs

☐

Vacant lot

☐

Other

☐

PROPOSED CONSTRUCTION:

Alum. Patio Cover

USE:

MATERIALS OF CONSTRUCTION:

Wood Frame

☐

Concrete Block

☐

Reinforced Concrete

☐

Steel Frame

☐

SQ. FEET OF FLOOR AREAS:

1st

2nd

3rd

Other

TOTAL SQ. FT.

112

FIRE ZONE: 1 2 3

Occupancy Group 1 2

CONST. TYPE

I II III IV V

ARCHITECT

ENGINEER

NO. of UNITS

NO. of STORES

Plans Submitted:

Yes

☐

No

☐

Calculations Submitted:

Yes

☐

No

☐

Sewer Fee Req'd.

Yes

☐

No

☐

CONTRACTOR

Dura Kool Alum Prod

STATE LICENSE

11488-A

CITY LICENSE

10254

ADD'L PERMITS REQ'D:

Air Cond.

☐

Elec.

☐

Plumbing

☐

Signs

☐

Paving

☐

Fence

☐

Public Works

☐

Curb-gutters

☐

CONDITIONS OF THE PERMIT

1. I agree to call the City Building Department for inspections before concrete is poured, before rough wiring, electrical, plumbing, framing is covered. Also for air conditioning, sheet-rock and sheathing inspection.
2. I agree that when the job is completed, that I will call for final inspection before occupancy.
3. I agree to perform all construction in accordance with City Ordinances and Building Codes.
4. The Contractor's signature below delegates authority from the owner to sign in his behalf and that the owner is aware of all requirements of this application and permit. Separate permits must be taken out for work outlined above this agreement.
5. I have read and understand the contents of this application and permit. I hereby state that the information I have supplied on this application is true and correct.

Approval for the work under this permit will be given only after refuse and debris have been removed from site and public right of way

SIGNED

Dura Kool Alum Prod Inc Contractor

BY

Betty Cohen

Agent or Owner

CLARK COUNTY HEALTH DEPT.

Date

LAS VEGAS FIRE DEPARTMENT

Date

PLANNING DEPT.

Date

5/30/79

PUBLIC WORKS DEPT.

Date

BUILDING DEPT.

Date

5-6-79

12850

PERMIT NO.

16616

PERMIT FEE \$

5.00

RECEIPT

2138 \$005.00 - 8

CITY OF LAS VEGAS
DEPT. OF
BUILDING & SAFETY

MUST BE MACHINE VALIDATED

10 MAY 79

Sharon Davis May 30, 1979

CITY OF LAS VEGAS, NEVADA
Department of Building and Safety

CERTIFICATE OF INSPECTION



Address

1817 Granite

Owner

Terry Teal

Legal

Lot 14 blk 1

Date

June 17, 1975

Ivan Lakes Village #7

This certificate issued pursuant to the requirements of Section 306 of the
UNIFORM BUILDING CODE certifying that at the time of this issuance
the improvements on this property were in compliance with CITY OF LAS
VEGAS, HOUSING, BUILDING, ELECTRICAL, PLUMBING and MECH-
ANICAL CODES

DIRECTOR

Department of Building & Safety

by William R. Fitzgerald

This Certificate does not include conditions subject to normal maintenance.

No.

2715

Fee \$

10.00

RECEIPT

Must be machine validated

Paid 6/16/75
MR 208557
WRJ

12850

Sharon Curran May 30, 1979

MAYOR ORAN K. GRAGSON

COMMISSIONERS
PAUL J. CHRISTENSEN
GEORGE E. FRANKLIN
RON LURIE
HAL F. MORELLI

CITY ATTORNEY
CARL E. COWELL
CITY MANAGER
A. R. TRELEASE

CITY OF LAS VEGAS




DEPARTMENT BUILDING & SAFETY
BUILDING INSPECTION REPORT OF REQUIREMENTS FOR COMPLIANCE WITH CITY OF LAS VEGAS
BUILDING CODES AND ZONING ORDINANCE

ADDRESS H 17 Granite
OWNER 7 Years
DATE 6-17-78

PERMITS REQUIRED

BLDG. ☒ Convert 2 Con Garage To den
ELEC. ☒ Landy Room
PLBG. ☐
A.C. ☐

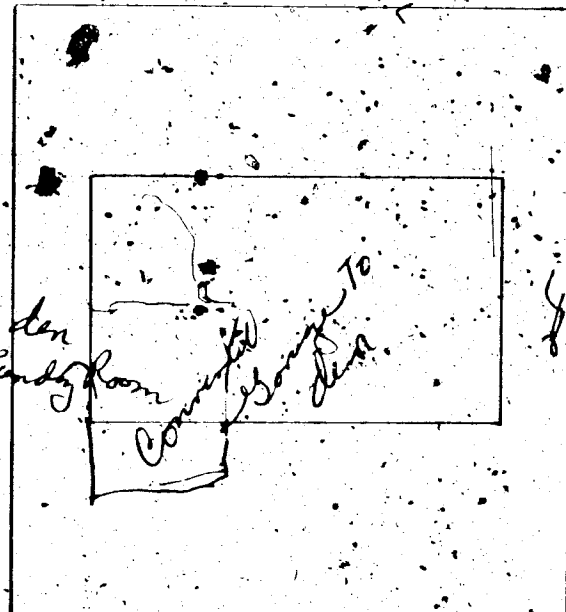


CORRECTIONS TO BE MADE

BLDG. _____
ELEC. _____
PLBG. _____
A.C. _____
MISC. _____

CERTIFICATE OF INSPECTION
APPROVED _____ DATE _____

☐ NOT APPROVED - CALL FOR
REINSPECTION:
386 6251

REMARKS _____

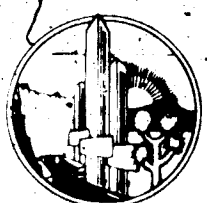

BLDG. INSPECTOR Walter Q. Lister

May 30, 1979

CITY OF LAS VEGAS, NEVADA

LOG NO. & AREA

DEPARTMENT OF BUILDING & SAFETY

CONST. VAL. \$ 6000

APPLICATION & BUILDING PERMIT — for:
Dwellings, Dwellings, Misc. Residential Const.

ADDRESS OF CONSTRUCTION

1817 Granite

OWNER

Terry Lee

LOT(s)

BLOCK

SUBDIVISION

Twin Lakes Village #1

ZONE

R-1

Existing structure on lot: Dwelling

☐

Accessory bldgs.

☐

Vacant lot

☐

Other

☐

PROPOSED CONSTRUCTION

Enclosure Garage

MATERIALS OF CONSTRUCTION:

Wood Frame

☐

Concrete Block

☐

Reinforced Concrete

☐

Steel Frame

☐

SQ. FEET OF FLOOR AREAS:

1st

2nd

3rd

Other

TOTAL SQ. FT.

208

FIRE ZONE: 1 2 3

Occupancy Group

1 J 1 - 2

CONST. TYPE

I II III IV V

ARCHITECT:

ENGINEER:

NO. of UNITS

NO. of STORIES

Plans Submitted:

Yes

☐

No

Calculations Submitted:

Yes

☐

No

☐

Sewer Fee Req'd:

Yes

☐

No

☐

CONTRACTOR:

Owner

STATE LICENSE #

CITY LICENSE #

ADD'L PERMITS REQ'D:

Air Cond.

☐

Elec.

☒

Plumbing

☐

Signs

☐

Paving

☐

Fence


☐

Public Walks

☐

Curb-gutters

☐

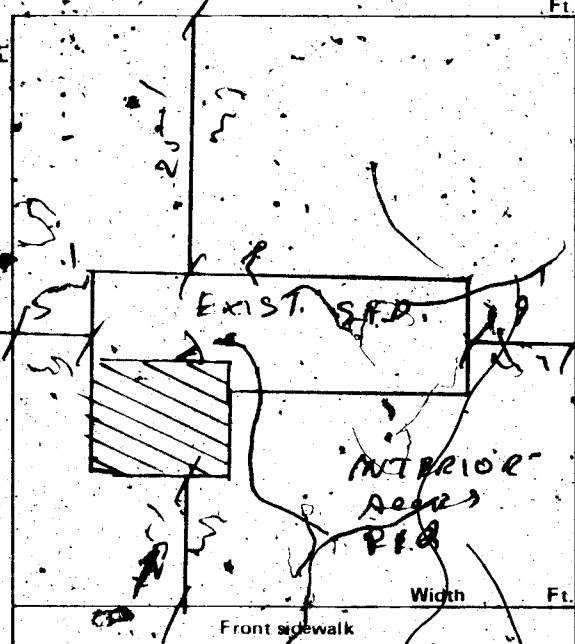

CONDITIONS OF THE PERMIT:

- I agree to call the City Building Department for inspections before concrete is poured, before rough wiring, electrical, plumbing, framing is covered. Also for air conditioning, sheet-rock and sheathing inspection.
- I agree that when the job is completed that I will call for final inspection before occupancy.
- I agree to perform all construction in accordance with City Ordinances and Building Codes.
- The Contractor's signature below denotes authority from the owner to sign in his behalf and that the owner is aware of all requirements of this application and permit. Separate permits must be taken out for work outlined above this agreement.
- I have read and understand the contents of this application and permit. I hereby state that the information I have supplied on this application is true and correct.

Approval for the work under this permit will be given only after refuse and debris have been removed from job site and public right of way.

SIGNED:

Terrance F. Team

Contractor

BY:

Agent or Owner

CLARK COUNTY HEALTH DEPT.

Date

LAS VEGAS FIRE DEPARTMENT

Date

PLANNING DEPT.:

Mal

Date:

6/12/75

PUBLIC WORKS DEPT.:

Date:

BUILDING DEPT.:

N. M. Jell

Date:

6-24-75

12850

PERMIT NO.:

2716

PERMIT FEE \$

600.00

RECEIPT

7027 \$8008.00

CITY OF LAS VEGAS
DEPT. OF
BUILDING & SAFETY

MUST BE MACHINE VALIDATED

25 JUN 75

CITY OF LAS VEGAS, NEVADA

LOG NO. & AREA

DEPARTMENT OF BUILDING & SAFETY

CONST. VAL. \$

APPLICATION & BUILDING PERMIT — for:
Dwellings, Dwellings, Misc. Residential Const.

ADDRESS OF CONSTRUCTION

LOT(s)

BLOCK

SUBDIVISION

ZONE

Existing structure on lot: Dwelling

Accessory bldgs.

Vacant lot

Other

PROPOSED CONSTRUCTION

MATERIALS OF CONSTRUCTION:

Wood Frame

Concrete Block

Reinforced Concrete

Steel Frame

SQ. FEET OF FLOOR AREAS:

1st

2nd

3rd

Oth

TOTAL SQ. FT.

FIRE ZONE: 1 2 3

Occupancy Group

1 J 1 - 2

CONST. TYPE

I II III IV V

ARCHITECT

ENGINEER

NO. of UNITS

NO. of STORIES

Plans Submitted:

Yes

No

Calculations Submitted

Yes

No

Sewer Fee Req'd.

Yes

No

CONTRACTOR

STATE LICENSE #

CITY LICENSE #

ADD'L. PERMITS REQ'D:

Air Cond.

Incinerators

Elec.

Plumbing


Signs

Paving

Fence

Public Walks

Curb gutters

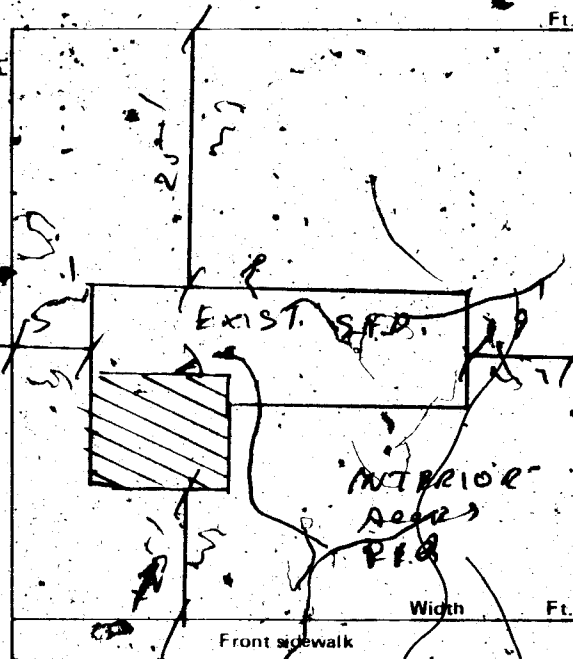

CONDITIONS OF THE PERMIT:

- I agree to call the City Building Department for inspections before concrete is poured, before rough wiring, electrical, plumbing, framing is covered. Also for air conditioning, sheet-rock and sheathing inspection.
- I agree that when the job is completed that I will call for final inspection before occupancy.
- I agree to perform all construction in accordance with City Ordinances and Building Codes.
- The Contractor's signature below denotes authority from the owner to sign in his behalf and that the owner is aware of all requirements of this application and permit. Separate permits must be taken out for work outlined above this agreement.
- I have read and understand the contents of this application and permit. I hereby state that the information I have supplied on this application is true and correct.

Approval for the work under this permit will be given only after refuse and debris have been removed from job site and public right of way.

SIGNED:

Contractor

BY:

Agent or Owner

CLARK COUNTY HEALTH DEPT.

Date

LAS VEGAS FIRE DEPARTMENT

Date

PLANNING DEPT.

Date

PUBLIC WORKS DEPT.

Date

BUILDING DEPT.

Date

12850

PERMIT NO.

PERMIT FEE \$

RECEIPT

7027 \$8008.00

CITY OF LAS VEGAS
DEPT. OF
BUILDING & SAFETY

MUST BE MACHINE VALIDATED

25 JUN 75

CITY OF LAS VEGAS, NEVADA

DEPARTMENT OF BUILDING & SAFETY - ELECTRICAL APPLICATION & PERMIT

ADDRESS OF
CONSTRUCTION:

1817 Granite

OWNER'S
NAME:

Jerry Teas

CIRCLE: New Bldg.; Add'n. Remodel; TYPE OF BLDG: SFD. APT. PUBLIC COMM.

CONTRACTOR'S NAME:

Owner

STATE
LICENSE #

CITY
LICENSE #

NUMBER	FIXTURE OR INSTALLATION	UNIT PRICE	TOTAL
	Rm addition, carport or garage enclosure	4.00	4.00
	Temporary power	4.00	
	Light, receptacle or switch outlet	.20	
	Wall or ceiling space heater	.35	
	Garbage grinder outlet	.35	
	Dishwasher outlet	.35	
	Clothes dryer outlet	.35	
	Automatic clothes washer	.35	
	Electric range outlet	.35	
	Electric water heater outlet	.35	
	Special purpose outlet	.35	
	X-ray unit and its appurtenances	5.00	
	Watts of festoon lighting (Watts) First 3,000 watts for each additional thousand watts	4.00 1.50	
	Horsepower each motor first horsepower or less for each additional horsepower	1.75 .35	
	Electric service (including any single meter socket) for each additional socket	3.00 .35	
	Air conditioning service	1.50	
	Each KW(KVA) Generator (Transformer, Welder) First 100 KVA for each additional KW(KVA)	2.00 .01	
	Speaker, signal or alarm outlet	.15	
	Amplifiers	.50	
	Control panels	.25	
	Main control racks	1.00	
	T.V. and radio antennas-master system only	.75	
	Minimum fee for any permit	4.00	
	TOTAL FEE		4.00

Approval for the work under this permit will be given only after refuse and debris have been removed from job site and public right of way.

I hereby certify that I have carefully examined and read the above application; that the same is true and correct; and that the work herein described is to be done in accordance with all the provisions of the applicable Ordinances of the City of Las Vegas, Nevada and State laws whether herein specified or not.

SIGNED

MASTER (ELECTRICIAN) (TECHNICIAN) (OWNER)

DATE

BUILDING DEPARTMENT

DATE

#12860

PERMIT NO.

1585

PERMIT FEE: \$

4.00

RECEIPT

7028

\$004.00

6

CITY OF LAS VEGAS

DEPT. OF
BUILDING & SAFETY

MUST BE MACHINE VALIDATED

25 JUN 75

DEPT. of BLDG. & SAFETY - CITY of LAS VEGAS, NEVADA

OWNER Rita Teas

ADDRESS

1817 Granite

DATE 5-9-74

GEN. CONT. Dura Kool

TYPE OF STRUCTURE alum patio cover

PERMIT NO. 16616

LEGAL DESCRIPTION

L 14 B 1 Twin Lakes Village # 11

BUILDING	MECHANICAL	ELECTRICAL
Investigation	Plumbing Cont.	Temp. pole cont.
Location & Footing	Permit No. _____ Date _____	Permit No. _____ Date _____
Stem Wall	Heat & Vent. A/C Cont.	Inspection _____ Date _____
Concrete Slab Floor	Permit No. _____ Date _____	Electrical Cont. _____
Floor Framing	Sewer Cont.	Permit No. _____ Date _____
Fireplace Footing	Permit No. _____ Date _____	Fixtures Cont. _____
Chimney Steel	Rough Soil	Permit No. _____ Date _____
Vert. Steel Reinf.	Rough Water	Slab _____
Horiz. Steel Reinf.	Top-Out	Rough _____
Roof Sheathing	Rough Gas	Final Rough _____
Framing	A/C Rough Duct	Final Fixture _____
Backing for siding	Ref. Rough Piping	Final Electrical _____
Ext. Lath	Final Plumbing	Temporary Service _____
Ext. Scratch	Final Gas	MISCELLANEOUS
Ext. Brown	Final Air Cond.	Grading & Drainage _____
Int. Lath	Final Refrig.	On-Site Parking Spaces _____ App. _____
Int. Brown	Final Sewer	Eng. Approval of _____
Drywall	Final Septic Tank	Off-Site Improvements _____
Permit No. _____		
Final Building		
Appr. for Occu.		

INSPECTOR:

DATE

APPROVED FOR OCCUPANCY & METER

1817 Granite

LOG #

AREA #

PLEASE NOTE REMARKS ON REVERSE SIDE

DEPT. of BLDG. & SAFETY - CITY of LAS VEGAS, NEVADA

OWNER Terry Teas

ADDRESS 1817 Granite

DATE 6-24-75

GEN. CONT. Owner

TYPE OF STRUCTURE Enc garage for

PERMIT NO. 2716

LEGAL DESCRIPTION

L 14 B 1 Twin Lakes

Certification

BUILDING	MECHANICAL	ELECTRICAL
Investigation	Plumbing Cont.	Temp. pole cont.
Location & Footing	Permit No. _____ Date _____	Permit No. _____ Date _____
Stem Wall	Heat & Vent. A/C Cont.	Inspection _____ Date _____
Concrete Slab Floor	Permit No. _____ Date _____	Electrical Cont. Owner
Floor Framing	Sewer Cont.	Permit No. 1585
Fireplace Footing	Permit No. _____ Date _____	Fixtures Cont. _____
Chimney Steel	Rough Soil	Permit No. _____ Date _____
Vert. Steel Reinf.	Rough Water	Slab _____
Horiz. Steel Reinf.	Top-Out	Rough _____
Roof Sheathing	Rough Gas	Final Rough _____
Framing	A/C Rough Duct	Final Fixture _____
Backing for siding	Ref. Rough Piping	Final Electrical _____
Ext. Lath	Final Plumbing	Temporary Service _____
Ext. Scratch	Final Gas	MISCELLANEOUS
Ext. Brown	Final Air Cond.	Grading & Drainage _____
Int. Lath	Final Refrig.	On-Site Parking Spaces _____ App. _____
Int. Brown	Final Sewer	Eng. Approval of _____
Drywall	Final Septic Tank	Off-Site Improvements _____
Permit No. _____		
Final Building		
Appr. for Occu.		

INSPECTOR:

DATE

APPROVED FOR OCCUPANCY & METER

LOG #

AREA #

PLEASE NOTE REMARKS ON REVERSE SIDE 1817 Granite

DEPT. of BLDG. & SAFETY - CITY of LAS VEGAS, NEVADA

OWNER Rita Teas
GEN. CONT. Dura Kool
PERMIT NO. 16616

ADDRESS

1817 Granite

DATE 5-9-74

TYPE OF STRUCTURE alum patio cover

L 14 B 1 Twin Lakes Village # 11

LEGAL DESCRIPTION

BUILDING	MECHANICAL	ELECTRICAL
Investigation	Plumbing Cont.	Temp. pole cont.
Location & Footing	Permit No. _____ Date _____	Permit No. _____ Date _____
Stem Wall	Heat & Vent. A/C Cont.	Inspection _____ Date _____
Concrete Slab Floor	Permit No. _____ Date _____	Electrical Cont. _____
Floor Framing	Sewer Cont.	Permit No. _____ Date _____
Fireplace Footing	Permit No. _____ Date _____	Fixtures Cont. _____
Chimney Steel	Rough Soil	Permit No. _____ Date _____
Vert. Steel Reinf.	Rough Water	Slab _____
Horiz. Steel Reinf.	Top-Out	Rough _____
Roof Sheathing	Rough Gas	Final Rough _____
Framing	A/C Rough Duct	Final Fixture _____
Backing for siding	Ref. Rough Piping	Final Electrical _____
Ext. Lath	Final Plumbing	Temporary Service _____
Ext. Scratch	Final Gas	MISCELLANEOUS
Ext. Brown	Final Air Cond.	Grading & Drainage _____
Int. Lath	Final Refrig.	On-Site Parking Spaces _____ App. _____
Int. Brown	Final Sewer	Eng. Approval of _____
Drywall	Final Septic Tank	Off-Site Improvements _____
Permit No. _____		
Final Building		
Appr. for Occu.		

INSPECTOR:

DATE

APPROVED FOR OCCUPANCY & METER

1817 Granite

LOG #

AREA #

PLEASE NOTE REMARKS ON REVERSE SIDE

DEPT. of BLDG. & SAFETY - CITY of LAS VEGAS, NEVADA

OWNER Terry Teas
GEN. CONT. Owner
PERMIT NO. 2716

ADDRESS 1817 Granite

DATE 6-24-75

TYPE OF STRUCTURE Enc garage for

L 14 B 1 Twin Lakes

Certification

LEGAL DESCRIPTION

BUILDING	MECHANICAL	ELECTRICAL
Investigation	Plumbing Cont.	Temp. pole cont.
Location & Footing	Permit No. _____ Date _____	Permit No. _____ Date _____
Stem Wall	Heat & Vent. A/C Cont.	Inspection _____ Date _____
Concrete Slab Floor	Permit No. _____ Date _____	Electrical Cont. Owner
Floor Framing	Sewer Cont.	Permit No. 1585 Date _____
Fireplace Footing	Permit No. _____ Date _____	Fixtures Cont. _____
Chimney Steel	Rough Soil	Permit No. _____ Date _____
Vert. Steel Reinf.	Rough Water	Slab _____
Horiz. Steel Reinf.	Top-Out	Rough _____
Roof Sheathing	Rough Gas	Final Rough _____
Framing	A/C Rough Duct	Final Fixture _____
Backing for siding	Ref. Rough Piping	Final Electrical _____
Ext. Lath	Final Plumbing	Temporary Service _____
Ext. Scratch	Final Gas	MISCELLANEOUS
Ext. Brown	Final Air Cond.	Grading & Drainage _____
Int. Lath	Final Refrig.	On-Site Parking Spaces _____ App. _____
Int. Brown	Final Sewer	Eng. Approval of _____
Drywall	Final Septic Tank	Off-Site Improvements _____
Permit No. _____		
Final Building		
Appr. for Occu.		

INSPECTOR:

DATE

APPROVED FOR OCCUPANCY & METER

1817 Granite

LOG #

AREA #

PLEASE NOTE REMARKS ON REVERSE SIDE

Sub 105-5

DEPT. of BLDG & SAFETY—CITY of LAS VEGAS, NEVADA			
OWNER <u>D. Spencer</u>		ADDRESS <u>1817 Granite</u>	
GEN. CONT. <u>Arden Bldrs</u>		DATE <u>6-25-65</u>	
PERMIT NO. <u>30739</u>		TYPE OF STRUCTURE <u>Finish sfd</u>	
LEGAL DESCRIPTION			
BUILDING		MECHANICAL	
ELECTRICAL		MISCELLANEOUS	
LOCATION	PLUMBING CONT. <u>Lox</u>	TEMP. POLE CONT.	
FIREPLACE-FTS.	PERMIT NO. <u>18169</u> DATE <u>6-25-65</u>	PERMIT NO.	
FOOTINGS	HEAT & VENT. AC CONT. <u>Oasis</u>	INSPECTION	
FOUNDATION WALL	PERMIT NO. <u>10436</u> DATE <u>6-25-65</u>	ELECTRICAL CONT. <u>Electriccon</u>	
FLOOR FRAMING	SEWER CONT.	PERMIT NO. <u>19746</u> DATE <u>6-25-65</u>	
SLAB	PERMIT NO.	DATE	
CHIMNEY STEEL (FIREPLACE)	ROUGH SOIL	FIXTURES CONT.	
WALL STEEL	ROUGH WATER	PERMIT NO.	
COLUMN STEEL	TOP-OUT	DATE	
BEAM STEEL	ROUGH GAS	SLAB	
FRAMING	AC ROUGH DUCT	ROUGH	
ROOF SHEATHING	REF. ROUGH PIPING	FINAL ROUGH	
INTERIOR	FINAL PLUMBING <u>10/10/65</u>	FINAL FIXTURE	
DRYWALL	FINAL GAS	FINAL ELECTRICAL <u>11/1/65</u>	
BATHING	FINAL AIR COND.	TEMPORARY SERVICE	
BACKING (SHOWS)	FINAL REFRIG.		
PLASTER	FINAL SEWER		
SCRATCH	FINAL SEPTIC TANK		
BROWN			
URBAN REDEVELOPMENT APPROVAL			
FINAL BLDG <u>Sub 105</u> DATE <u>7-16-65</u>			
APPROVED FOR OCCUPANCY & METER		INSPECTOR	DATE
PLEASE NOTE REMARKS ON REVERSE SIDE		1817 Granite	LOS: # AREA: # 23.0

Check Jones 3.56

DEPT. of BLDG & SAFETY—CITY of LAS VEGAS, NEVADA

OWNER Barnette & Assoc
ADDRESS 1817 Granite
DATE 9-9-63

GEN. CONT. Dallas Const. Corp
TYPE OF STRUCTURE SFD

PERMIT NO. 186-7
LEGAL DESCRIPTION Lot 11 Block 1 Twin Lakes Village #11

BUILDING	MECHANICAL	ELECTRICAL
LOCATION _____	PLUMBING CONT. <u>11-26-63</u>	TEMP. POLE CONT. _____
FIREPLACE FTS. _____	PERMIT NO. <u>186-3</u> DATE _____	PERMIT NO. _____ DATE _____
FOOTINGS <u>Drake 11-26-63</u>	HEAT & VENT. AC CONT. _____	INSPECTION _____ DATE _____
FOUNDATION WALL _____	PERMIT NO. _____ DATE _____	ELECTRICAL CONT. <u>Morgan Valley</u>
FLOOR FRAMING _____	SEWER CONT. <u>12-4-63</u>	PERMIT NO. <u>172-01</u> DATE <u>6-5-64</u>
SLAB <u>Drake 12-4-63</u>	PERMIT NO. <u>186-3</u> DATE <u>12-4-63</u>	FIXTURES CONT. <u>172-01</u> DATE _____
CHIMNEY STEEL (FIREPLACE) _____	ROUGH SOIL <u>12-5-63</u>	PERMIT NO. <u>172-01</u> DATE _____
WALL STEEL <u>Drake 12-5-63</u>	ROUGH WATER <u>12-5-63</u>	BLAB _____
COLUMN STEEL _____	TOP-DUT <u>12-5-63</u>	ROUGH <u>12-4-20-64</u>
BEAM STEEL _____	ROUGH GAS _____	FINAL ROUGH _____
FRAMING _____	AC ROUGH DUCT <u>12-4-22-64</u>	FINAL FIXTURE _____
ROOF SHEATHING <u>11-11-63</u>	REF. ROUGH PIPING _____	FINAL ELECTRICAL _____
INTERIOR <u>11-11-63</u>	FINAL PLUMBING _____	TEMPORARY SERVICE _____
EXTERIOR <u>11-11-63</u>	FINAL GAS _____	
DRYWALL <u>11-11-63</u>	FINAL AIR COND. _____	
LATHING _____	FINAL REFRIG. _____	
BACKING (SIDING) _____	FINAL SEWER <u>11-11-63</u>	
PLASTER SCRATCH _____	FINAL SEPTIC TANK _____	
PLASTER BROWN _____		
URBAN REDEVELOPMENT APPROVAL _____		
FINAL BLDG. _____ DATE _____		

APPROVED FOR OCCUPANCY & METER _____

PLEASE NOTE REMARKS ON REVERSE SIDE

INSPECTOR _____

1817 Granite

DATE _____

LOG: # _____ AREA: # _____

T 75 3