

613 Greenhurst

— Lot 23 Blk 10 Charleston Rainbow 9F Zone R1 —

Theresa Kynalko 110-9-82

CITY OF LAS VEGAS, NEVADA

LOG NO. & AREA

CONST. VAL. 768

DEPARTMENT OF PUBLIC SERVICES
DIVISION OF BUILDING AND SAFETY

APPLICATION & BUILDING PERMIT - for:
Dwellings, Duplexes, Misc. Residential Const.

ADDRESS OF
CONSTRUCTION

613 Greenhurst Rd

OWNER

Helveng Thomas Bruce

LOT(s)

23

BLOCK

10

SUBDIVISION

Charleston Rainbow 9F

ZONE

R-1

Existing structure on lot:

Dwelling ☐

Accessory Bldg ☐

Vacant Lot ☐

Other ☐

PROPOSED CONSTRUCTION:

Addn

USE

extend living room

MATERIALS OF CONSTRUCTION:

Wood Frame ☐

Concrete Block ☐

Reinforced Concrete ☐

Steel Frame ☐

SQUARE FEET OF FLOOR AREAS: 1st

2nd

3rd

Other

TOTAL SQ. FT.

64

FIRE ZONE:

Occupancy Group

CONST. TYPE:

ARCHITECT

ENGINEER

NO. OF UNITS

NO. OF STORIES

Plans Submitted:

Yes ☐

No ☐

Calculations Submitted:

Yes ☐

No ☐

Sewer Fee Req'd:

Yes ☐

No ☐

CONTRACTOR

Owner

STATE
LICENSE #

CITY
LICENSE #

ADD'L PERMITS REQ'D:

Air Cond. ☐

Elec. ☐

Plumbing ☐

Signs ☐

Paving ☐

Fence ☐

Public Walks ☐

Curb gutters ☐

Incinerators ☐

Fire Sprinkling System ☐

CONDITIONS OF THE PERMIT:

- I agree to call the City Building Department for inspections before concrete is poured, before rough wiring, electrical, plumbing, framing is covered. Also for Air conditioning, drywall and sheathing inspection.
- I agree that when the job is completed that I will call for final inspection before occupancy.
- I agree to perform all construction in accordance with City Ordinances and Building Codes.
- The Contractor's signature below denotes authority from the owner to sign in his behalf and that the owner is aware of all requirements of this application and permit. Separate permits must be taken out for work outlined above this agreement.
- I have read and understand the contents of this application and permit. I hereby state that the information I have supplied on this application is true and correct.

Approval for the work under this permit will be given only after release and debris have been removed from job site and public right of way.


SIGNED:

Thomas B. Helveng

Contractor

BY:

Agent or Owner

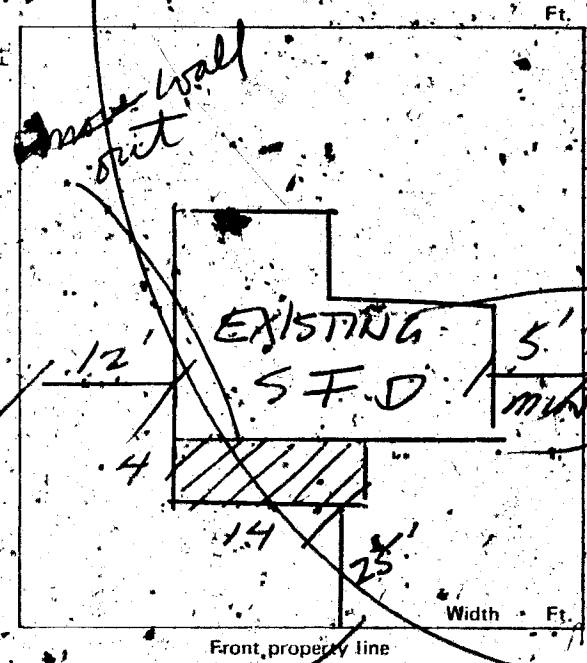

PLANNING DEPT.

Date:

10/6/80

PUBLIC WORKS DEPT.

Date:

10/6/80

BUILDING DIVISION:

Date:

10/6/80

PERMIT NO. 51611

PERMIT FEE \$ 225

1721-2401

RECEIPT \$19.55
\$19.55
\$19.55
\$19.55
CITY OF LAS VEGAS
DIVISION OF BUILDING AND SAFETY
MUST BE MACHINE VALIDATED

Theresa Kynak 10-9-82

CITY OF LAS VEGAS, NEVADA

DEPARTMENT OF PUBLIC SERVICES — ELECTRICAL APPLICATION & PERMIT
DIVISION OF BUILDING AND SAFETY

ADDRESS OF
CONSTRUCTION:

613 Green Street

OWNER'S
NAME:

Helvin Thomas Bruce

CIRCLE: Addition

Remodel New Bldg.

TYPE OF BLDG:

SFD

APT.

COMM.

PUBLIC

CONTRACTOR'S NAME:

Owner

STATE

LICENSE #

CITY

LICENSE #

UNITS	DESCRIPTION	FEE	TOTAL
1	Receptacles — Duplex Switches	.30	30
	Wall or Ceiling Space Heating	.50	
	Blast Coil Heaters (per kilowatt)	.35	
	Garbage Grinder Outlet	.50	
	Trash Compactor	.35	
	Dishwasher Outlet	.50	
	Clothes Dryer Outlet	.50	
	Automatic Clothes Washer Outlet	.50	
	Electric Range	.50	
	Electric Water Heater	.50	
	Each Fixture or Socket	.15	
	Each Mercury Arc Lamp and Equipment (sealing)	.50	
	Each Special Purpose Outlet	.50	
	Each X-ray Unit and its Appurtenances	7.50	
	Area Lighting — First 3000 Watts	6.00	
	For Each Additional 1000 Watts	2.25	
	Total Horsepower Each Motor — Generator, Transformer, Welder		
	First Horsepower or KVA	2.50	
	For Each Additional Horsepower up to 50	.40	
	For Each Horsepower over 50	.15	
	Temporary Power and Lights — Temporary Pole	5.00	
	Electric Service, including First Meter Socket	4.50	
	For Each Additional Meter Socket	.40	
	Services over 200 to 600 Amperes	6.25	
	600 to 1200 Amperes	12.50	
	over 1200 Amperes	25.00	
	Sub Panel	1.50	
	Permanently Connected Air Conditioning Service (Heating/Cooling)	2.25	
	Speaker Outlets	.20	
	Signal or Alarm Outlets	.25	
	Amplifiers	1.25	
	Control Panels	.35	
	T.V. Outlets — Master System Only	.30	
	Swimming Pool (residential)	10.00	
	Swimming Pool (commercial)	15.00	
	Spas	4.00	
	Recreational Vehicles (per space)	1.50	
	Busways — for Trolley and Plug in Type Busways, Each 100 Feet or Fraction Thereof	1.50	
	Fee for Issuing Each Permit	7.00	

Other inspections and fees:

1. Inspections outside of normal business hours = \$7.50 per hour (minimum charge two hours)
2. Re-inspection fee assessed under provisions of Section 305(h) of the Uniform Building Code = \$7.50 per hour.
3. Inspections for which no fees specifically indicated = \$7.50 per hour (minimum charge one hour).
4. Additional plan review required by changes, additions or revisions to approved plans = \$7.50 per hour (minimum charge one half hour).

I hereby certify that I have carefully examined and read the above application, the same is true and correct; and that the work herein described is to be done in accordance with all the provisions of the applicable Ordinances of the City of Las Vegas, Nevada and the State Laws whether herein specified or not.

SIGNED

Thomas B. Helvin
Master (Electrician) (Technician) (Owner)

Date

BUILDING DIVISION

PERMIT NO.

5611-1

PERMIT FEE \$

739

#1721-2402 (REV. 3/80)

Approval for the work under this permit will be given only after refuse and debris have been removed from job site and public right of way.

RECEIPT

MUST BE MACHINE VALIDATED