

1620 HARLEY WAY

LOT 4 BLK 2 MAYFAIR #3 ZONE R-1

Glenn Gatewood 7-3-79

LOG NO. & AREA

CITY OF LAS VEGAS, NEVADA

CONST. VAL. \$

27200

DEPARTMENT OF BUILDING & SAFETY

APPLICATION & BUILDING PERMIT — for:
Dwellings, Dwellings, Misc. Residential Const.

ADDRESS OF
CONSTRUCTION:

1620 Harley Way

OWNER:

Carl J. Bohne

LOT(s)

4

BLOCK

2

SUBDIVISION

Mayfair #3

ZONE: R-1

Existing structure on lot: Dwelling ☒ Accessory bldg. ☐ Vacant lot ☐ Other ☐

PROPOSED CONSTRUCTION:

Carpent roof

USE:

Carpent

MATERIALS OF CONSTRUCTION: Wood Frame ☐ Concrete Block ☐ Reinforced Concrete ☐ Steel Frame ☐

SQUARE FEET OF FLOOR AREAS: 1st ☐ 2nd ☐ 3rd ☐ Other ☐ TOTAL SQ. FT. 272

FIRE ZONE: 1 2 3 Occupancy Group A B C D E F G H I J K L M N O P Q R S T U V W X Y Z CONST. TYPE: I II III IV V

ARCHITECT:

ENGINEER:

NO. of UNITS

NO. of STORIES

Plans Submitted: Yes ☐ No ☐ Calculations Submitted: Yes ☐ No ☐ Sewer Fee Req'd: Yes ☐ No ☐


CONTRACTOR:

Owner

STATE
LICENSE #

CITY
LICENSE #

ADD'L PERMITS REQ'D: Air Cond. ☐ Elec. ☐ Plumbing ☐ Signs ☐ Paving ☐ Fence ☐ Public Walks ☐ Curb-gutters ☐
Incinerators ☐ Fire Sprinkling System ☐

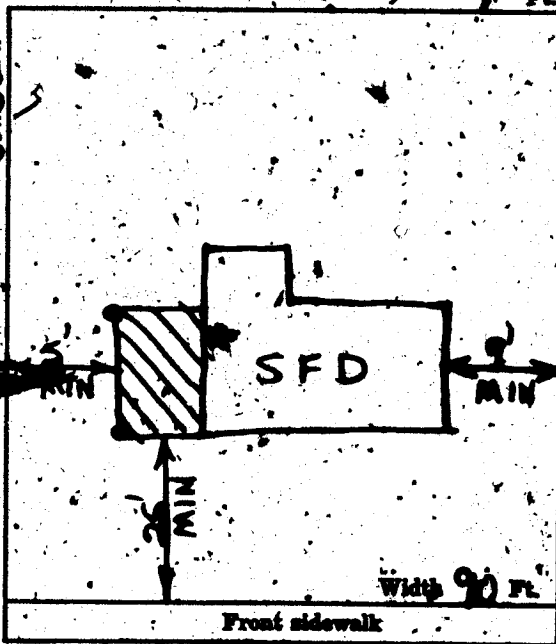

CONDITIONS OF THE PERMIT:

1. I agree to call the City Building Department for inspections before concrete is poured, before rough wiring, electrical, plumbing, framing is covered. Also for Air conditioning, sheet-rock and sheathing inspection.
2. I agree that when the job is completed that I will call for final inspection before occupancy.
3. I agree to perform all construction in accordance with City Ordinances and Building Codes.
4. The Contractor's signature below denotes authority from the owner to sign in his behalf and that the owner is aware of all requirements of this application and permit. Separate permits must be taken out for work outlined above this agreement.
5. I have read and understand the contents of this application and permit; I hereby state that the information I have supplied on this application is true and correct.

SIGNED:

Carl J. Bohne

Contractor

BY:

Agent or Owner

CLARK COUNTY HEALTH DEPT.

Date

LAS VEGAS FIRE DEPARTMENT

Date

PLANNING DEPT:

DLB

Date:

6-6-68

ENGINEERING DEPT:

Date:

BUILDING DEPT:

H. R. Bailey

Date:

6-6-68

#1285

PERMIT NO:

43062

PERMIT FEE \$

4.00

RECEIPT

662 3004.00 - 8

CITY OF LAS VEGAS
DEPT. OF
BUILDING & SAFETY

MUST BE MACHINE VALIDATED

7 JUN 68

Glenn Gatewood 7-3-79

CITY OF LAS VEGAS, NEVADA

LOG NO. & AREA
DEPARTMENT OF BUILDING & SAFETY

CONST. VAL. \$ 300

APPLICATION & BUILDING PERMIT for:
Fence, Wall, Retaining Wall.

ADDRESS OF
CONSTRUCTION:

1620 HARLEY WAY

OWNER:

EARL J. BOHNE

LOT(s)

4

BLOCK

2

SUBDIVISION

Mayfair Tract #3

ZONE

R-1

Materials of Construction:

Block ☒

Concrete ☐

Wire ☐

Wood ☐

Other ☐

Yes No

PLANS: ☐ ☐

ARCHITECT:

ENGINEER:

CALCS: ☐ ☐

CONTRACTOR:

Earl J. Bohne

STATE

LICENSE # 2505

CITY

LICENSE #

TOTAL SQUARE FEET:


TOTAL LINEAL FEET:

84

Remarks:

CONDITIONS OF THE PERMIT:

1. Any type of retaining wall must be engineered by a Civil or Structural Engineer.
2. If a home owner takes out the Building Permit and if the owner sublets the work to a Contractor, then the Contractor must take out the permit and pay for it.
3. No fence or wall can be built on City property or rights-of-way, but this is not intended to preclude construction within utility easements if utilities will not be damaged or made inaccessible.
4. The fence or wall shall not enclose any water meter, light standard, or fire alarm box and shall not come closer than 24" from the nearest fire hydrant outlet.
5. Department Inspectors must approve footings before concrete is poured and block wall reinforcing before grouting is done.
6. Maximum height of any wall or fence is 6' side and rear yards; 4' maximum in front yard with the vertical surface above the height of 2' 50% open.
7. I must not obstruct required on-site parking space (2 spaces for each dwelling unit) by the erection of this fence or wall.
8. By the signing of this application I herewith agree to the requirements outlined above.

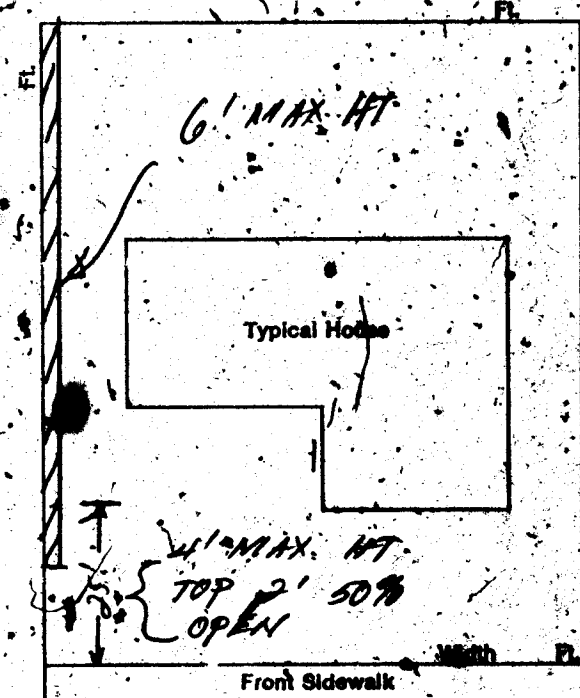

SIGNED:

Earl J. Bohne

DATE:

8/14/75

CONTRACTOR ☒

AGENT ☐

OWNER ☒

PLANNING DEPT:

Date:

8/14/75

PUBLIC WORKS DEPT:

Date:

8/14/75

BUILDING DEPT:

Date:

8-14-75

#12850

PERMIT NO:

3532

PERMIT FEE \$

5.00

RECEIPT

9423. \$005.00 - 8

CITY OF LAS VEGAS
DEPT. OF BUILDING & SAFETY

MUST BE MACHINE VALIDATED

14 AUG 75

• 1620 Warley Wry.

L. Collins 3-26-82

DEPT. of BLDG & SAFETY—CITY of LAS VEGAS, NEVADA
OWNER Earl Bohne ADDRESS 1620 Harley Way DATE 6/6/68
GEN. CONT. Owner TYPE OF STRUCTURE Carport Roof
PERMIT NO. 43062 LEGAL DESCRIPTION L. 4 R2 Mayfair #3

BUILDING			MECHANICAL		ELECTRICAL	
LOCATION			PLUMBING CONT.		TEMP. ROLE CONT.	
FIREPLACE PTB.			PERMIT NO.	DATE	PERMIT NO.	DATE
FOOTINGS			HEAT & VENT. AC CONT.		INSPECTION	DATE
FOUNDATION WALL			PERMIT NO.	DATE	ELECTRICAL CONT.	
DOOR FRAMING			SEWER CONT.		PERMIT NO.	DATE
SLAB			PERMIT NO.	DATE	FIXTURES CONT.	
CHIMNEY STEEL (FIREPLACE)			ROUGH SOIL		PERMIT NO.	DATE
WALL STEEL			ROUGH WATER		SLAB	
COLUMN STEEL			TOP-OUT		ROUGH	
BEAM STEEL			ROUGH GAS		FINAL ROUGH	
FRAMING			AC ROUGH DUCT		FINAL FIXTURE	
ROOF SHEATHING			REF. ROUGH PIPING		FINAL ELECTRICAL	
INTERIOR	EXTERIOR		FINAL PLUMBING		TEMPORARY SERVICE	
DRYWALL			FINAL GAS			
LATHING			FINAL AIR COND.		MISCELLANEOUS	
BACKING (SIDING)			FINAL HEATING			
PLASTER	SCRATCH		FINAL SEWER		GRADING & DRAINAGE	
BROWN			FINAL SEPTIC TANK		ON-SITE PARKING SPACES	
URBAN REDEVELOPMENT APPROVAL					ENG. APPROVAL OF	
FINAL BLDG					OFF-SITE IMPROVEMENTS	
DATE					DATE	

APPROVED FOR OCCUPANCY & METER Q 47-12-68 INSPECTOR
PLEASE NOTE REMARKS ON REVERSE SIDE 1620 Harley Way LOG # AREA # 23.04

