

420 W. Harrison

See Application

TY OF LAS VEGAS, NEVA

DEPARTMENT OF PUBLIC SERVICES—ELECTRICAL APPLICATION & PERMIT DIVISION OF BUILDING AND SAFETY

ADDRESS OF CONSTRUCTION: 420 W. Harrison

OWNER'S NAME: Luther Kendrick

CIRCLE: New Bldg; Add'n; Remodel TYPE OF BLDG.: SFD APT. PUBLIC COMM.

CONTRACTOR'S NAME: Owner

STATE LICENSE #

CITY LICENSE #

NUMBER	FIXTURE OR INSTALLATION	UNIT PRICE	TOTAL
	Rm addition, carport or garage enclosure	4.00	
	Temporary power	4.00	
	Light, receptacle or switch outlet	.20	
	Wall or ceiling space heater	.35	
	Garbage grinder outlet	.35	
	Dishwasher outlet	.35	
	Clothes dryer outlet	.35	
	Automatic clothes washer	.35	
	Electric range outlet	.35	
	Electric water heater outlet	.35	
	Special purpose outlet	.35	
	X-ray unit and its appurtenances	5.00	
	Watts of festoon lighting (Watts) First 3,000 watts for each additional thousand watts	4.00 1.50	
	Horsepower each motor first horsepower or less for each additional horsepower	1.75 .35	
	Electric service (including any single meter socket) for each additional socket	3.00 .35	300
	Air conditioning service	1.50	
	Each KW(KVA) Generator (Transformer, Welder) First 100 KVA for each additional KW(KVA)	2.00 .01	
	Speaker, signal or alarm outlet	.15	
	Amplifiers	.50	
	Control panels	.25	
	Main control racks	1.00	
	T.V. and radio antennas-master system only	.75	
	Minimum fee for any permit	4.00	
	TOTAL FEE		400

Approval for the work under this permit will be given only after refuse and debris have been removed from job site and public right of way.

I hereby certify that I have carefully examined and read the above application; that the same is true and correct; and that the work herein described is to be done in accordance with all the provisions of the applicable Ordinances of the City of Las Vegas, Nevada and State laws whether herein specified or not.

SIGNED: Luther Kendrick
MASTER (ELECTRICIAN) (TECHNICIAN) (OWNER)

DATE

BUILDING DIVISION: WBZ

DATE

PERMIT NO. 9307

PERMIT FEE: \$ 400

RECEIPT

MUST BE MACHINE VALIDATED

L. Collins 3-26-82

ELEC. ONLY, PLBG. ONLY, A/C. ONLY		
OWNER <i>Luther Kendrick</i>		DATE
ADDRESS <i>420 W. Harrison</i>		
CONTRACTOR <i>Owner</i>	PERMIT NO. <i>9307</i>	FINAL INSPECTION
LOT	BLOCK	SUBDIVISION
LOG NO.		AREA
ELECTRIC ONLY		PLUMBING ONLY
Contractor <i>Owner</i>	Contractor	
Permit No. <i>9307</i>	Permit No.	
Rough Elec.	Rough Soil	
Final Rough	Rough Water	
Final Elec. <i>1054-1-81</i>	Top Out	
Temp. Service	Rough Gas	
HEAT & VENT. A/C ONLY		Final Plbg.
Contractor	Final Gas	
Permit No.	Sewer Final	
A/C Rough Duct	<i>Service charge</i>	
Rough Gas		
Final A/C		
Final Gas		
78-3-15 DIV. OF BLDG. & SAFETY CITY OF LAS VEGAS REV. 10-78		

Donna Hovels

3-21-84

CITY OF LAS VEGAS, NEVADA

LOG NO. & AREA

DATE 3-21-84

CONST. VAL. \$

912.80

DEPARTMENT OF BUILDING AND SAFETY
PHONE 386-0851

DEVELOPMENT PERMIT AND BUILDING PERMIT
FOR: Fence, Wall, Retaining Wall

ADDRESS OF CONSTRUCTION

420 W. Humboldt Ave. Over Garth's Bar Park

CONTRACTOR

Owner

CITY LICENSE NO.

LOT(s)

1

BLOCK

8

SECTION

17th St. N. All

ZONE

R-3

PROPOSED CONSTRUCTION:

BUILDING PERMIT NO.

3010

ENGINEER

Permit for the work under this permit will be given only after refuse has been removed from job site and public right of way.

Remarks

TOTAL SQUARE FEET:

1404


TOTAL LINEAL FEET:

OTHER INSPECTIONS AND FEES

1. Inspection of building business hours = \$25.00 per hour (minimum charge three hours).
2. Inspection of building business hours = \$25.00 per hour (minimum charge three hours).
3. Inspection during normal business hours for which no fee is specifically indicated = \$15.00 per hour (minimum charge one hour).
4. Additional plan review required by changes, additions or revisions of approved plans = \$25.00 per hour (minimum charge two hours).

CONDITIONS OF THE PERMIT:

1. Any type of retaining wall must be engineered by a Civil or Structural Engineer.
2. If a home owner takes out the Building Permit and if the owner sublets the work to a Contractor, then the Contractor must take out the permit and pay for it.
3. No fence or wall can be built on City property rights of way, but this is not intended to preclude construction within utility easements if utility will not be damaged or made inaccessible.
4. The fence or wall shall not enclose any water meter, light standard, or fire alarm box and shall not come closer than 24" from the nearest fire hydrant outlet.
5. Department inspectors must approve footings before concrete is poured and block wall reinforcing before grouting is done.
6. Maximum height of any wall or fence is 6' side and rear yards, maximum in front yard with the vertical surface above the height of 6' open.
7. I must not obstruct required onsite parking space (2 spaces for each dwelling unit) by the erection of this fence or wall.
8. By the signing of this application I herewith agree to the requirements outlined above.

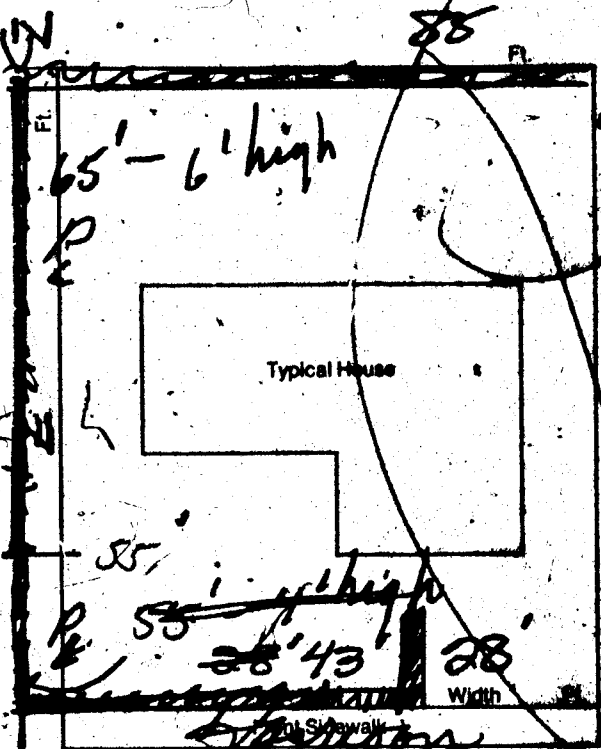

SIGNED

PLANNING DEPT.

BUILDING DEPT.

I hereby certify that I have reviewed this application and the proposed plans and have found that the proposed development meets the requirements of the City of Las Vegas Flood Hazard Reduction Ordinance for the issuance of this Development Permit.

LAND DEVELOPMENT AND FLOOD CONTROL ENGINEER

3/83

Permit Expires 180 Days After Abandonment of Work

RECEIPT

Wall 19.50
Cash 19.50
Permit # 3010

RECEIVED

Amount \$ 17.50

MAR 16 1984

CITY OF LAS VEGAS
DEPT. OF BLDG. & SAFETY

MUST BE MACHINE VALIDATED

We do agree that if given a building permit to install a fence on property to be vacated in Petition of Vacation # Vac-1-84 should the petition be denied we will agree to remove the fence.

Signed
 J. Connelly
 For
 Arthur J. Folk

Done Fresh 4-25-84

CITY OF LAS VEGAS, NEVADA

LOG NO. & AREA _____ DATE _____ CONST. VAL. \$ _____

DEPARTMENT OF BUILDING AND SAFETY 010-474-006 **BUILDING PERMIT**
PHONE 386-6251 FOR: Remodel, Additions, Misc. Residential Const.

ADDRESS OF CONSTRUCTION 420 Harrison OWNER Gertrude Polky

CONTRACTOR OWNER STATE LICENSE NO. _____ CITY LICENSE NO. _____

LOT(s) 1 BLOCK 8 SUBDIVISION HEATH ADD ZONE R-3

PROPOSED CONSTRUCTION: DEMOLITION
BUILDING PERMIT NO. 3688 ELECTRIC PERMIT NO. _____ PLUMBING PERMIT NO. _____ USE: _____ AIR COND. PERMIT NO. _____

ADD'L. PERMITS REQ'D.: Air Cond. ☐ Elec. ☐ Plumbing ☐ Signs ☐ Paving ☐ Fence ☐
Incinerators ☐ Fire Sprinkling System ☐ Off-Site Permit ☐

MATERIALS OF CONSTRUCTION: Wood Frame ☐ Concrete Block ☐ Reinforced Concrete ☐ Steel Frame ☐

SQUARE FEET OF FLOOR AREAS: 1st _____ 2nd _____ 3rd _____ Other _____ TOTAL SQ. FT. _____

ARCHITECT: _____ ENGINEER: _____ NO. of UNITS _____ NO. of STORIES _____

OTHER INSPECTIONS AND FEES

1. Inspections outside of normal business hours = \$25.00 per hour (minimum charge three hours)
2. Re-inspection fee during normal business hours assessed under provisions of TABLE 3-A of the Uniform Building Code = \$15.00 per hour
3. Inspections during normal business hours for which no fee is specifically indicated = \$15.00 per hour (minimum charge one half hour)
4. Additional plan review required by changes, additions or revisions to approved plans = \$25.00 per hour (minimum charge two hours)

CONDITIONS OF THE PERMIT:

1. I agree to call the City Building Department for inspections before concrete is poured, before rough wiring, electrical, plumbing, framing is covered. Also for air conditioning, drywall and sheathing inspection.
2. I agree that when the job is completed that I will call for final inspection before occupancy.
3. I agree to perform all construction in accordance with City Ordinances and Building Codes.
4. The Contractor's signature below denotes authority from the owner to sign in his behalf and that the owner is aware of all requirements of this application and permit. Separate permits must be taken out for work outlined above this agreement.
5. I have read and understand the contents of this application and permit; I hereby state that the information I have supplied on this application is true and correct.

Approval for the work under this permit will be given only after release and debris have been removed from job site and public right of way

BY: *[Signature]* OWNER
I HEREBY DECLARE THAT I AM THE LEGAL OWNER OF THE ABOVE PROPERTY.


BY: *[Signature]* AGENT
DATE 4/13/84

PLANNING DEPT. *[Signature]*
BUILDING DEPT. *[Signature]*
DATE 4/13/84

PLUMBING	FEE	ELECTRICAL	FEE
WATER DISTRIBUTION		RECEPTACLE _____ SWITCH _____	
SEWER SYSTEM - NEW OR MODIFICATION		EACH LIGHT FIXTURE OR SOCKET _____	
FIXTURES - WATER SOFTENER, H.W. HEATER		SPECIAL OUTLET, APPLIANCE ETC.	
GARBAGE DISPOSAL - WASHER, (DISH OR CLOTHES)		ELECTRICAL SERVICE OR PANEL	
FUEL PIPING		A.C. UNIT OR MOTORS	
GAS APPLIANCE OR A.C. UNIT		2310 - 2402 TOTAL	
IRRIGATION SYSTEM		MISC.	
2310 - 2403 TOTAL			
AIR CONDITIONING	FEE		
NEW UNIT			
HEATERS - WALL, CEILING OR FLOOR			
EVAPORATIVE COOLER			
2310 - 2405 TOTAL			

PLAN REVIEW FEE

BLDG. PERMIT FEE
TOTAL FEES 30.00

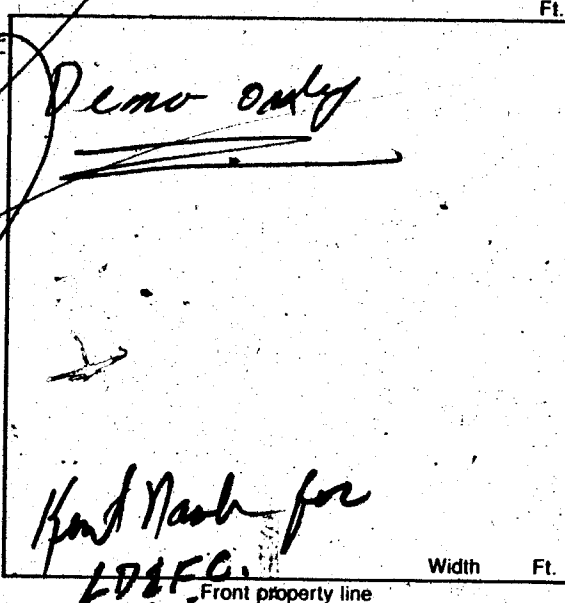

1 JULI \$RECEIPT 00
SFD \$ 30.00
STL \$ 30.00
STL \$ 30.00
TOTL \$ 30.00
CASH \$ 30.00
R#3688 SR#001/01
CITY - LAS VEGAS
BLDG. & SAFETY
04/13/84

PERMIT EXPIRES 180 DAYS AFTER ABANDONMENT OF WORK

MUST BE MACHINE VALIDATED

Mona Lisa 5-30-84

OWNER <i>Gerthie Polk</i>		ADDRESS <i>420 Harrison</i>	
DATE <i>4-16-84</i>		GEN. CONT. <i>Owner</i>	
TYPE OF STRUCTURE <i>DEMOLITION</i>		PERMIT No. <i>3688</i>	
LEGAL DESCRIPTION <i>1/8 NFM & M Addn.</i>		LOG No.	AREA No.
APPROVED FOR OCCUPANCY & METER			
BUILDING		MECHANICAL	
Location & Footing		Plumbing Cont.	
Concrete Slab Floor		Permit No.	Date <i>1</i>
Fireplace Footing		Htg./Vt./A.C. Cont.	
Chimney Steel		Permit No.	Date
Vert. Steel Reinf.		Sewer Cont.	
HORIZ. Steel Reinf.		Permit No.	Date
Framing		Rough Soil	
Ext. Lath		Rough Water	
Roof Sheathing		Tap-Out	
Ext. Brown		Rough Gas	
Insulation		A/C Rough Duct	
Drywall		Final Plumbing	
Final Building <i>EC 629-84</i>		Final Gas	
Appr. for Occu.		Final Air Cond.	
ELECTRICAL		Final Sewer	
Temp. Pole cont.		REMARKS	
Permit No.	Date		
Inspection	Date		
Electrical Cont.			
Permit No.	Date		
Rough		PLEASE NOTE ADDITIONAL REMARKS ON REVERSE SIDE	
Final Electrical		DEPT. OF BLDG. & SAFETY CITY OF LAS VEGAS REV. 82-3-29	
Temporary Service			

M. J. Francis 8-29-84

FENCE & RETAINING WALLS			
OWNER		GERTHIE POLK	
ADDRESS		420 Harrison Ave.	
CONTRACTOR		PERMIT NO.	FINAL INSPECTION
Owner		3010	
LOT	BLOCK	SUBDIVISION	
1	8	FM & M ADD	
LOG #.	AREA		
FENCES (wire, wood, block, & retaining walls)			
1	Location		
2	Footing		
3	Wall Steel		
	1st	2nd	
4	Bond Beam		
	1st	2nd	
5	Final		
	EC8-27-84		
Specify Type Of Fence			
2-1-33 DIV. OF BLDG. & SAFETY CITY OF LAS VEGAS REV. 10-78			