

7217 N. Jones

Yoland: Alter 6-28-82

CITY OF LAS VEGAS, NEVADA

LOG NO. & AREA

DEPARTMENT OF BUILDING AND SAFETY

CONS: 3000

APPLICATION & BUILDING PERMIT for
Fence Wall, Retaining Wall

ADDRESS OF
CONSTRUCTION: 2212 N. Jones

OWNER: J. N. Jones

LOT: 1

BLOCK: 1

SUBDIVISION: 3

SECTION: 19

PLAT: 1

Materials of Construction:

Block

Concrete

Steel

Wood

Chair

PLANS: ☐

ALCS: ☐

ARCHITECT:

ENGINEER:

CONTRACTOR: Owner

STATE

LICENSE:

USE:


Remarks:

TOTAL SQUARE FEET: 1300

TOTAL LINE FEET: 33

CONDITIONS OF THE PERMIT:

1. Any type of retaining wall must be engineered by a Civil or Structural Engineer.
2. If a home owner takes out the Building Permit and the owner sublets the work to a Contractor, then the Contractor must take out the permit and pay for it.
3. No fence or wall can be built on City property or right-of-way. If this is not intended to preclude construction with utility easements if utilities will not be damaged or made inaccessible.
4. The fence or wall shall not enclose any water meter, light standard, or fire alarm box and shall not come closer than 24" from the nearest fire hydrant outlet.
5. Department inspectors must approve footings before concrete is poured and block wall reinforcing before grouting is done.
6. Maximum height of any wall or fence is 6' side and rear yards; 4' maximum in front yard with the vertical surface above the height of 2' - 50% open.
7. I must not obstruct required on-site parking space (2 spaces for each dwelling unit) by the erection of this fence or wall.
8. By the signing of this application I herewith agree to the requirements outlined above.

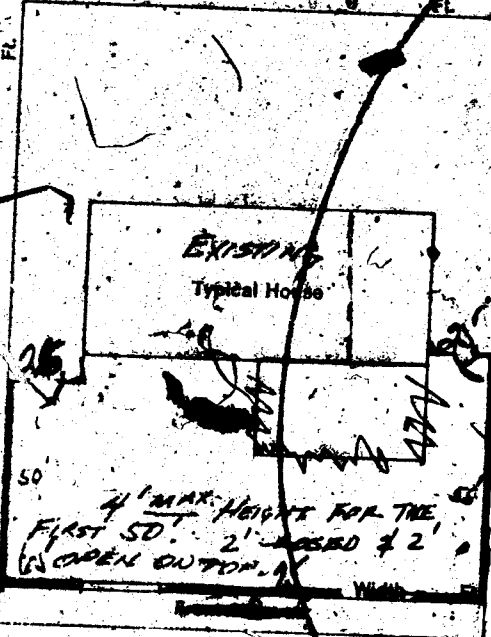

1TONI \$ 00.00
WALL \$ 38.50
STL \$ 38.50
TOTL \$ 77.00
CHK \$ 38.50
R#5262 SN#000001
REV - 1/83 (1/3/81)
11/08/81

SIGNED: [Signature]

CONTRACTOR ☐ AGENT ☐

PLANNING DEPT: [Signature]

Date: 11/3/81

PUBLIC WORKS DEPT: C. D. [Signature]

Date: 11/3/81

BUILDING DIVISION: [Signature]

Date: 11/3/81

PERMIT NO: 5262

PERMIT FEE: 38.50

RECEIPT

MUST BE MACHINE VALID

STACKE B.

2-20-86

FENCE & RETAINING WALL			
OWNER Lynn Wedaworth		DATE 11-3-81	
ADDRESS 7217 S. Jones			
CONTRACTOR Cramer		PERMIT NO. 5269	FINAL INSPECTION Blk wall
LOT Pt 82, SW 1/4, SEC 13, T15N, R9E	BLOCK	SUBDIVISION	
LOG #	AREA		
FENCE TYPE, WALL, & RETAINING WALL			
1	Location		
2	Fence		
3	Wall Detail		
4	1st		
5	2nd		
6	3rd		
7	Final		
Specify Type Of Paper			
2-2-86			