

825 N. Lamb #176

N $\frac{1}{2}$ SW $\frac{1}{4}$ Sec. 29 T-20-S. R-62 E. Z-RT

16-09
H. Gatewood 9-20-79

CITY OF LAS VEGAS, NEVADA

LOG NO. & AREA

CONST. VAL. \$

DEPARTMENT OF PUBLIC SERVICES
DIVISION OF BUILDING AND SAFETY

APPLICATION & BUILDING PERMIT - for:
Dwellings, Duplexes, Misc. Residential Const.

ADDRESS OF
CONSTRUCTION:

8257 N. Lamb #176

OWNER:

TOM BORASKI

LOT(S)

PORTION N1/2 BLK 4 SEC 29 T20S R62E RT

Existing structure on lot:

Dwelling ☐

Accessory Bldgs. ☐

Vacant Lot ☐

Other ☐

PROPOSED CONSTRUCTION:

MOBILE HOME INSP

USE:

AES

MATERIALS OF CONSTRUCTION:

Wood Frame ☐

Concrete Block ☐

Reinforced Concrete ☒

Steel Frame ☐

SQUARE FEET OF FLOOR AREAS: 1st

2nd

3rd

Other

TOTAL SQ. FT.

FIRE ZONE:

Occupancy Group

CONST. TYPE:

ARCHITECT:

ENGINEER:

NO. of UNITS

NO. of STORIES

Plans Submitted:

Yes ☐

No ☐

Calculations Submitted:

Yes ☐

No ☐

Sewer Fee Req'd.

Yes ☐

No ☐

CONTRACTOR:

OWNED

STATE
LICENSE #

CITY
LICENSE #

ADD'L. PERMITS REQ'D:

Air Cond. ☐

Elec. ☐

Plumbing ☐

Signs ☐

Paving ☐

Fence ☐

Public Walks ☐

Submitters ☐


Incinerators ☐

Fire Sprinkling System ☐

CONDITIONS OF THE PERMIT:

1. I agree to call the City Building Department for inspections before concrete is poured, before rough wiring, electrical, plumbing, framing is covered. Also for Air conditioning, drywall and sheathing inspection.
2. I agree that when the job is completed that I will call for final inspection before occupancy.
3. I agree to perform all construction in accordance with City Ordinances and Building Codes.
4. The Contractor's signature below denotes authority from the owner to sign in his behalf and that the owner is aware of all requirements of this application and permit. Separate permits must be taken out for work outlined above this agreement.
5. I have read and understand the contents of this application and permit hereby state that the information I have supplied on this application is true and correct.

Approval for the work under this permit will be given only after refuse and debris have been removed from job site and public right of way.

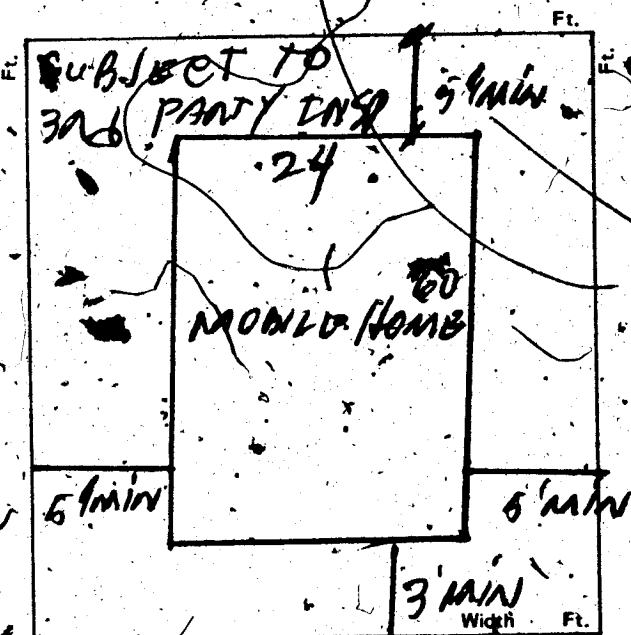

SIGNED

Tom Boraski

Contractor

BY


Agent or Owner

PLANNING DEPT.:

Date:

9-16-79

PUBLIC WORKS DEPT.:

Date:

9-16-79

BUILDING DIVISION:

Date:

9-16-79

PERMIT NO.:

306.9

PERMIT FEE \$

10.00

154-01-220

RECEIPT

MUST BE MACHINE VALIDATED

CITY OF LAS VEGAS, NEVADA

LOG NO. & AREA

DEPARTMENT OF PUBLIC SERVICES
DIVISION OF BUILDING AND SAFETY

CONST. VAL. \$

APPLICATION & BUILDING PERMIT
Dwellings, Duplexes, Misc. Residential Const.

ADDRESS OF
CONSTRUCTION

825 N. LAMAR #176

OWNER

GARY MERRILL

LOT(s)

TRUCKEE DIVISION

RANCHO VEGAS #176

ZONE

PMHP

Existing structure on lot:

Dwelling ☐

Accessory Bldg. ☐

Vacant lot ☐

Other ☐

PROPOSED CONSTRUCTION:

ALUM AWNING & RAISED DECK

USE: PATIO/CARPORT

MATERIALS OF CONSTRUCTION:

Wood Frame ☐

Concrete Block ☐

Reinforced Concrete ☐

Steel Frame ☐

SQUARE FEET

FLOOR AREAS: 1st

2nd

3rd

Other

TOTAL SQ. FT.

300 SPAWN
16039 DECK

FIRE ZONE:

Occupancy Group

CONST. TYPE:

ARCHITECT:

ENGINEER:

NO. of UNITS

NO. of STORIES

Plans Submitted:

Yes ☐

No ☐

Calculations Submitted:

Yes ☐

No ☐

Sewer Fee Req'd:

Yes ☐

No ☐

CONTRACTOR:

SIKING BUILDERS

STATE

LICENSE # 12444

CITY

LICENSE # C11-12114

ADD'L. PERMITS REQ'D:

Air Cond. ☐

Elec. ☐

Plumbing ☐

Signs ☐

Paving ☐

Fence ☐

Public Walks ☐

Curb-gutters ☐

Incinerators ☐

Fire Sprinkling System ☐

CONDITIONS OF THE PERMIT:

- I agree to call the City Building Department for inspections before concrete is poured, before rough wiring, electrical, plumbing, framing is covered. Also for Air conditioning, drywall and sheathing inspection.
- I agree that when the job is completed that I will call for final inspection before occupancy.
- I agree to perform all construction in accordance with City Ordinances and Building Codes.
- The Contractor's signature below denotes authority from the owner to sign in his behalf and that the owner is aware of all requirements of this application and permit. Separate permits must be taken out for work outlined above this agreement.
- I have read and understand the contents of this application and permit. I hereby state that the information I have supplied on this application is true and correct.

Approval for the work under this permit will be given only after refuse and debris have been removed from job site and public right of way.

SIGNED


SUNSHIELD AWNING

Contractor

BY:

G.C. Jahn

Agent or Owner

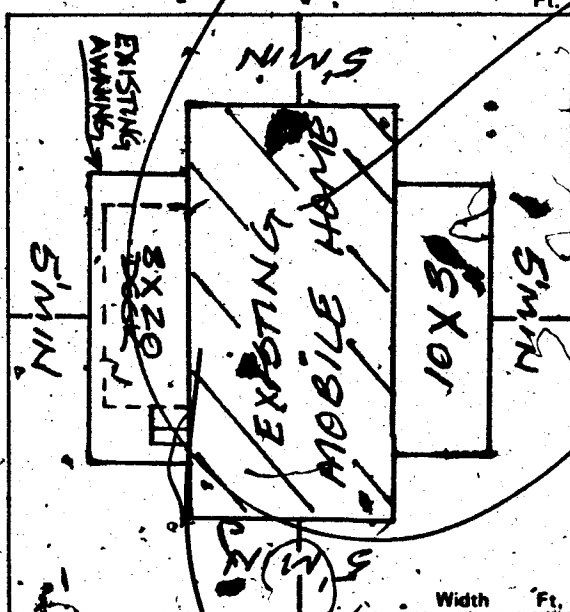

PLANNING DEPT.

Date:

6/2/81

PUBLIC WORKS DEPT.

Date:

6-12-81

BUILDING DIVISION:

Date:

6/12/81

PERMIT NO.:

2005-6

PERMIT FEE \$

32.50

1721-2401

RECEIPT

MUST BE MACHINE VALIDATED

Dona Hovely 9-21-82

OWNER Tom Bonaski ADDRESS 825 N. Lamb #176

DATE 4-16-79 GEN. CONT. Owner

TYPE OF STRUCTURE Mobile home PERMIT NO. 3069 FINAL INSPECTION

LEGAL DESCRIPTION Portion N. SW 1/4, Sec 29, T20S, R62E LOG # AREA #

APPROVED FOR OCCUPANCY & METER

BUILDING	MECHANICAL
Investigation	Plumbing Cont.
Location & Footing	Permit No. Date
Concrete Slab Floor	Heat & Vent. A/C Cont.
Fireplace Footing	Permit No. Date
Chimney Steel	Sewer Cont.
Vert. Steel Reinf.	Permit No. Date
Horiz. Steel Reinf.	Rough Soil
Framing	Rough Water
Ext. Lath	Top-Out
Ext. Brown	Rough Gas
Drywall	A/C Rough Duct
Final Building FC 4-19-79	Final Plumbing
Appr. for Occu.	Final Gas
ELECTRICAL	Final Air Cond.
Temp. Pole Cont.	Final Sewer
Permit No. Date	REMARKS
Inspection Date	
Electrical Cont.	
Permit No. Date	
Rough	PLEASE NOTE ADDITIONAL REMARKS ON REVERSE SIDE.
Final Rough	DIV. OF BLDG. & SAFETY CITY OF LAS VEGAS REV. 10-78
Final Electrical	79-3-16
Temporary Service	

OWNER Gary Merrill ADDRESS 825 N. Lamb #176

DATE 6-12-81 GEN. CONT. Viking Builders

Alum Awning/Deck 2005-6 TYPE OF STRUCTURE PERMIT NO. FINAL INSPECTION

LEGAL DESCRIPTION See application LOG # AREA #

APPROVED FOR OCCUPANCY & METER

BUILDING	MECHANICAL
Investigation	Plumbing Cont.
Location & Footing	Permit No. Date
Concrete Slab Floor	Heat & Vent. A/C Cont.
Fireplace Footing	Permit No. Date
Chimney Steel	Sewer Cont.
Vert. Steel Reinf.	Permit No. Date
Horiz. Steel Reinf.	Rough Soil
Framing	Rough Water
Ext. Lath	Top-Out
Ext. Brown	Rough Gas
Drywall	A/C Rough Duct
Final Building RB 7-6-81	Final Plumbing
Appr. for Occu.	Final Gas
ELECTRICAL	Final Air Cond.
Temp. Pole Cont.	Final Sewer
Permit No. Date	REMARKS
Inspection Date	
Electrical Cont.	
Permit No. Date	
Rough	PLEASE NOTE ADDITIONAL REMARKS ON REVERSE SIDE.
Final Rough	DIV. OF BLDG. & SAFETY CITY OF LAS VEGAS REV. 10-78
Final Electrical	79-3-16
Temporary Service	