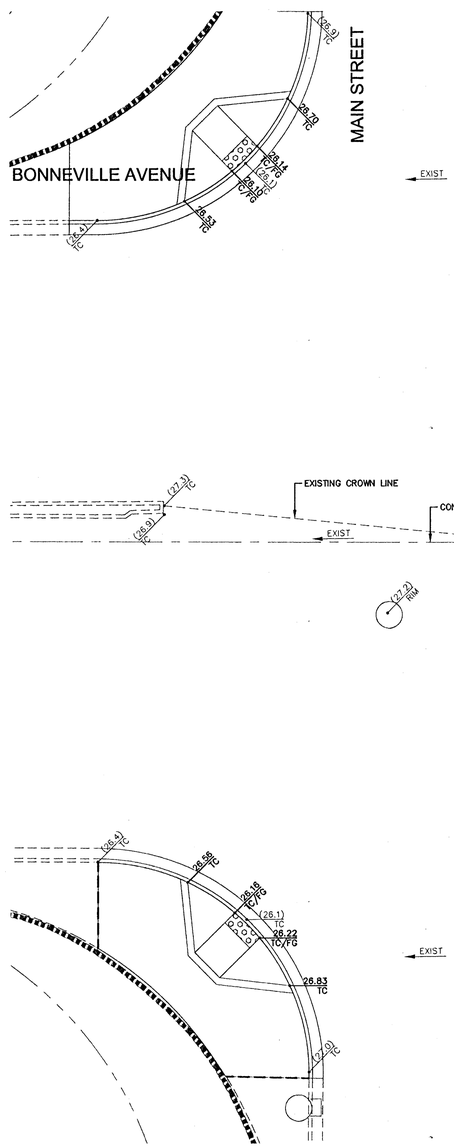

BONNEVILLE/MAIN INTERSECTION GRADING

1":10'

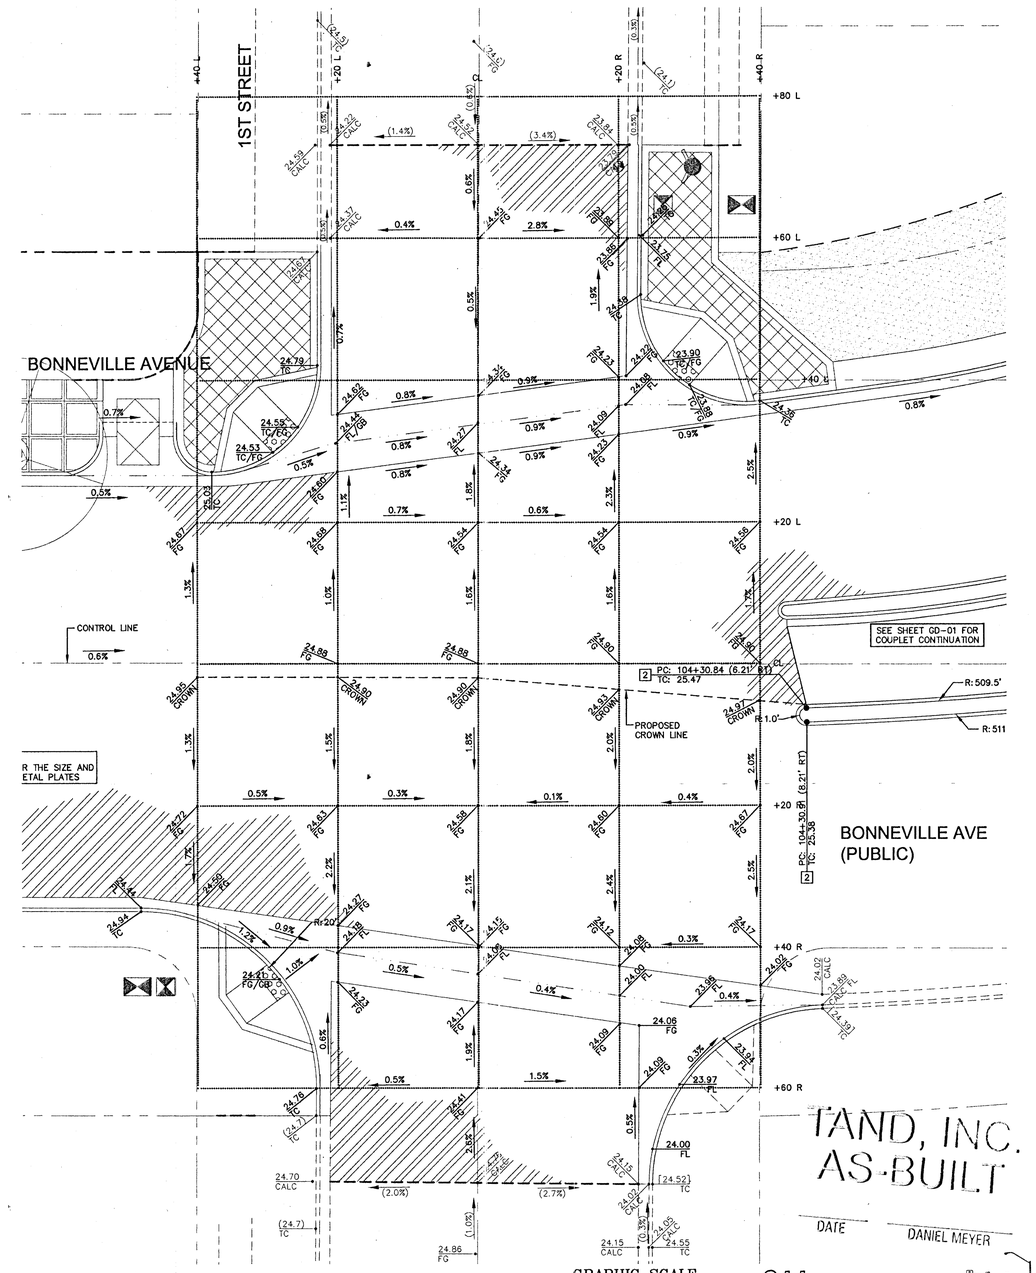

BONNEVILLE/1ST INTERSECTION GRADING

1":10'

GRAPHIC SCALE

(IN FEET)

811 know what's below Call before you dig

SAFETY ALERT Call Before You Overhead 1-702-227-2929

Call before you UnderGround 1-702-432-5300

REVISIONS	DATE

SCALE (H): 1":10' | SCALE (V): N/A | DATE: FEBRUARY 2010

DRAWN BY: TEA | DESIGNED BY: TEA | CHECKED BY: PM/CC

Kimley-Horn and Associates, Inc.
Engineering, Planning, and Environmental Consultants
2080 E. Flamingo Road, Suite 210, Las Vegas, NV 89119
PH. (702) 734-5666 FAX (702) 735-4949

© 2010

CITY OF LAS VEGAS

DEPARTMENT OF PUBLIC WORKS

PROJECT: BONNEVILLE/CLARK ONEWAY COUPLET PHASE 1 IMPROVEMENT PLANS

SHEET: GRADING DETAIL INTERSECTION GRADING SHEET

PROFESSIONAL ENGINEER-STATE OF NEVADA
PETER N. MEYERHOFER
Exp: 12/31/11
CIVIL
No. 18093

SHEET NO. GD-05
SHEET 31 OF 91
DRAWING NO. 107V5201

BID# 09.1730.37

Apr 25, 2010 - 9:04pm - USER peter.meyerhofer
\\LAVFP01\Projects\LAV_PublicTrans\092256\019 Bonneville-Clark 2008\CADD\25601bgd-03_09.dwg

20130452