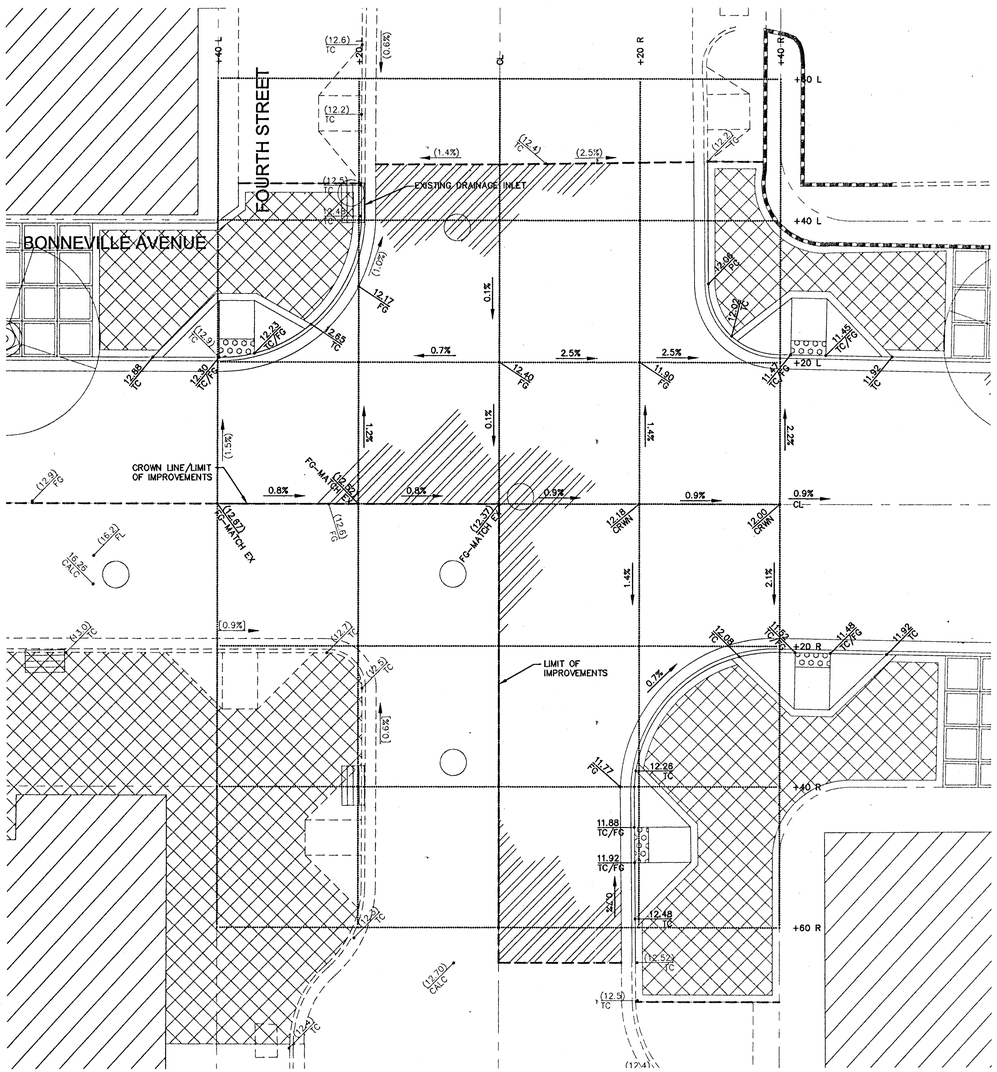

BONNEVILLE/4TH INTERSECTION GRADING

1":10'

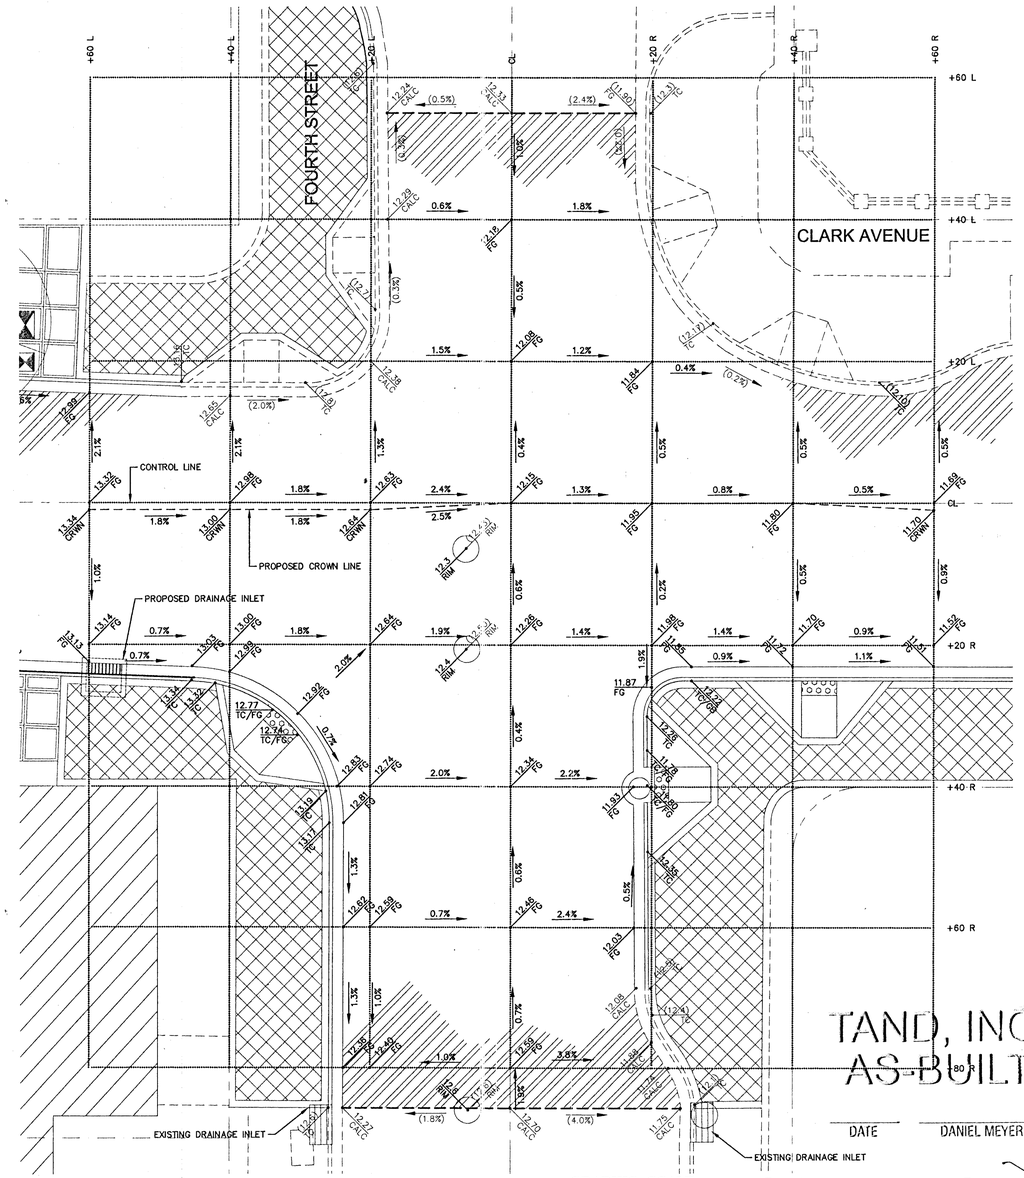

CLARK/4TH INTERSECTION GRADING

1":10'

TAND, INC.
AS-BUILT

DATE DANIEL MEYER

GRAPHIC SCALE

10 0 5 10 20

(IN FEET)

811 know what's below Call before you dig 1-702-227-2929

SAFETY ALERT Call Before You Overhead

CALL BEFORE YOU DIG! HAVE YOUR UNDERGROUND FACILITIES MARKED BY LOCAL UTILITIES

Call before you UnderGround 1-702-432-5300

FREEWAY AND ARTERIAL SYSTEM OF TRANSPORTATION

REVISIONS | DATE

SCALE (H): 1"=10' | SCALE (V): N/A | DATE: FEBRUARY 2010

DRAWN BY: TEA | DESIGNED BY: TEA | CHECKED BY: PM/CC

Kimley-Horn and Associates, Inc.
Engineering, Planning, and Environmental Consultants
2080 E. Flamingo Road, Suite 210, Las Vegas, NV 89119
PH. (702) 734-5666 FAX (702) 735-4949

© 2010

CITY OF LAS VEGAS NEVADA

DEPARTMENT OF PUBLIC WORKS

PROJECT: BONNEVILLE/CLARK ONEWAY COUPLET PHASE 1 IMPROVEMENT PLANS

SHEET: GRADING DETAIL INTERSECTION GRADING SHEET

PROFESSIONAL ENGINEER STATE OF NEVADA PETER N. MEYERHOFER Exp: 12/31/11 CIVIL No. 18093

SHEET NO. GD-07

SHEET 33 OF 91

DRAWING NO. 107V5201

BID# 09.1730.37

Apr 25, 2010 - 9:05am - USER peter.meyerhofer
\\LAVFP01\Projects\LAV_Public Trans\092256\019 Bonneville-Clark 2008\CADD\256019gd-03_09.dwg

20130154