## STREET LIGHTING SCHEDULE

| POLE No. | WATTAGE | STREET | STATION AND OFFSET | SERVICE METER | NOTES |
|---|---|---|---|---|---|
| (1) | 250 | BONNEVILLE | 101+10.4, 29.0' LT | NEW TS/SL SERVICE "1" SW CORNER OF FIRST AND BONNEVILLE SEE TS SHEETS FOR DETAILS ⟨F⟩ | CIRCUIT 1-B SEE NOTE A |
| (2) | 250 | BONNEVILLE | 102+28.6, 29.0' LT | | |
| (3) | 250 | BONNEVILLE | 101+62.7, 36.5' RT | | |
| (4) | 250 | BONNEVILLE | 102+82.7, 36.5' RT | | |
| (5) | 250 | BONNEVILLE | 104+79.7, 56.4' LT | EXISTING SERVICE ADDRESS: 018 CLARK | SEE NOTE A |
| (6) | 250 | BONNEVILLE | 109+26.8, 22.5' RT | EXISTING SERVICE ADDRESS: 212 BONNEVILLE | SEE NOTE A |
| (7) | 250 | BONNEVILLE | 110+46.6, 29.5' RT | | |
| (8) | 250 | BONNEVILLE | 114+03.8, 23.2' LT | EXISTING SERVICE ADDRESS: 324 LEWIS | SEE NOTE A |
| (9) | 250 | BONNEVILLE | 116+26.0, 22.6' LT | NEW TS/SL SERVICE "2" SE CORNER OF LV BLVD. AND BONNEVILLE SEE TS SHEETS FOR DETAILS ⟨K⟩ | SEE NOTE A |
| (10) | 250 | BONNEVILLE | 116+88.1, 25.3' RT | | |
| (11) | 250 | BONNEVILLE | 117+72.8, 20.0' LT | | |
| (12) | 250 | BONNEVILLE | 118+17.0, 27.8' RT | | |
| (13) | 250 | CLARK | 208+59.2, 40.4' RT | EXISTING SERVICE ADDRESS: 018 CLARK | SEE NOTE A |
| (14) | 250 | RUE CLARK | 13+38.7, 28.8' RT | | |
| (15) | 250 DOUBLE ARM | RUE CLARK | 10+84.6, 0.3' RT | | |
| (16) | 250 | RUE CLARK | 12+69.4, 24.5' LT | | |
| (17) | 250 | RUE CLARK | 14+29.6, 2.2' RT | | |
| (18) | 250 | CLARK | 205+98.7, 3.0' LT | | |
| (19) | 250 | CLARK | 212+45.1, 24.0' LT | NEW TS/SL SERVICE "3" NE CORNER OF THIRD AND CLARK SEE TS SHEETS FOR DETAILS ⟨B⟩ | SEE NOTE A |
| (20) | 250 | CLARK | 213+73.2, 23.2' LT | | |
| (21) | 250 | CLARK | 212+85.3, 22.9' RT | | |
| (22) | 250 | CLARK | 214+27.5, 27.9' RT | | |
| (23) | 250 | CLARK | 216+58.0, 27.5' LT | EXISTING SERVICE ADDRESS: 601 BONNEVILLE | SEE NOTE A |
| (24) | 250 | CLARK | 217+41.6, 27.5' RT | | |
| (25) | 250 | CLARK | 217+99.2, 27.5' LT | | |
| (26) | 250 RELOCATION | LAS VEGAS BLVD. | 13+05.3, 4.6' LT | EXISTING SERVICE ADDRESS: 487 GASS | SEE NOTE A |

NOTE A: SEE SHEETS SL-07 TO SL-08 FOR SERVICE PEDESTAL CAPACITY CALCULATIONS

## CENTENNIAL STANDARD STREETLIGHT POLES TO BE RELOCATED. [Q]

| | | | |
|---|---|---|---|
| ⟨1⟩ | BONNEVILLE AVE | STA: 106+00 | NORTH SIDE |
| ⟨2⟩ | BONNEVILLE AVE | STA: 111+00 | NORTH SIDE |
| ⟨3⟩ | 3RD ST | STA: 10+38 | EAST SIDE |
| ⟨4⟩ | BONNEVILLE AVE | STA: 111+89 | SOUTH SIDE |
| ⟨5⟩ | 4TH ST | STA: 9+36 | WEST SIDE |
| ⟨6⟩ | CLARK AVE | STA: 206+10 | NORTH SIDE |
| ⟨7⟩ | CLARK AVE | STA: 210+97 | NORTH SIDE |
| ⟨8⟩ | 3RD ST | STA: 14+44 | WEST SIDE |
| ⟨9⟩ | CLARK AVE | STA: 214+60 | NORTH SIDE |

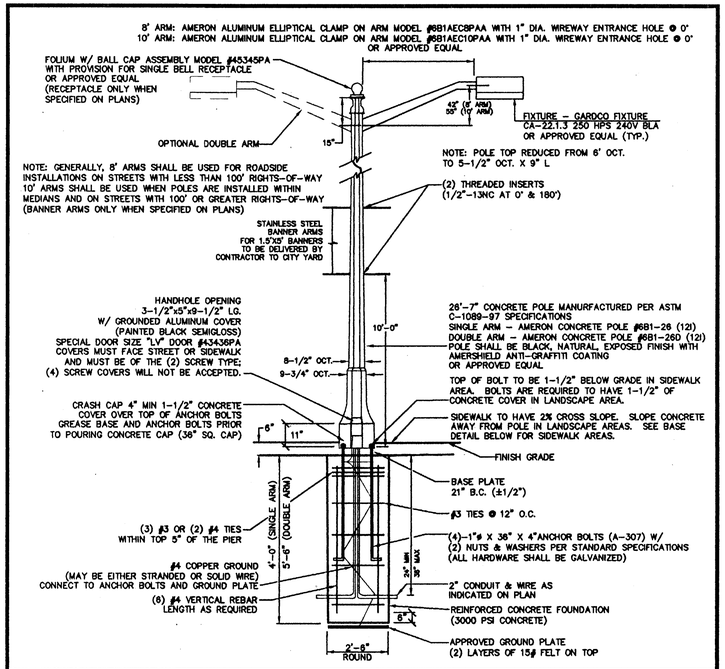


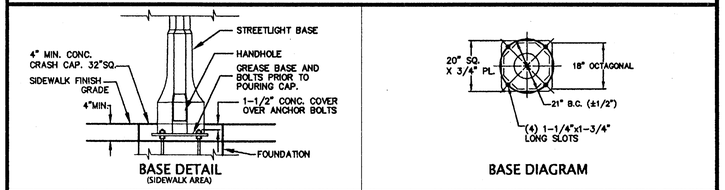


| SPECIFICATION REFERENCE | |
|---|---|
| | |
| | |
| | |
| | |
| | |
| | |

**STANDARD DRAWINGS**
**CITY OF LAS VEGAS, NEVADA**

STREET LIGHT POLE

SCALE: N.T.S.

DATE: 10-14-2008 | DWG. NO. 303-DC/TC

TAND, INC.
AS-BUILT

DATE DANIEL MEYER

811 know what's below Call before you dig 1-702-227-2929

SAFETY ALERT Call Before You Overhead

Call before you UnderGround 1-702-432-5300

| REVISIONS | DATE |
|---|---|
| SHEET REPLACEMENT | 6/21/10 |

DATE: FEBRUARY 2010 | CHECKED BY: RC/RF | © 2010

SCALE (V): N/A | DESIGNED BY: WSW

SCALE (H): 1"=30' | DRAWN BY: WSW

Kimley-Horn and Associates, Inc.
Engineering, Planning, and Environmental Consultants
2080 E. Flamingo Road, Suite 210, Las Vegas, NV 89119
PH. (702) 734-5666
FAX (702) 735-4949

DEPARTMENT OF PUBLIC WORKS

PROJECT: BONNEVILLE/CLARK ONEWAY COUPLET PHASE 1 IMPROVEMENT PLANS

SHEET: STREET LIGHT - INTERCONNECT DETAILS

STATE OF NEVADA — RANDY W. CARROLL — Exp. 12/31/10 — CIVIL — No. 16131 — 6-21-10

SHEET NO. SL-06
SHEET 47 OF 91
DRAWING NO. 107V5201

BID# 09.1730.37 REV 3

Jun 21, 2010 - 1:32pm - USER peter.meyerhofer
\\LAVP01\Projects\LAV_PublicTrans\092256\019 Bonneville-Clark 2008\CADD\256019a-01_10.dwg

20130468