



Apr. 25, 2010 - 4:03pm - USER: peter.meyerhofer  
 \\LAWF001\Projects\LA\_V\_P\Public\Drawings\2008\CADD\256019a-01\_10.dwg

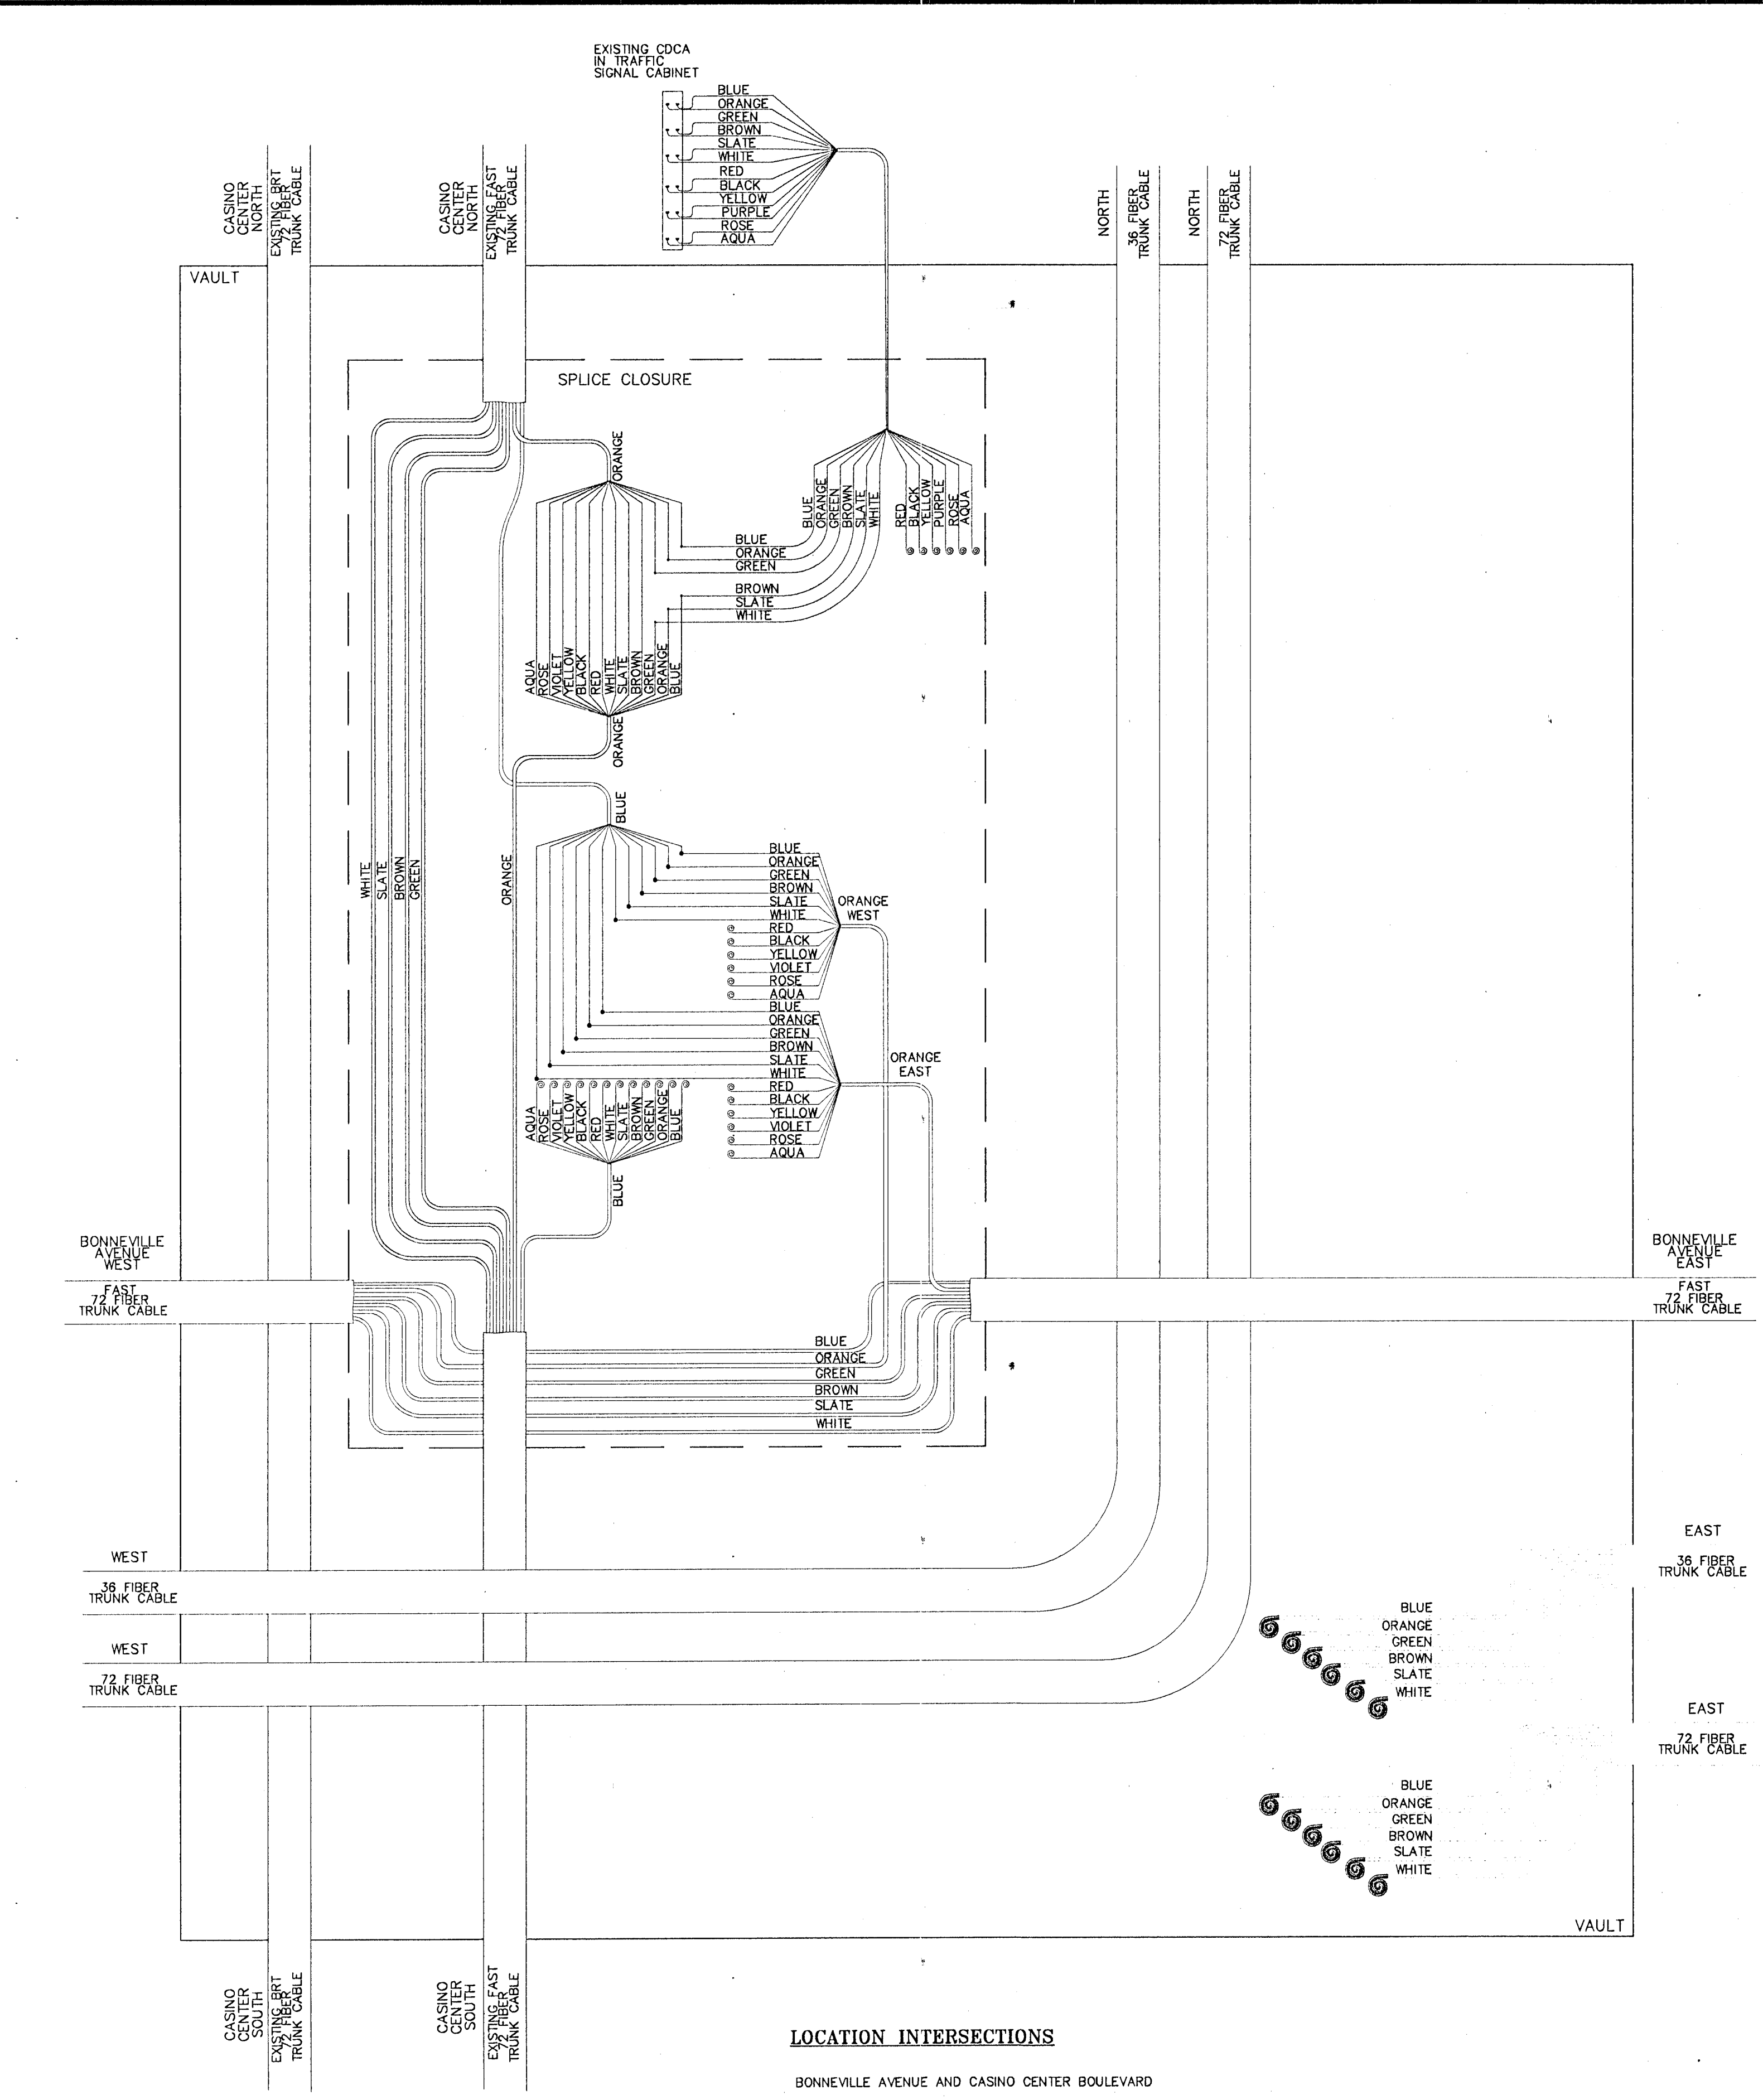

LOCATION INTERSECTIONS  
 BONNEVILLE AVENUE AND CASINO CENTER BOULEVARD

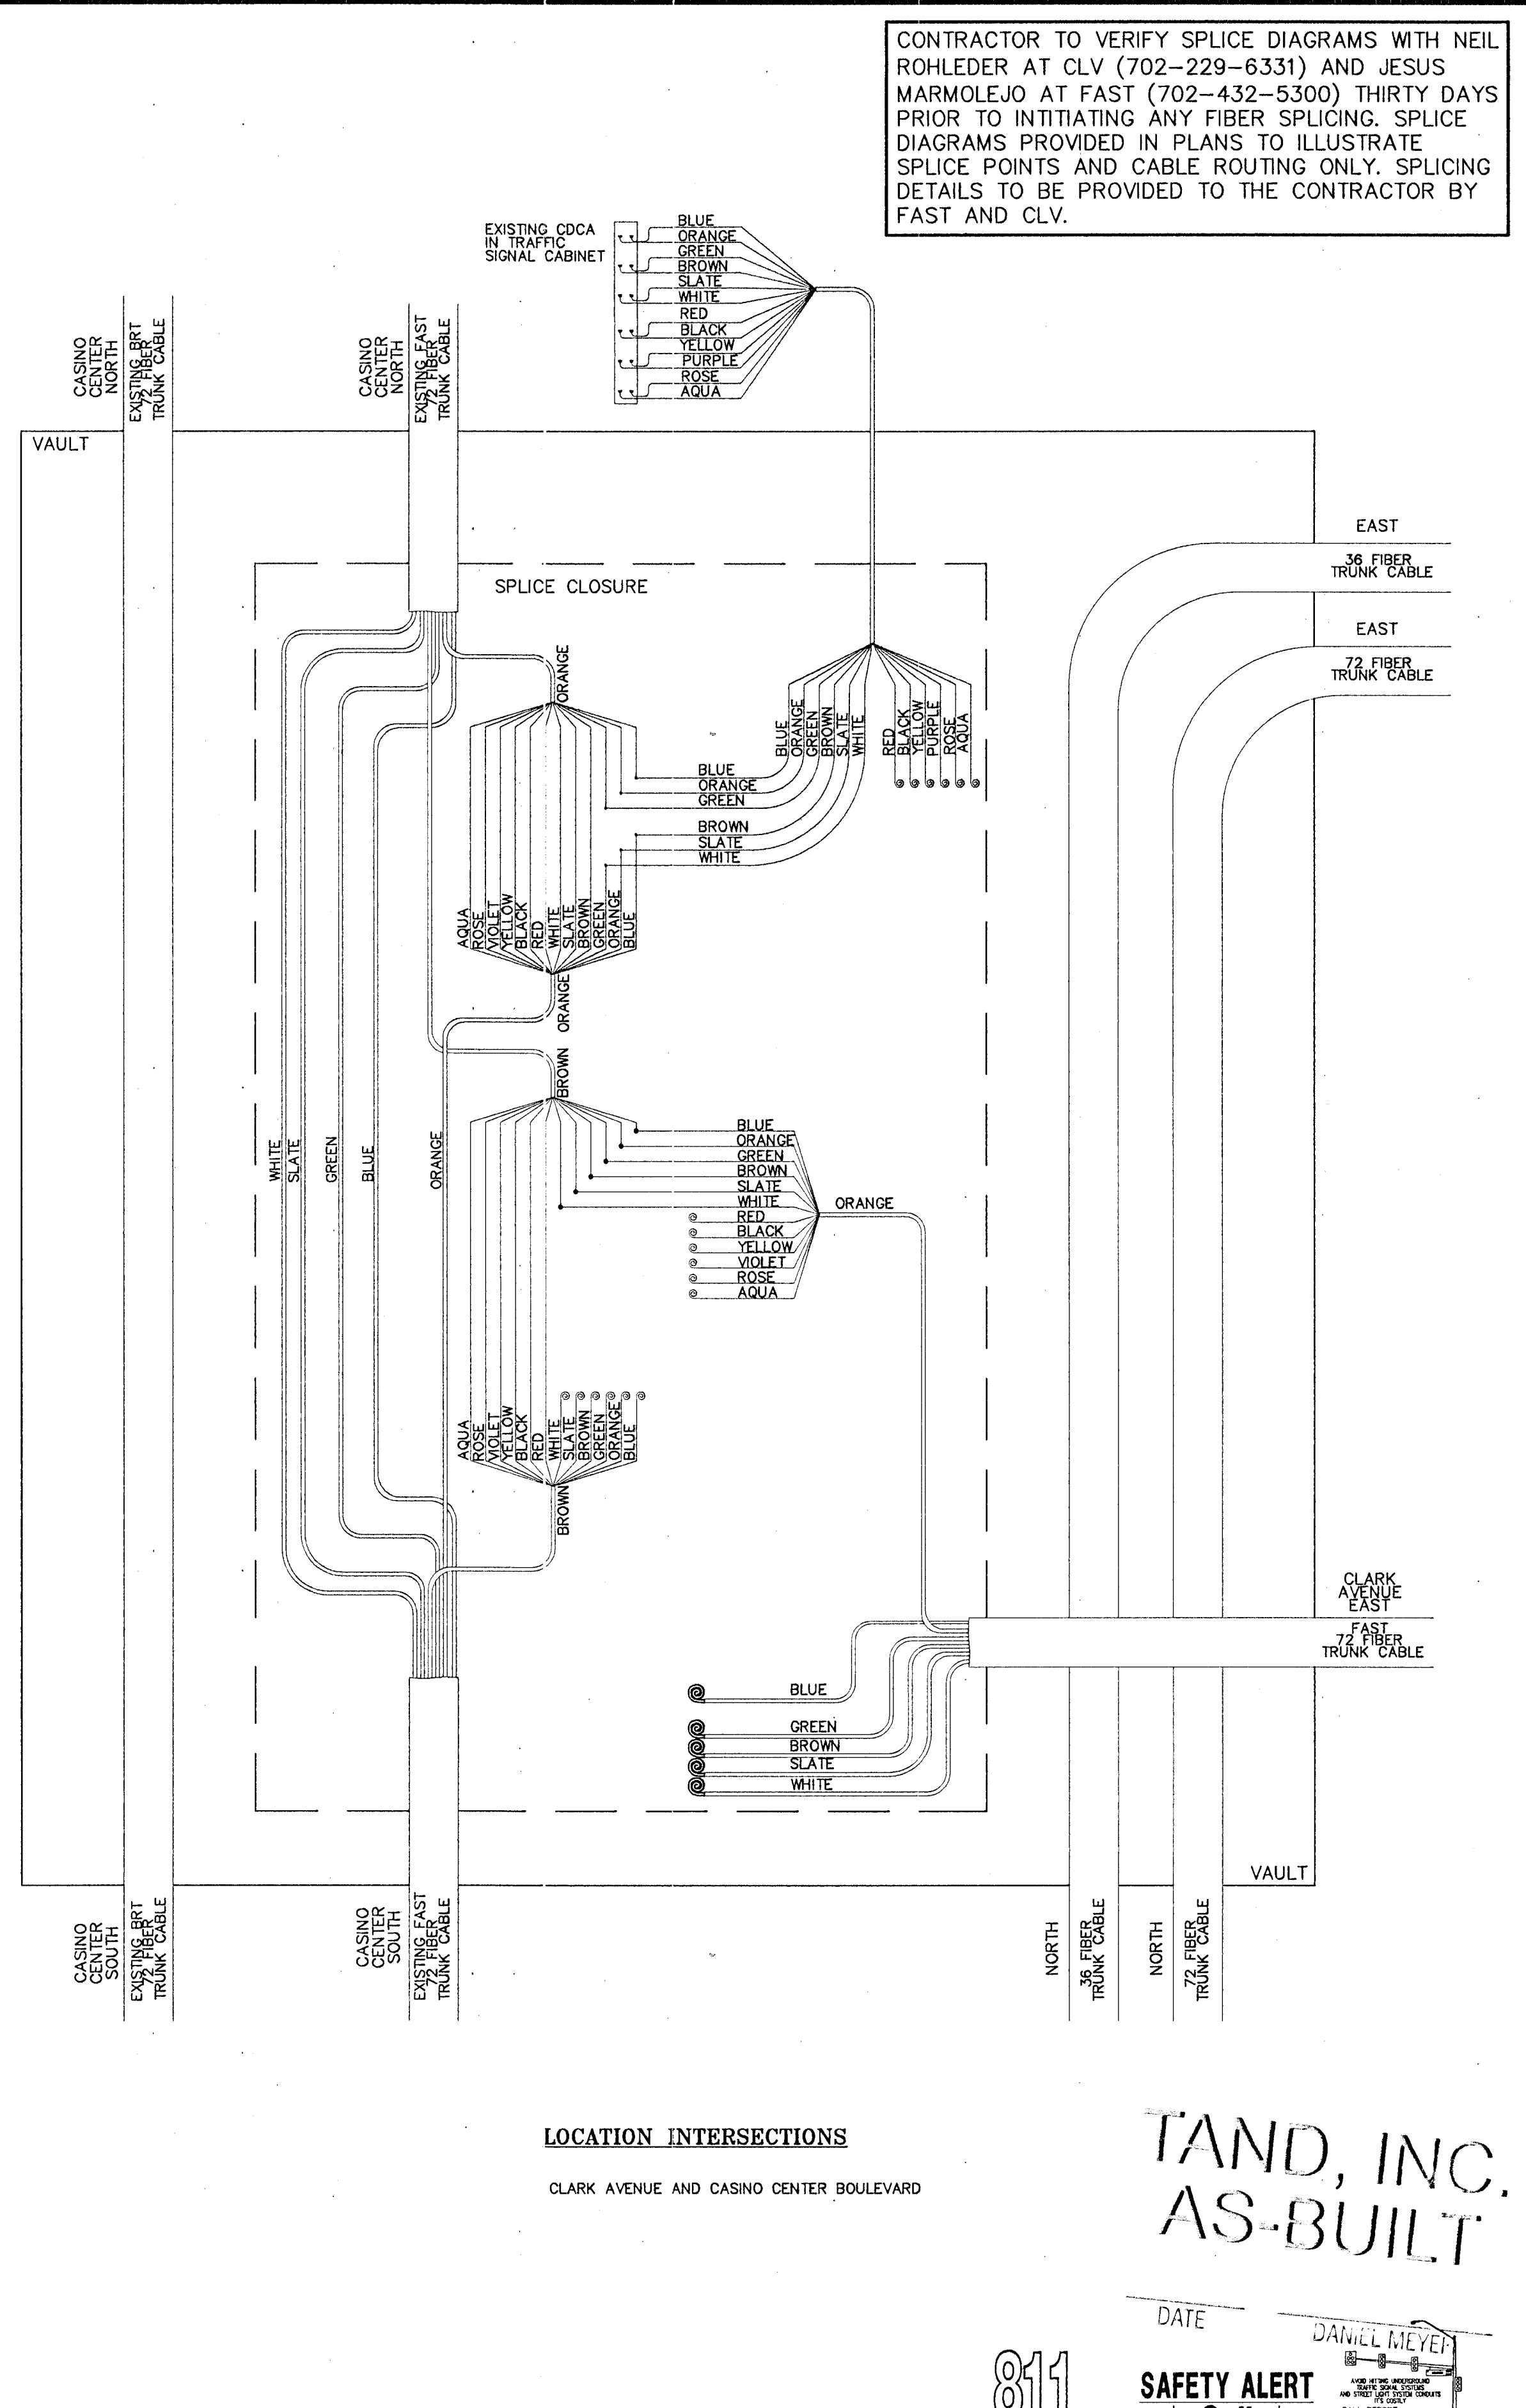

LOCATION INTERSECTIONS  
 CLARK AVENUE AND CASINO CENTER BOULEVARD

CONTRACTOR TO VERIFY SPLICE DIAGRAMS WITH NEIL ROHLER AT CLV (702-229-6331) AND JESUS MARMOLEJO AT FAST (702-432-5300) THIRTY DAYS PRIOR TO INITIATING ANY FIBER SPLICING. SPLICE DIAGRAMS PROVIDED IN PLANS TO ILLUSTRATE SPLICE POINTS AND CABLE ROUTING ONLY. SPLICING DETAILS TO BE PROVIDED TO THE CONTRACTOR BY FAST AND CLV.

DATE	REVISIONS
DATE: FEBRUARY 2010	CHECKED BY: RF/RWC
SCALE (V):	DESIGNED BY: RWC
SCALE (H): 1"=20'	DRAWN BY: WSW
 <b>Kimley-Horn and Associates, Inc.</b> Engineering, Planning, and Environmental Consultants 2080 E. Flamingo Road, Suite 210, Las Vegas, NV 89119 PH: (702) 735-4949 FAX: (702) 735-5666	
 <b>DEPARTMENT OF PUBLIC WORKS</b>	
PROJECT: <b>BONNEVILLE/CLARK ONEWAY COUPLER PHASE 1 IMPROVEMENT PLANS</b>	
SHEET: <b>FIBER OPTIC SPLICE DETAILS</b>	
 <b>RANDY W. CARROLL</b> Exp. 12/31/10 CIVIL	
SHEET NO: SL-10 SHEET 51 OF 91 DRAWING NO: 107V5201	

811  
 know what's below  
 Call before you dig 1-702-227-2929

**SAFETY ALERT**  
 Call Before You Overhead

DATE: \_\_\_\_\_  
 DANIEL MEYER

BEFORE YOU UNDERGROUND  
 CALL BEFORE YOU OVERHEAD  
 1-702-432-5300

20130472

BID# 09.1730.37