CONTRACTOR TO VERIFY SPLICE DIAGRAMS WITH NEIL ROHLEDER AT CLV (702-229-6331) AND JESUS MARMOLEJO AT FAST (702-432-5300) THIRTY DAYS PRIOR TO INTITIATING ANY FIBER SPLICING. SPLICE DIAGRAMS PROVIDED IN PLANS TO ILLUSTRATE SPLICE POINTS AND CABLE ROUTING ONLY. SPLICING DETAILS TO BE PROVIDED TO THE CONTRACTOR BY FAST AND CLV.

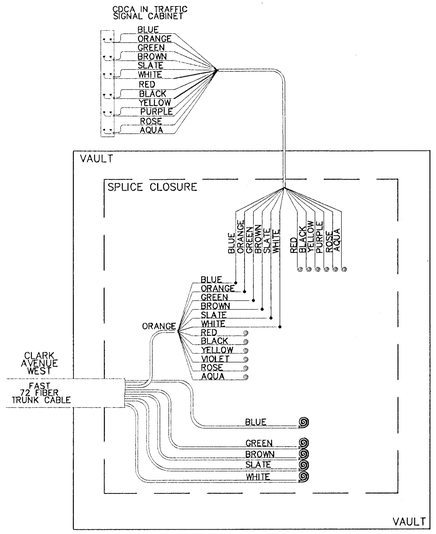

LOCATION INTERSECTIONS

CLARK AVENUE AND LAS VEGAS BOULEVARD

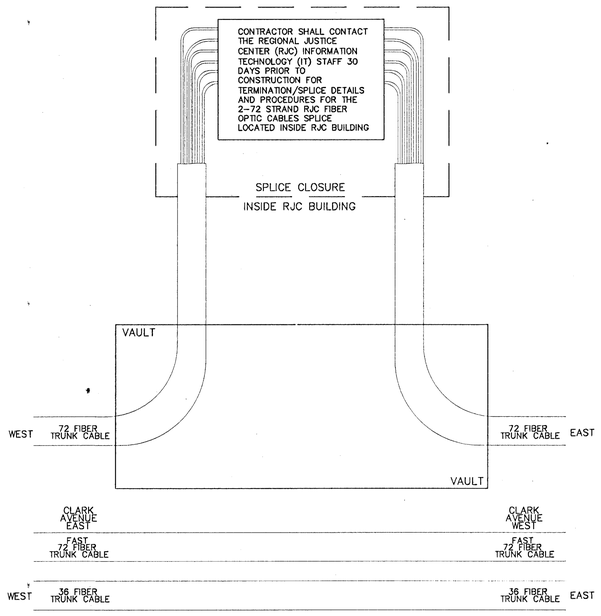

LOCATION INTERSECTION

CLARK AVENUE AND RJC VAULT BETWEEN 3RD STREET AND CASINO CENTER BOULEVARD

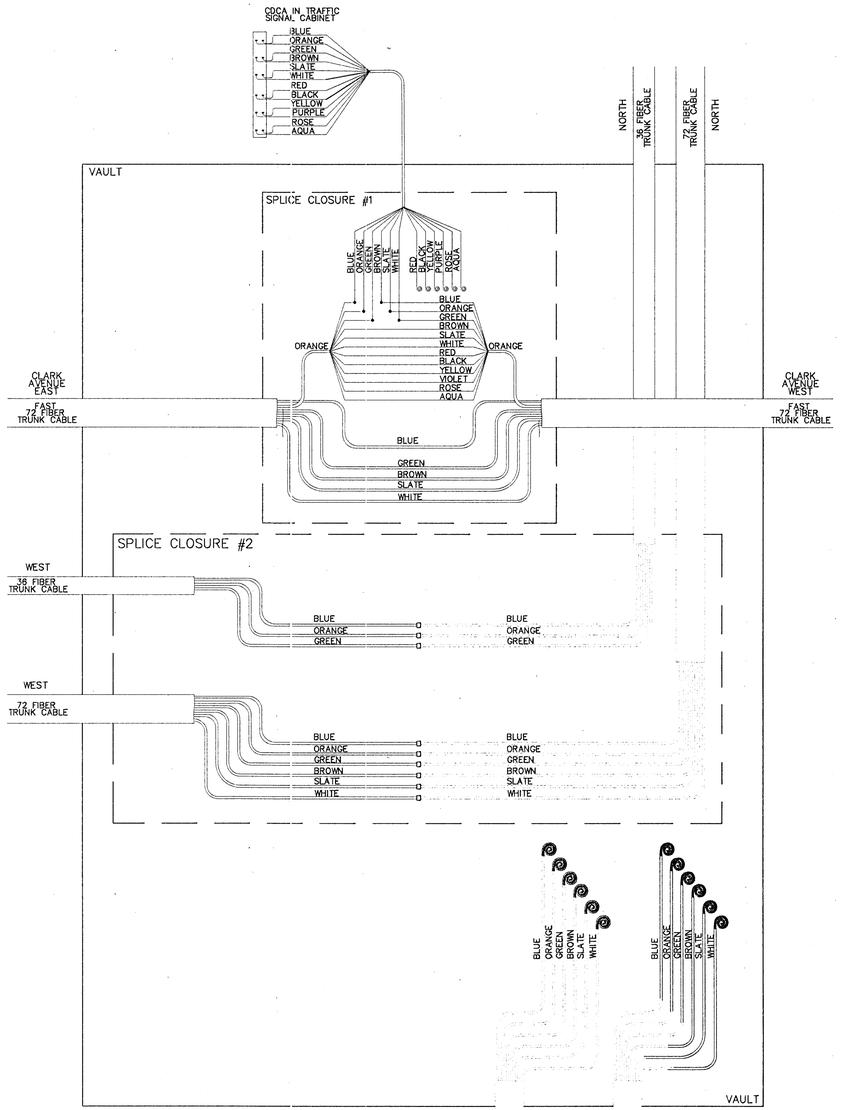

LOCATION INTERSECTIONS

CLARK AVENUE AND 4TH STREET

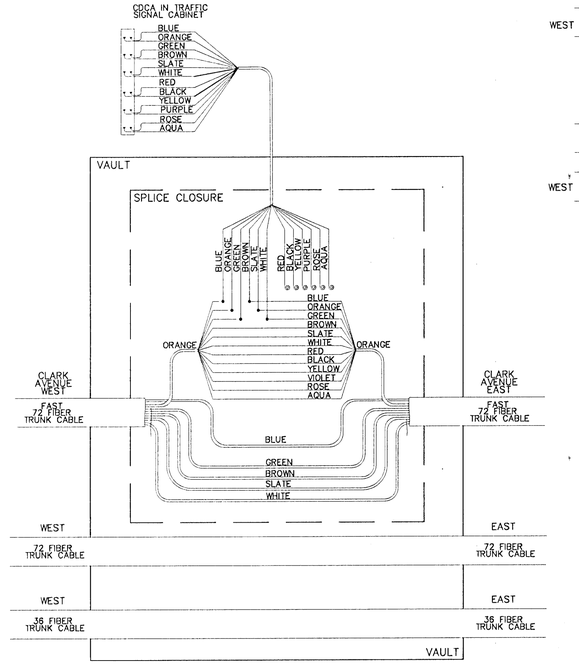

LOCATION INTERSECTION

CLARK AVENUE AND 3RD STREET

AS-BUILT

811 know what's below Call before you dig

DATE SAFETY ALERT Call Before You Overhead

DANIEL MEYER

Call before you UnderGround 1-702-432-5300

REVISIONS | DATE

DATE: FEBRUARY 2010
CHECKED BY: RF/RNC
SCALE (V): -
DESIGNED BY: RNC
SCALE (H): 1"=20'
DRAWN BY: WSW

Kimley-Horn and Associates, Inc.
Engineering, Planning, and Environmental Consultants
2080 E. Flamingo Road, Suite 210, Las Vegas, NV 89119
FAX (702) 735-4343 PH: (702) 734-8666

© 2010

CITY OF LAS VEGAS NEVADA

DEPARTMENT OF PUBLIC WORKS

PROJECT: BONNEVILLE/CLARK ONEWAY COUPLET PHASE 1 IMPROVEMENT PLANS

SHEET: FIBER OPTIC SPLICE DETAILS

PROFESSIONAL ENGINEER STATE OF NEVADA
RANDY W. CARROLL
No. 16131
Exp. 12/31/10
CIVIL
11/25/10

SHEET NO. SL-11
SHEET 52 OF 91
DRAWING NO. 107V5201

BID# 09.1730.37

Apr 25, 2010 - 4:03pm - USER peter.meyerhofer
\\LAVP01\Projects\LAV_Public\Trans\092258\019 Bonneville-Clark 2008\CADD\2258019sl-01_10.dwg

20130473