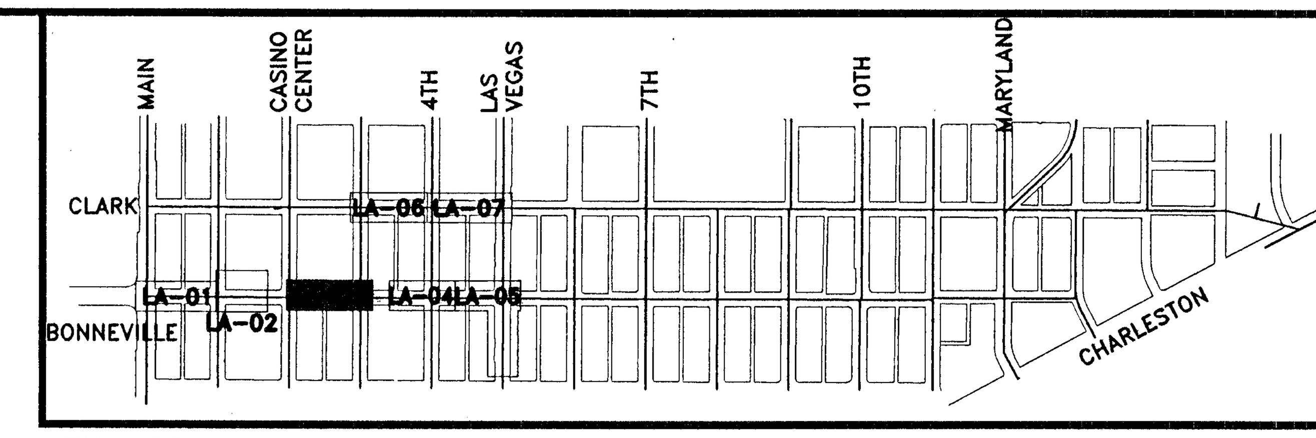

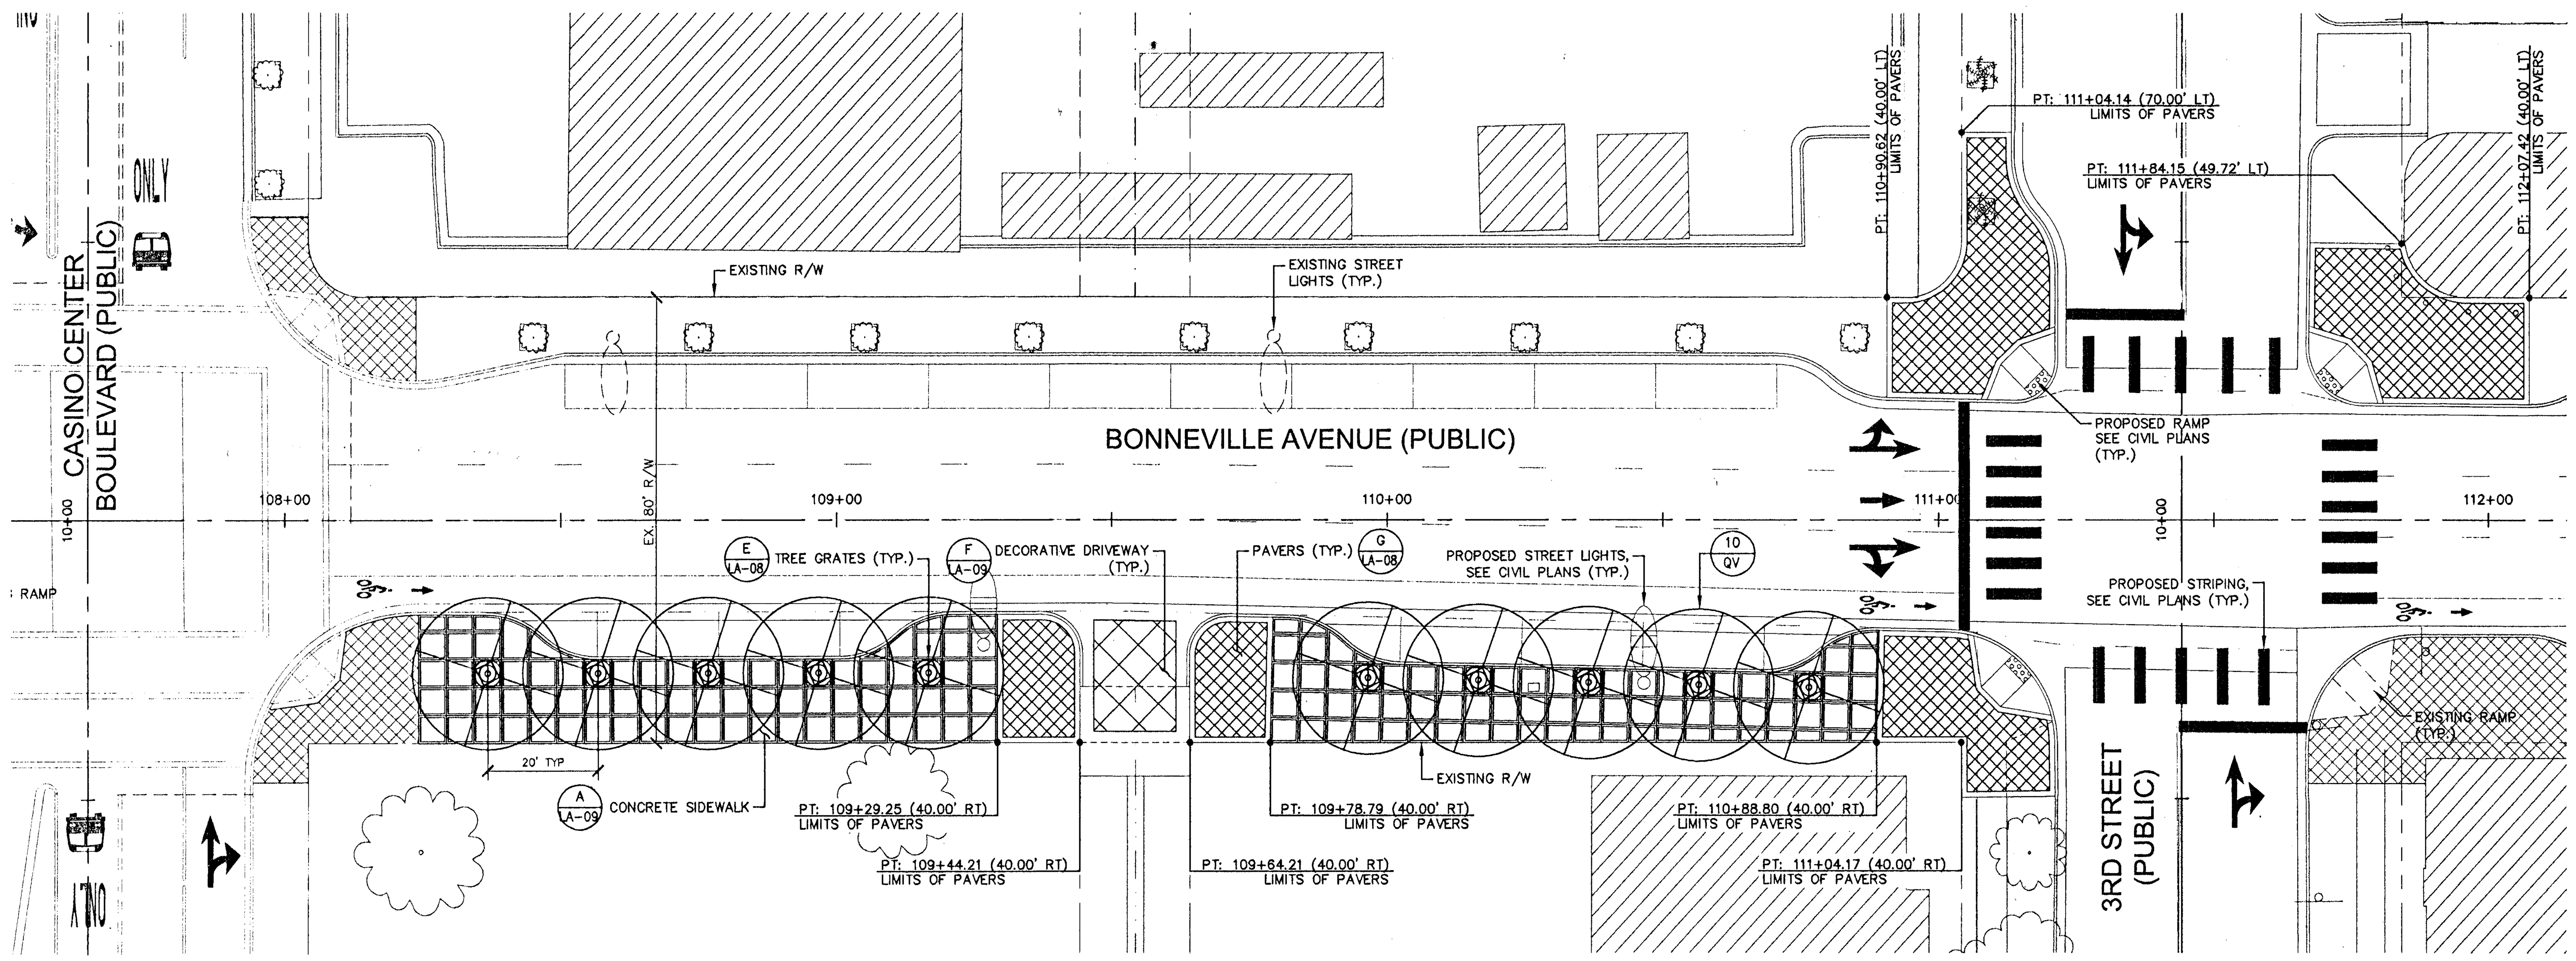

TAND, INC.
AS-BUILT

DATE — DANIEL MEYER

PLANT SCHEDULE

TREES, EXISTING TREES, SHRUBS & GROUNDCOVERS

SYMBOL	BOTANICAL NAME	COMMON NAME	QTY.	SIZE
⊗	QV – Quercus virginiana Chilopsis linearis	~~Southern Live Oak~~ Chilopsis "Pink Dawn"	49	36" BOX
	PD – Phoenix dactylifera	Phoenix Date Palm	17	36" ROOT BALL 25' HEIGHT
	XT – EXISTING TREE			
	XP – EXISTING PALM TREE			
	CN – Cassia nemophila	Desert Cassia	137	5 GAL
⊘	CD – Cotoneaster dammeri 'Coral Beauty'	Coral Beauty Cotoneaster	122	5 GAL
	AR – Acacia redolens 'Desert Carpet'	Desert Carpet	52	5 GAL
	CO – Convolvulus cneorum	Bush Morning Glory	35	5 GAL
	LS – Lantana camara 'New Gold'	New Gold Lantana	47	5 GAL

NOTES

1. CONTRACTOR IS RESPONSIBLE TO VERIFY ALL PLANT QUANTITIES. THE PLANT SCHEDULE IS INTENDED AS A REFERENCE ONLY.
2. LANDSCAPE ARCHITECT IS TO APPROVE ALL PLANT MATERIAL PRIOR TO INSTALLATION WITH A 48 HOUR ADVANCED NOTICE.
3. PLANT MATERIAL IS TO HAVE IDENTIFICATION TAGS ON 10% OF THE TOTAL QUANTITY OF EACH SPECIES, SHOWING GENUS, SPECIES, VARIETY, ETC.
4. CONTRACTOR TO PROVIDE MATCHING SIZES AND FORMS OF LIKE SHRUB SPECIES AS SHOWN ON DRAWINGS.
5. DECOMPOSED GRANITE, 1/2" MINUS, COLOR: "PINK CORAL", 2" DEPTH TYPICAL IN ALL PLANTING BEDS. DECOMPOSED GRANITE SHALL CONTAIN 60% AGGREGATE AND 40% FINES. CONTRACTOR TO RECEIVE VERIFICATION FROM ROCK SUPPLIER AND PRESENT VERIFICATION TO THE OWNER PRIOR TO ANY CONSTRUCTION.

   WHOLESALE DEALER:
   KALAMAZOO MATERIALS, INC.
   2251 SOUTH FORT APACHE ROAD, SUITE 2079
   LAS VEGAS, NV 89117
   TELEPHONE: (702) 296-9133

6. LANDSCAPE BOULDERS ARE TO BE GRANITE AND ROUND IN SHAPE. COLOR TO MATCH OR COMPLIMENT ROCK GROUND COVER. CONTRACTOR TO SET 1/4 OF ROCK DIAMETER INTO FINISH GRADE. BOULDERS TO BE 2' TO 4' IN DIAMETER, SIZED ACCORDING TO THE FOLLOWING PERCENTAGES:

   20% 4' LARGEST DIAMETER*
   40% 3' LARGEST DIAMETER
   40% 2' LARGEST DIAMETER

   TOTAL QUANTITY OF BOULDERS: 68

   * NOT TO BE USED IN AREAS LESS THAN 7'

7. LANDSCAPE UPLIGHTING–
   ▲ INSTALL TRAILBLAZER LANDSCAPE LIGHT, PRODUCT CODE LT-24-12W-45D-RD-VC-TW-LT6912GRS, OR APPROVED EQUAL

GRAPHIC SCALE
20 0 10 20 40
(IN FEET)

811 know what's below Call before you dig
SAFETY ALERT Call Before You Overhead dig1-702-227-2929
Call before you UnderGround 1-702-432-5300

REVISIONS | DATE
1 SHEET REPLACEMENT | 6/15/10

SCALE (H): 1"=20' | SCALE (V): N/A | DATE: FEBRUARY 2010
DRAWN BY: FR | DESIGNED BY: DJC | CHECKED BY: ACP

Kimley-Horn and Associates, Inc.
Engineering, Planning, and Environmental Consultants
2080 E. Flamingo Road, Suite 210, Las Vegas, NV 89119
FAX (702) 735-4949 PH. (702) 734-5666

© 2010

CITY OF LAS VEGAS NEVADA

DEPARTMENT OF PUBLIC WORKS

PROJECT: BONNEVILLE/CLARK ONEWAY COUPLET PHASE 1 IMPROVEMENT PLANS

SHEET: LANDSCAPE SHEET

REGISTERED LANDSCAPE ARCHITECT ADAM PERILLO 791 STATE OF NEVADA Expires: 6-30-11
6-15-10

SHEET NO. LA-03
SHEET 75 OF 91
DRAWING NO. 107V5201

BID# 09.1730.37 REV 3

Jun 15, 2010 – 7:42am – USER david.casselbury
K:\PHX_Roadway\092-Las Vegas\092256019-Bonneville_Clark\CADD\Bonneville-Clark LA01-07\256019la-01_07.dwg

20130496