

RECORD OF SURVEY


MONUMENT TIE MAP

BARCELONA AT THE PASEOS-- UNIT 1, A COMMON INTEREST COMMUNITY ON FILE IN BOOK 117, PAGE 08 OF PLATS IN THE COUNTY RECORDER'S OFFICE, CLARK COUNTY, NEVADA. SITUATE WITHIN SECTION 34, TOWNSHIP 20 SOUTH, RANGE 59 EAST, M.D.M., CITY OF LAS VEGAS, CLARK COUNTY, NEVADA.

SURVEYOR'S CERTIFICATE


- I, RAYMOND JEMISON, A PROFESSIONAL LAND SURVEYOR REGISTERED IN THE STATE OF NEVADA, CERTIFY THAT:
- THIS PLAT REPRESENTS THE RESULTS OF A SURVEY CONDUCTED UNDER MY SUPERVISION AT THE INSTANCE OF: HOWARD HUGHES CORPORATION, A DELAWARE CORPORATION
 - THE LANDS SURVEYED LIE WITHIN SECTION 34, TOWNSHIP 20 SOUTH, RANGE 59 EAST, M.D.M., CLARK COUNTY, NEVADA, AND THE SURVEY WAS COMPLETED ON NOVEMBER 15, 2010.
 - THIS PLAT COMPLIES WITH THE APPLICABLE STATE STATUTES AND ANY LOCAL ORDINANCES IN EFFECT ON THE DATE THAT THE SURVEY WAS COMPLETED AND THAT THIS SURVEY DOES NOT CONSTITUTE A SUBDIVISION AS DEFINED BY NEVADA REVISED STATUTES.
 - THE MONUMENTS DEPICTED ON THE PLAT ARE OF THE CHARACTER SHOWN, OCCUPY THE POSITIONS INDICATED, ARE OF SUFFICIENT DURABILITY AND THE TIE DISTANCES ESTABLISHED AS SHOWN HEREON.
 - THIS PLAT AND THE SURVEY ON WHICH IT IS BASED, MEET POSITIONAL CERTAINITY ACCURACY REQUIREMENTS FOR A LOW URBAN LAND BOUNDARY SURVEY AS DEFINED BY N.A.C. 625.740 N.A.C. 625.666.

RAYMOND JEMISON
PROFESSIONAL LAND SURVEYOR
NEVADA REG. NO. 10598

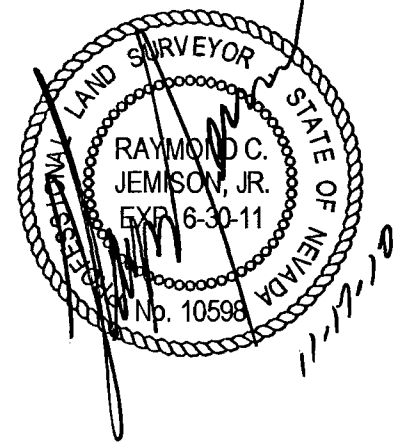


BASIS OF BEARINGS

SOUTH 80°49'20" WEST BEING THE BEARING OF THE CENTERLINE OF PASEO BREEZE DRIVE AS SHOWN ON THE FINAL MAP OF "SUMMERLIN VILLAGE 23A UNIT NO. 1", IN BOOK 108 OF PLATS, PAGE 29 OFFICE OF THE RECORDER CLARK COUNTY, NEVADA.

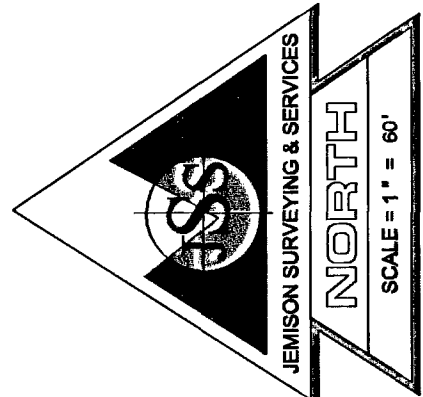

GRAPHIC SCALE

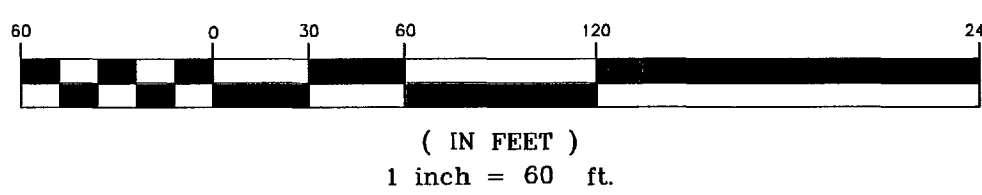

LEGEND


(NOTE: SOME SYMBOLS HAVE BEEN EXAGGERATED IN SCALE FOR CLARITY)

- SET TYPE III CENTERLINE MONUMENT PLS 10598 AT LOCATION INDICATED IN BOOK 117, PAGE 08 OF PLATS
- SET TYPE IV REFERENCE MONUMENT PLS 10598
- STREET CENTERLINE
- RIGHT-OF-WAY/LOT LINE
- XX.XX' MONUMENT TIE DISTANCE

NOTE:

THE PURPOSE OF THIS MAP IS TO SATISFY THE REQUIREMENTS OF THE CITY OF LAS VEGAS, NEVADA FOR THE RELEASE OF FINAL DEVELOPMENT BONDS AND FEES. UNLESS NOTED OTHERWISE, MONUMENTS WERE SET RESPECTIVE OF THE RECORDED MAPS AS INDICATED IN THE LEGEND. CERTIFICATION BY THE SURVEYOR OF THIS MAP IS LIMITED ONLY TO THE MONUMENTS SET BY SAID SURVEYOR, THE TYPE AND KIND OF MONUMENTS DESCRIBED, AND THE RESPECTIVE DIMENSIONS FROM THE REFERENCE MONUMENTS TO THE MONUMENTS SET AS INDICATED ON THE FINAL MAP AS RECORDED IN BOOK 117 OF PLATS, PAGE 08. ADDITIONAL LIMITS OF LIABILITY IS STATED BY A CERTIFICATE OF AMENDMENT DATED AS RECORDED IN DOCUMENT NO OTHER LIABILITIES ARE ASSUMED OR IMPLIED.

FOR DETAILS OF THE ADJUTING LANDS, REFER TO THE APPROPRIATE PLATS.

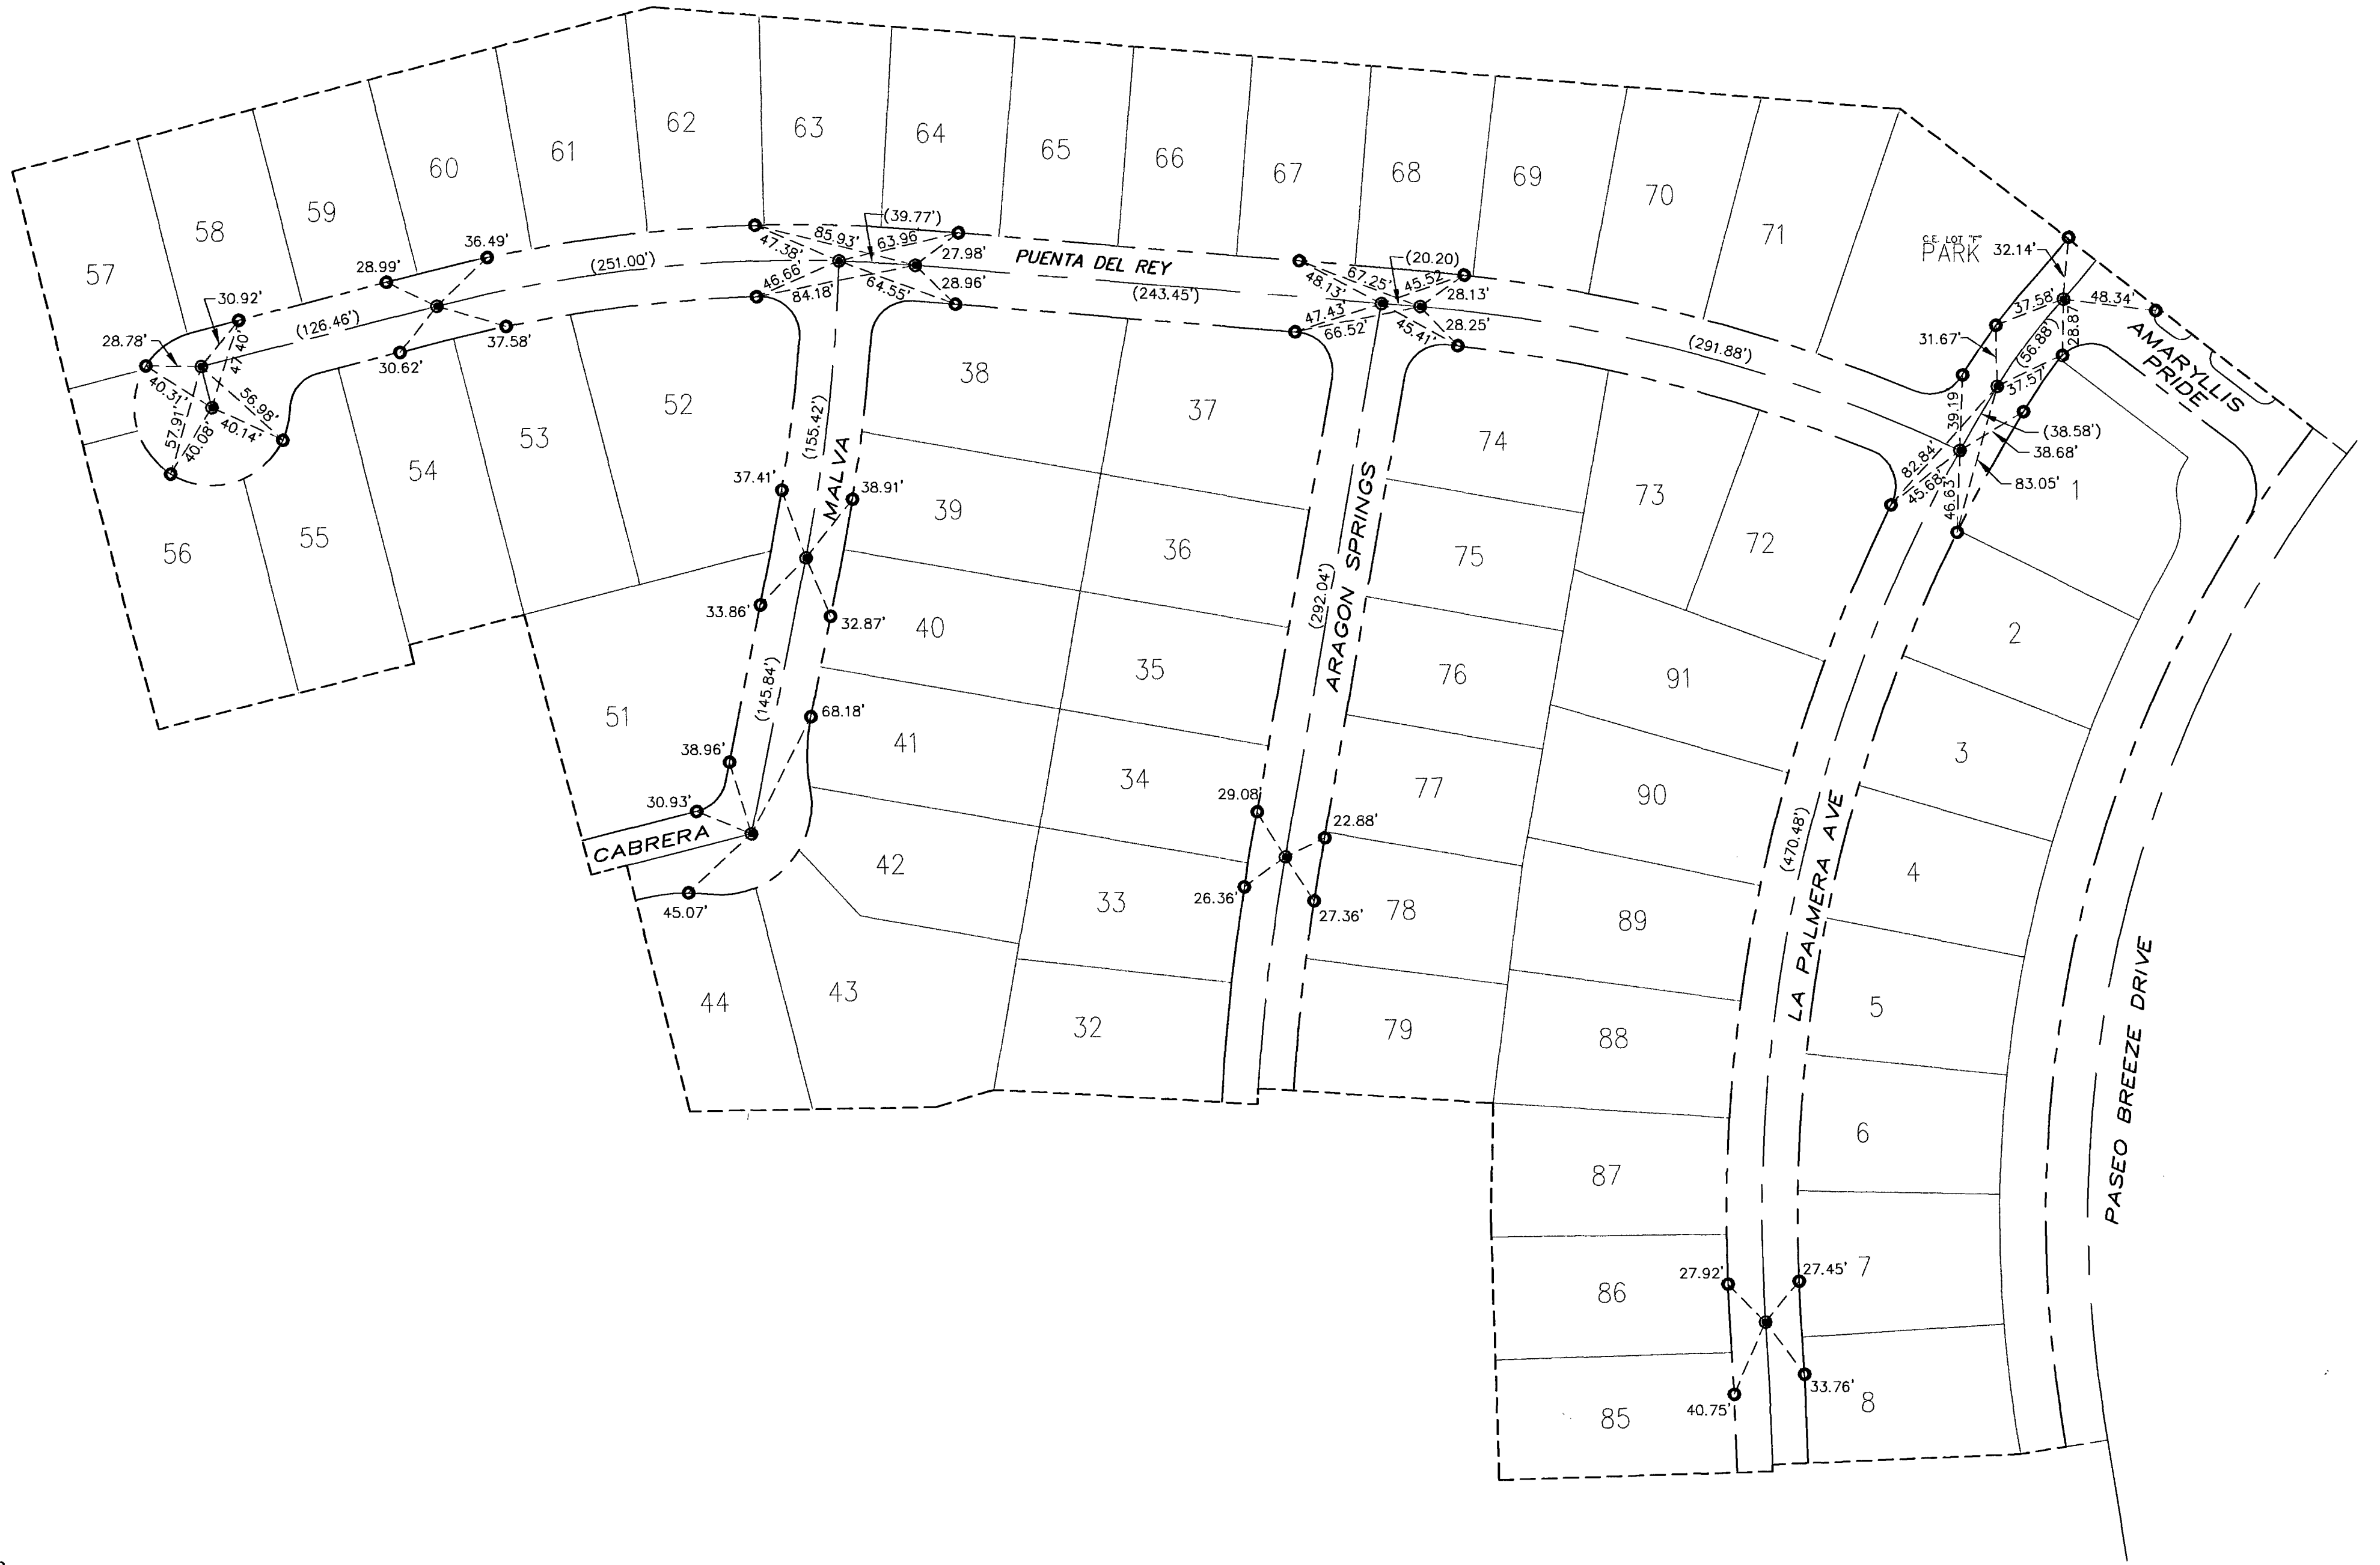

RECORDER'S NOTE

ANY SUBSEQUENT CHANGES TO THIS MAP SHOULD BE EXAMINED AND MAY BE DETERMINED BY REFERENCE TO THE COUNTY RECORDER'S CUMULATIVE MAP INDEX. (N.R.S. 278.5695)

REFERENCE FMP-3801

RECORD OF SURVEY

MONUMENT TIE MAP

BARCELONA AT THE PASEOS - UNIT 1
A COMMON INTEREST COMMUNITY, BOOK 117 OF PLATS, PAGE 08

SITUATE IN THE SECTION 34
TOWNSHIP 20 SOUTH, RANGE 59 EAST, M.D.M.
CITY OF LAS VEGAS, CLARK COUNTY, NEVADA.

DATE: NOVEMBER 15, 2010 JOB NUMBER: 255-101025 DWG NAME: VILLAGE23A-PCL-1



JEMISON SURVEYING & SERVICES
2690 CRIMSON CANYON DR.
LAS VEGAS, NEVADA, 89128
702-360-4838 FAX: 702-360-4839

INSTRUMENT NO. _____
OFFICIAL RECORDS
BOOK NO. _____
FILED AT THE REQUEST OF
HOWARD HUGHES CORPORATION
DATE _____ AT _____
FILE _____ PAGE _____
RECORD OF SURVEY
CLARK COUNTY, NEVADA RECORDS
DEBBIE CONWAY
RECORDER
FEE \$ _____ DEPUTY _____

SHEET 1 OF 1

FILE _____ PAGE _____

RECORD OF SURVEY


MONUMENT TIE MAP

BARCELONA AT THE PASEOS-- UNIT 1, A COMMON INTEREST COMMUNITY ON FILE IN BOOK 117, PAGE 08 OF PLATS IN THE COUNTY RECORDER'S OFFICE, CLARK COUNTY, NEVADA. SITUATE WITHIN SECTION 34, TOWNSHIP 20 SOUTH, RANGE 59 EAST, M.D.M., CITY OF LAS VEGAS, CLARK COUNTY, NEVADA.

SURVEYOR'S CERTIFICATE



- I, RAYMOND JEMISON, A PROFESSIONAL LAND SURVEYOR REGISTERED IN THE STATE OF NEVADA, CERTIFY THAT:
- THIS PLAT REPRESENTS THE RESULTS OF A SURVEY CONDUCTED UNDER MY SUPERVISION AT THE INSTANCE OF: HOWARD HUGHES CORPORATION, A DELAWARE CORPORATION
 - THE LANDS SURVEYED LIE WITHIN SECTION 34, TOWNSHIP 20 SOUTH, RANGE 59 EAST, M.D.M., CLARK COUNTY, NEVADA, AND THE SURVEY WAS COMPLETED ON NOVEMBER 15, 2010.
 - THIS PLAT COMPLIES WITH THE APPLICABLE STATE STATUTES AND ANY LOCAL ORDINANCES IN EFFECT ON THE DATE THAT THE SURVEY WAS COMPLETED AND THAT THIS SURVEY DOES NOT CONSTITUTE A SUBDIVISION AS DEFINED BY NEVADA REVISED STATUTES.
 - THE MONUMENTS DEPICTED ON THE PLAT ARE OF THE CHARACTER SHOWN, OCCUPY THE POSITIONS INDICATED, ARE OF SUFFICIENT DURABILITY AND THE TIE DISTANCES ESTABLISHED AS SHOWN HEREON.
 - THIS PLAT AND THE SURVEY ON WHICH IT IS BASED, MEET POSITIONAL CERTAINITY ACCURACY REQUIREMENTS FOR A LOW URBAN LAND BOUNDARY SURVEY AS DEFINED BY N.A.C. 625.740 N.A.C. 625.666.

RAYMOND JEMISON
PROFESSIONAL LAND SURVEYOR
NEVADA REG. NO. 10598

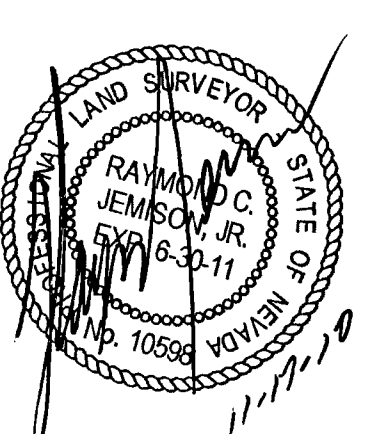

BASIS OF BEARINGS

SOUTH 80°49'20" WEST BEING THE BEARING OF THE CENTERLINE OF PASEO BREEZE DRIVE AS SHOWN ON THE FINAL MAP OF "SUMMERLIN VILLAGE 23A UNIT NO. 1", IN BOOK 108 OF PLATS, PAGE 29 OFFICE OF THE RECORDER CLARK COUNTY, NEVADA.

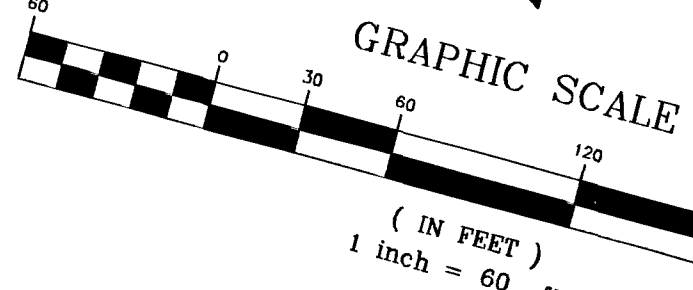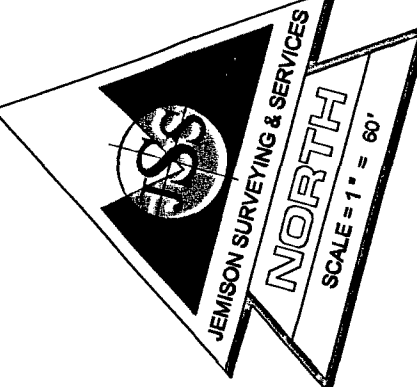


LEGEND

- (NOTE: SOME SYMBOLS HAVE BEEN EXAGGERATED IN SCALE FOR CLARITY)
- SET TYPE III CENTERLINE MONUMENT PLS 10598 AT LOCATION INDICATED IN BOOK 117, PAGE 08 OF PLATS
 - SET TYPE IV REFERENCE MONUMENT PLS 10598
 - STREET CENTERLINE
 - RIGHT-OF-WAY/LOT LINE
 - XX.XX' MONUMENT TIE DISTANCE

NOTE:

THE PURPOSE OF THIS MAP IS TO SATISFY THE REQUIREMENTS OF THE CITY OF LAS VEGAS, NEVADA FOR THE RELEASE OF FINAL DEVELOPMENT BONDS AND FEES. UNLESS NOTED OTHERWISE, MONUMENTS WERE SET RESPECTIVE OF THE RECORDED MAPS AS INDICATED IN THE LEGEND. CERTIFICATION BY THE SURVEYOR OF THIS MAP IS LIMITED ONLY TO THE MONUMENTS SET BY SAID SURVEYOR, THE TYPE AND KIND OF MONUMENTS DESCRIBED, AND THE RESPECTIVE DIMENSIONS FROM THE REFERENCE MONUMENTS TO THE MONUMENTS SET AS INDICATED ON THE FINAL MAP AS RECORDED IN BOOK 117 OF PLATS, PAGE 08. ADDITIONAL LIMITS OF LIABILITY IS STATED BY A CERTIFICATE OF AMENDMENT DATED AS RECORDED IN DOCUMENT NO OTHER LIABILITIES ARE ASSUMED OR IMPLIED.

FOR DETAILS OF THE ADJUTING LANDS, REFER TO THE APPROPRIATE PLATS.

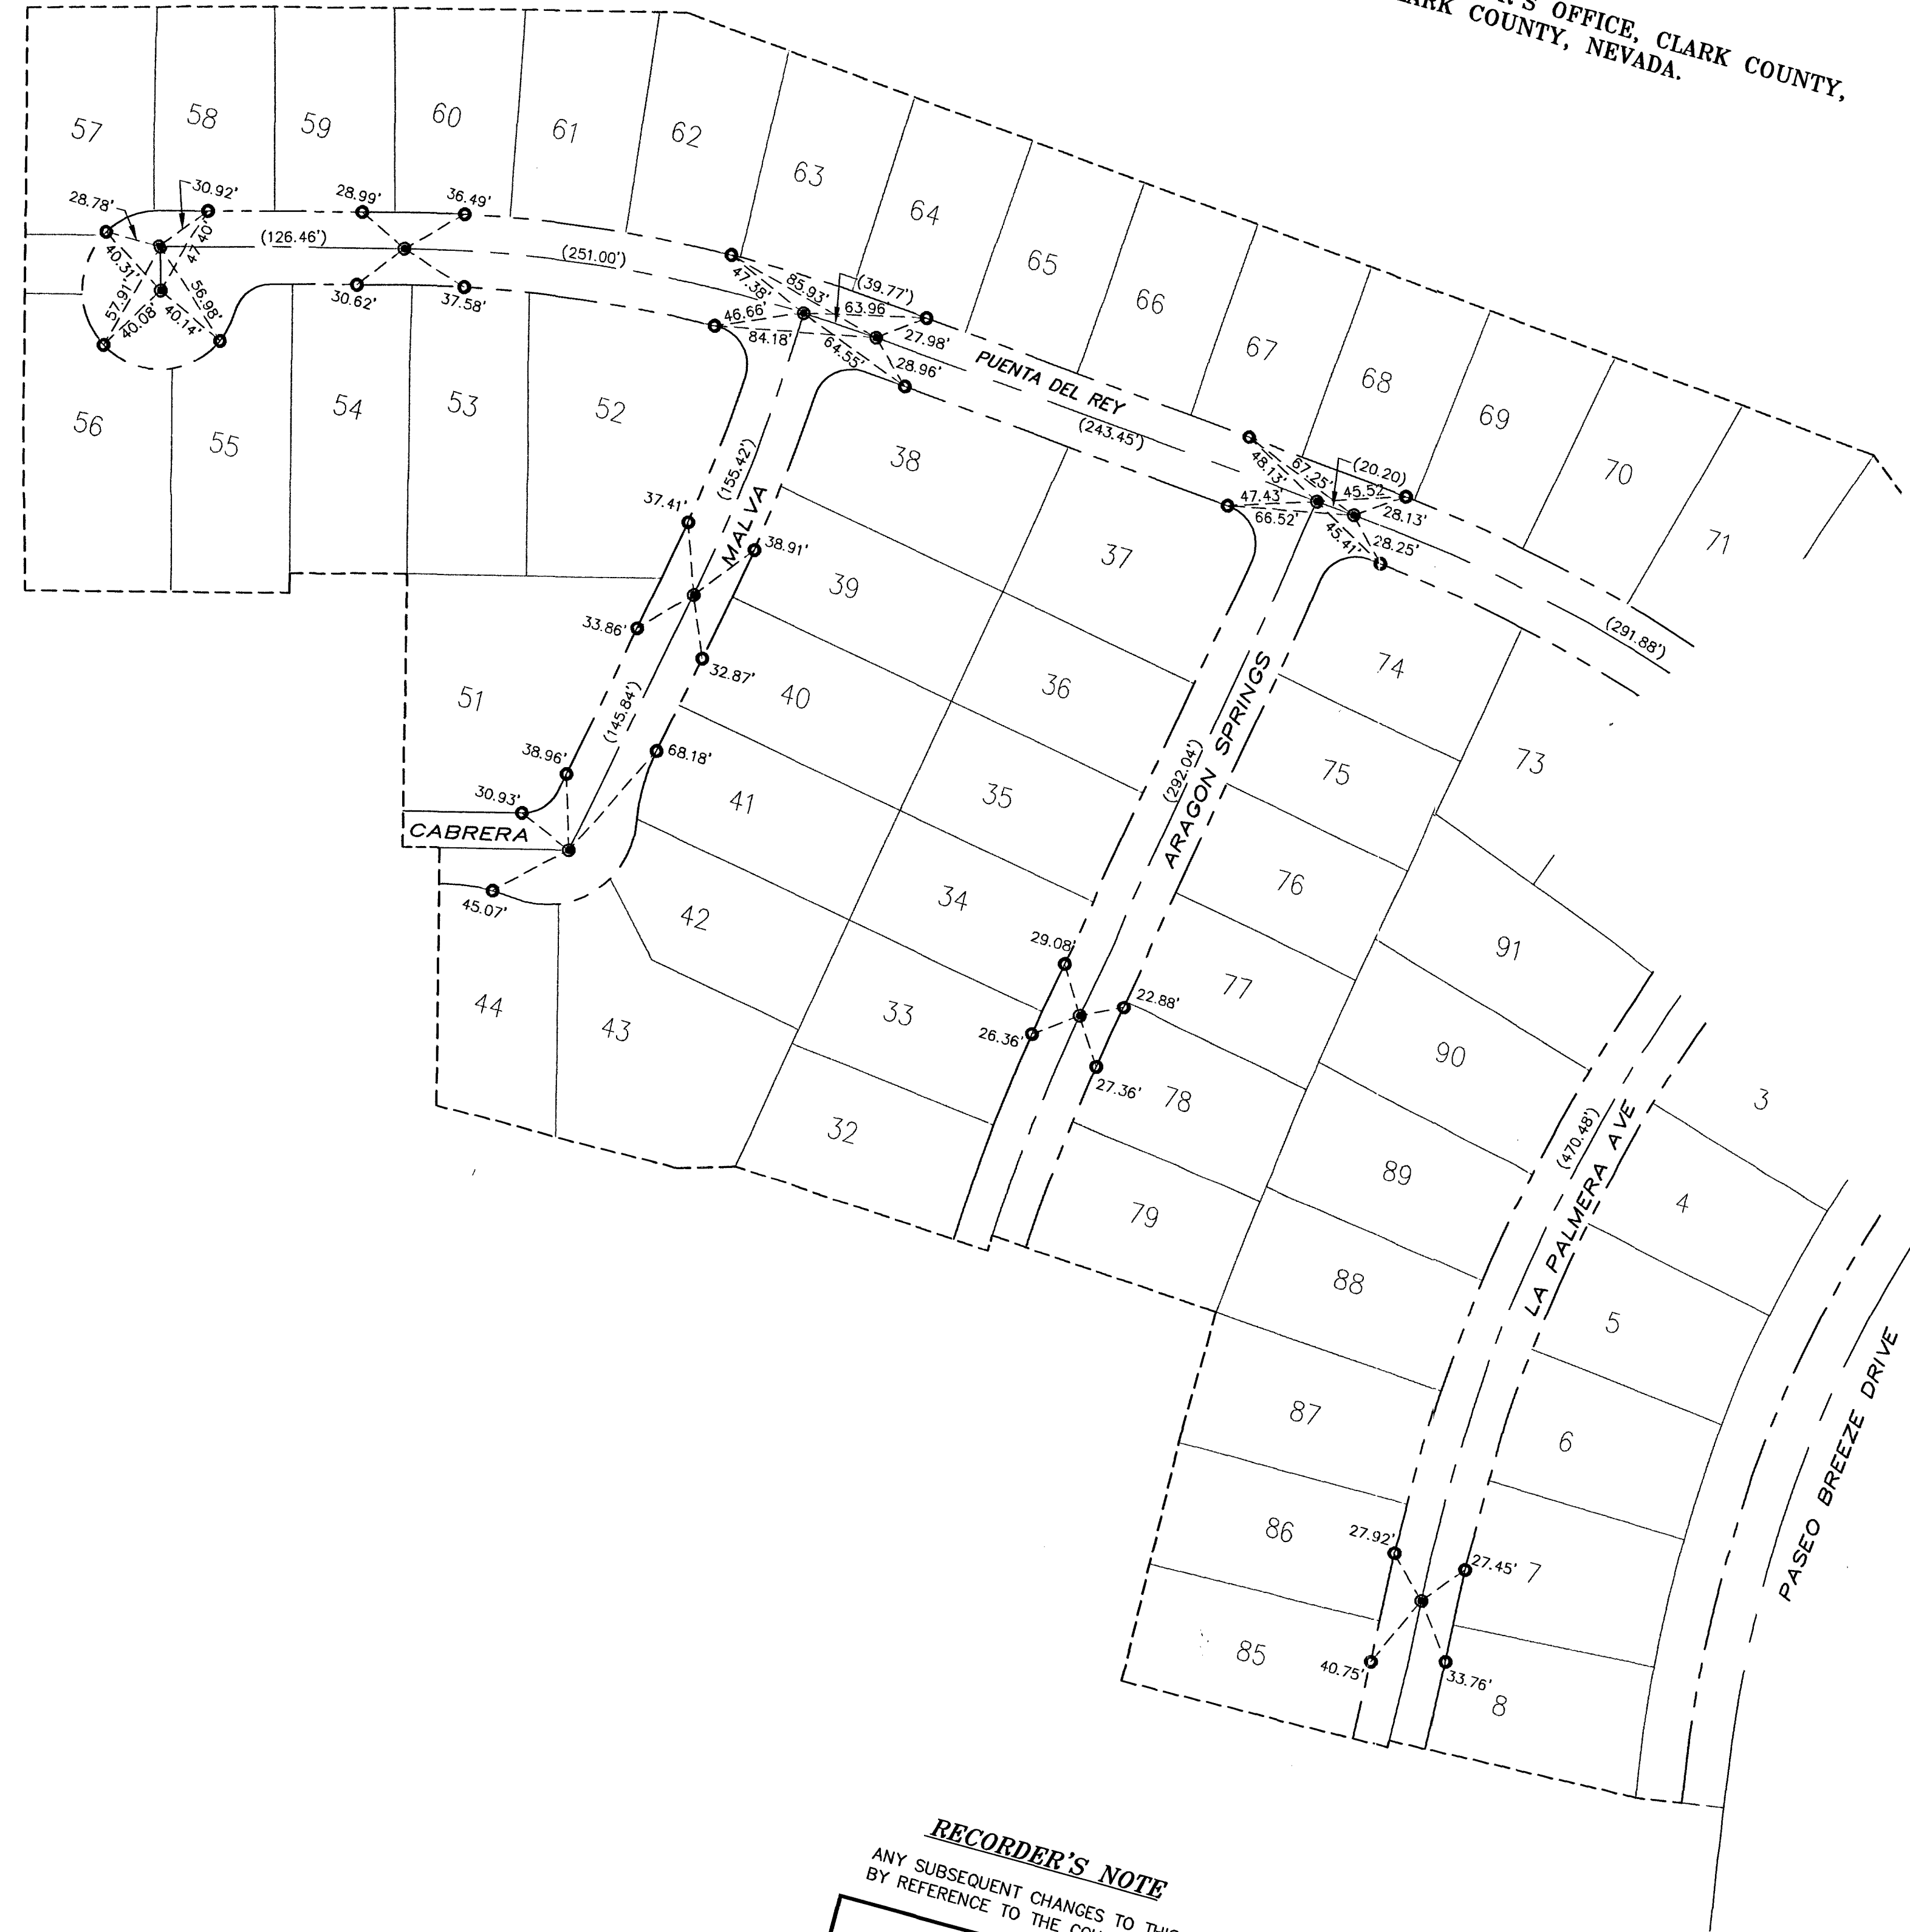

RECORDER'S NOTE

ANY SUBSEQUENT CHANGES TO THIS MAP SHOULD BE EXAMINED AND MAY BE DETERMINED BY REFERENCE TO THE COUNTY RECORDER'S CUMULATIVE MAP INDEX. (N.R.S. 278.5695)

RECORD OF SURVEY

MONUMENT TIE MAP

BARCELONA AT THE PASEOS - UNIT 1
A COMMON INTEREST COMMUNITY, BOOK 117 OF PLATS, PAGE 08

SITUATE IN THE SECTION 34
TOWNSHIP 20 SOUTH, RANGE 59 EAST, M.D.M.
CITY OF LAS VEGAS, CLARK COUNTY, NEVADA.

DATE: NOVEMBER 15, 2010 JOB NUMBER: 255-101025 DWG NAME: VILLAGE23A-PCL-1



JEMISON SURVEYING & SERVICES
2690 CRIMSON CANYON DR.
LAS VEGAS, NEVADA, 89128
702-360-4838 FAX: 702-360-4839

INSTRUMENT NO. _____
OFFICIAL RECORDS
BOOK NO. _____
FILED AT THE REQUEST OF
HOWARD HUGHES CORPORATION
DATE _____ AT _____
FILE _____ PAGE _____
RECORD OF SURVEY
CLARK COUNTY, NEVADA RECORDS
DEBBIE CONWAY
RECORDER
FEE \$ _____ DEPUTY _____

SHEET 1 OF 1

RECORD OF SURVEY

MONUMENT TIE MAP


BARCELONA AT THE PASEOS- UNIT 1, A COMMON INTEREST COMMUNITY ON FILE IN BOOK 117, PAGE 06 OF PLATS IN THE COUNTY RECORDER'S OFFICE, CLARK COUNTY, NEVADA. SITUATE WITHIN SECTION 34, TOWNSHIP 20 SOUTH, RANGE 59 EAST, M.D.M., CITY OF LAS VEGAS, CLARK COUNTY, NEVADA.

SURVEYOR'S CERTIFICATE

I, RAYMOND JEMISON, A PROFESSIONAL LAND SURVEYOR REGISTERED IN THE STATE OF NEVADA, CERTIFY THAT:



- THIS PLAT REPRESENTS THE RESULTS OF A SURVEY CONDUCTED UNDER MY SUPERVISION AT THE INSTANCE OF: HOWARD HUGHES CORPORATION, A DELAWARE CORPORATION
- THE LANDS SURVEYED LIE WITHIN SECTION 34, TOWNSHIP 20 SOUTH, RANGE 59 EAST, M.D.M., CLARK COUNTY, NEVADA, AND THE SURVEY WAS COMPLETED ON NOVEMBER 15, 2010.
- THIS PLAT COMPLIES WITH THE APPLICABLE STATE STATUTES AND ANY LOCAL ORDINANCES IN EFFECT ON THE DATE THAT THE SURVEY WAS COMPLETED AND THAT THIS SURVEY DOES NOT CONSTITUTE A SUBDIVISION AS DEFINED BY NEVADA REVISED STATUTES.
- THE MONUMENTS DEPICTED ON THE PLAT ARE OF THE CHARACTER SHOWN, OCCUPY THE POSITIONS INDICATED, ARE OF SUFFICIENT DURABILITY AND THE TIE DISTANCES ESTABLISHED AS SHOWN HEREON.
- THIS PLAT AND THE SURVEY ON WHICH IT IS BASED, MEET POSITIONAL CERTAINTY ACCURACY REQUIREMENTS FOR A LOW URBAN LAND BOUNDARY SURVEY AS DEFINED BY N.A.C. 625.740 N.A.C. 625.666.

RAYMOND JEMISON
PROFESSIONAL LAND SURVEYOR
NEVADA REG. NO. 10598

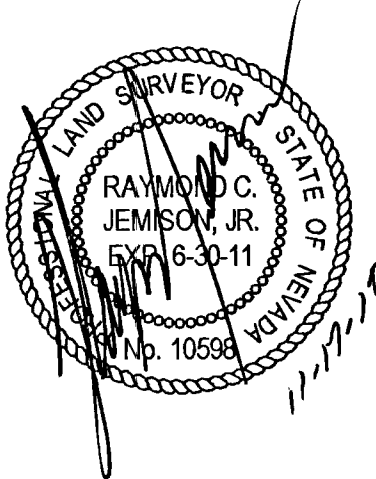

BASIS OF BEARINGS

SOUTH 80°49'20" WEST BEING THE BEARING OF THE CENTERLINE OF PASEO BREEZE DRIVE AS SHOWN ON THE FINAL MAP OF "SUMMERLIN VILLAGE 23A UNIT NO. 1", IN BOOK 108 OF PLATS, PAGE 29 OFFICE OF THE RECORDER CLARK COUNTY, NEVADA.

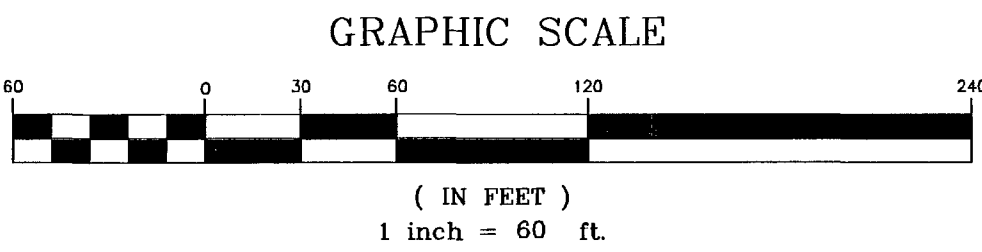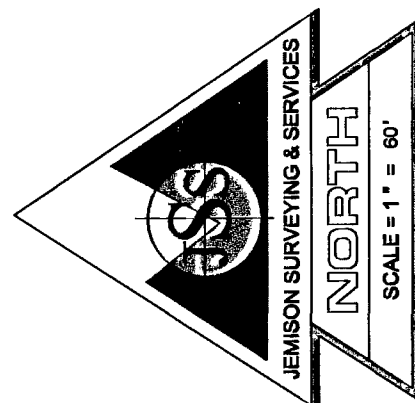

LEGEND


(NOTE: SOME SYMBOLS HAVE BEEN EXAGGERATED IN SCALE FOR CLARITY)

- SET TYPE III CENTERLINE MONUMENT PLS 10598 AT LOCATION INDICATED IN BOOK 117, PAGE 06 OF PLATS
- SET TYPE IV REFERENCE MONUMENT PLS 10598
- STREET CENTERLINE
- - - RIGHT-OF-WAY/LOT LINE
- XX.XX' MONUMENT TIE DISTANCE

NOTE:

THE PURPOSE OF THIS MAP IS TO SATISFY THE REQUIREMENTS OF THE CITY OF LAS VEGAS, NEVADA FOR THE RELEASE OF FINAL DEVELOPMENT BONDS AND FEES. UNLESS NOTED OTHERWISE, MONUMENTS WERE SET RESPECTIVE OF THE RECORDED MAPS AS INDICATED IN THE LEGEND. CERTIFICATION BY THE SURVEYOR OF THIS MAP IS LIMITED ONLY TO THE MONUMENTS SET BY SAID SURVEYOR, THE TYPE AND KIND OF MONUMENTS DESCRIBED, AND THE RESPECTIVE DIMENSIONS FROM THE REFERENCE MONUMENTS TO THE MONUMENTS SET AS INDICATED ON THE FINAL MAP AS RECORDED IN BOOK 117 OF PLATS, PAGE 06. ADDITIONAL LIMITS OF LIABILITY IS STATED BY A CERTIFICATE OF AMENDMENT DATED AS RECORDED IN DOCUMENT NO OTHER LIABILITIES ARE ASSUMED OR IMPLIED.

FOR DETAILS OF THE ABUTTING LANDS, REFER TO THE APPROPRIATE PLATS.

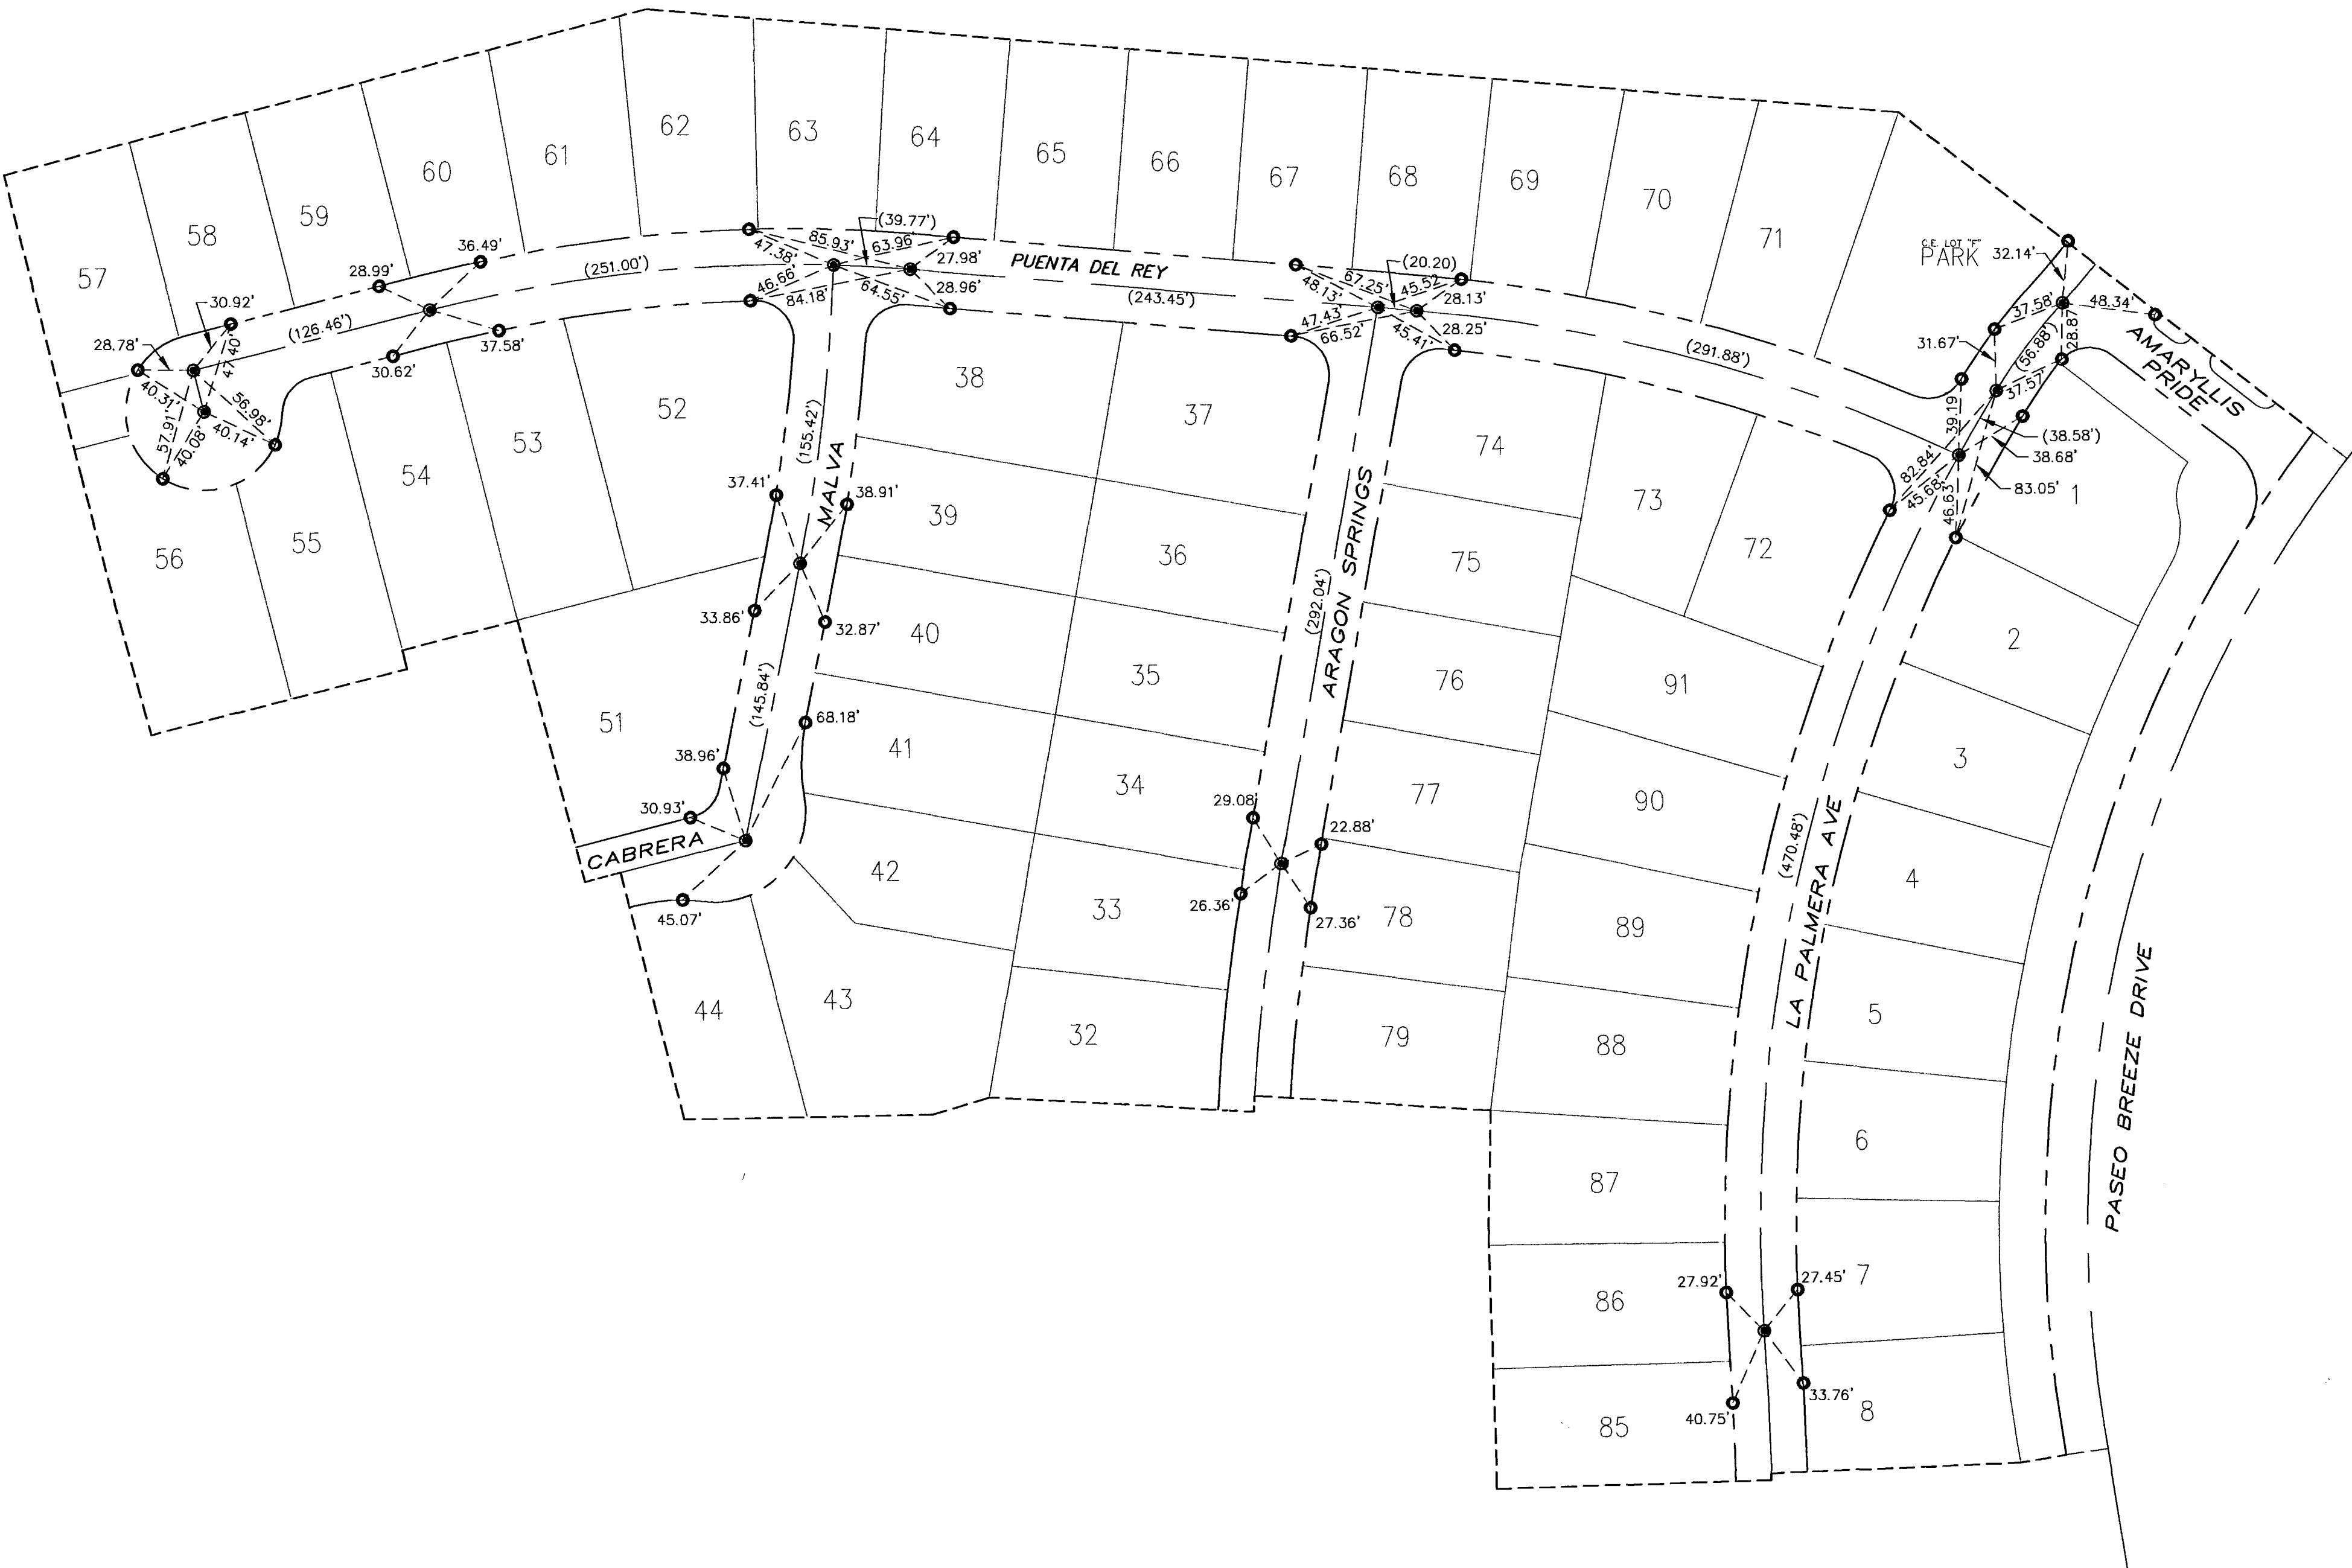

RECORDER'S NOTE

ANY SUBSEQUENT CHANGES TO THIS MAP SHOULD BE EXAMINED AND MAY BE DETERMINED BY REFERENCE TO THE COUNTY RECORDER'S CUMULATIVE MAP INDEX. (N.R.S. 278.5695)

REFERENCE FMP-3801

RECORD OF SURVEY		
MONUMENT TIE MAP		
BARCELONA AT THE PASEOS - UNIT 1		
A COMMON INTEREST COMMUNITY, BOOK 117 OF PLATS, PAGE 06		
SITUATE IN THE SECTION 34		
TOWNSHIP 20 SOUTH, RANGE 59 EAST, M.D.M.		
CITY OF LAS VEGAS, CLARK COUNTY, NEVADA.		
DATE: NOVEMBER 15, 2010	JOB NUMBER: 255-101025	DWG NAME: VILLAGE23A-PCL-J
JEMISON SURVEYING & SERVICES 2690 CRIMSON CANYON DR. LAS VEGAS, NEVADA, 89128 702-360-4838 FAX 702-360-4839		
INSTRUMENT NO. _____ OFFICIAL RECORDS BOOK NO. _____ FILED AT THE REQUEST OF HOWARD HUGHES CORPORATION DATE _____ AT _____ FILE _____ PAGE _____ RECORD OF SURVEY CLARK COUNTY, NEVADA RECORDS DEBBIE CONWAY RECORDER FEE \$ _____ DEPUTY _____		