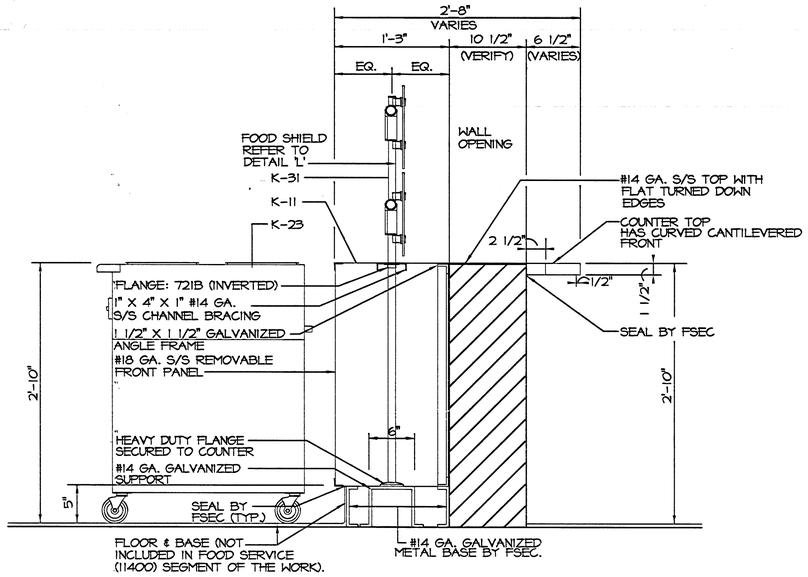

(K) SECTION - COUNTER @ COOKING EQUIPMENT

SCALE: 1 1/2" = 1'-0"

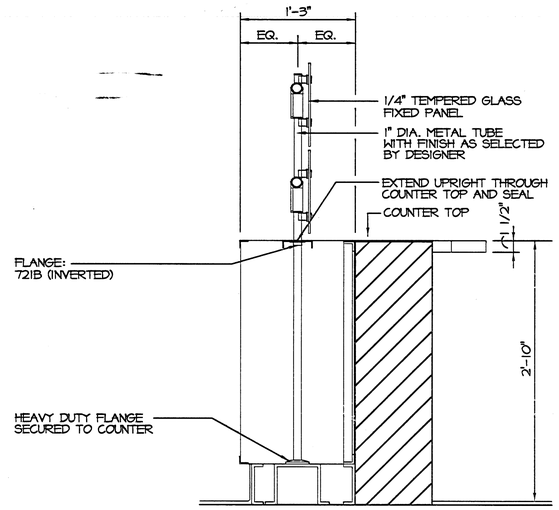

SECTION

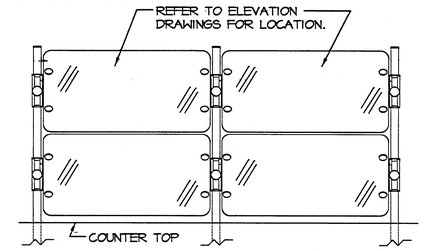

ELEVATION

FOOD SHIELD NOTES:

MANUFACTURER: BRASS SMITH
STYLE: Z-GUARD
FINISH: METAL TUBING AND ALL METAL COMPONENTS AS SELECTED BY DESIGNER
GLASS: 1/4" TEMPERED GLASS FULLY ADJUSTABLE W/ LOCKING THUMB SCREW

(L) DETAIL - FOOD SHIELD (TYPICAL)

SCALE: 1 1/2" = 1'-0"

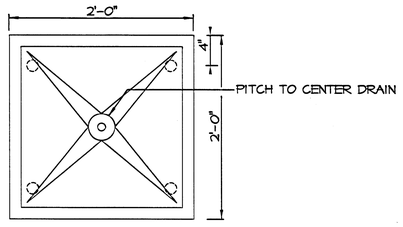

PLAN

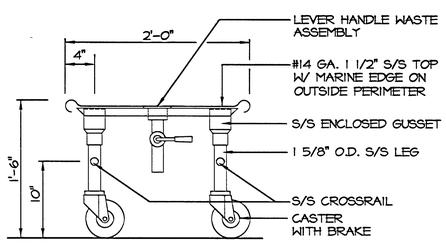

ELEVATION
SCALE: 1 1/2"=1'-0"

(M) DETAIL-MOBILE DRAINBOARD-ITEM K-29/K-131

SCALE: 1 1/2"=1'-0"

HDA PACIFIC
134 Church Street
P.O. Box 1718
Sonoma, CA 95476
USA
Phone: 707-933-0749
Fax: 707-933-0757

1000 Commerce Drive
Suite 1006
Carnegie, PA 15108
USA
Phone: 412-299-9300
Fax: 412-299-9300

Food Facility Planning and Design
A Division of Hammer Design Associates, Inc.

© HDA-PACIFIC 2005

KEYPLAN

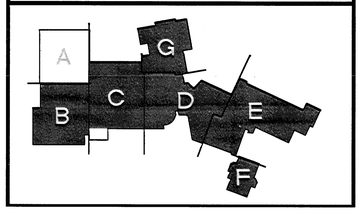

REVISIONS
RECORD DRAWINGS REVISED

CONSULTANT

500 PILOT ROAD, SUITE A
LAS VEGAS, NEVADA 89119
(702) 283-7111
(702) 283-8111 FAX
LUCCHESI •GALATI•

Disclaimer: These record drawings prepared by Lucchesi Galati Architects, Inc. and HDA-Pacific, are based on information provided by others. Lucchesi Galati Architects, Inc. and HDA-Pacific have not verified the accuracy and/or completeness of its information supplied by others, and shall not be responsible for any errors or omissions, which may be incorporated herein as a result.

CENTER

CITY OF LAS VEGAS
CENTENNIAL HILLS COMMUNITY
RECORD DRAWINGS

STAMP

OWNER: CITY OF LAS VEGAS
DEPARTMENT OF PUBLIC WORKS
ARCHITECTURAL SERVICES

400 EAST STEWART AVENUE
LAS VEGAS, NEVADA 89101
PHONE: (702) 229-6533
FAX: (702) 384-4846
TDD: (702) 386-9108

DRAWN
TITLE
DATE 03/18/05
SCALE
BID NO 05.15341.01
CLV DWG NO 671-49
SHT NO FS4.01

127.072

0056 FS4.01.TIF