SHEET NOTES

1. 52x24 COMBUSTION AIR DUCT DOWN THRU ROOF FROM GOOSENECK WITH BIRDSCREEN.
2. MAINTAIN 10'-0" FROM FRESH AIR INTAKES.
3. 8x4 COMBUSTION AIR DUCT DOWN THRU ROOF FROM GOOSENECK WITH BIRDSCREEN.

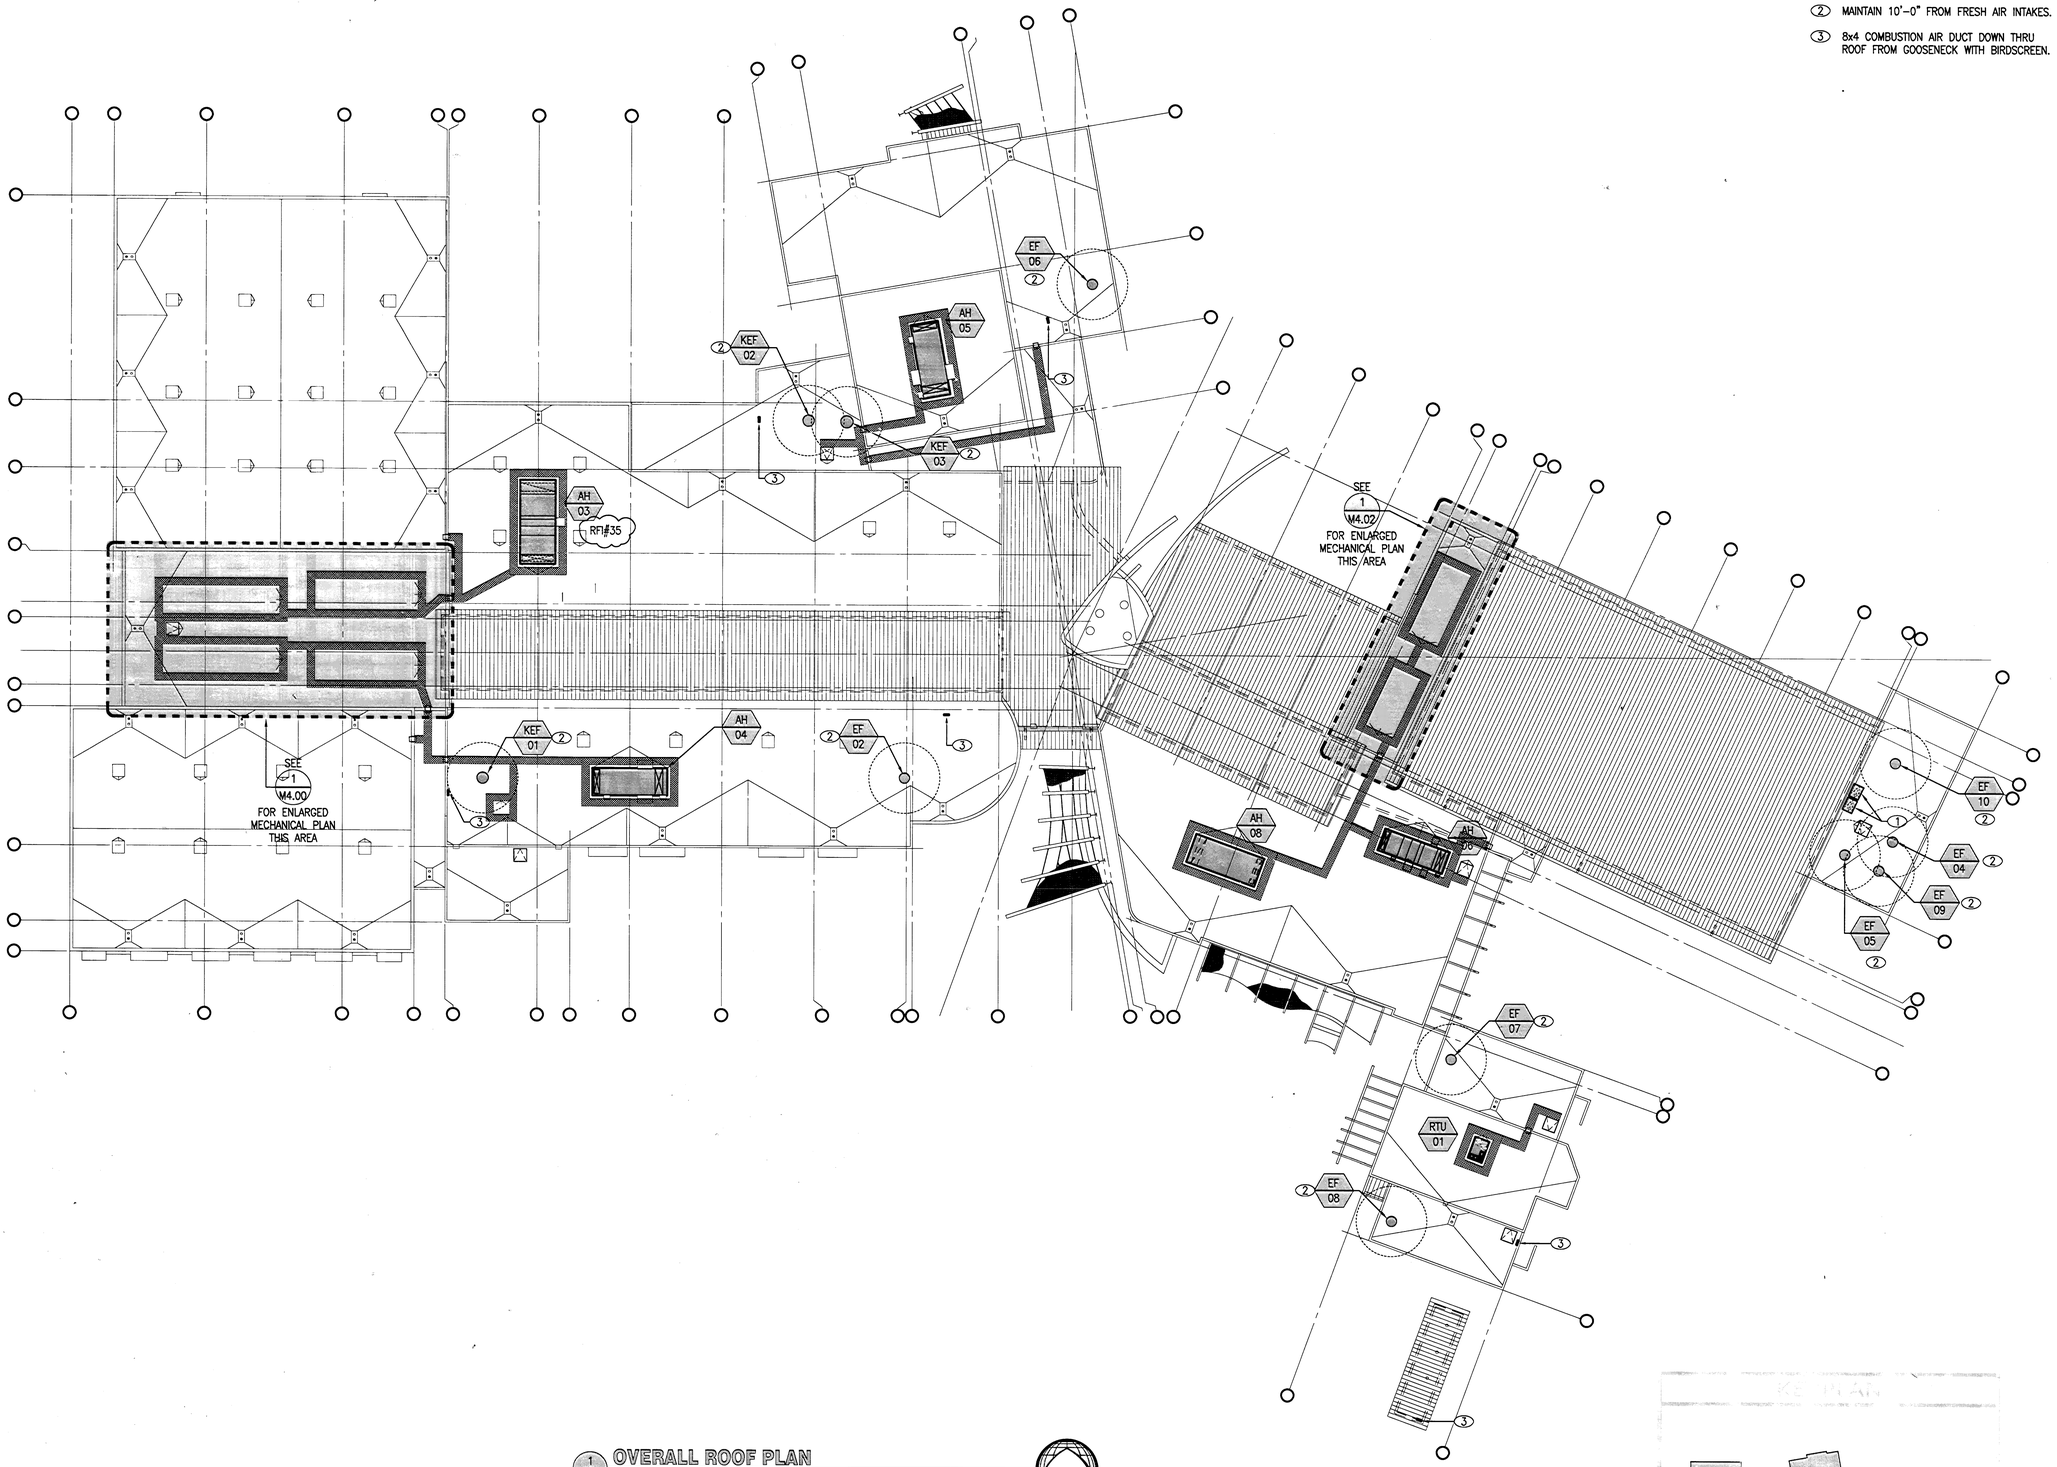

1 M3.00 OVERALL ROOF PLAN
SCALE: 1" = 20'-0"

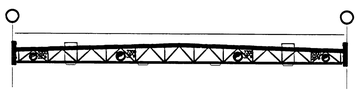

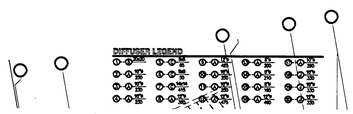

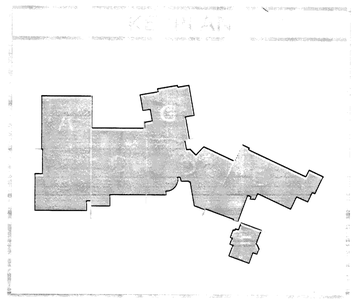

SHEET NOTES:
1. SEE SHEET M3.00 FO
2. SEE SHEET M3.00 FO
3. SEE SHEET M3.00 FO

RECORD DRAWINGS 10/05/07

LUCCHESI GALATI
503 RUBY ROAD, SUITE A
LAS VEGAS, NEVADA 89169
702 243-2111 FAX

Disclaimer: These record drawings prepared by Lucchesi Galati Architects, Inc., are based on information provided by others. Lucchesi Galati Architects, Inc. has not verified the accuracy and/or completeness of this information supplied by others; and shall not be responsible for any errors or omissions, which may be incorporated herein as a result.

STAMP

CITY OF LAS VEGAS
CENTENNIAL HILLS COMMUNITY CENTER
OVERALL ROOF PLAN
MECHANICAL

03-10-05
1" = 20'-0"
05153410
671-49

M3.00

1270834

017M3.00.TIF