SHEET NOTES

1. DROP 4" SD/OSD TO TERMINATE OUT OF WALL @ 6" ABOVE FINISH GRADE.
2. DROP 6" SD/OSD TO TERMINATE OUT OF WALL @ 6" ABOVE FINISH GRADE.
3. DROP 1/2" CW IN WALL. TEE 1/2" CW IN WALL TO HEATER. ROUTE 1/2" HW FROM HEATER TO SINK. RISE 2" V UP AND DROP 2" SS TO ROUTE BELOW FLOOR.
4. RISE 3" CW UP FROM BELOW GRADE IN WALL TO CEILING.
5. 3/4" CW DOWN IN PIPE CHASE/VOID.
6. REFER TO CIVIL UTILITY DRAWINGS FOR CONTINUATION.
7. DROP 1/2" CW IN WALL. RISE 2" V UP AND DROP 2" SS TO ROUTE BELOW FLOOR.
8. RISE 2" MPG UP FROM BELOW GRADE ALONG WALL TO CEILING.
9. DROP 1/2" CW IN WALL WITH ANGLE STOP IN WALL BOX.
10. 4" SD/OSD DOWN FROM ROOF DRAINAGE AND ROUTED BELOW ROOF STRUCTURE.
11. 8" SD/OSD DOWN FROM ROOF DRAINAGE AND ROUTED BELOW ROOF STRUCTURE.

PLUMBING PIPING SHALL NOT BE RUN IN CMU BLOCK. ROUTE PIPING EITHER IN FURRED OUT OR STUD WALLS.

KEYPLAN

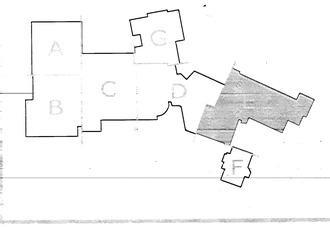

1 FLOOR PLAN - AREA E
P2.05 SCALE: 1/8" = 1'-0"

LUCCHESI GALATI
300 PILOT ROAD, SUITE A
LAS VEGAS, NEVADA 89119
(702) 263-2111 FAX (702) 263-4111

Disclaimer: These record drawings prepared by Lucchesi Galati Architects, Inc., are based on information provided by others and Lucchesi Galati Architects, Inc. has not verified the accuracy and/or completeness of this information supplied by others, and shall not be responsible for any errors or omissions, which may be incorporated herein as a result.

RECORD DRAWINGS 10/05/07

CITY OF LAS VEGAS
CENTENNIAL HILLS COMMUNITY CENTER
FLOOR PLAN - AREA E

STAMP

ISSUE
03-10-05
1/8" = 1'-0"
05153401.01
6711-49

P2.05

028 P2.05.TIF