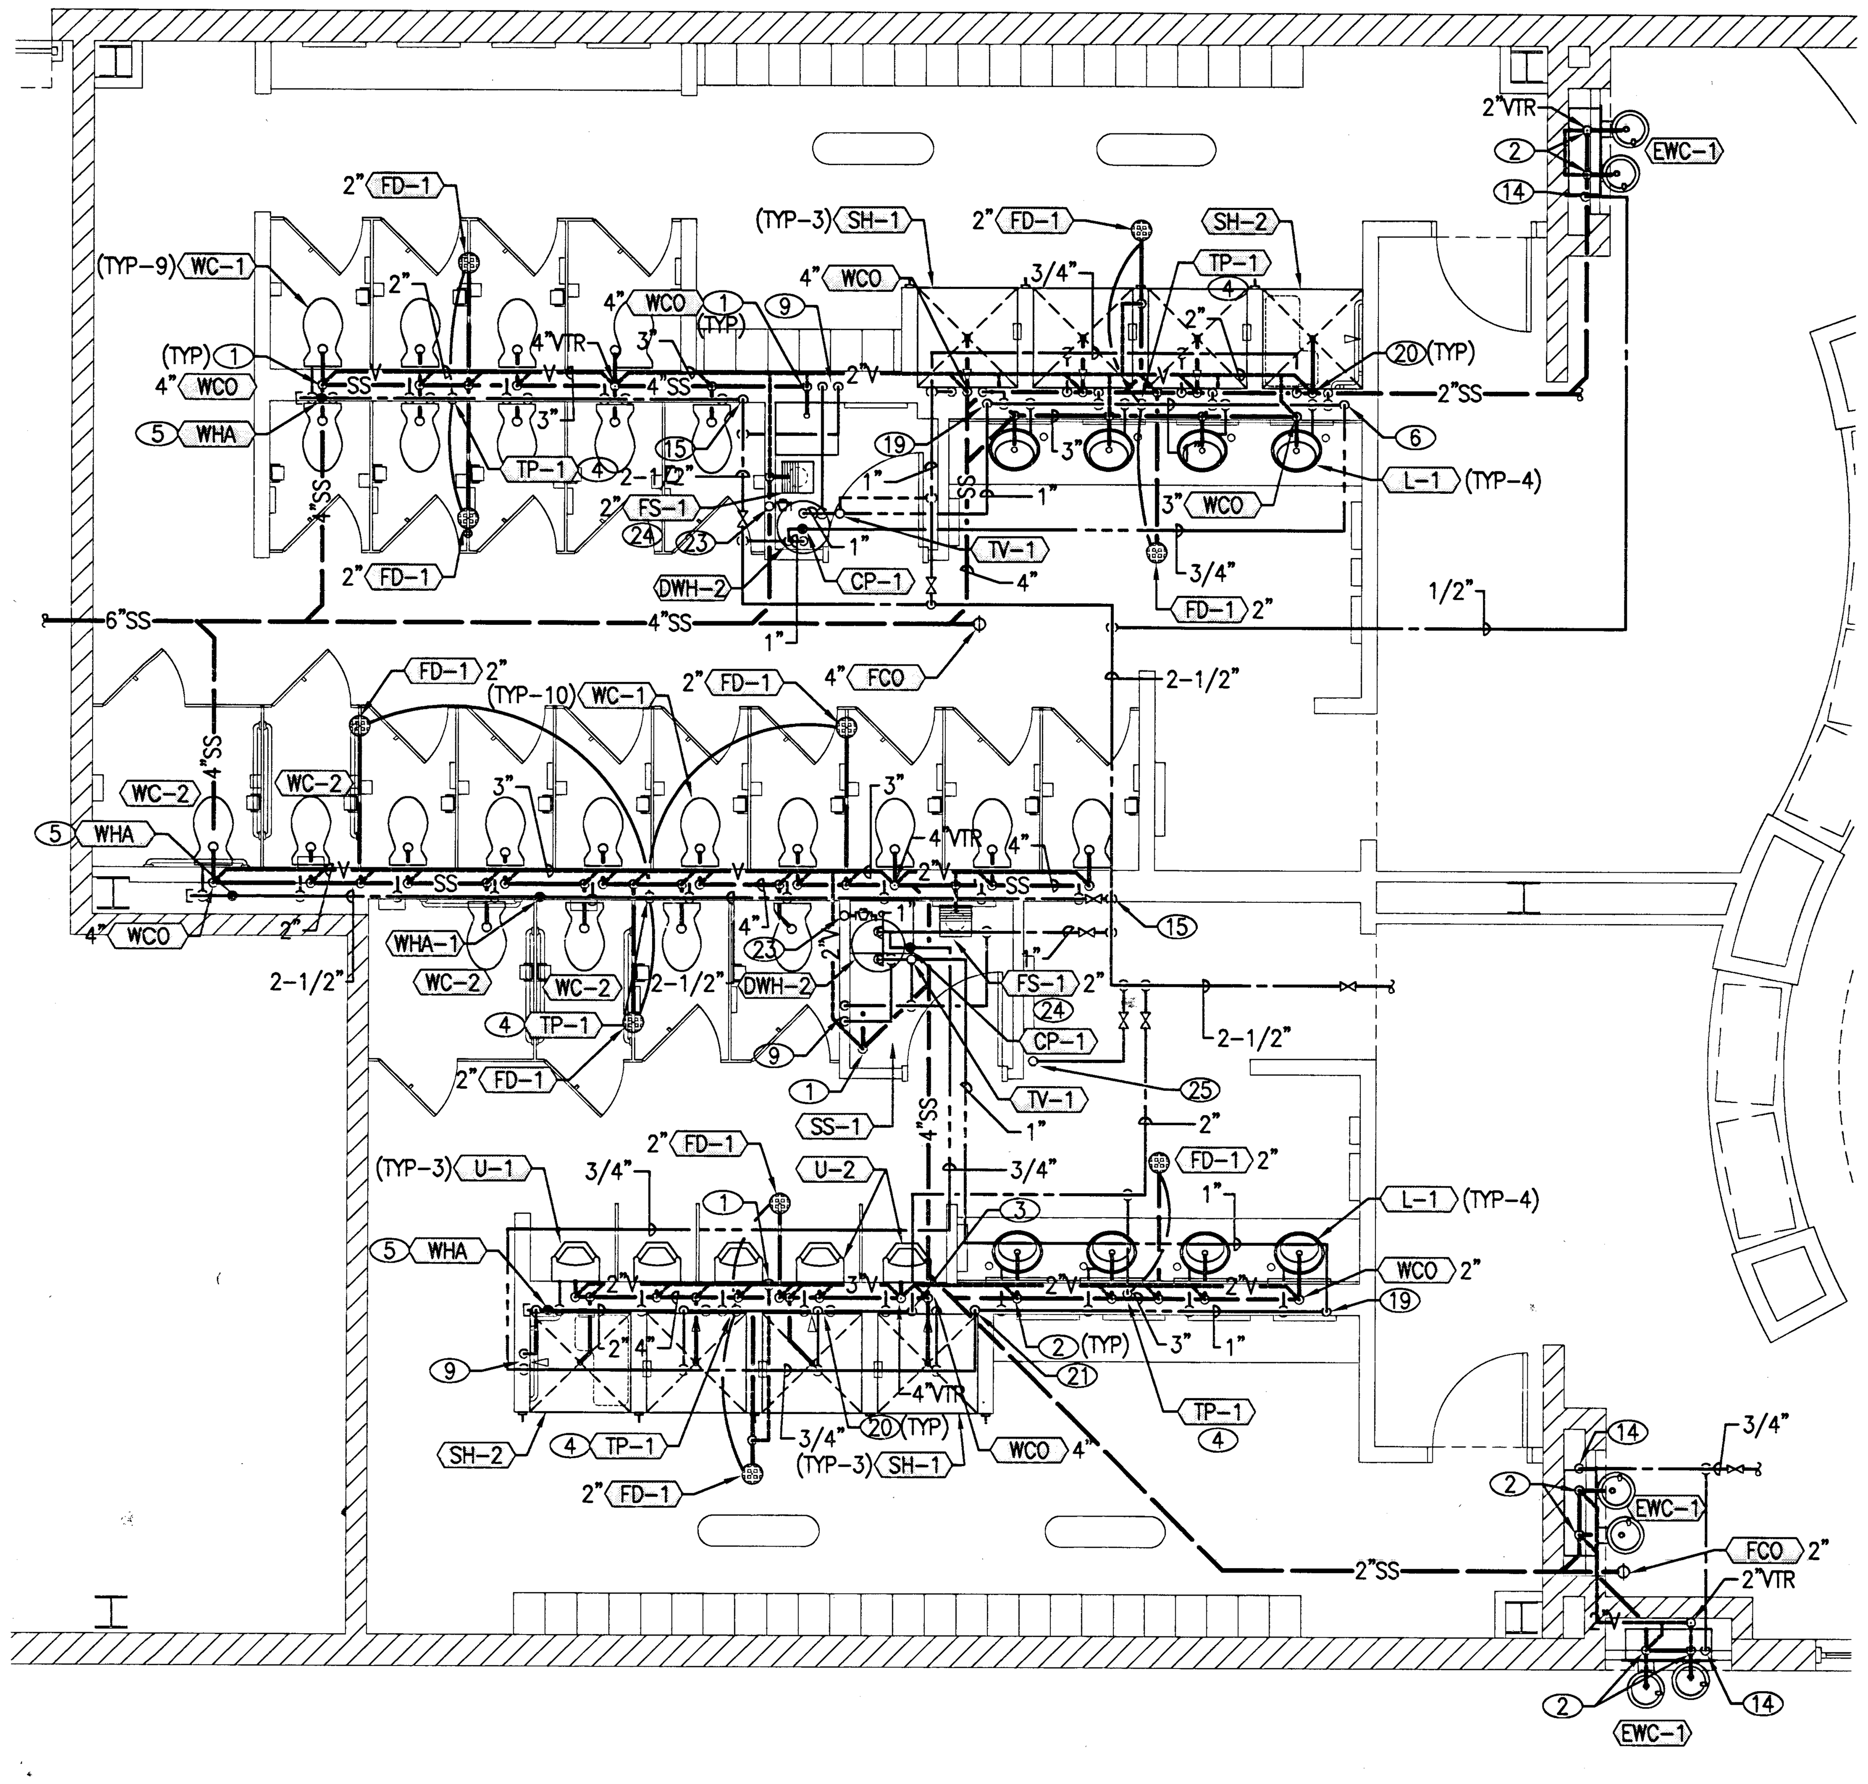

ENLARGED PLUMBING PLAN

1 / P4.01 SCALE: 1/4" = 1'-0"

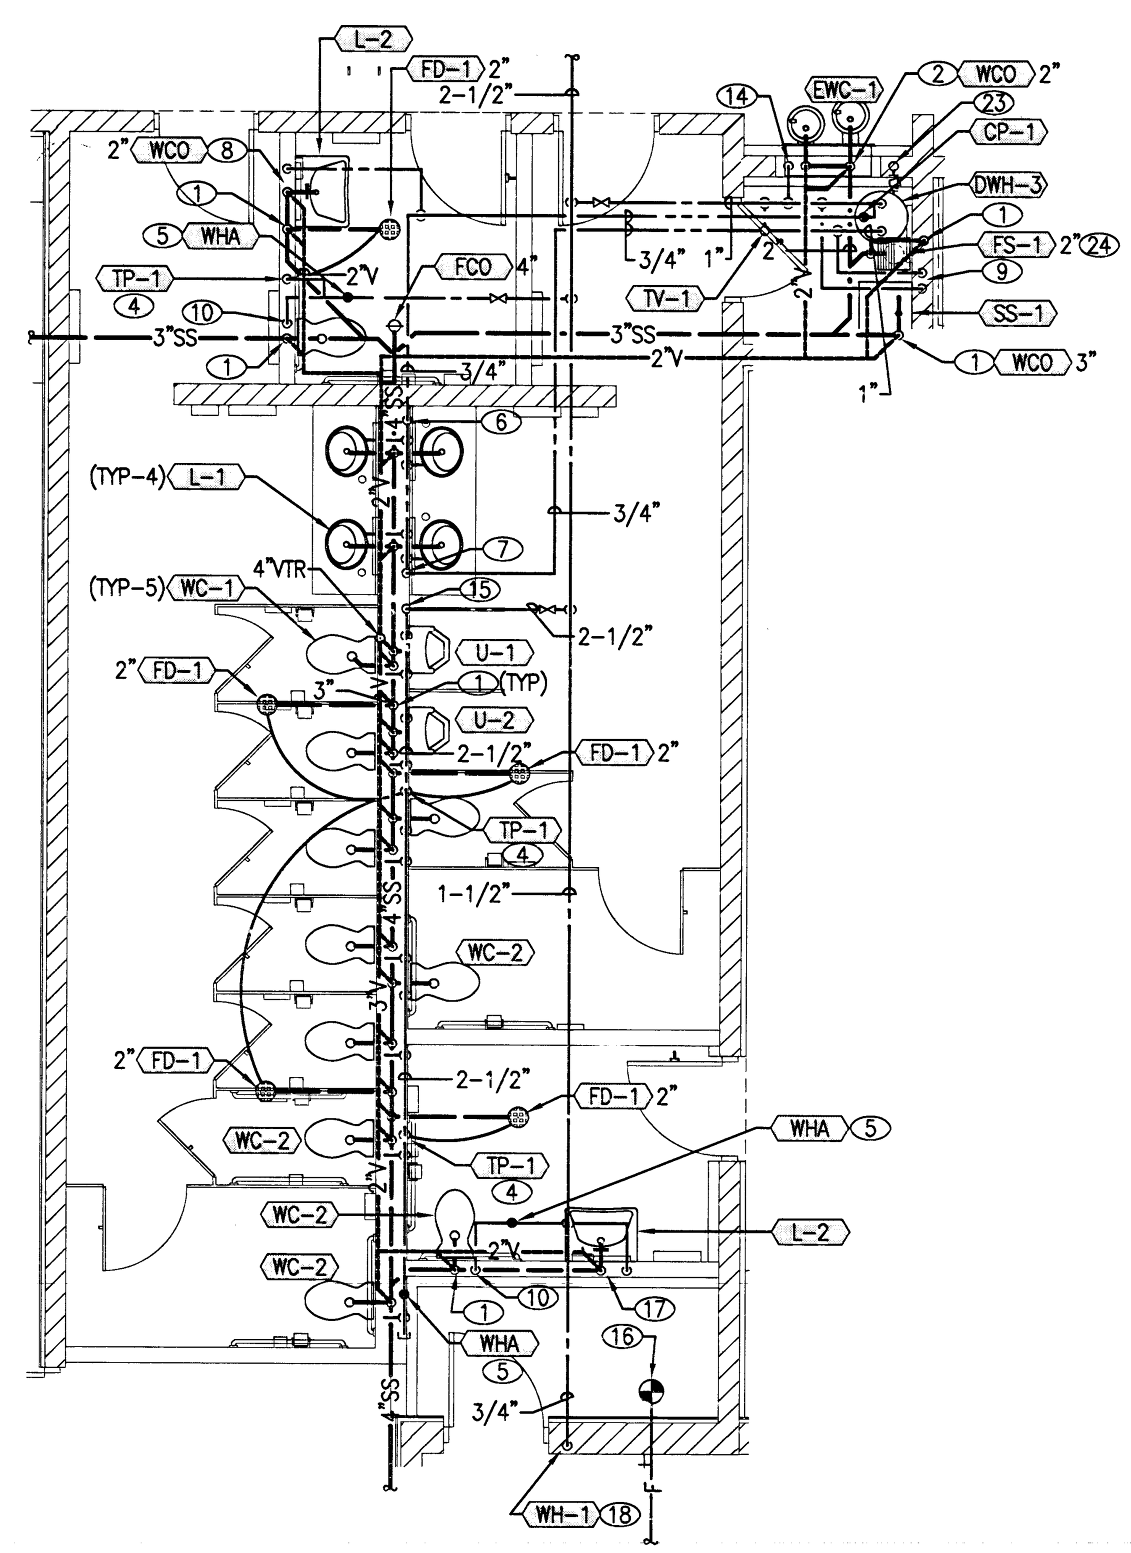

ENLARGED PLUMBING PLAN

2 / P4.01 SCALE: 1/4" = 1'-0"

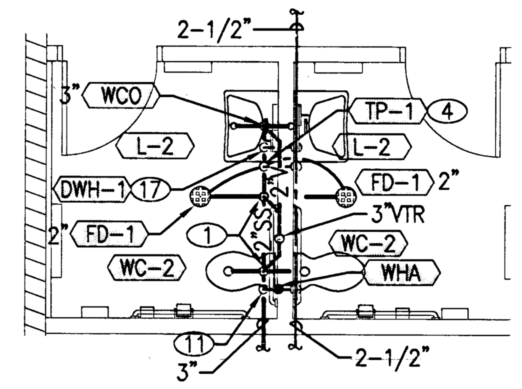

ENLARGED PLUMBING PLAN

3 / P4.01 SCALE: 1/4" = 1'-0"

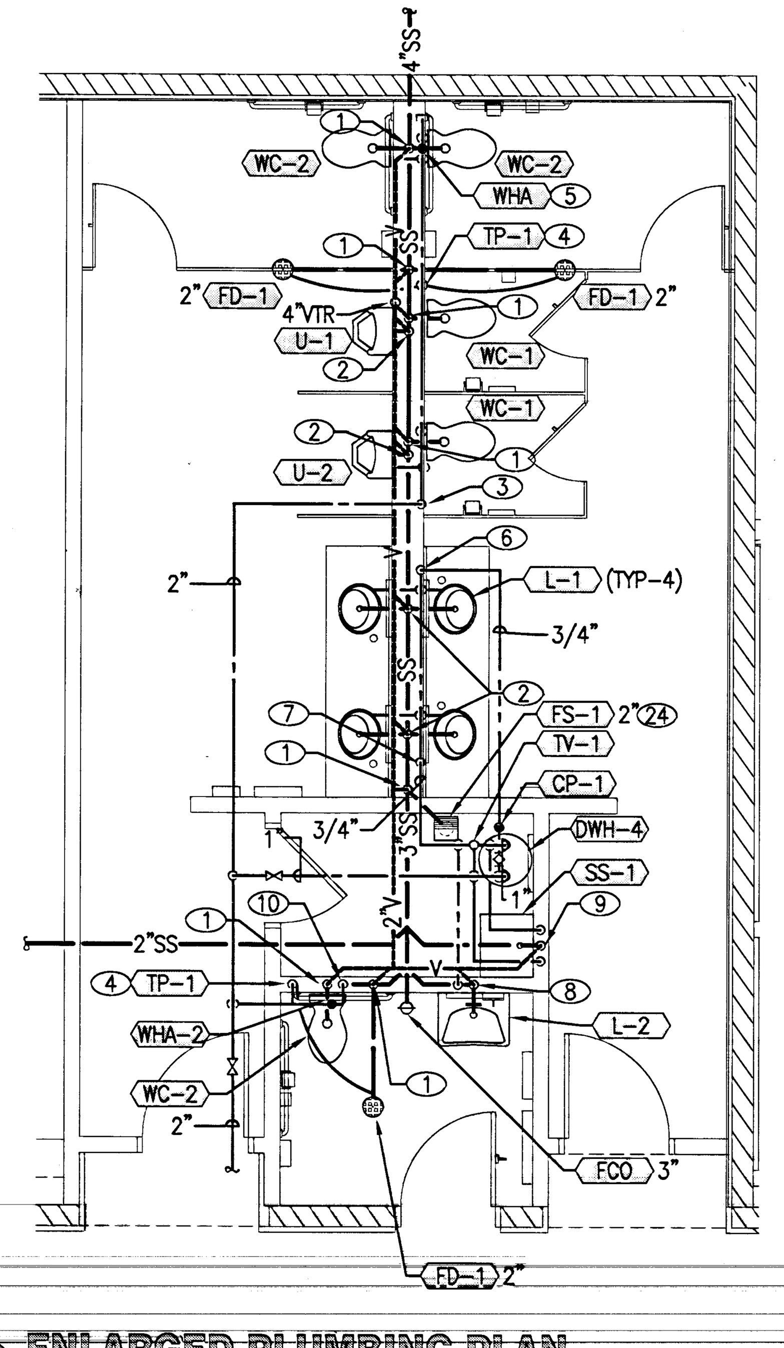

ENLARGED PLUMBING PLAN

4 / P4.01 SCALE: 1/4" = 1'-0"

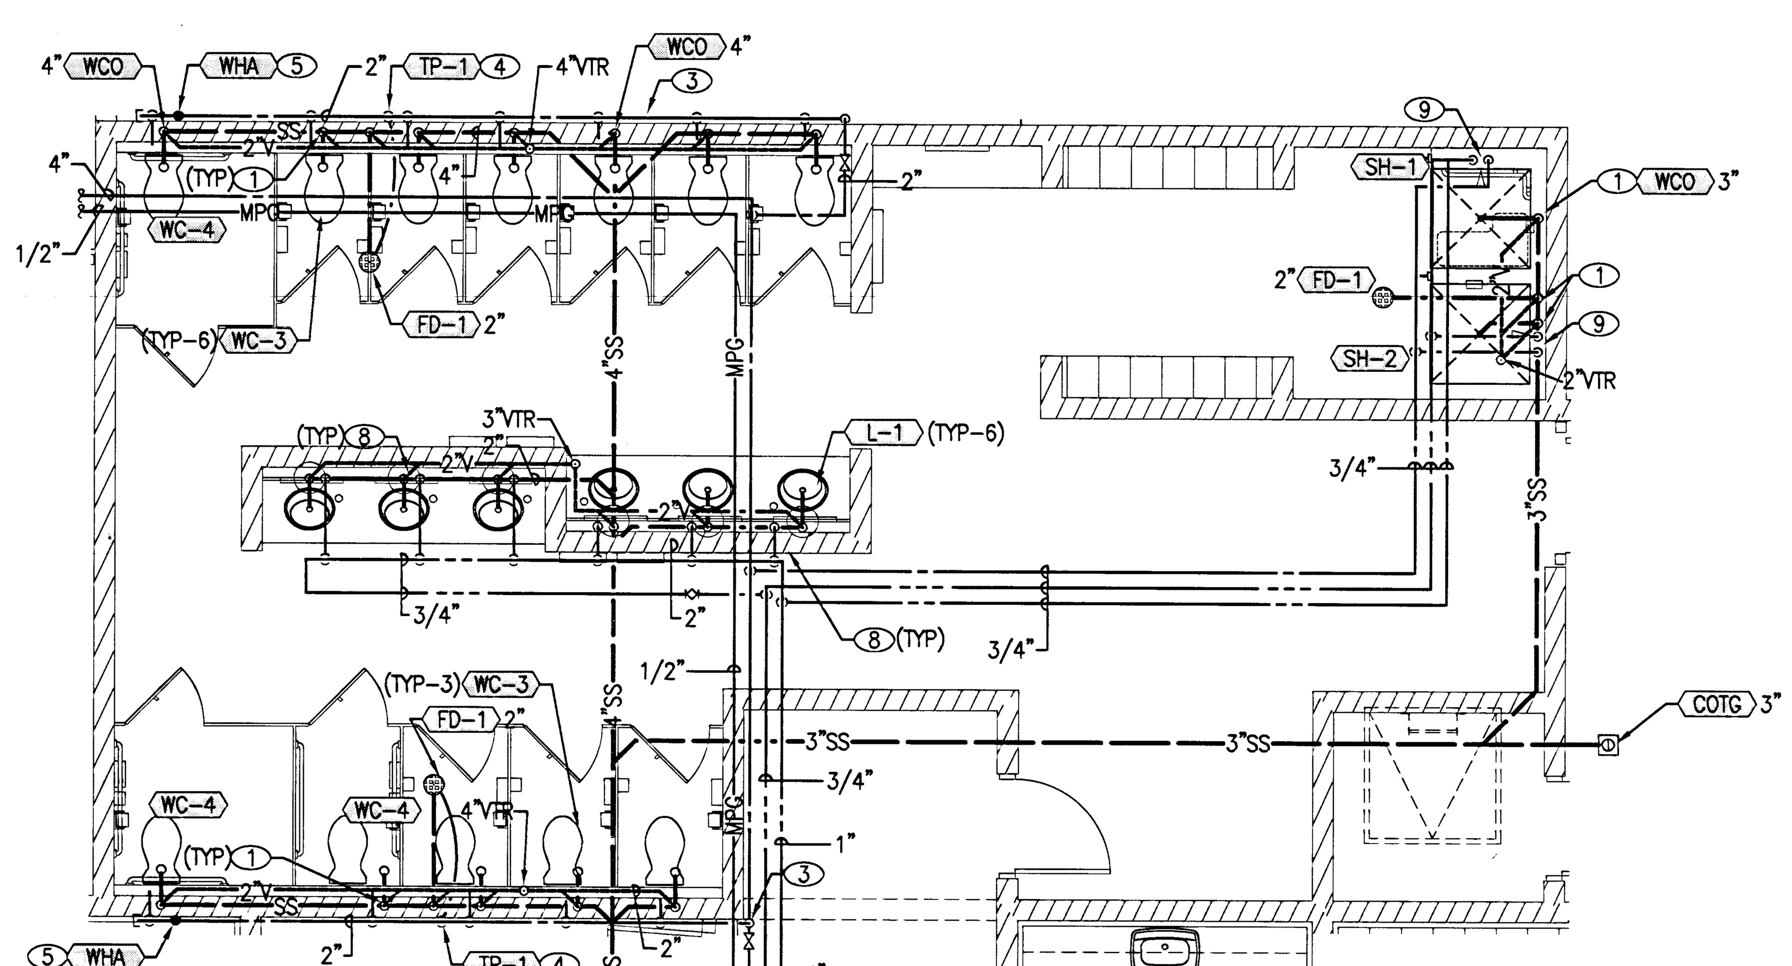

ENLARGED PLUMBING PLAN

5 / P4.01 SCALE: 1/4" = 1'-0"

SHEET NOTES

1. RISE 2" V UP FROM BELOW FLOOR IN WALL TO CEILING.
2. RISE 2" V UP AND DROP 2" SS TO ROUTE BELOW FLOOR.
3. DROP 2" CW AND ROUTE IN WALL.
4. DROP 1/2" CW BELOW FLOOR TO TIE INTO FLOOR DRAIN.
5. PROVIDE ACCESS PANEL TO WATER HAMMER ARRESTOR.
6. RISE 3/4" HW UP TO TIE INTO 3/4" HWC IN CEILING.
7. DROP 3/4" HW AND ROUTE IN WALL.
8. DROP 1/2" HW IN WALL. RISE 2" V UP AND DROP 2" SS TO ROUTE BELOW FLOOR.
9. DROP 1/2" CW/HW IN WALL.
10. DROP 1-1/2" CW IN WALL.
11. DROP 2" CW IN WALL.
12. DROP 3/4" HW IN WALL. RISE 2" V UP AND DROP 2" SS TO ROUTE BELOW FLOOR.
13. DROP 3/4" CW/HW IN WALL.
14. DROP 1/2" CW IN WALL.
15. DROP 2-1/2" CW AND ROUTE IN WALL.
16. LOCATION FOR FIRE RISER. REFER TO FIRE PROTECTION CONTRACTOR DRAWINGS FOR CONTINUATION. ACTUAL FIRE LINE SIZE TO BE DETERMINED BY FIRE SPRINKLER CONTRACTOR HYDRAULIC CALCULATIONS.
17. DROP 1/2" CW IN WALL. TEE 1/2" CW IN WALL TO HEATER. ROUTE 1/2" HW FROM HEATER TO SINK. RISE 2" V UP AND DROP 2" SS TO ROUTE BELOW FLOOR.
18. DROP 3/4" CW IN WALL.
19. DROP 1" HW AND ROUTE IN WALL.
20. DROP 1/2" HW IN WALL.
21. RISE 1" HW UP AND ROUTE IN CEILING.
22. DROP 1/2" CW/HW IN WALL. RISE 2" V UP AND DROP 2" SS TO ROUTE BELOW FLOOR.
23. 1/2" G DOWN FROM ABOVE WITH GAS COCK AND FLEX CONNECTION TO WATER HEATER.
24. (Revision 1) LOCATE FLOOR SINK AS FAR AWAY FROM SERVICE SINK AND NOT IN TRAFFIC AREA.
25. 3/4" CW TO WH-3 ON ROOF.

PLUMBING PIPING SHALL NOT BE RUN IN CMU BLOCK. ROUTE PIPING EITHER IN FURRED OUT OR STUD WALLS.

RECORD DRAWINGS 10/05/07

LUCCHESI • GALATI •
500 PILOT ROAD, SUITE A
LAS VEGAS, NEVADA 89119
(702) 263-7111
(702) 263-6111 FAX

Disclaimer: These record drawings prepared by Lucchesi Galati Architects. Inc., are based on information provided by others. Lucchesi Galati Architects, Inc. has not verified the accuracy and/or completeness of tis information supplied by others, and shall not be responsible for any errors or omissions, which may be incorporated herein as a result.

CITY OF LAS VEGAS
CENTENNIAL HILLS COMMUNITY CENTER
ENLARGED PLUMBING PLANS

03-15-05
AS NOTED
0515341.01
6TL-43

P4.01