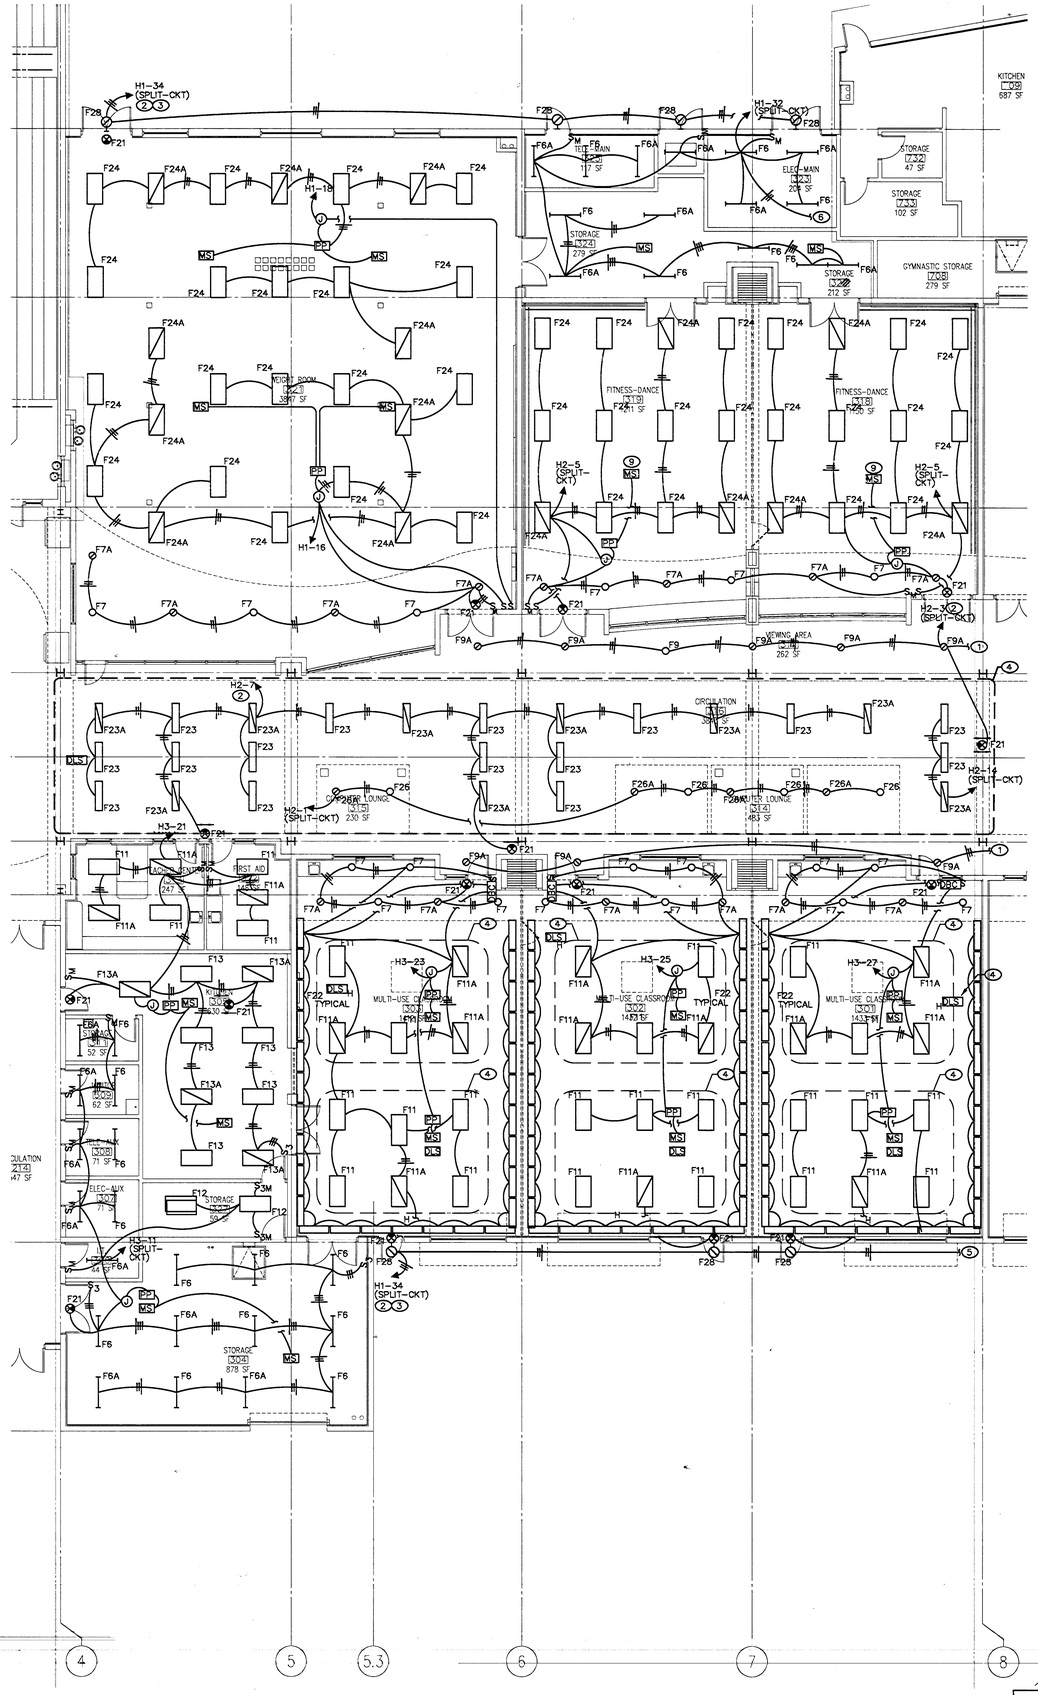

ELECTRICAL LIGHTING PLAN AREA C

SCALE: 1/8"=1'-0"

NOTES:

1. SEE SHEET E1.04 FOR CONTINUATION OF CIRCUIT H2-3.
2. ROUTE CIRCUIT THROUGH TIMECLOCK AND CONTACTOR. SEE CONTACTOR SCHEDULE.
3. PROVIDE ADDITIONAL WIRE TO CIRCUIT TO MAINTAIN CONSTANT HOT TO THE EMERGENCY BALLAST.
4. AREA TO BE CONTROLLED BY DAY LIGHTING SENSOR. SEE DETAIL 2/E4.04 FOR ADDITIONAL INFOPMATION.
5. SEE SHEET E1.04 FOR CONTINUATION OF CIRCUIT H1-34.
6. SEE SHEET E1.07 FOR CONTINUATION OF CIRCUIT H1-32.
7. MOUNT DAYLIGHT SENSOR BELOW SOFFIT MOUNTED LIGHTS.
8. SEE DETAIL 10/E4.02 FOR ADDITIONAL INFORMATION.
9. AREA TO BE CONTROLLED BY MOTION SENSOR WITH LOCAL SWITCH AT WALL.

THESE RECORD DOCUMENTS HAVE BEEN PREPARED BASED ON INFORMATION PROVIDED BY OTHERS. THE DESIGN PROFESSIONAL HAS NOT VERIFIED THE ACCURACY AND/OR COMPLETENESS OF THIS INFORMATION AND SHALL NOT BE RESPONSIBLE FOR ANY ERRORS OR OMISSIONS WHICH MAY BE INCORPORATED HEREIN AS A RESULT.

KEYPLAN

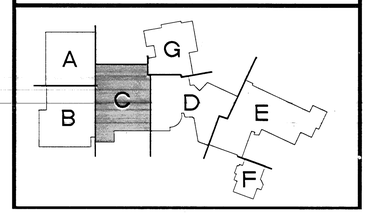

REVISIONS
RECORD DRAWINGS 10/15/07

CONSULTANT

LUCCHESI •GALATI•
501 PILOT ROAD, SUITE A
LAS VEGAS, NEVADA 89119
(702) 263-7711
(702) 263-8111 FAX

Disclaimer: These record drawings prepared by Lucchesi Galati Architects, Inc., are based on information provided by others. Lucchesi Galati Architects, Inc. has not verified the accuracy and/or completeness of tis information supplied by others, and shall not be responsible for any errors or omissions, which may be incorporated herein as a result.

CITY OF LAS VEGAS
CENTENNIAL HILLS COMMUNITY CENTER
RECORD DRAWINGS
ELECTRICAL LIGHTING PLAN AREA C

STAMP

OWNER: CITY OF LAS VEGAS
DEPARTMENT OF PUBLIC WORKS
ARCHITECTURAL SERVICES

400 EAST STEWART AVENUE
LAS VEGAS, NEVADA 89101
PHONE: (702)229-5535
FAX: (702)384-8846
TDD: (702)386-9108

DRAWN
TITLE
DATE 03/18/05
SCALE
PROJ NO 05.1534.01
CITY DWG NO 671-49
SHT NO E1.03

DRAWINGS AS INSTRUMENTS OF SERVICE ARE THE PROPERTY OF THE DESIGN PROFESSIONAL WHOSE STAMP OF CERTIFICATION APPEARS ON THE DRAWINGS AND SPECIFICATIONS ANY USE OR REPRODUCTION IN WHOLE OR IN PART WITHOUT WRITTEN CONSENT IS STRICTLY PROHIBITED COPIES OF THE DRAWINGS AND SPECIFICATIONS RETAINED BY THE CLIENT MAY BE UTILIZED ONLY FOR OCCUPYING THE PROJECT FOR WHICH THEY WERE PREPARED AND NOT FOR THE CONSTRUCTION OF ANY OTHER PROJECT N.A.C. 623.780

12/7/07