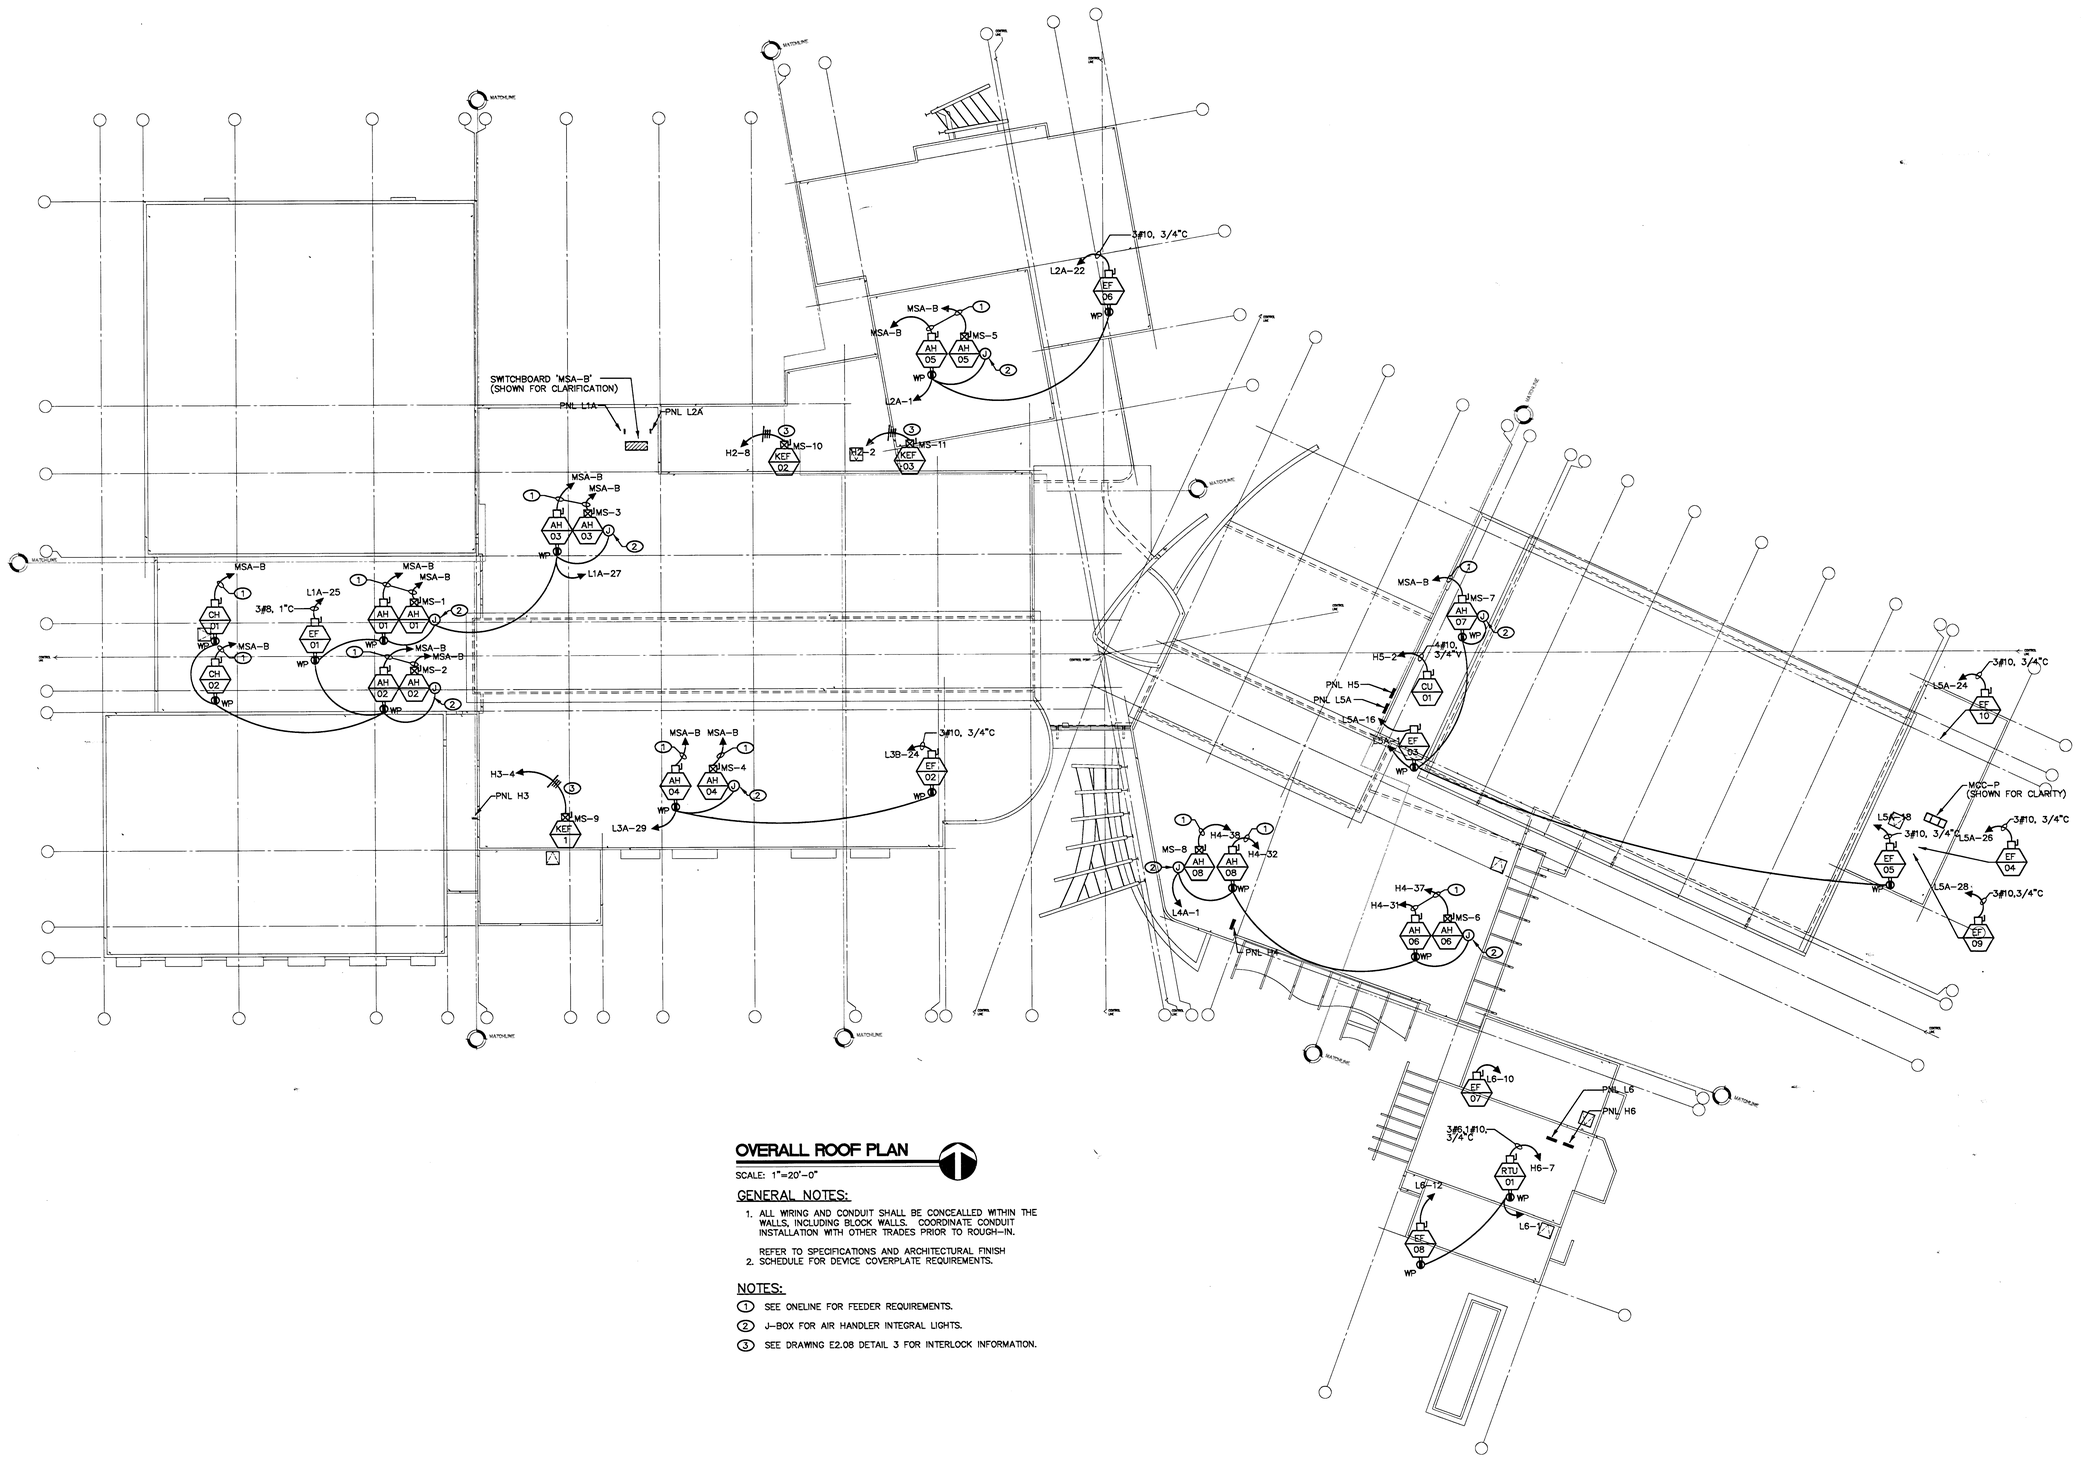

OVERALL ROOF PLAN

SCALE: 1"=20'-0"

GENERAL NOTES:

1. ALL WIRING AND CONDUIT SHALL BE CONCEALLED WITHIN THE WALLS, INCLUDING BLOCK WALLS. COORDINATE CONDUIT INSTALLATION WITH OTHER TRADES PRIOR TO ROUGH-IN.
2. REFER TO SPECIFICATIONS AND ARCHITECTURAL FINISH SCHEDULE FOR DEVICE COVERPLATE REQUIREMENTS.

NOTES:

1. SEE ONELINE FOR FEEDER REQUIREMENTS.
2. J-BOX FOR AIR HANDLER INTEGRAL LIGHTS.
3. SEE DRAWING E2.08 DETAIL 3 FOR INTERLOCK INFORMATION.

THESE RECORD DOCUMENTS HAVE BEEN PREPARED BASED ON INFORMATION PROVIDED BY OTHERS. THE DESIGN PROFESSIONAL HAS NOT VERIFIED THE ACCURACY AND/OR COMPLETENESS OF THIS INFORMATION AND SHALL NOT BE RESPONSIBLE FOR ANY ERRORS OR OMISSIONS WHICH MAY BE INCORPORATED HEREIN AS A RESULT.

KEYPLAN

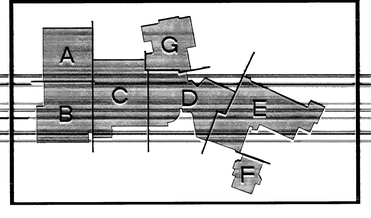

REVISIONS

RECORD DRAWINGS 10/05/07

CONSULTANT

LUCCHESI •GALATI•
500 PILOT ROAD, SUITE A
LAS VEGAS, NEVADA 89119
(702) 263-7111
(702) 263-8111 FAX

Disclaimer: These record drawings prepared by Lucchesi Galati Architects, Inc., are based on information provided by others. Lucchesi Galati Architects, Inc. has not verified the accuracy and/or completeness of tis information supplied by others, and shall not be responsible for any errors or omissions, which may be incorporated herein as a result.

CITY OF LAS VEGAS
CENTENNIAL HILLS COMMUNITY CENTER
RECORD DRAWINGS
OVERALL ROOF PLAN

STAMP

OWNER: CITY OF LAS VEGAS
DEPARTMENT OF PUBLIC WORKS
ARCHITECTURAL SERVICES

400 EAST STEWART AVENUE
LAS VEGAS, NEVADA 89101
PHONE: (702) 229-5535
FAX: (702) 384-4846
TDD: (702) 386-9108

DRAWN
TITLE
DATE 03/18/05
SCALE
REC NO 05.5341.01
CLIENT NO 671-49
SHT NO E2.00

DRAWINGS AS INSTRUMENTS OF SERVICE ARE THE PROPERTY OF THE DESIGN PROFESSIONAL WHOSE STAMP OF CERTIFICATION APPEARS ON THE DRAWINGS AND SPECIFICATIONS ANY USE OR REPRODUCTION IN WHOLE OR IN PART WITHOUT WRITTEN CONSENT IS STRICTLY PROHIBITED COPIES OF THE DRAWINGS AND SPECIFICATIONS RETAINED BY THE CLIENT MAY BE UTILIZED ONLY FOR OCCUPYING THE PROJECT FOR WHICH THEY WERE PREPARED AND NOT FOR THE CONSTRUCTION OF ANY OTHER PROJECT N A C 623.760

045 E2.00.TIF

127112