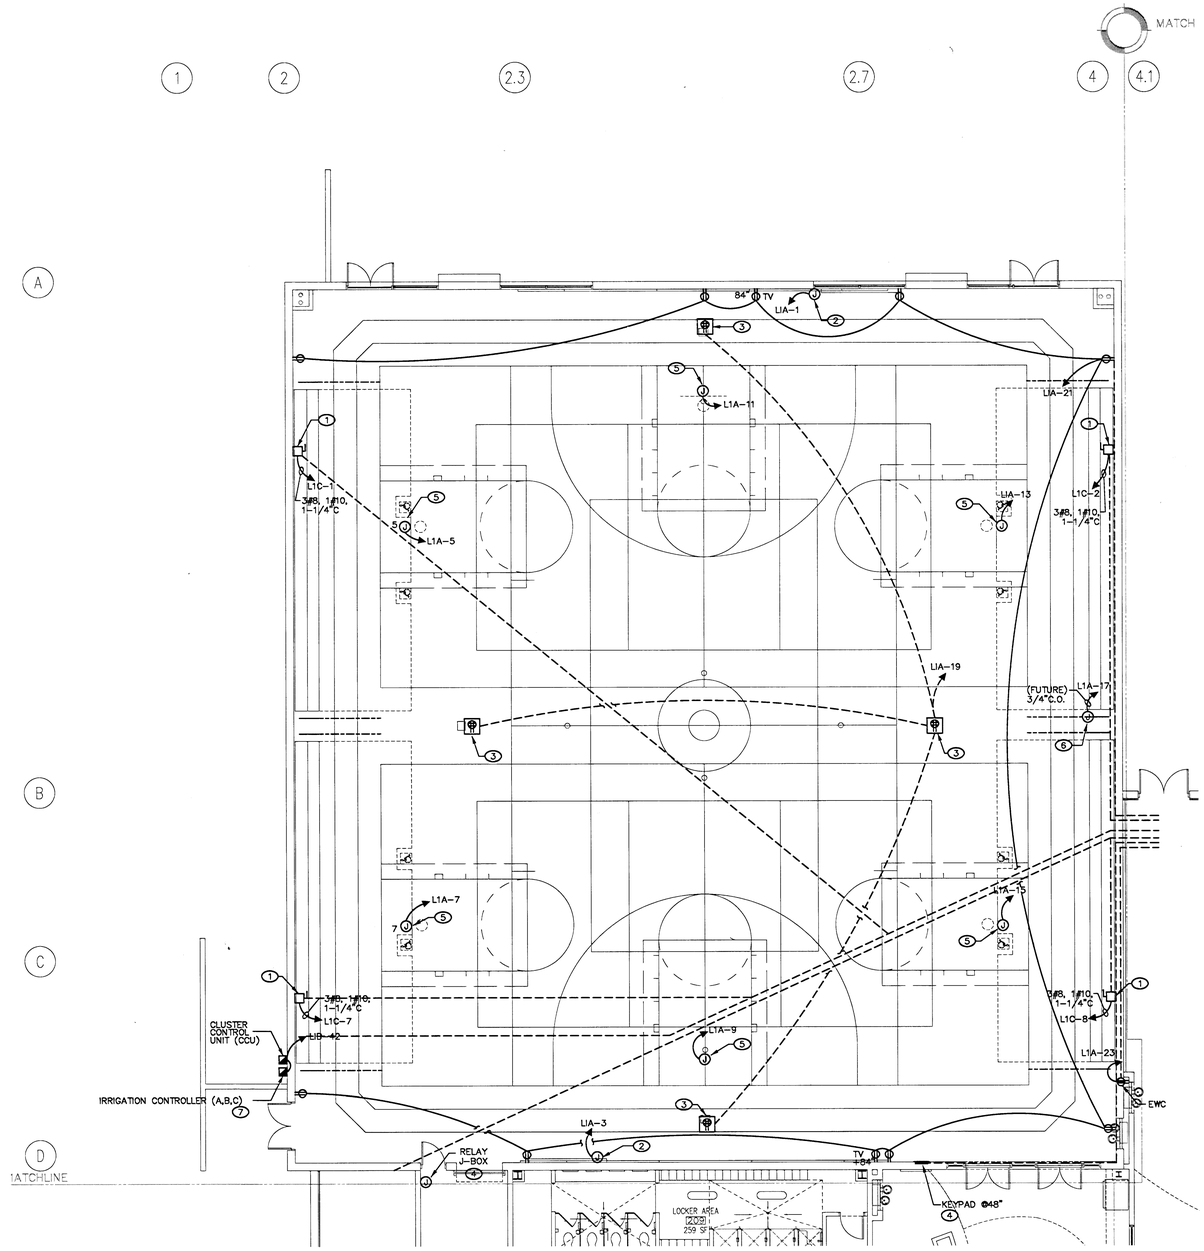

ELECTRICAL POWER PLAN AREA A

SCALE: 1/8"=1'-0"

NOTES:

1. PROVIDE DISCONNECT FOR CONNECTION TO BLEACHERS (MOUNT AT 36" AFF). COORDINATE LOCATION WITH BLEACHERS MANUFACTURER.
2. J-BOX FOR SCOREBOARD. VERIFY HEIGHT WITH ARCHITECT.
3. SEE DETAIL 5/E4.01 FOR FLOOR BOX AND INSTALLATION INFORMATION. REFER TO ARCHITECTURAL DRAWINGS FOR DIMENSIONING.
4. HOOP/CURTAIN CONTROL EQUIPMENT SEE DETAIL 1/E2.01.
5. J-BOX FOR EQUIPMENT CONTROLS ADJUSTABLE BASKETBALL HOOP, LIGHTS & CURTAIN, MOUNTED PER MANUFACTURER SPECIFICATIONS. SEE DETAIL 1/E2.01 FOR CONTROL INFORMATION.
6. J-BOX FOR FUTURE DIVIDER CURTAIN. SEE DETAIL 1/E2.01 FOR CONTROL INFORMATION.
7. ~~COORDINATE LOCATION OF IRRIGATION EQUIPMENT WITH IRRIGATION DRAWINGS.~~

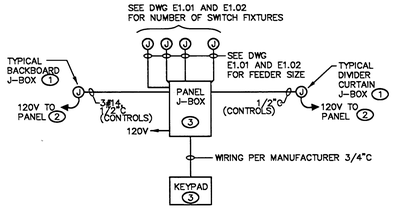

1 / E2.01 LIGHT/HOOP/CURTAIN CONTROL DIAGRAM

NOT TO SCALE

NOTES:

1. PROVIDE 4S J-BOX WITHIN 3' OF BACKBOARD AND FUTURE CURTAIN.
2. SEE POWER PLANS FOR FEEDER INFORMATION.
3. RELAY, KEYPAD, AND ASSOCIATED EQUIPMENT PROVIDED WITH THE MANUFACTURED CONTROLS. SEE ARCHITECTURAL DRAWINGS AND SPECIFICATION FOR ADDITIONAL INFORMATION.

GENERAL NOTES:

1. ALL WIRING AND CONDUIT SHALL BE CONCEALLED WITHIN THE WALLS, INCLUDING BLOCK WALLS. COORDINATE CONDUIT INSTALLATION WITH OTHER TRADES PRIOR TO ROUGH-IN.

   REFER TO SPECIFICATIONS AND ARCHITECTURAL FINISH
2. SCHEDULE FOR DEVICE COVERPLATE REQUIREMENTS.

THESE RECORD DOCUMENTS HAVE BEEN PREPARED BASED ON INFORMATION PROVIDED BY OTHERS. THE DESIGN PROFESSIONAL HAS NOT VERIFIED THE ACCURACY AND/OR COMPLETENESS OF THIS INFORMATION AND SHALL NOT BE RESPONSIBLE FOR ANY ERRORS OR OMISSIONS WHICH MAY BE INCORPORATED HEREIN AS A RESULT.

KEYPLAN

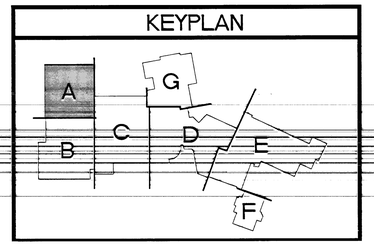

REVISIONS
RECORD DRAWINGS 10/05/07

CONSULTANT

500 WEST HOVAT, SUITE A
LAS VEGAS, NEVADA 89119
(702) 263-7111
(702) 263-8111 FAX

LUCCHESI •GALATI•

Disclaimer: These record drawings prepared by Lucchesi Galati Architects, Inc., are based on information provided by others. Lucchesi Galati Architects, Inc. has not verified the accuracy and/or completeness of its information supplied by others, and shall not be responsible for any errors or omissions, which may be incorporated herein as a result.

CITY OF LAS VEGAS
CENTENNIAL HILLS COMMUNITY CENTER
RECORD DRAWINGS
ELECTRICAL POWER PLAN AREA A

STAMP

OWNER: CITY OF LAS VEGAS
DEPARTMENT OF PUBLIC WORKS
ARCHITECTURAL SERVICES

400 EAST STEWART AVENUE
LAS VEGAS, NEVADA 89101
PHONE: (702)229-6533
FAX: (702)384-8846
TDD: (702)386-9108

DRAWN
FILE
DATE 03/18/05
SCALE
PROJ NO 05534.01
CLV DWG NO 671-49
SHT NO E2.01

DRAWINGS AS INSTRUMENTS OF SERVICE ARE THE PROPERTY OF THE DESIGN PROFESSIONAL WHOSE STAMP OF CERTIFICATION APPEARS ON THE DRAWINGS AND SPECIFICATIONS. ANY USE OR REPRODUCTION IN WHOLE OR IN PART WITHOUT WRITTEN CONSENT IS STRICTLY PROHIBITED. COPIES OF THE DRAWINGS AND SPECIFICATIONS RETAINED BY THE CLIENT MAY BE UTILIZED ONLY FOR OCCUPYING THE PROJECT FOR WHICH THEY WERE PREPARED AND NOT FOR THE CONSTRUCTION OF ANY OTHER PROJECT. N.A.C. 623.780.

046 E2.01.TIF

12-7-13