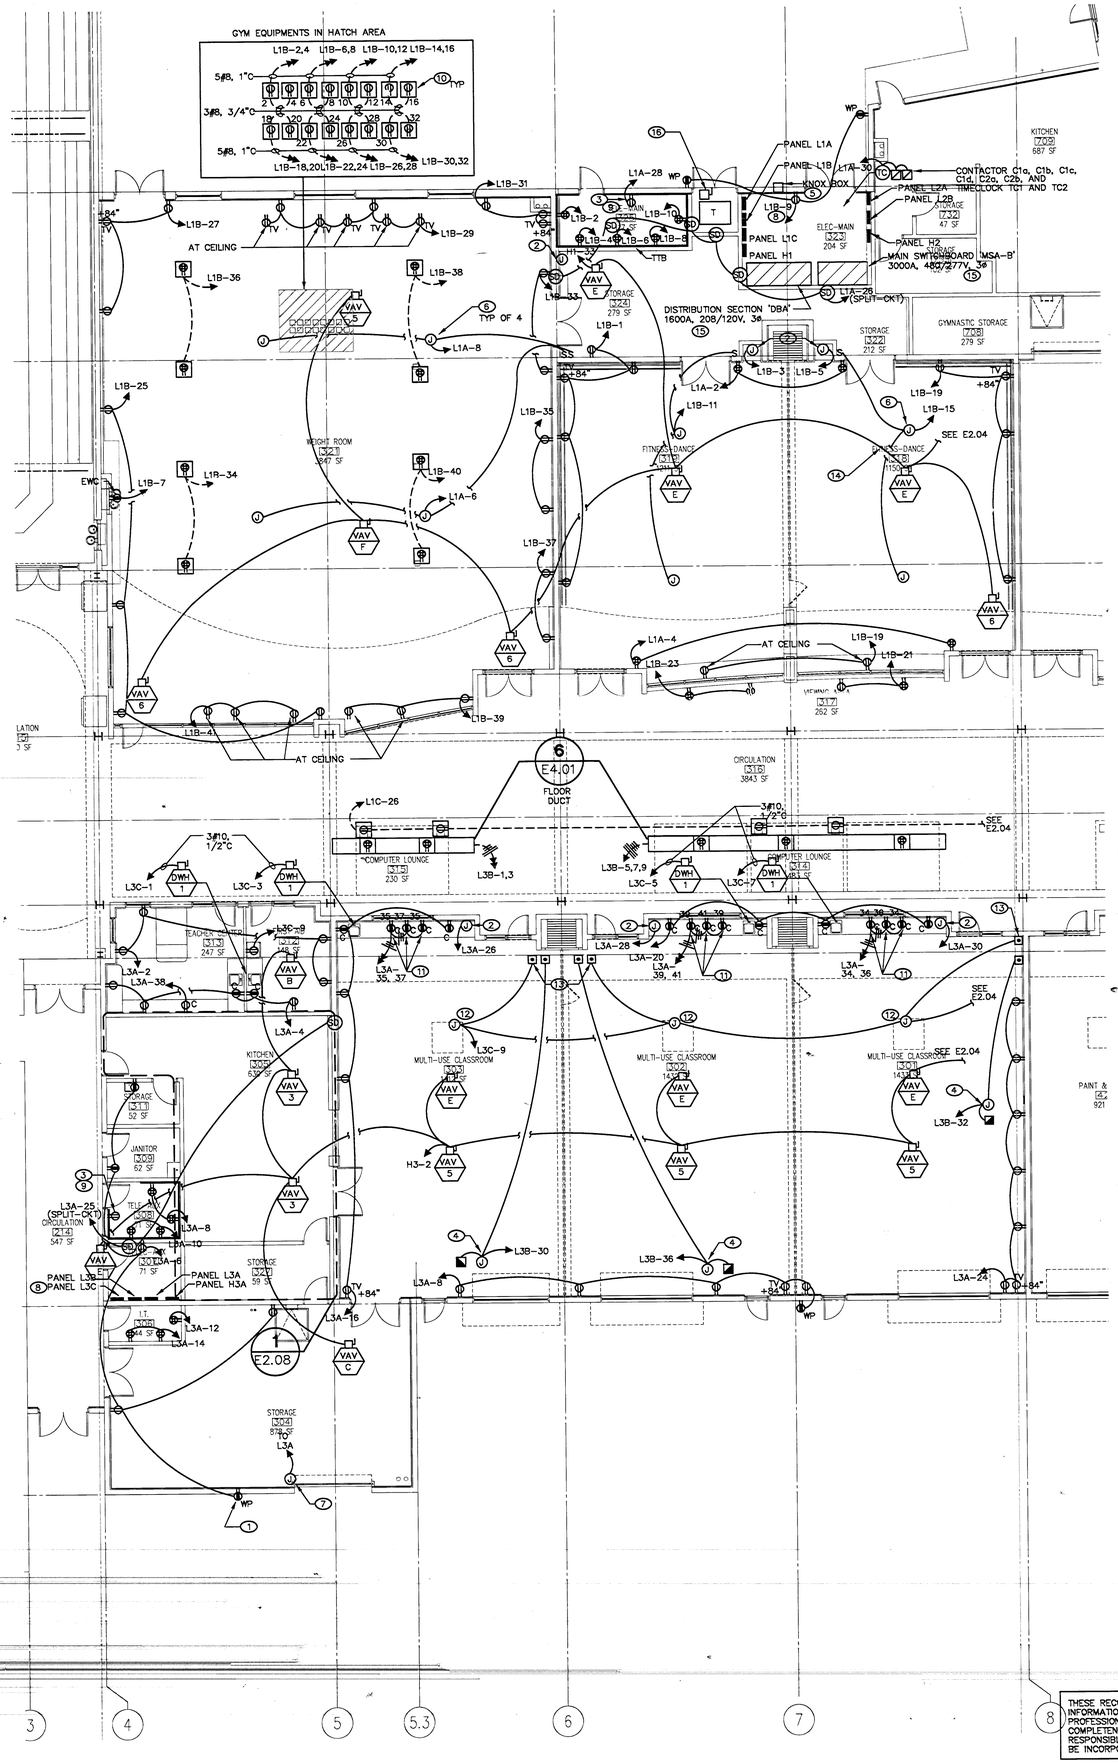

ELECTRICAL POWER PLAN AREA C

SCALE: 1/8"=1'-0"

NOTES:

1. PROVIDE LOCKABLE ENCLOSURE SUITABLE FOR WET LOCATIONS WHILE IN USE.
2. J-BOX POWER (DOUBLE DUPLEX RECEPTACLE) TO THE SOUND SYSTEM. MOUNT IN UPPER CABINETING. COORDINATE LOCATION WITH SOUND SYSTEM INSTALLER.
3. POWER FOR SECURITY EQUIPMENT. (CARD READERS, DOOR CONTACTS, ETC)
4. J-BOX FOR MOTORIZED PROJECTION SCREEN.
5. INSTALL KNOX BOX PER SOUTHERN NEVADA AMENDMENT TO THE NEC. COORDINATE WITH ARCHITECUAL DRAWINGS FOR ADDITIONAL INFORMATION.
6. J-BOX FOR FAN, SUITABLE FOR 50LBS. COORDINATE LOCATION OF FAN WITH ARCHITECTURAL DRAWINGS.
7. J-BOX FOR FUTURE ROLL-UP DOOR CONNECTION.
8. SEE ONELINE DIAGRAM FOR FEEDER INFORMATION.
9. SEE DRAWINGS E3.08 AND E3.09 FOR SECURITY CONDUIT REQUIREMENTS.
10. SEE ARCHITECTURAL DRAWINGS FOR DIMENSIONAL LOCATION OF FLOOR BOXES.
11. SPACE RECEPTACLES EVENLY AT THE COUNTERS.
12. J-BOX FOR CONTROL POWER AT THE SKYLIGHTS.
13. CONTROL STATION FOR SKYLIGHT LOUVER CONTROL.
14. PROVIDE MIRRORED COVERPLATES ON ALL DEVICES MOUNTED ON MIRRORED SURFACES.
15. MOUNT EQUIPMENT ON 4" HOUSEKEEPING PAD.
16. MOUNT DISCONNECT ON UNISTRUT RACK ABOVE TRANSFORMER.

GENERAL NOTES:

1. ALL WIRING AND CONDUIT SHALL BE CONCEALLED WITHIN THE WALLS, INCLUDING BLOCK WALLS. COORDINATE CONDUIT INSTALLATION WITH OTHER TRADES PRIOR TO ROUGH-IN.

   REFER TO SPECIFICATIONS AND ARCHITECTURAL FINISH
2. SCHEDULE FOR DEVICE COVERPLATE REQUIREMENTS.

THESE RECORD DOCUMENTS HAVE BEEN PREPARED BASED ON INFORMATION PROVIDED BY OTHERS. THE DESIGN PROFESSIONAL HAS NOT VERIFIED THE ACCURACY AND/OR COMPLETENESS OF THIS INFORMATION AND SHALL NOT BE RESPONSIBLE FOR ANY ERRORS OR OMISSIONS WHICH MAY BE INCORPORATED HEREIN AS A RESULT.

KEYPLAN

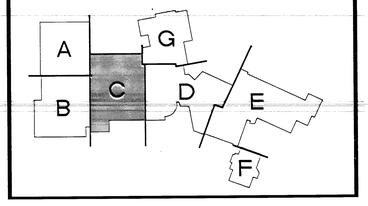

REVISIONS
RECORD DRAWINGS 10/05/07

CONSULTANT

LUCCHESI •GALATI•
501 PILOT ROAD, SUITE A
LAS VEGAS, NEVADA 89119
(702) 263-7111
(702) 263-8111 FAX

Disclaimer: These record drawings prepared by Lucchesi Galati Architects, Inc., are based on information provided by others. Lucchesi Galati Architects, Inc. has not verified the accuracy and/or completeness of tis information supplied by others, and shall not be responsible for any errors or omissions, which may be incorporated herein as a result.

CITY OF LAS VEGAS
CENTENNIAL HILLS COMMUNITY CENTER
RECORD DRAWINGS
ELECTRICAL POWER PLAN AREA C

STAMP

OWNER: CITY OF LAS VEGAS
DEPARTMENT OF PUBLIC WORKS
ARCHITECTURAL SERVICES

400 EAST STEWART AVENUE
LAS VEGAS, NEVADA 89101
PHONE: (702) 229-5535
FAX: (702) 384-8846
TDD: (702) 386-9108

DRAWN
TITLE
DATE 03/18/05
SCALE
PROJ NO 05.15341.01
CLV DWG NO 611-49
SHT NO E2.03

DRAWINGS AS INSTRUMENTS OF SERVICE ARE THE PROPERTY OF THE DESIGN PROFESSIONAL WHOSE STAMP OF CERTIFICATION APPEARS ON THE DRAWINGS AND SPECIFICATIONS. ANY USE OR REPRODUCTION, IN WHOLE OR IN PART, WITHOUT WRITTEN CONSENT IS STRICTLY PROHIBITED EXCEPT OF THE DRAWINGS AND SPECIFICATIONS RETAINED BY THE CLIENT MAY BE UTILIZED ONLY FOR OCCUPYING THE PROJECT FOR WHICH THEY WERE PREPARED AND NOT FOR THE CONSTRUCTION OF ANY OTHER PROJECT. N.A.C. 623.780

12-7-05

048 E2.03.TIF