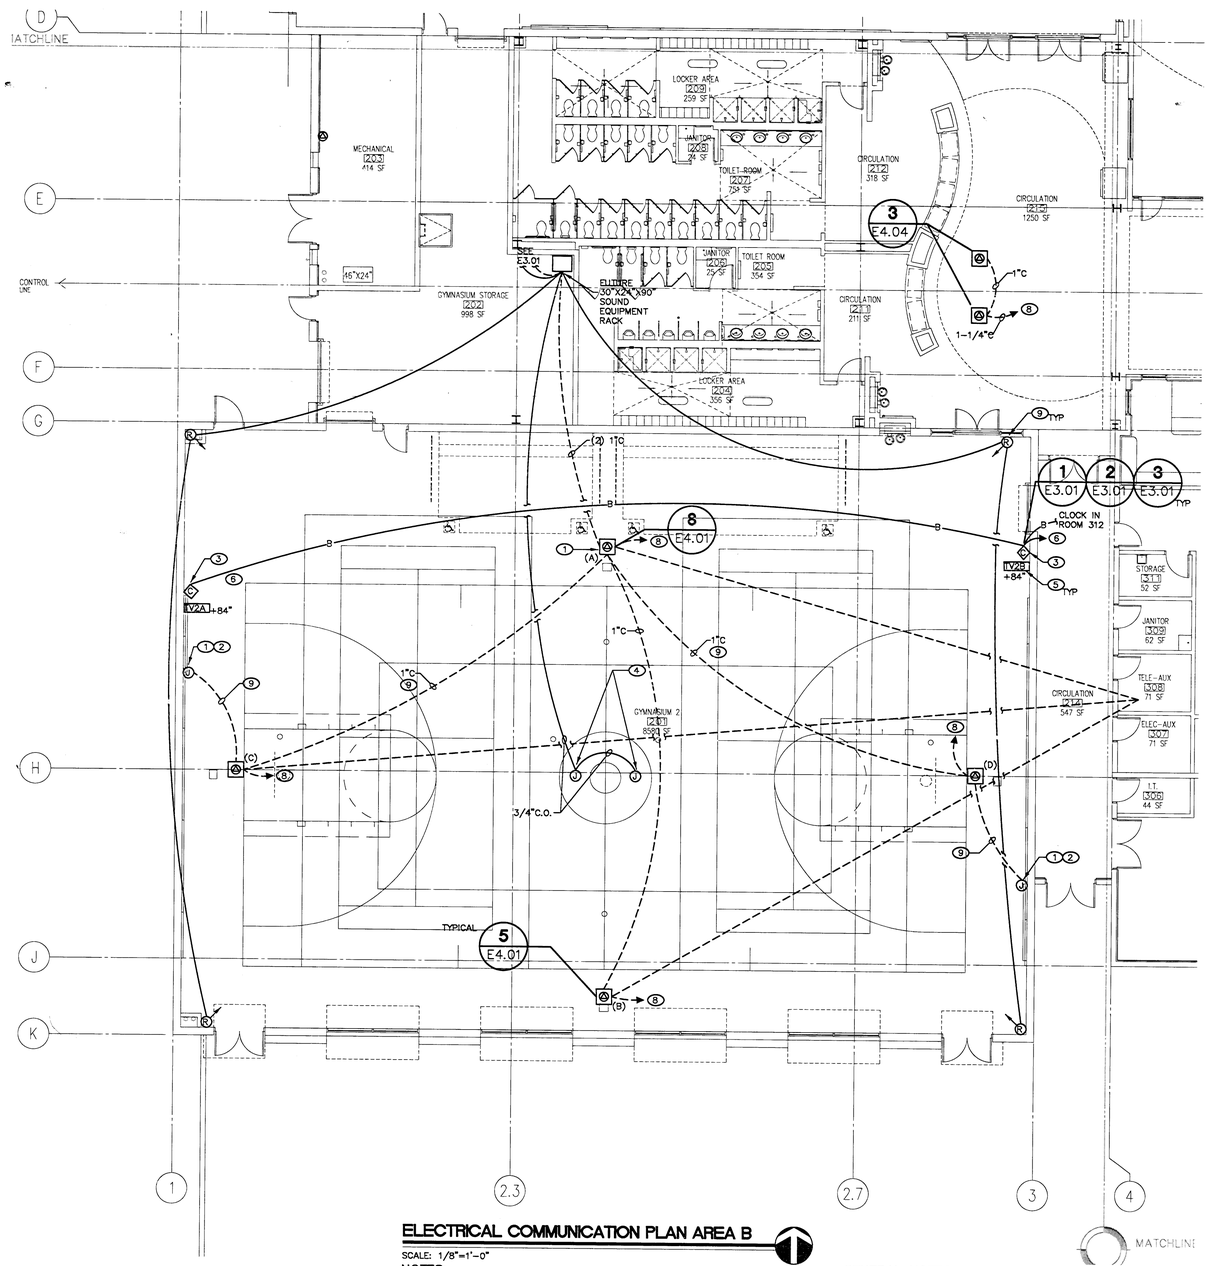

ELECTRICAL COMMUNICATION PLAN AREA B

SCALE: 1/8"=1'-0"

NOTES:

RFI#57

1. J-BOX FOR SCOREBOARD CONTROL. INSTALL J-BOX PER MANUFACTURERS REQUIREMENTS. SEE DETAIL 8/E4.01 FOR ADDITIONAL INFORMATION.
2. VERIFY MOUNTING HEIGHT WITH ARCHITECT.
3. PROVIDE WIRE CAGE.
4. J-BOX FOR FUTURE SPEAKERS.
5. SEE DETAIL 1/E4.04 FOR CONDUIT INFORMATION. MOUNT 4-S BOX REAR TO TOP OF WALL AT STRUCTURAL CEILING.
6. ROUTE CABLE A, 3/4"C TO CLOCK INTERCOM CABINET RM 403.
7. SEE DETAIL 4/E4.01 FOR ADDITIONAL INFORMATION.
8. ROUTE 1" TO TELE/AUX 308.
9. PROVIDE ADDITIONAL CONDUIT AS INDICATED ON DETAIL 8/E4.01.
10. PROVIDE J-BOX FOR FUTURE REPEATERS. ROUTE 3/4"C TO FUTURE EQUIPMENT RACK.

GENERAL NOTES:

1. ALL CONDUIT IS 3/4"C MIN. UNO.
2. CONTRACTOR MAY COMBINE ALL TYPE A HOMERUNS.
3. MOUNT ALL EXPOSED CONDUIT ALONG CEILING SNUG TO BOTTOM OF STRUCTURE.
4. SURFACE MOUNTED CONDUITS ARE NOT ACCEPTABLE. ALL CONDUITS ARE TO BE CONCEALED WITHIN WALLS OR BELOW GRADE.
5. ALL WIRING AND CONDUIT SHALL BE CONCELLED WITHIN THE WALLS, INCLUDING BLOCK WALLS. COORDINATE CONDUIT INSTALLATION WITH OTHER TRADES PRIOR TO ROUGH-IN.
6. REFER TO SPECIFICATONS AND ARCHITECTURAL FINISH SCHEDULE FOR DEVICE COVERPLATE REQUIREMENTS.

THESE RECORD DOCUMENTS HAVE BEEN PREPARED BASED ON INFORMATION PROVIDED BY OTHERS. THE DESIGN PROFESSIONAL HAS NOT VERIFIED THE ACCURACY AND/OR COMPLETENESS OF THIS INFORMATION AND SHALL NOT BE RESPONSIBLE FOR ANY ERRORS OR OMISSIONS WHICH MAY BE INCORPORATED HEREIN AS A RESULT.

KEYPLAN

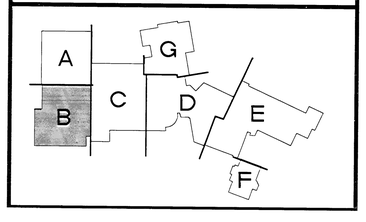

REVISIONS
RECORD DRAWINGS 10/05/07

CONSULTANT

500 PILOT ROAD, SUITE A
LAS VEGAS, NEVADA 89119
(702) 263-7111
(702) 263-8111 FAX
LUCCHESI •GALATI•

Disclaimer: These record drawings prepared by Lucchesi Galati Architects, Inc., are based on information provided by others. Lucchesi Galati Architects, Inc. has not verified the accuracy and/or completeness of tis information supplied by others, and shall not be responsible for any errors or omissions, which may be incorporated herein as a result.

CITY OF LAS VEGAS
CENTENNIAL HILLS COMMUNITY CENTER
RECORD DRAWINGS
ELECTRICAL COMMUNICATION PLAN AREA B

STAMP

OWNER: CITY OF LAS VEGAS
DEPARTMENT OF PUBLIC WORKS
ARCHITECTURAL SERVICES

400 EAST STEWART AVENUE
LAS VEGAS, NEVADA 89101
PHONE: (702) 229-5535
FAX: (702) 384-8846
TDD: (702) 386-9108

DRAWN	
TITLE	
DATE	03/18/05
SCALE	
BID NO	05153410
CLV DWG NO	671-49
SHT NO	E3.02

PROHIBITED COPIES OF THE DRAWINGS AND SPECIFICATIONS REMAINS BY THE CLIENT MAY BE UTILIZED ONLY FOR DECIPHERING THE PROJECT FOR WHICH THEY WERE PREPARED AND NOT FOR THE CONSTRUCTION OF ANY OTHER PROJECT N A C 623.750

DRAWINGS AS INSTRUMENTS OF SERVICE ARE THE PROPERTY OF THE DESIGN PROFESSIONAL WHOSE STAMP OF CERTIFICATION APPEARS ON THE DRAWINGS AND SPECIFICATIONS ANY USE OR REPRODUCTION IN WHOLE OR IN PART WITHOUT WRITTEN CONSENT IS STRICTLY PROHIBITED

055 E3 02 TIF

12/7/22