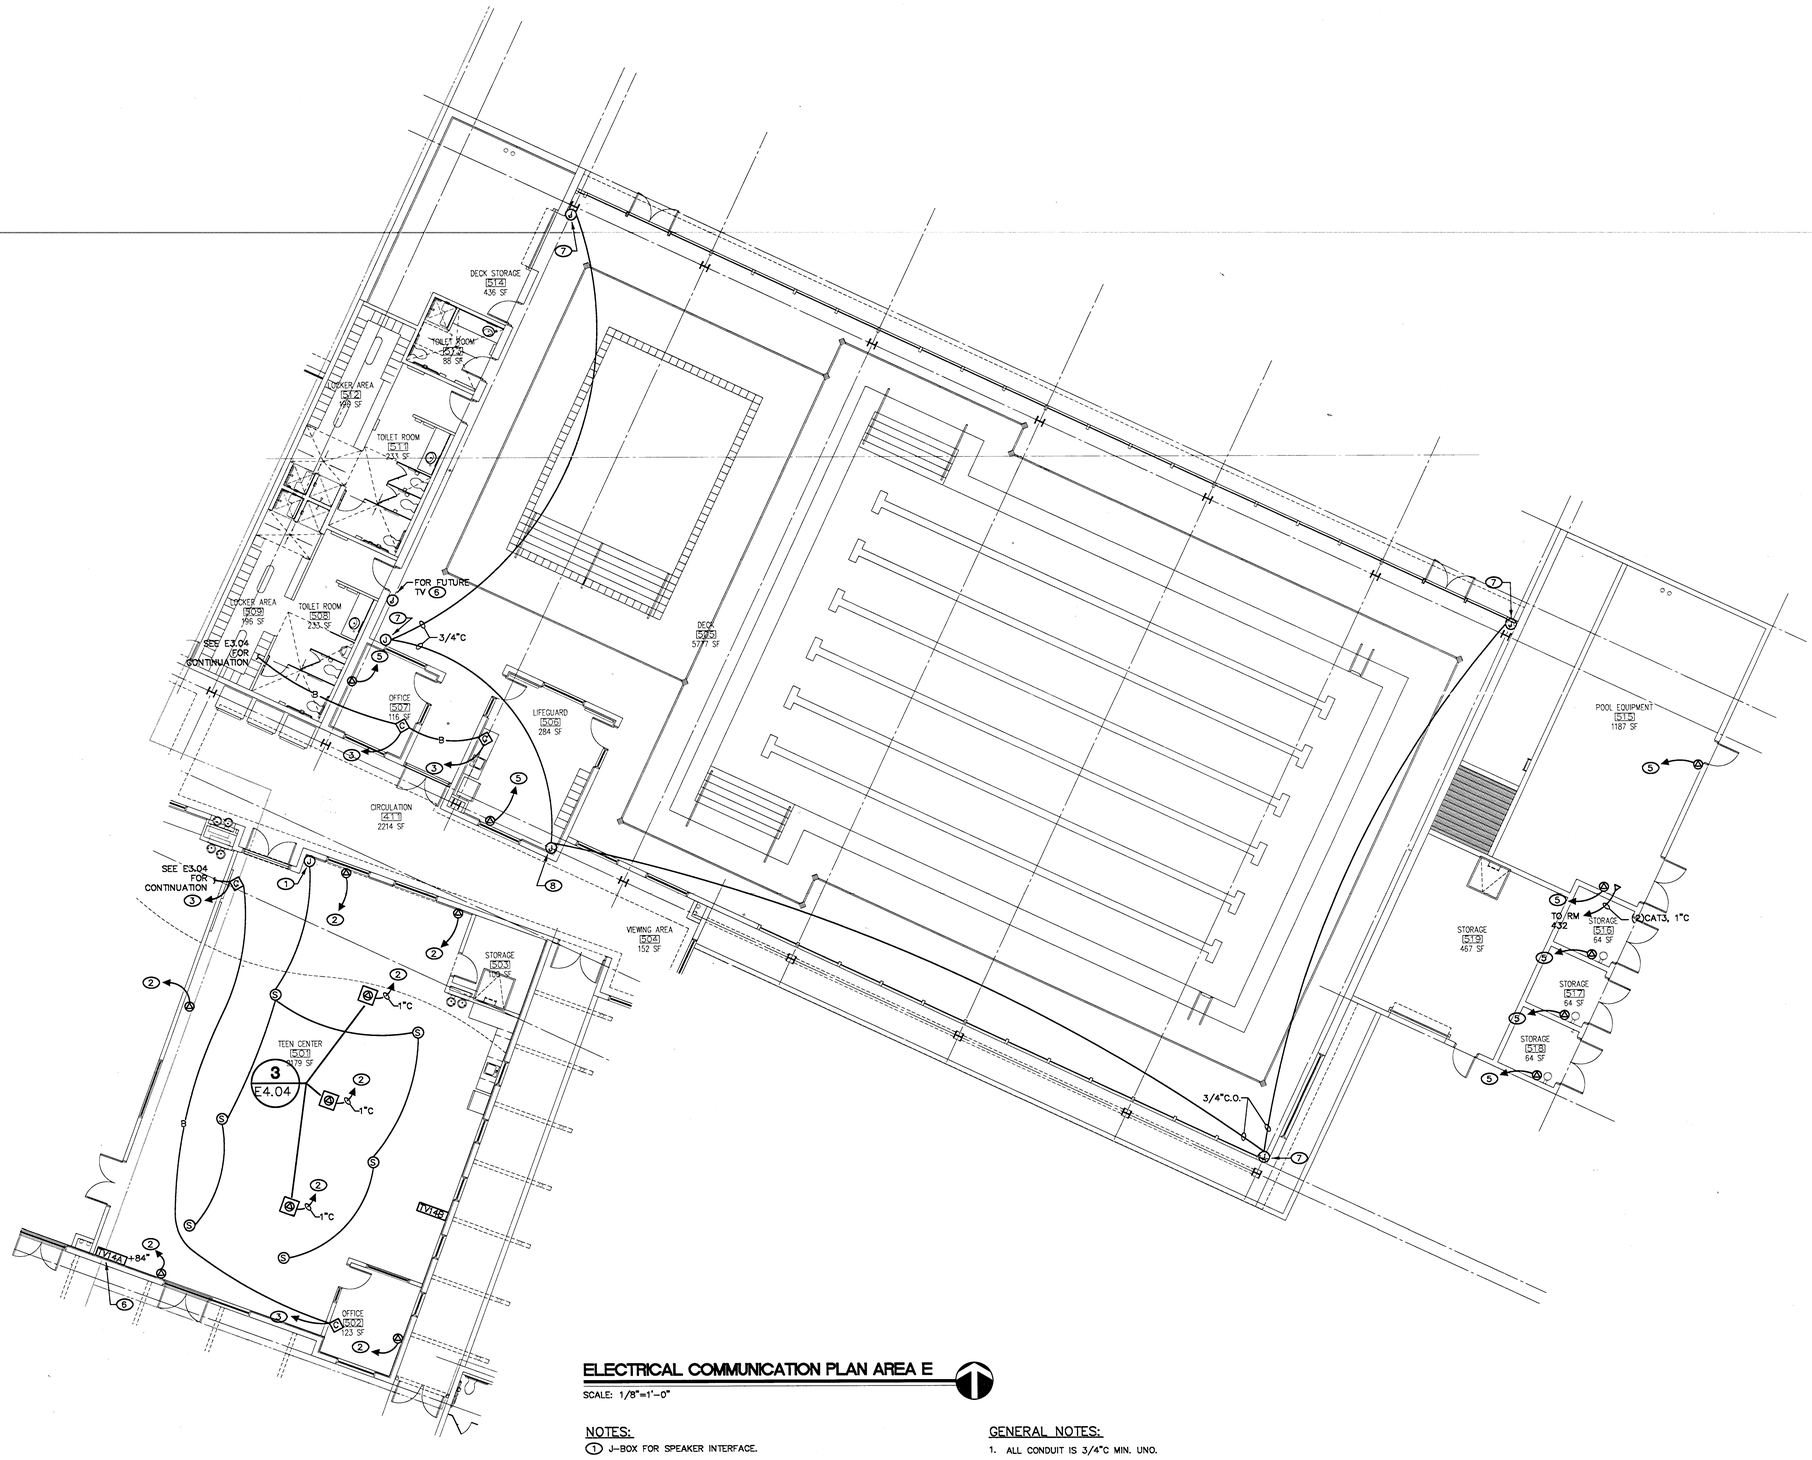

ELECTRICAL COMMUNICATION PLAN AREA E

SCALE: 1/8"=1'-0"

NOTES:

1. J-BOX FOR SPEAKER INTERFACE.
2. ROUTE TO ROOM 446 MIN 3/4"C UNO. SEE DRAWINGS E3.04 FOR TOOM LOCATION.
3. ROUTE CALBE A, 1"C TO CLOCK/INTERCOM CABINET IN ROOM 403.
4. NOT USED.
5. ROUTE 1" TO AUX/TELE ROOM 432 SEE DETAIL 3/E4.01 FOR ADDITIONAL INFORMATION.
6. SEE DETAIL 1/E4.01 FOR TV CONDUIT INFORMATION.
7. J-BOX FOR FUTURE SOUND SYSTEM. LOCATED AT STRUCTURAL CEILING.
8. J-BOX FOR FUTURE SOUND·SYSTEM. LOCATE ABOVE DROP CEILING.

GENERAL NOTES:

1. ALL CONDUIT IS 3/4"C MIN. UNO.
2. CONTRACTOR MAY COMBINE ALL TYPE A HOMERUNS.
3. MOUNT ALL EXPOSED CONDUIT ALONG CEILING SNUG TO BOTTOM OF STRUCTURE.
4. SURFACE MOUNTED CONDUITS ARE NOT ACCEPTABLE. ALL CONDUITS ARE TO BE CONCEALED WITHIN WALLS OR BELOW GRADE.
5. ALL WIRING AND CONDUIT SHALL BE CONCELLED WITHIN THE WALLS, INCLUDING BLOCK WALLS. COORDINATE CONDUIT INSTALLATION WITH OTHER TRADES PRIOR TO ROUGH-IN.
6. REFER TO SPECIFICATIONS AND ARCHITECTURAL FINISH SCHEDULE FOR DEVICE COVERPLATE REQUIREMENTS.

THESE RECORD DOCUMENTS HAVE BEEN PREPARED BASED ON INFORMATION PROVIDED BY OTHERS. THE DESIGN PROFESSIONAL HAS NOT VERIFIED THE ACCURACY AND/OR COMPLETENESS OF THIS INFORMATION AND SHALL NOT BE RESPONSIBLE FOR ANY ERRORS OR OMISSIONS WHICH MAY BE INCORPORATED HEREIN AS A RESULT.

KEYPLAN

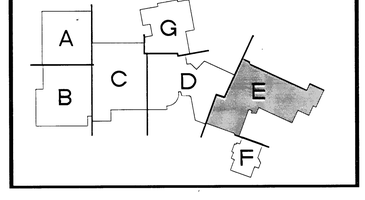

REVISIONS
RECORD DRAWINGS 10/15/07

CONSULTANT

LUCCHESI GALATI
300 WEST HOOVER, SUITE A
LAS VEGAS, NEVADA 89169
(702) 263-7111 FAX
(702) 263-8111

Disclaimer: These record drawings prepared by Lucchesi Galati Architects, Inc., are based on information provided by others. Lucchesi Galati Architects, Inc. has not verified the accuracy and/or completeness of tis information supplied by others, and shall not be responsible for any errors or omissions, which may be incorporated herein as a result.

CITY OF LAS VEGAS
CENTENNIAL HILLS COMMUNITY
RECORD DRAWINGS
ELECTRICAL COMMUNICATION PLAN AREA E

STAMP

OWNER: CITY OF LAS VEGAS
DEPARTMENT OF PUBLIC WORKS
ARCHITECTURAL SERVICES

400 EAST STEWART AVENUE
LAS VEGAS, NEVADA 89101
PHONE: (702)229-5535
FAX: (702) 384-4846
TDD: (702) 386-9108

DRAWN	
TITLE	
DATE	03/18/05
SCALE	
TCD NO	05134101
CLV DWG NO	671-49
SHT NO	E3.05

DRAWINGS AS INSTRUMENTS OF SERVICE ARE THE PROPERTY OF THE DESIGN PROFESSIONAL WHOSE STAMP OF CERTIFICATION APPEARS ON THE DRAWINGS AND SPECIFICATIONS ANY USE OR REPRODUCTION IN WHOLE OR IN PART WITHOUT WRITTEN CONSENT IS STRICTLY PROHIBITED COPIES OF THE DRAWINGS AND SPECIFICATIONS RETAINED BY THE CLIENT MAY BE UTILIZED ONLY FOR OCCUPYING THE PROJECT FOR WHICH THEY WERE PREPARED AND NOT FOR THE CONSTRUCTION OF ANY OTHER PROJECT N A C S 823.780

058 E3.05.TIF