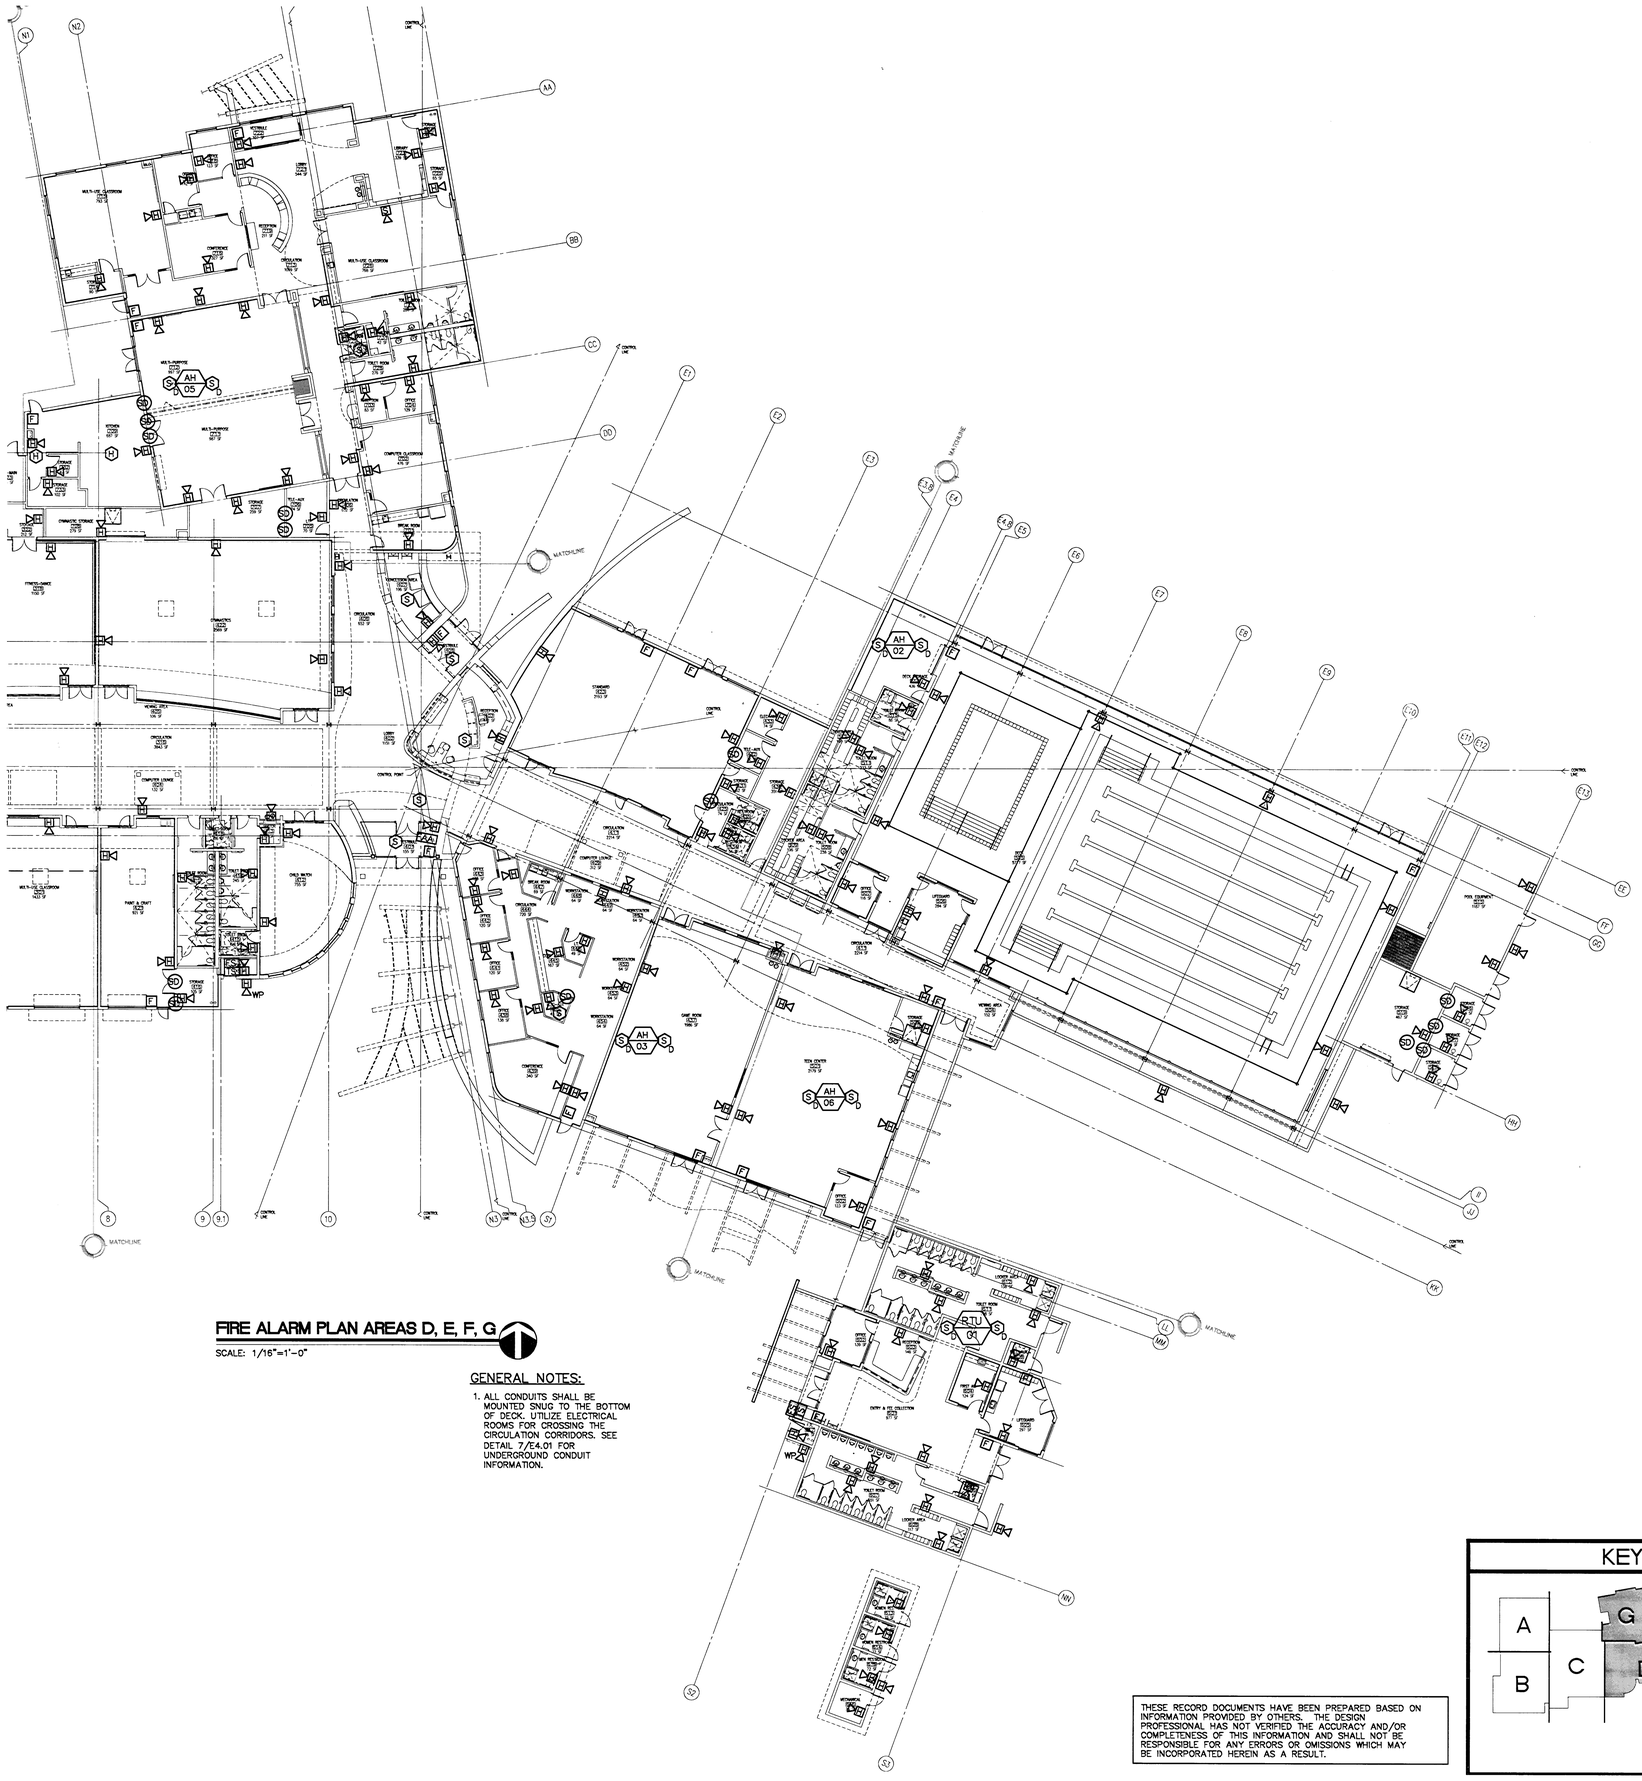


## FIRE ALARM PLAN AREAS D, E, F, G

SCALE: 1/16"=1'-0"

GENERAL NOTES:

1. ALL CONDUITS SHALL BE MOUNTED SNUG TO THE BOTTOM OF DECK. UTILIZE ELECTRICAL ROOMS FOR CROSSING THE CIRCULATION CORRIDORS. SEE DETAIL 7/E4.01 FOR UNDERGROUND CONDUIT INFORMATION.

THESE RECORD DOCUMENTS HAVE BEEN PREPARED BASED ON INFORMATION PROVIDED BY OTHERS. THE DESIGN PROFESSIONAL HAS NOT VERIFIED THE ACCURACY AND/OR COMPLETENESS OF THIS INFORMATION AND SHALL NOT BE RESPONSIBLE FOR ANY ERRORS OR OMISSIONS WHICH MAY BE INCORPORATED HEREIN AS A RESULT.

KEYPLAN




REVISIONS

RECORD DRAWINGS 10/05/07

CONSULTANT

500 PECOT ROAD, SUITE A
LAS VEGAS, NEVADA 89119
(702) 263-2111
(702) 262-8111 FAX

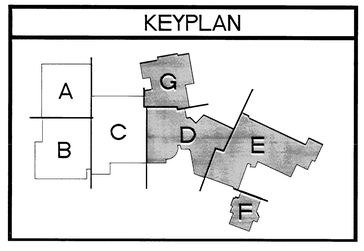LUCCHESI •GALATI•

Disclaimer: These record drawings prepared by Lucchesi Galati Architects, Inc., are based on information provided by others. Lucchesi Galati Architects, Inc. has not verified the accuracy and/or completeness of its information supplied by others, and shall not be responsible for any errors or omissions, which may be incorporated herein as a result.

CITY OF LAS VEGAS
CENTENNIAL HILLS COMMUNITY CENTER
RECORD DRAWINGS
FIRE ALARM PLAN AREAS D, E, F, G

STAMP

OWNER: CITY OF LAS VEGAS
DEPARTMENT OF PUBLIC WORKS
ARCHITECTURAL SERVICES

400 EAST STEWART AVENUE
LAS VEGAS, NEVADA 89101
PHONE: (702)229-6535
FAX: (702)384-8846
TDD: (702)386-9108

DRAWN

TITLE

DATE 03/18/05

SCALE

PROJ NO 05.1534.01

CITY DWG NO 671-49

SHT NO FA1.02

DRAWINGS AS INSTRUMENTS OF SERVICE ARE THE PROPERTY OF THE DESIGN PROFESSIONAL WHOSE STAMP OF CERTIFICATION APPEARS ON THE DRAWINGS AND SPECIFICATIONS ANY USE OR REPRODUCTION IN WHOLE OR IN PART WITHOUT WRITTEN CONSENT IS STRICTLY PROHIBITED COPIES OF THE DRAWINGS AND SPECIFICATIONS RETAINED BY THE CLIENT MAY BE UTILIZED ONLY FOR DOCUMENTING THE PROJECT FOR WHICH THEY WERE PREPARED AND NOT FOR THE CONSTRUCTION OF ANY OTHER PROJECT. N. A. G. 623-780

12-7-13 SL

069 FA1.02.TIF