



RECORD OF SURVEY
MONUMENT TIE MAP
FOR
HUNTRIDGE

BEING A PORTION OF SECTION 3, TOWNSHIP 21 SOUTH, RANGE 61 EAST,
MOUNT DIABLO MERIDIAN, CLARK COUNTY, NEVADA

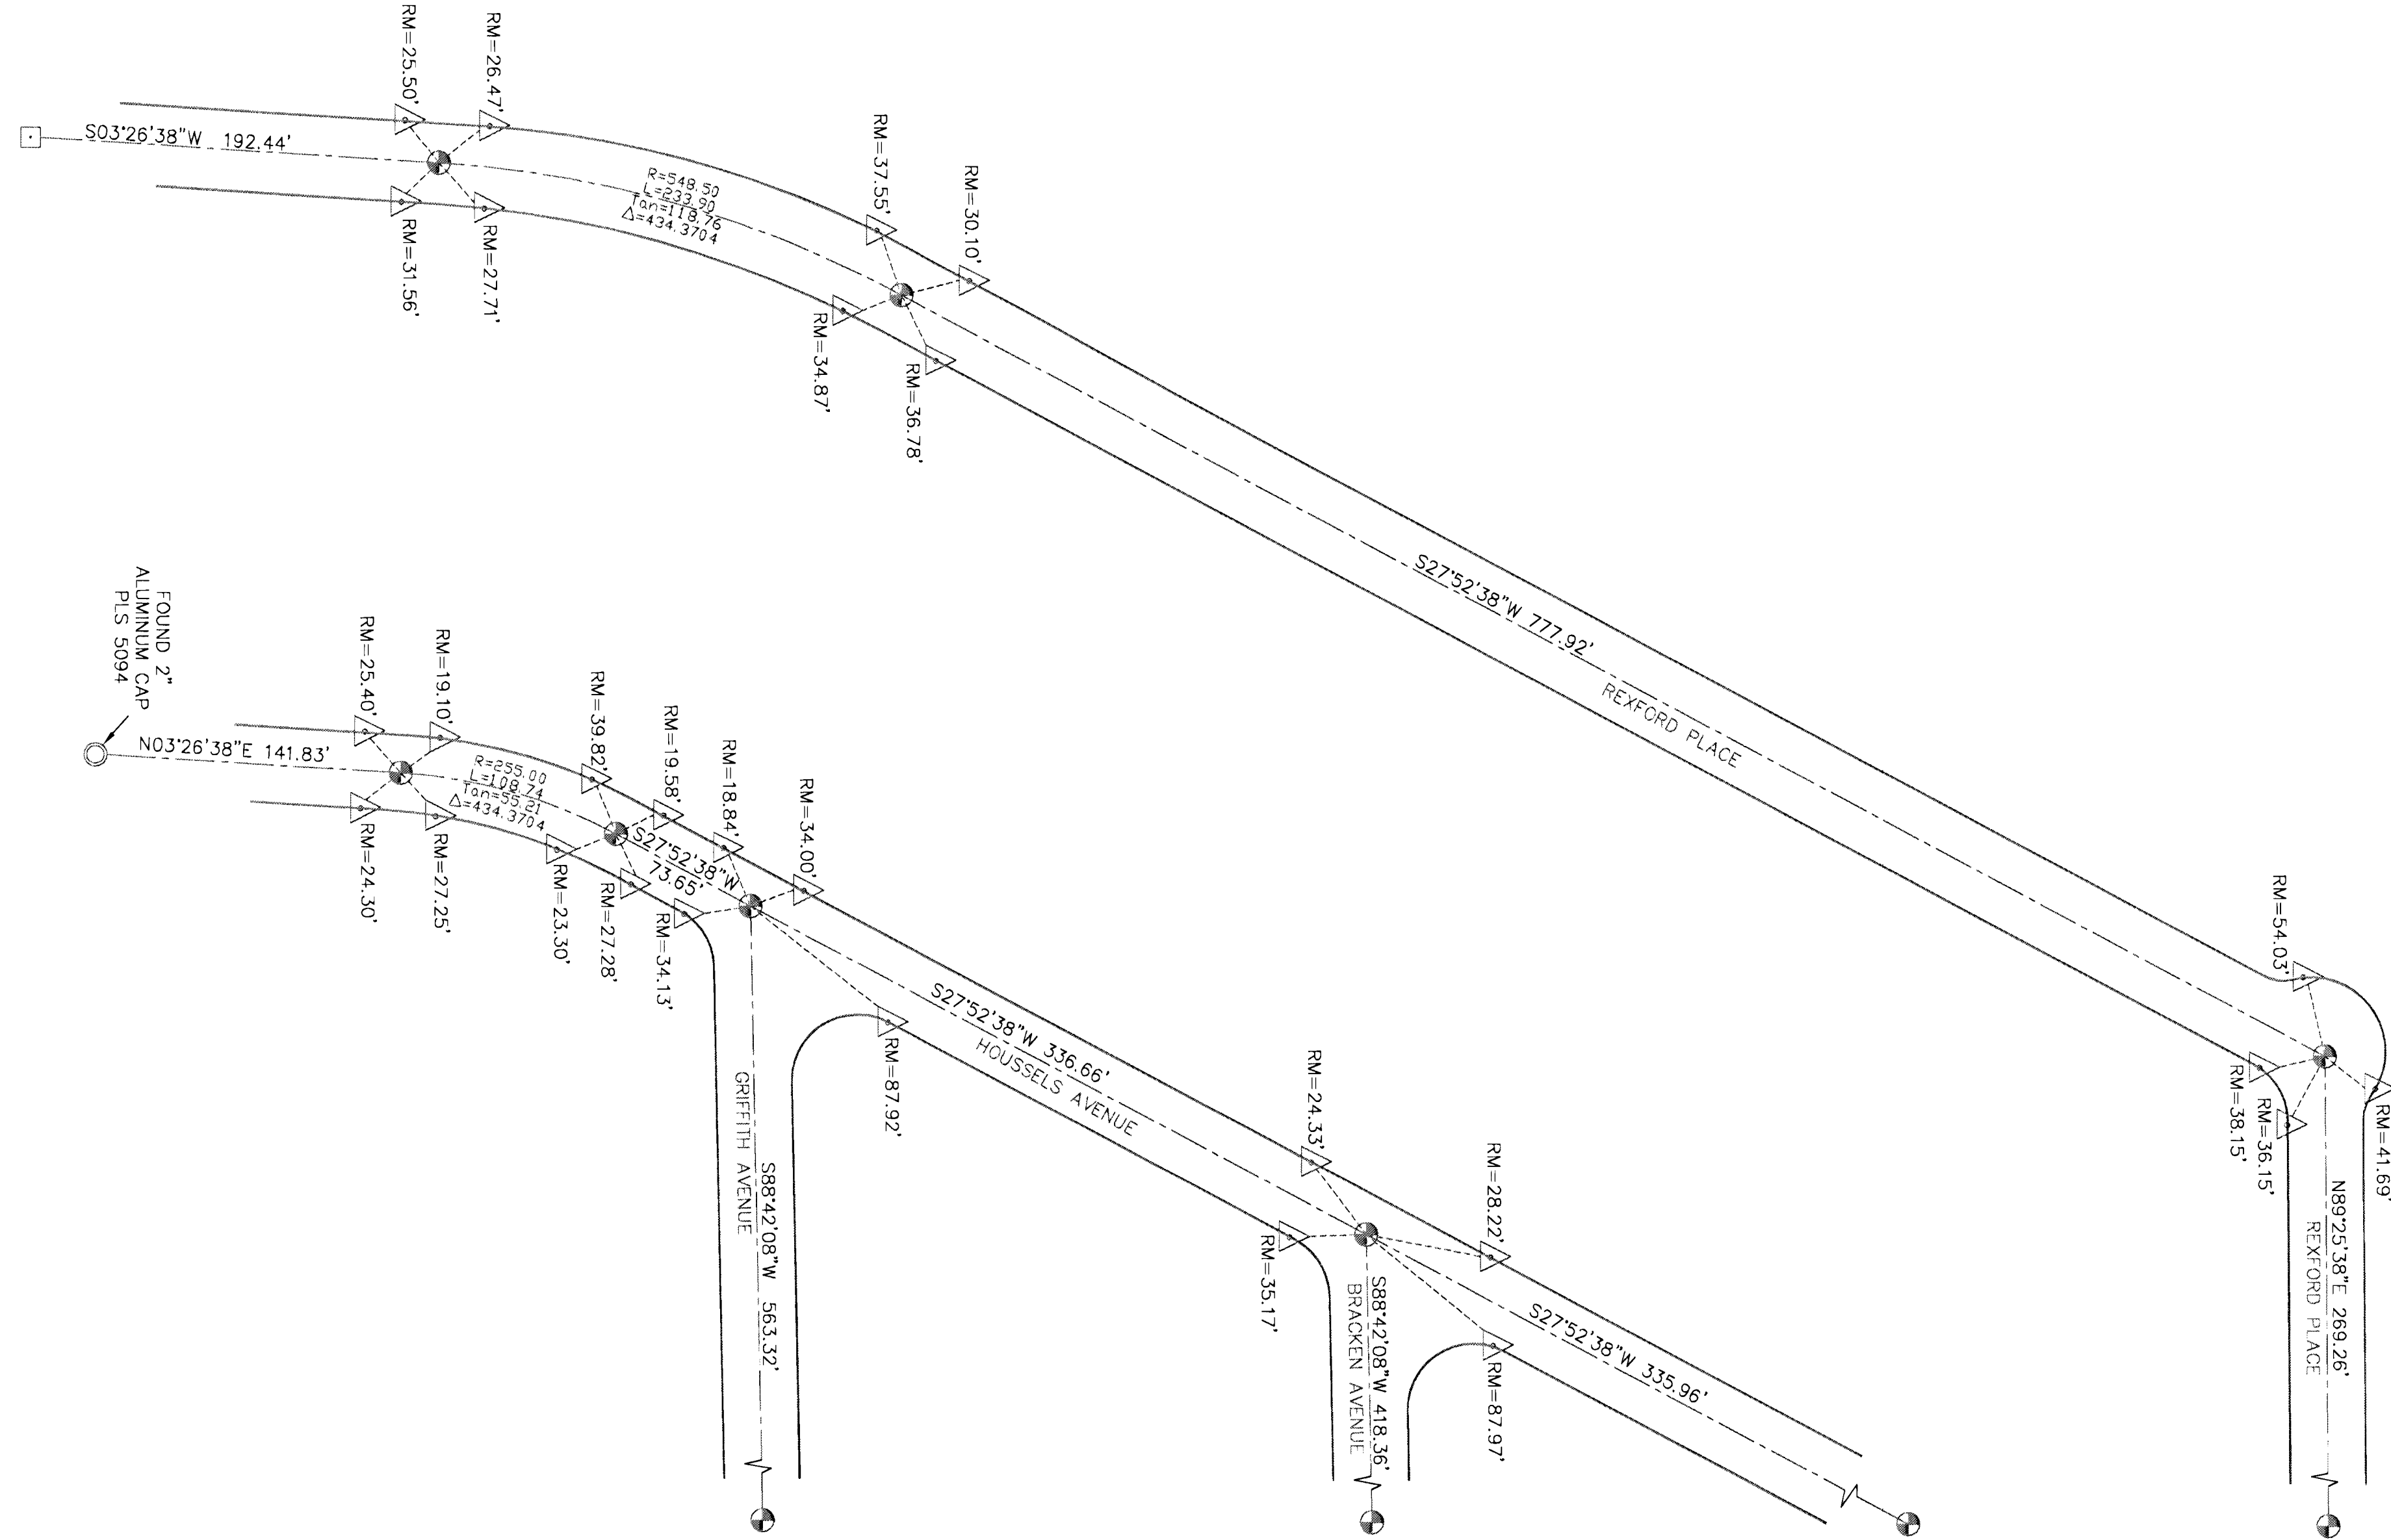

SURVEYOR'S CERTIFICATE

- I, RICHARD G. WILSON, A PROFESSIONAL LAND SURVEYOR LICENSED IN THE STATE OF NEVADA, AS AGENT FOR CCR PRECISION SURVEYING, LLC., DO HEREBY CERTIFY THAT:
1. THIS PLAT REPRESENTS THE RESULTS OF A SURVEY CONDUCTED UNDER MY DIRECT SUPERVISION AT THE INSTANCE OF LAS VEGAS VALLEY WATER DISTRICT.
 2. LANDS SURVEYED LIE WITHIN SECTION 3, TOWNSHIP 21 SOUTH, RANGE 61 EAST, MOUNT DIABLO MERIDIAN, CLARK COUNTY, NEVADA AND THIS SURVEY WAS COMPLETED ON FEBRUARY 6, 2013.
 3. THIS PLAT COMPLIES WITH THE APPLICABLE STATE STATUTES AND ANY LOCAL ORDINANCES IN EFFECT ON THE DATE THAT THE SURVEY WAS COMPLETED, AND THE SURVEY WAS CONDUCTED IN ACCORDANCE WITH CHAPTER 625 OF THE NEVADA ADMINISTRATIVE CODE.
 4. THE MONUMENTS DEPICTED ON THE PLAT ARE OF THE CHARACTER SHOWN, OCCUPY THE POSITIONS INDICATED, AND ARE OF SUFFICIENT NUMBER AND DURABILITY.
 5. THIS SURVEY WAS PERFORMED FOR POST-CONSTRUCTION RE-ESTABLISHMENT OF HUNTRIDGE MONUMENTATION AND IS NOT A SUBDIVISION.

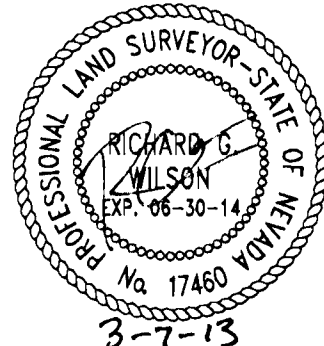

RICHARD G. WILSON
PROFESSIONAL LAND SURVEYOR
NEVADA CERTIFICATE NO. 17460

BASIS OF BEARINGS

THE BASIS OF BEARINGS FOR THE SURVEY SHOWN HEREON IS NORTH 01° 42' 22" EAST BEING THE CENTERLINE OF 8TH STREET BETWEEN OAKLEY BLVD AND SWEENEY AVE. AS SHOWN ON FILE 80, PAGE 46 OF SURVEYS.

REFERENCE MAPS


- PLAT: BOOK 04, PAGE 18
PLAT: BOOK 03, PAGE 92
PLAT: BOOK 02, PAGE 26
PLAT: BOOK 01, PAGE 69
PLAT: BOOK 03, PAGE 04
PLAT: BOOK 03, PAGE 58
PLAT: BOOK 03, PAGE 72

NOTES

THE PURPOSE OF THIS MONUMENT TIE MAP IS TO RE-ESTABLISH THE PREVIOUSLY ACCEPTED MONUMENTS LOST DUE TO HUNTRIDGE PHASE 6 CONSTRUCTION ACTIVITIES, UNLESS NOTED OTHERWISE.

COUNTY RECORDER'S NOTE

ANY SUBSEQUENT CHANGES TO THIS MAP SHOULD BE EXAMINED AND MAY BE DETERMINED BY REFERENCE TO THE COUNTY RECORDER'S CUMULATIVE MAP INDEX. N.R.S. 278.5695

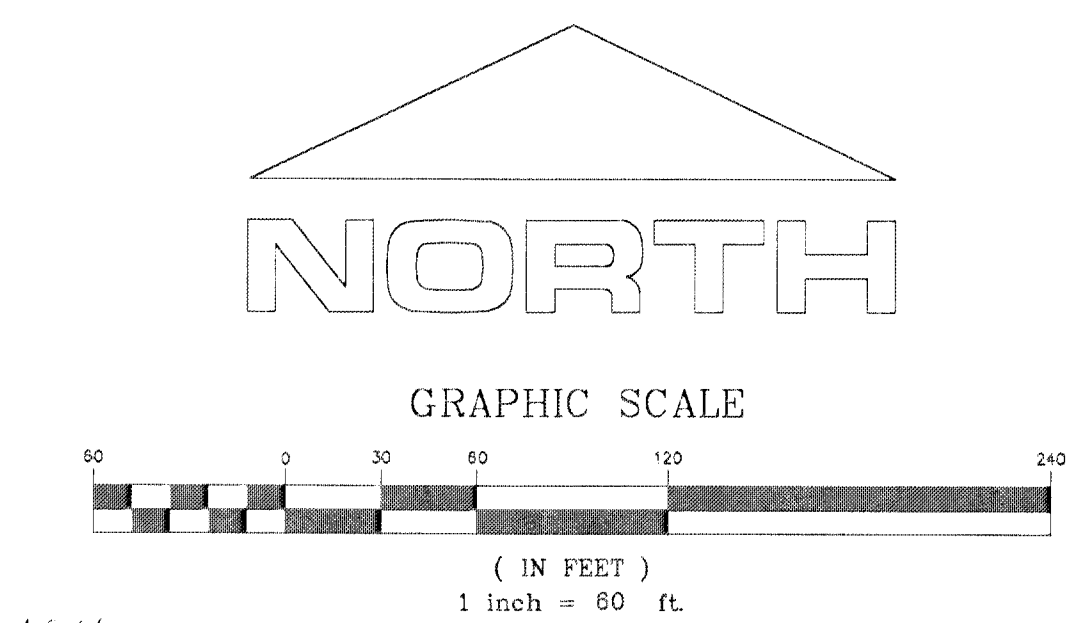

LEGEND

- CURB LINE
- CENTERLINE / CONTROL LINE
- SURVEY TIES
- FOUND MONUMENT AS DESCRIBED
- NOTHING FOUND, NOTHING SET
- POSITION CALCULATED
- SET 1 1/2-INCH ALUMINUM CAP
- STAMPED PLS 17460
- SET RM 2-INCH ALUMINUM CAP

RECORD OF SURVEY FOR CITY OF LAS VEGAS DEPT. OF PUBLIC WORKS BEING A PORTION OF SECTION 3, TOWNSHIP 21 SOUTH, RANGE 61 EAST, MOUNT DIABLO MERIDIAN, CLARK COUNTY, NEVADA		NO. _____ FILED AT THE REQUEST OF CCR PRECISION SURVEYING, LLC DATE _____ AT _____ M. FILE _____ PAGE _____ OF SURVEYS OFFICIAL RECORDS BOOK NO. _____ CLARK COUNTY, NEVADA RECORDS. DEBBIE CONWAY, RECORDER FEE \$ _____ DEPUTY _____
CCR PRECISION SURVEYING, LLC 4186 YAKIMA AVE. LAS VEGAS, NV 89121 (702) 327-7137		SHEET 3 OF 4 055-765

PROJECT NO.: 11-00670
DRAFTED BY: RGW